


ISSUANCES		
No.	Drawing Issue Description	Date
	BUILDING PERMIT	2016.10.17

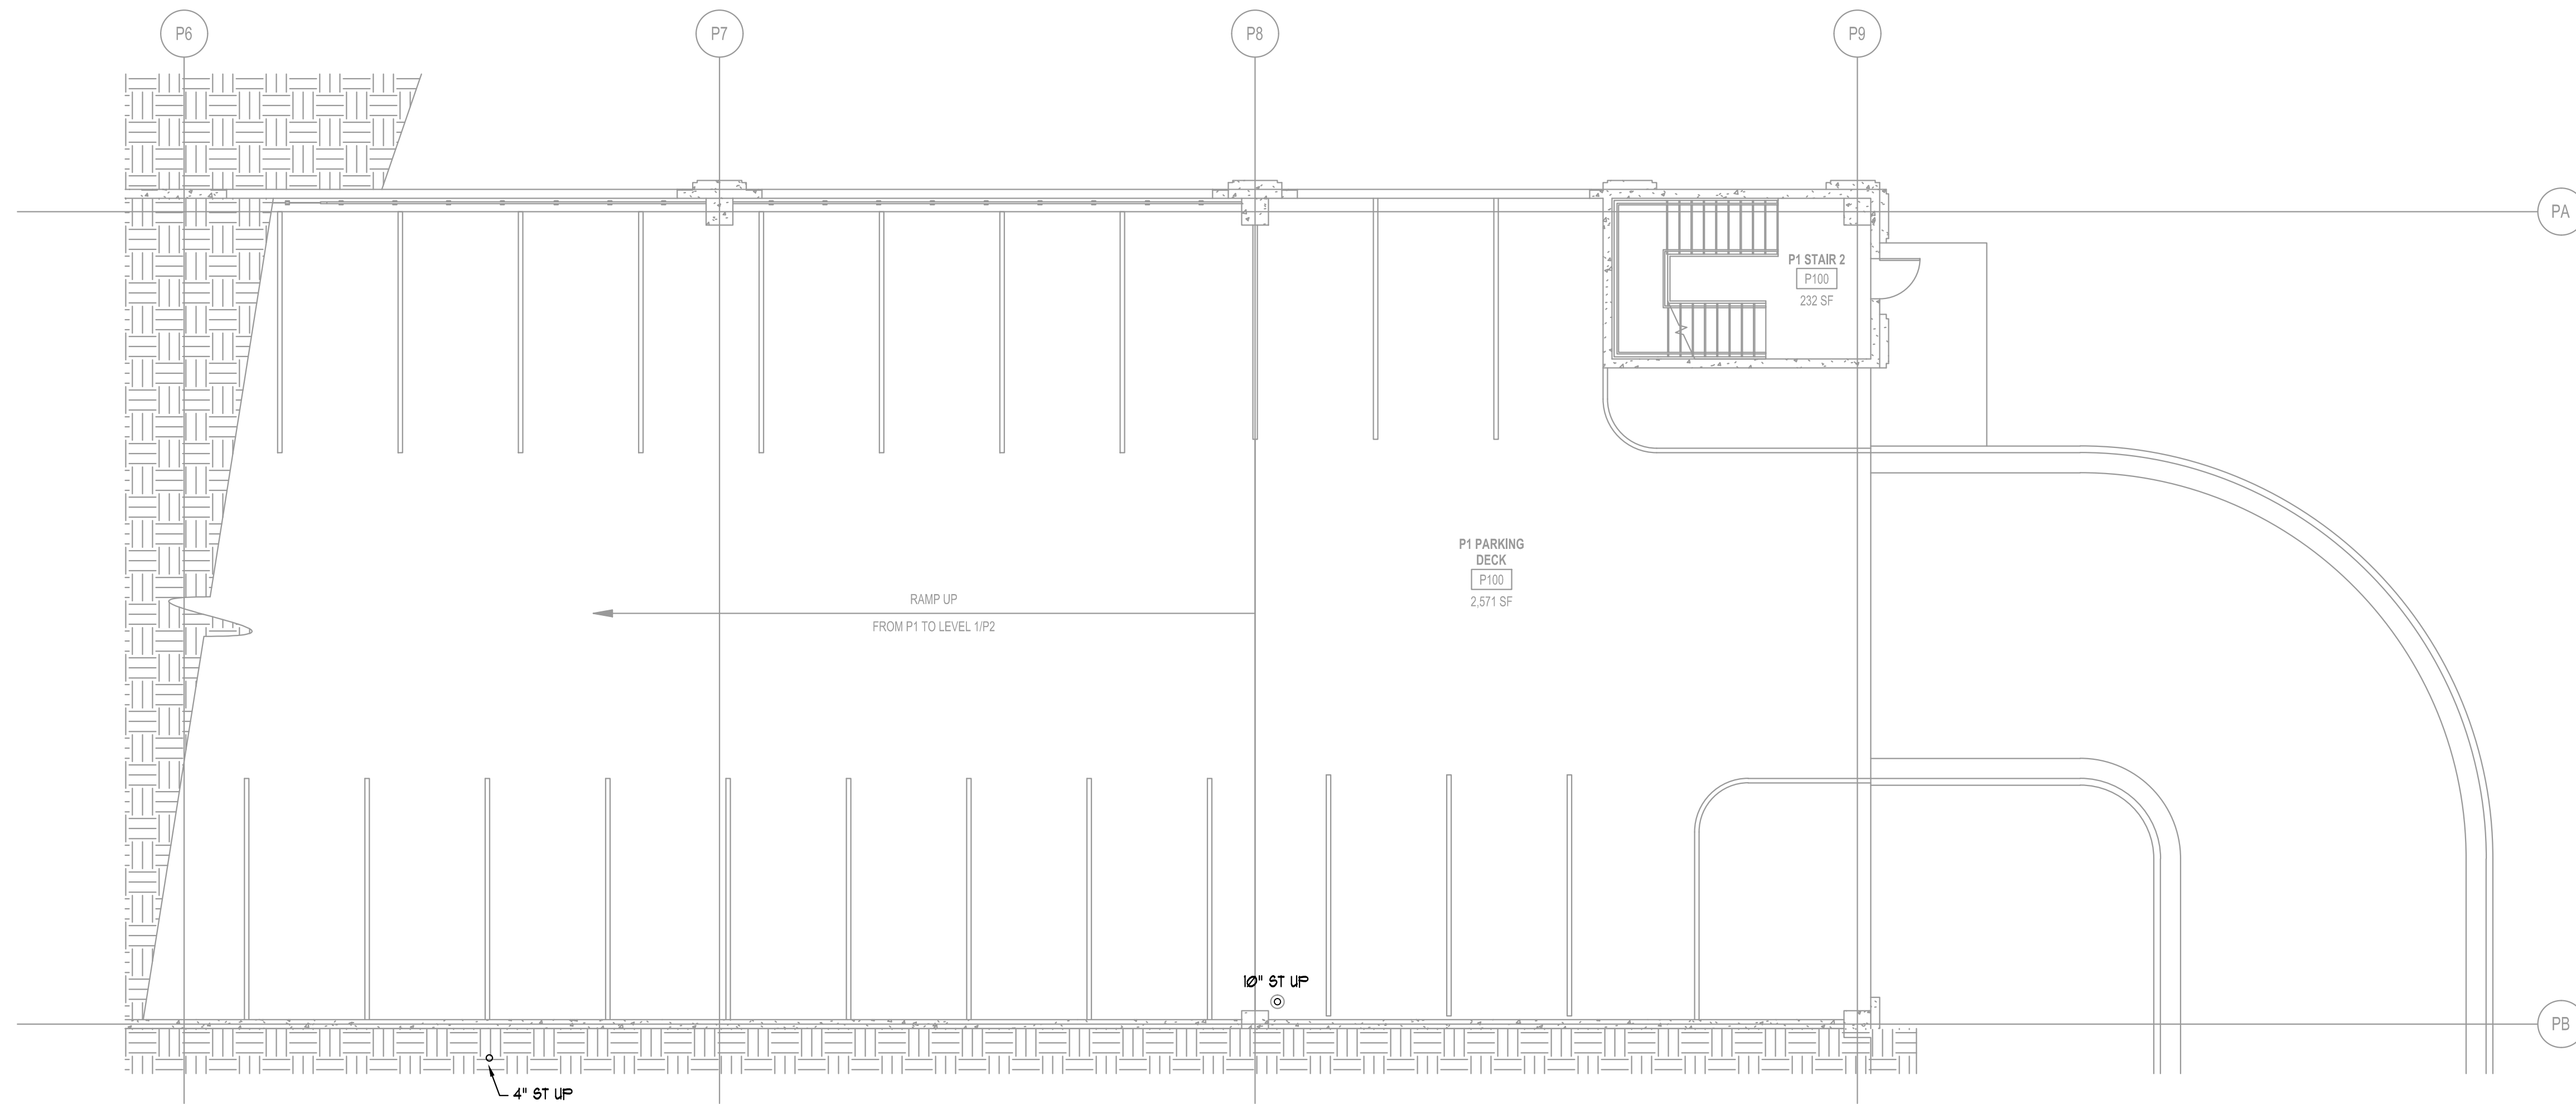

PROVIDE TRAFFIC RATED
AREA DRAINS AS LOCATED
ON ARCHITECTURAL PLANS

LEVEL P1 ZONE D -- PLUMBING
P2.000 1/8"=1'-0"

PROVIDE DRY STANDPIPES
PER NFPA 14.8.6A

ALPHARETTA CONFERENCE
CENTER & THE HOTEL AT
AVALON


9000 AVALON BOULEVARD /
ALPHARETTA, GEORGIA 30009

STORMONT HOSPITALITY GROUP, LLC /
NORTH AMERICAN PROPERTY GROUP

LEVEL P1
ZONE D
PLUMBING

K. PRICE	140028
Principal-in-Charge	SH&A Project No.
G. JENKINS	101716
Project Engineer	Date
T. MERCER	
Checker	

P2.00D

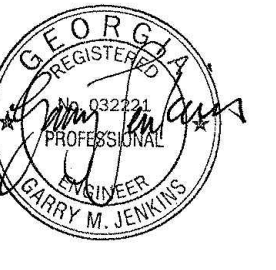

ISSUANCES		
No.	Drawing Issue Description	Date
1	BUILDING PERMIT	2016.10.17

ALPHARETTA CONFERENCE CENTER & THE HOTEL AT AVALON

9000 AVALON BOULEVARD /
ALPHARETTA, GEORGIA 30009

STORMONT HOSPITALITY GROUP, LLC /
NORTH AMERICAN PROPERTY GROUP

LEVEL 1 - ZONE A
PLUMBING


K. PRICE	140028
Principal in Charge	BWA Project No.
G. JENKINS	101716
Project Engineer	Date
T. MERCER	
Checker	


P2.01A

ISSUED FOR CONSTRUCTION

1 LEVEL 1 ZONE A - PLUMBING

P2.01A 1/8" = 1'-0"

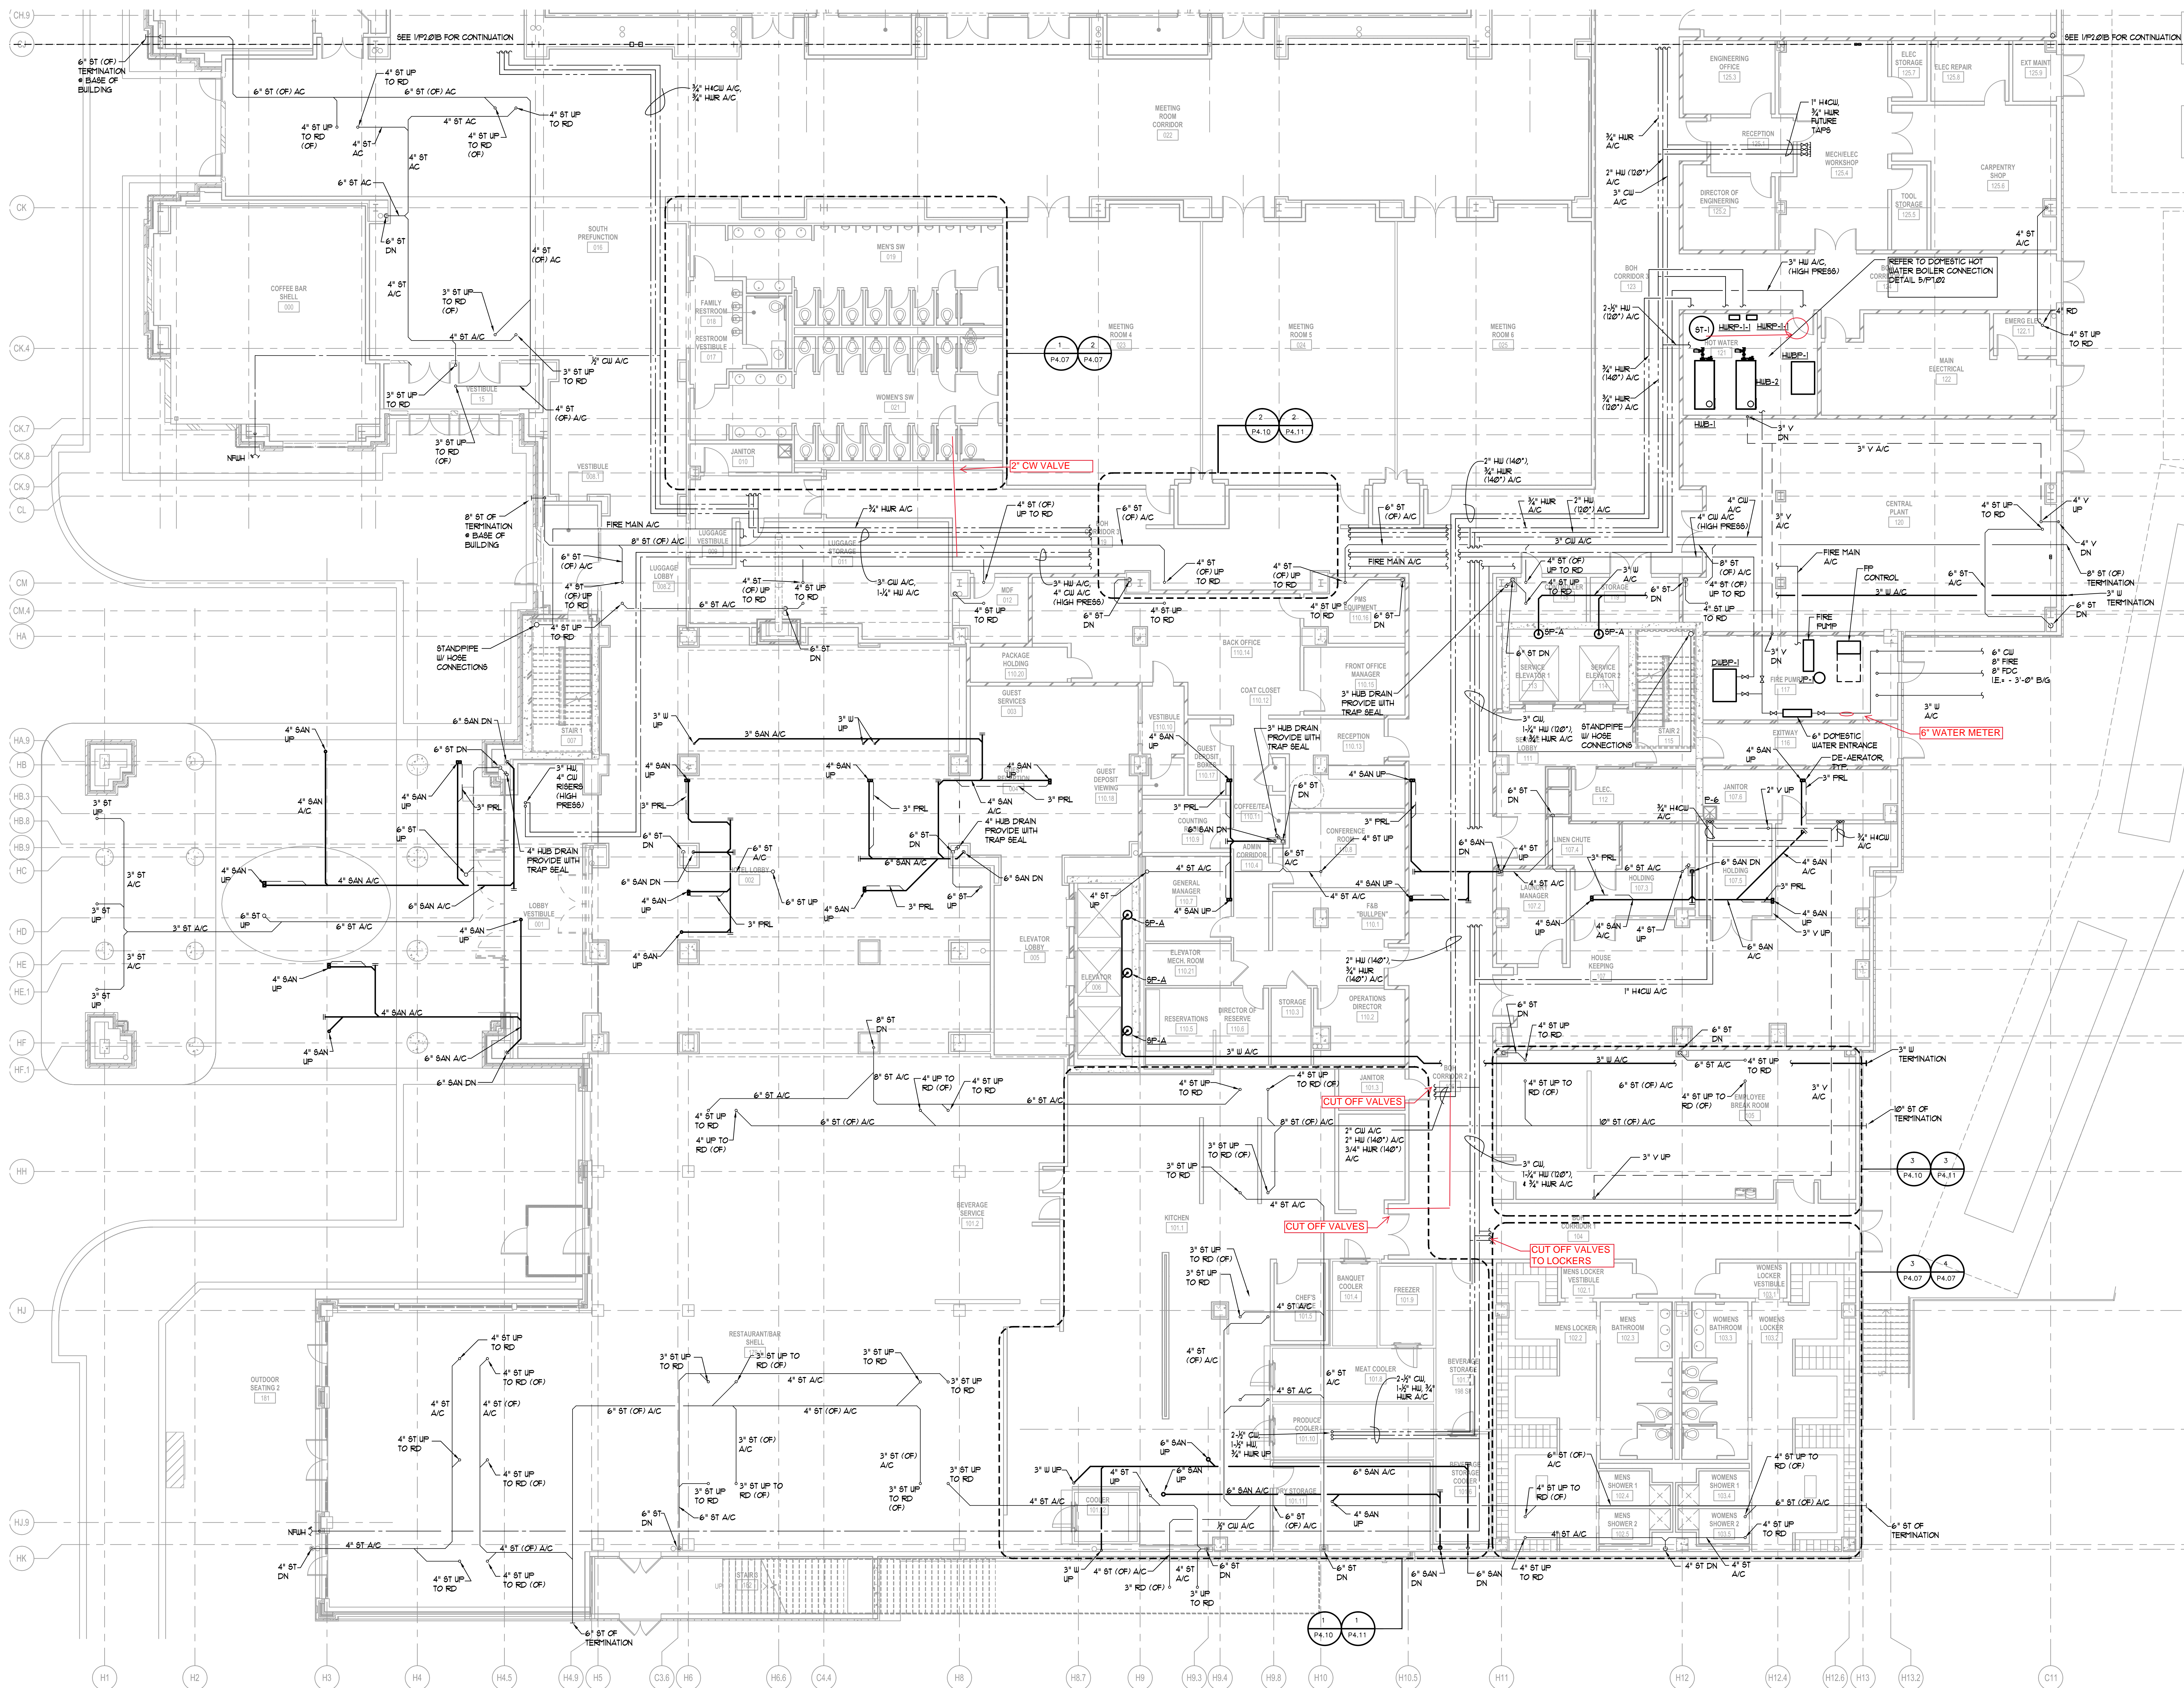

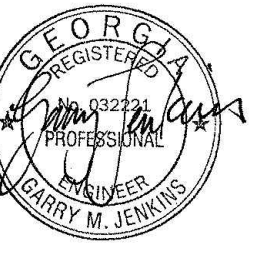

ISSUANCES

No.	Drawing Issue Description	Date
1	BUILDING PERMIT	2016.10.17

ALPHARETTA CONFERENCE CENTER & THE HOTEL AT AVALON

9000 AVALON BOULEVARD /
ALPHARETTA, GEORGIA 30009

STORMONT HOSPITALITY GROUP, LLC /
NORTH AMERICAN PROPERTY GROUP

LEVEL 1 - ZONE B PLUMBING


K. PRICE	140028
Principal in Charge	BWA Project No.
G. JENKINS	101716
Project Engineer	Date
T. MERCER	
Checker	


P2.01B

ISSUED FOR CONSTRUCTION


LEVEL 1 ZONE B - PLUMBING

1/8" = 1'-0"

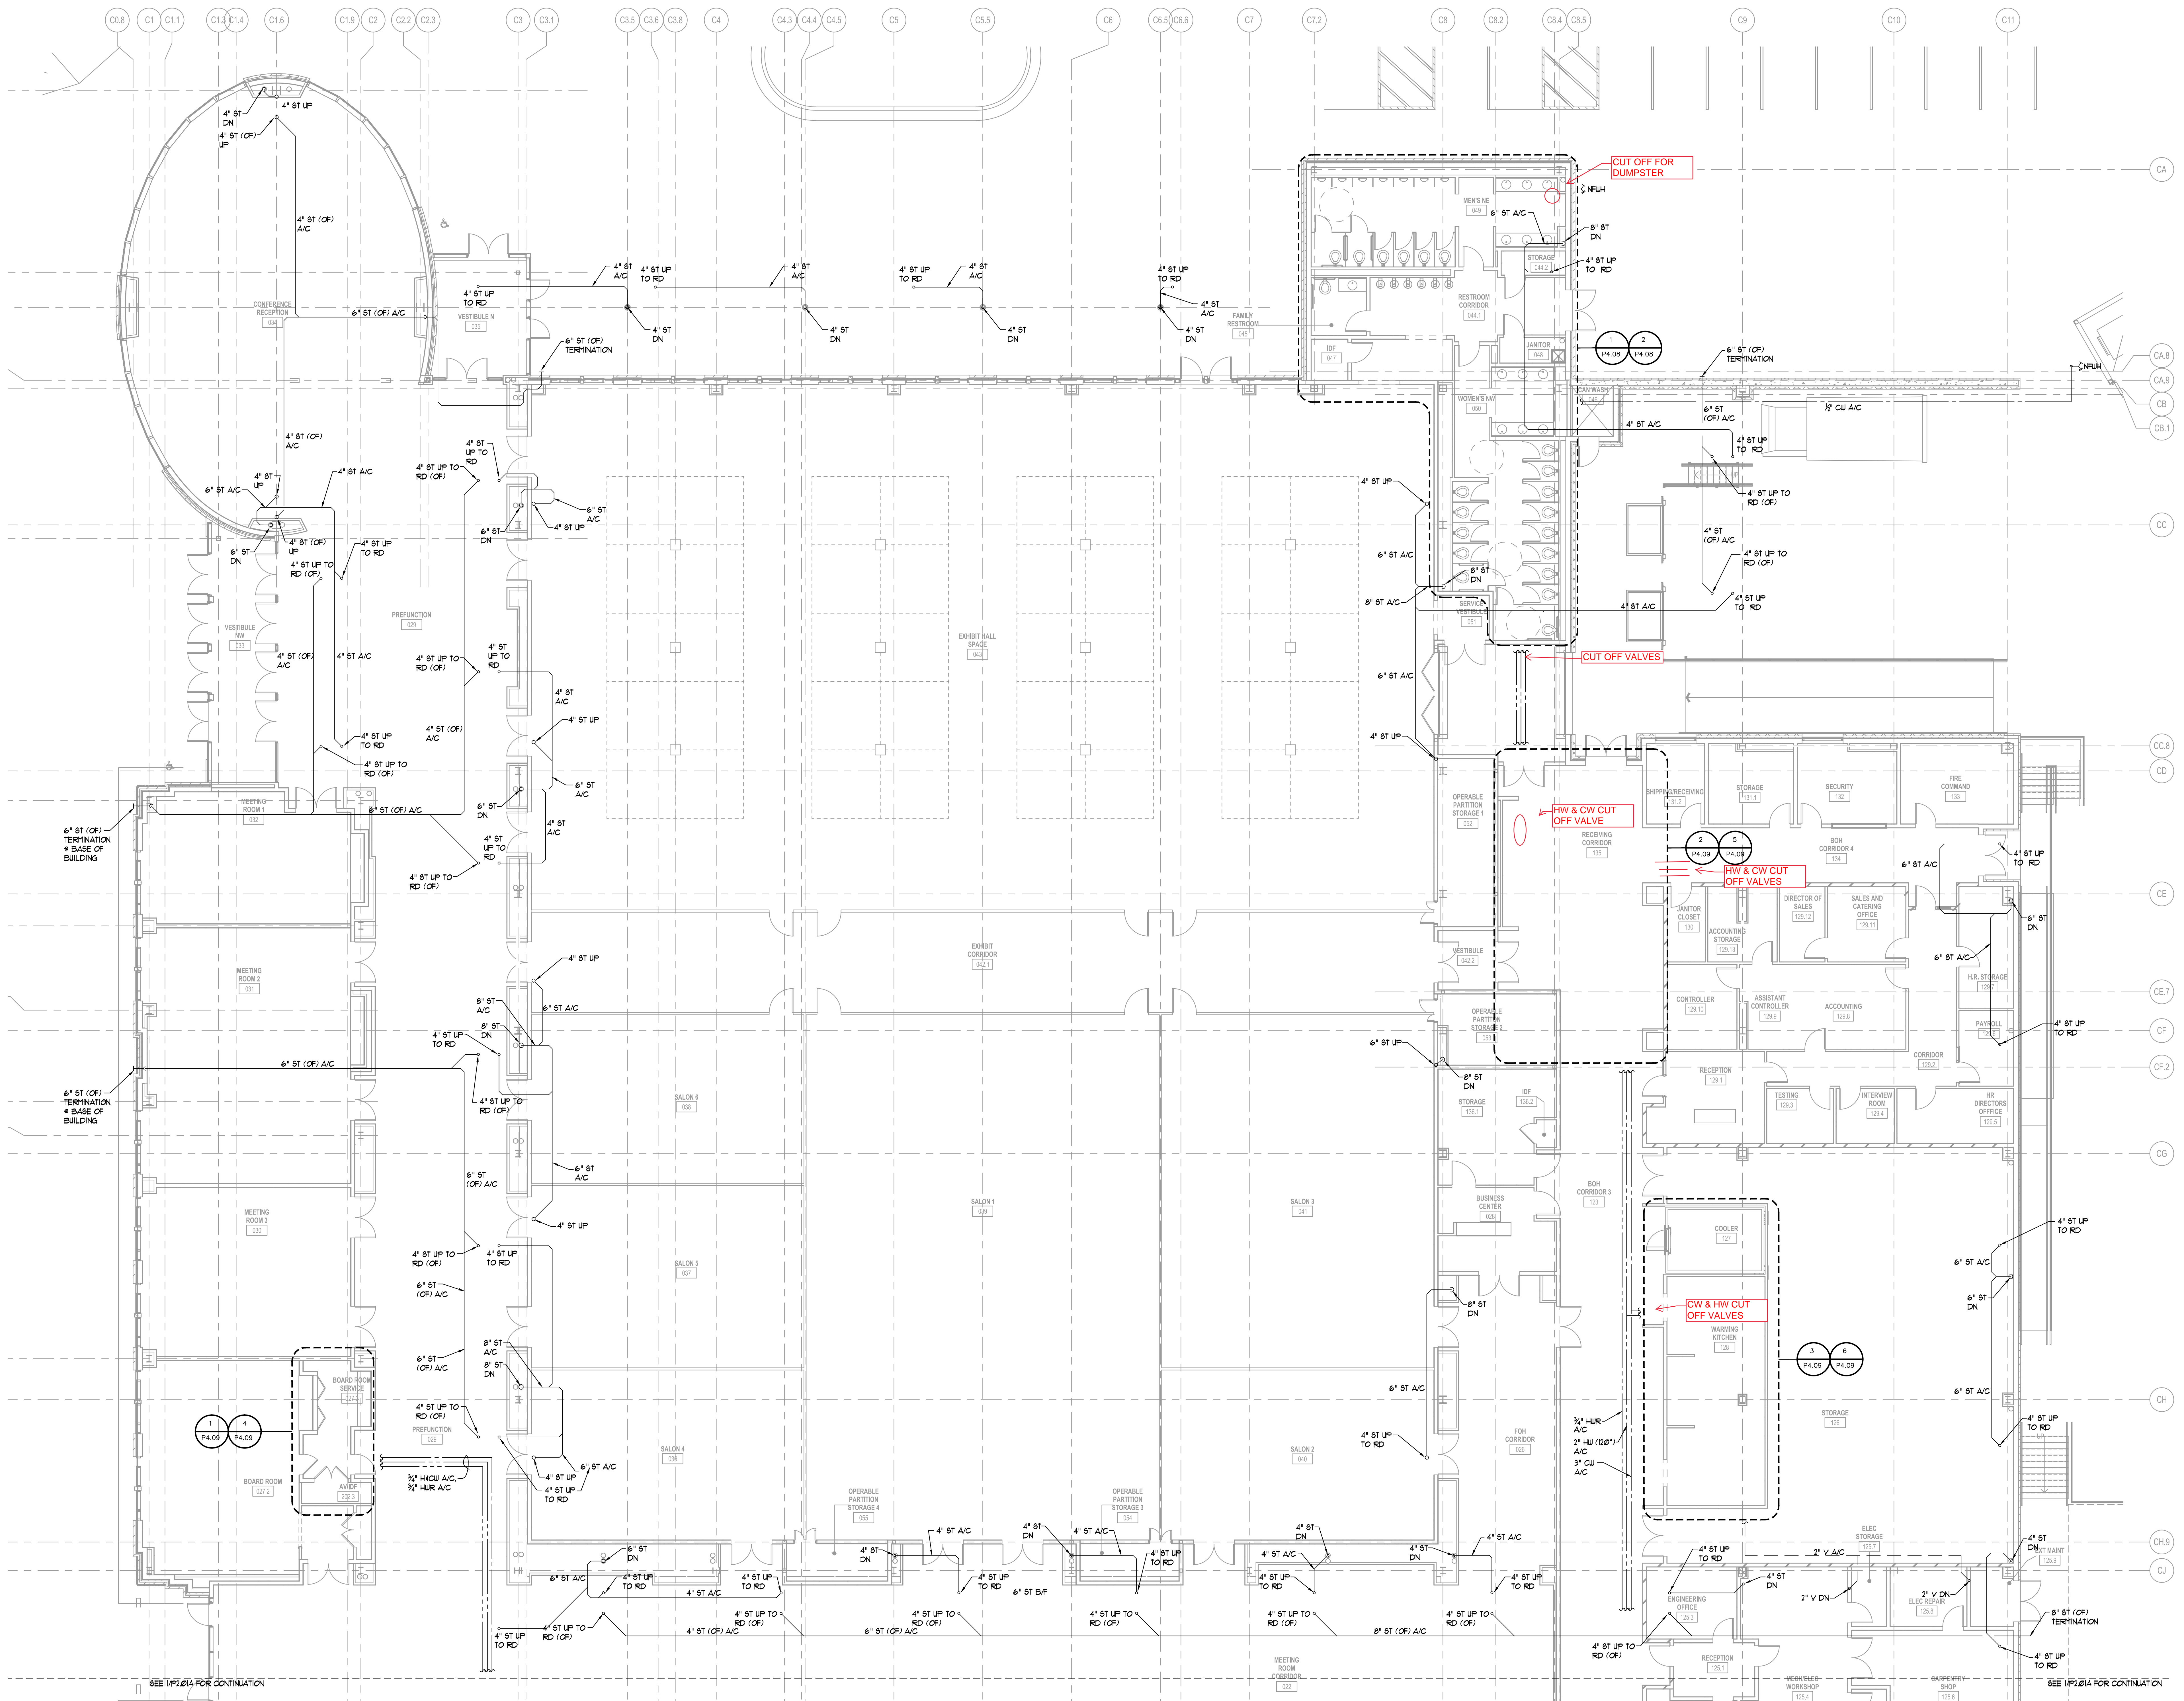

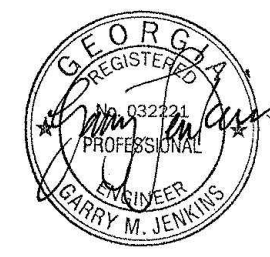

ISSUANCES		
No.	Drawing Issue Description	Date
	BUILDING PERMIT	2016.10.17

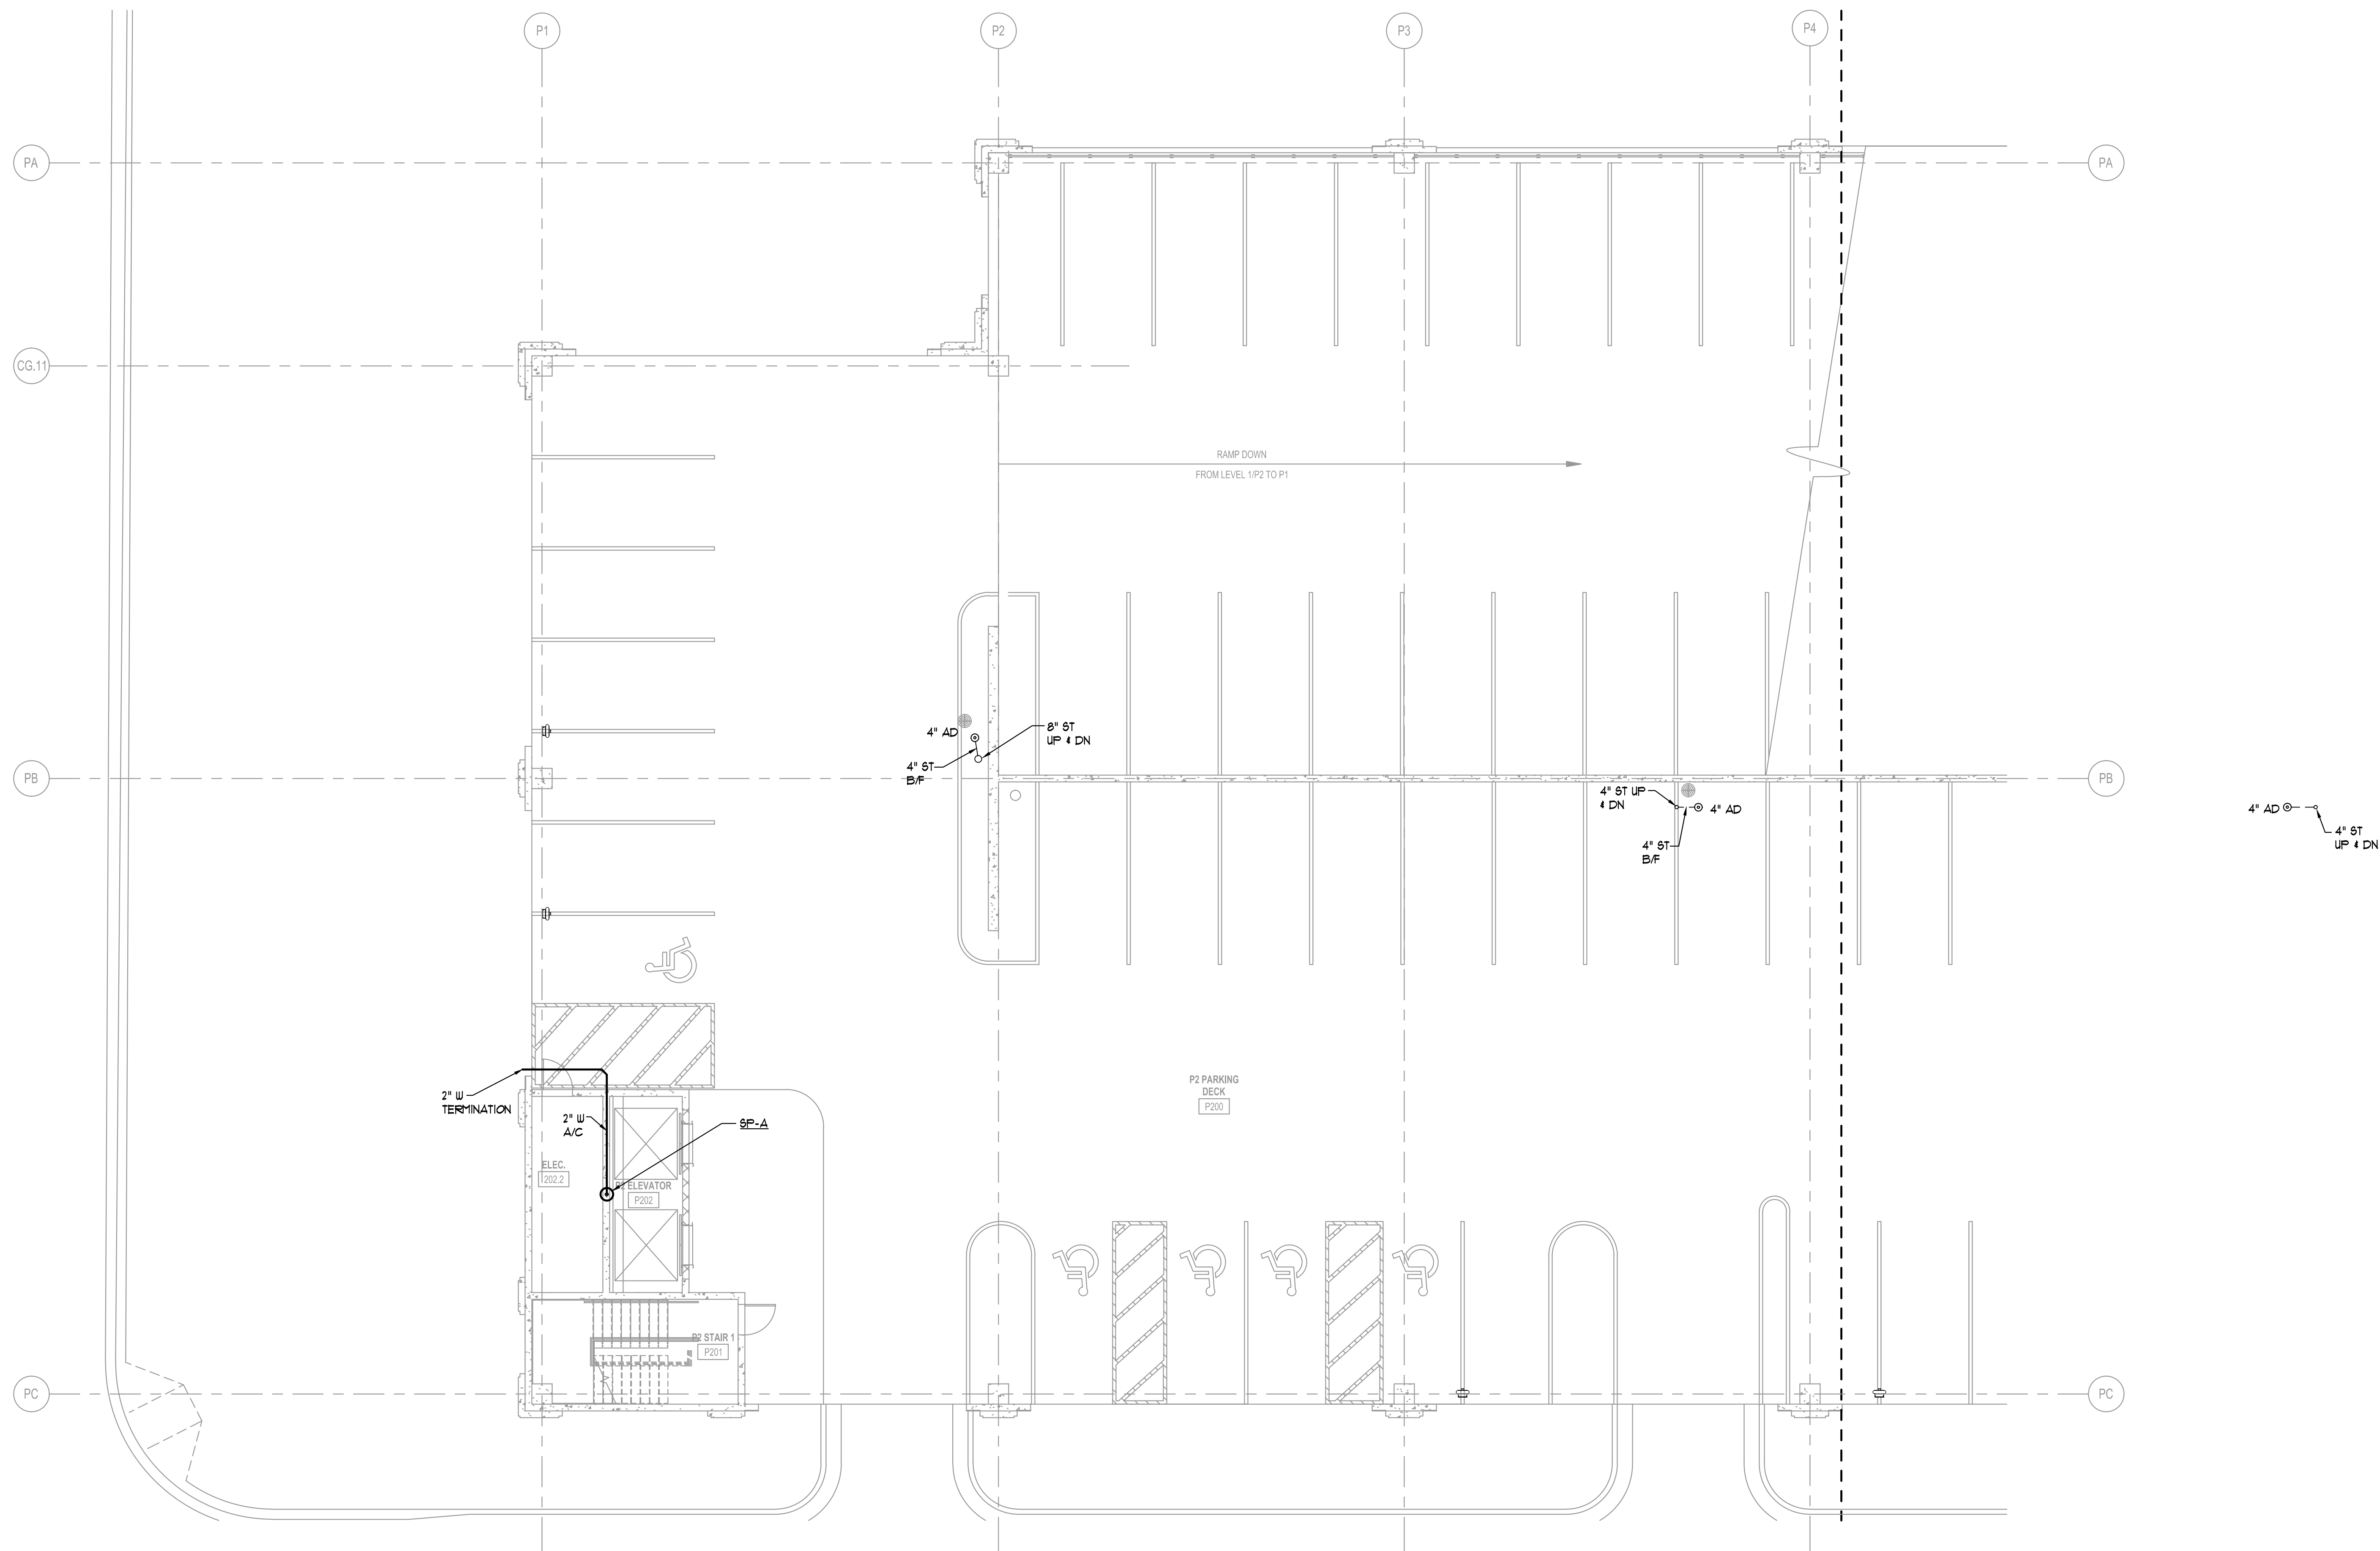

PROVIDE TRAFFIC RATED
AREA DRAINS AS LOCATED
ON ARCHITECTURAL PLANS

1 LEVEL P2 ZONE C — PLUMBING

1/8"=1'-0"

PROVIDE DRY STANDPIPES
PER NFPA 14/20A.

ALPHARETTA CONFERENCE CENTER & THE HOTEL AT AVALON


9000 AVALON BOULEVARD /
ALPHARETTA, GEORGIA 30009

STORMONT HOSPITALITY GROUP, LLC /
NORTH AMERICAN PROPERTY GROUP


LEVEL P2 ZONE C PLUMBING

K. PRICE	140028
Principal/Design	BW&A Project No.
G. JENKINS	101716
Project Engineer	Date
T. MERCER	
Drawn By	

P2.01C

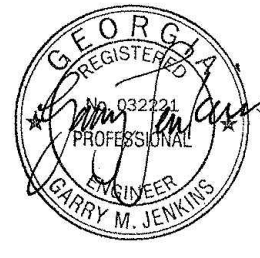

ISSUANCES		
No.	Drawing Issue Description	Date
1	BUILDING PERMIT	2016.10.17

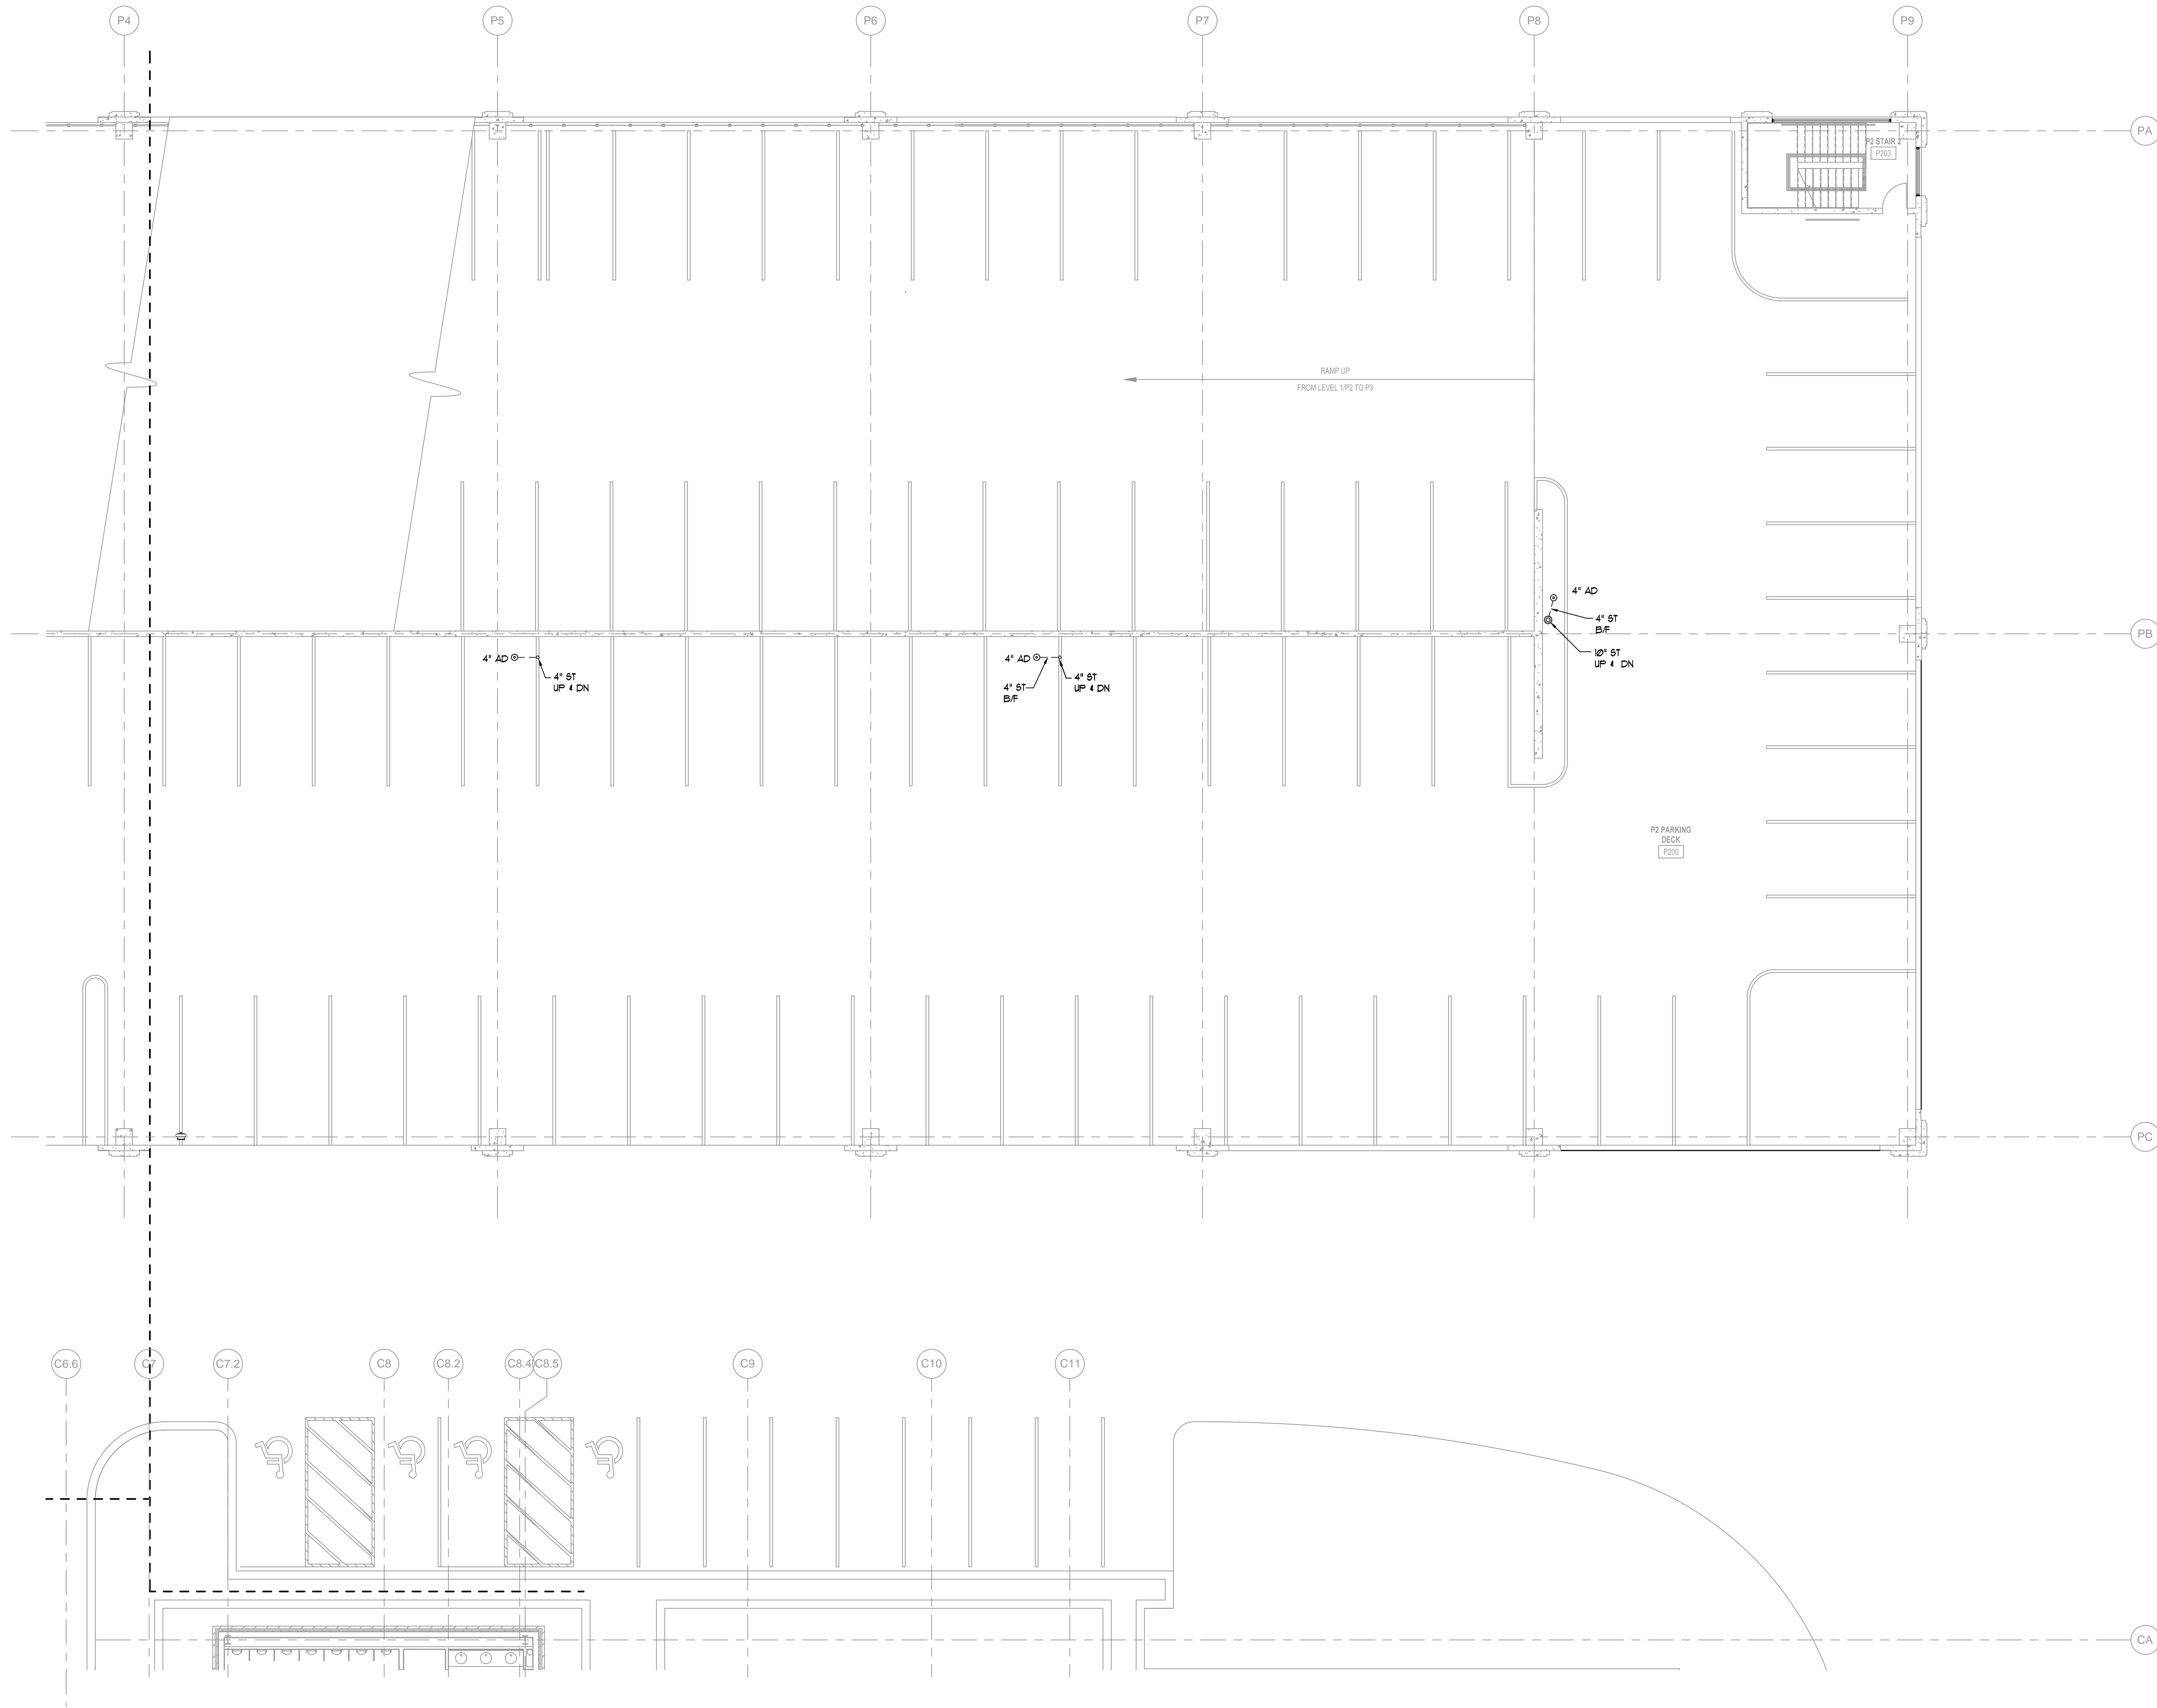

1 LEVEL P2 ZONE D - PLUMBING
1/8" = 1'-0"

PROVIDE TRAFFIC RATED
AREA DRAINS AS LOCATED
ON ARCHITECTURAL PLANS

PROVIDE DRY STANDPIPES
PER NFPA 14/88A

ALPHARETTA CONFERENCE
CENTER & THE HOTEL AT
AVALON


9000 AVALON BOULEVARD /
ALPHARETTA, GEORGIA 30009

STORMONT HOSPITALITY GROUP, LLC /
NORTH AMERICAN PROPERTY GROUP

LEVEL P2
ZONE D
PLUMBING

K. PRICE	140028
Principal-in-Charge	SH&A Project No.
G. JENKINS	101716
Project Engineer	Date
T. MERCER	
Checker	

P2.01D

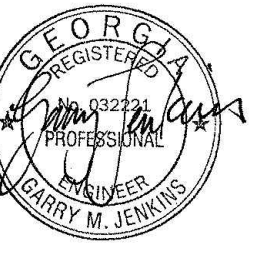

ISSUANCES		
No.	Drawing Issue Description	Date
1	BUILDING PERMIT	2016.10.17

1 LEVEL 2 ZONE A - PLUMBING

1/8" = 1'-0"

ALPHARETTA CONFERENCE CENTER & THE HOTEL AT AVALON

9000 AVALON BOULEVARD /
ALPHARETTA, GEORGIA 30009

STORMONT HOSPITALITY GROUP, LLC /
NORTH AMERICAN PROPERTY GROUP

LEVEL 2 - ZONE A PLUMBING

K. PRICE	140028
Principal in Charge	BWA Project No.
G. JENKINS	101716
Project Engineer	Date
T. MERCER	
Checker	

P2.02A



ISSUANCES		
No.	Drawing Issue Description	Date
1	BUILDING PERMIT	2016.10.17

ALPHARETTA CONFERENCE CENTER & THE HOTEL AT AVALON

9000 AVALON BOULEVARD /
ALPHARETTA, GEORGIA 30009

STORMONT HOSPITALITY GROUP, LLC /
NORTH AMERICAN PROPERTY GROUP

LEVEL 2 - ZONE B PLUMBING


K. PRICE	140028
Principal in Charge	BW&A Project No.
G. JENKINS	101716
Project Engineer	Date
T. MERCER	
Checker	


P2.02B

ISSUED FOR CONSTRUCTION

1 LEVEL 2 ZONE B - PLUMBING


P2.02B 1/8" = 1'-0"

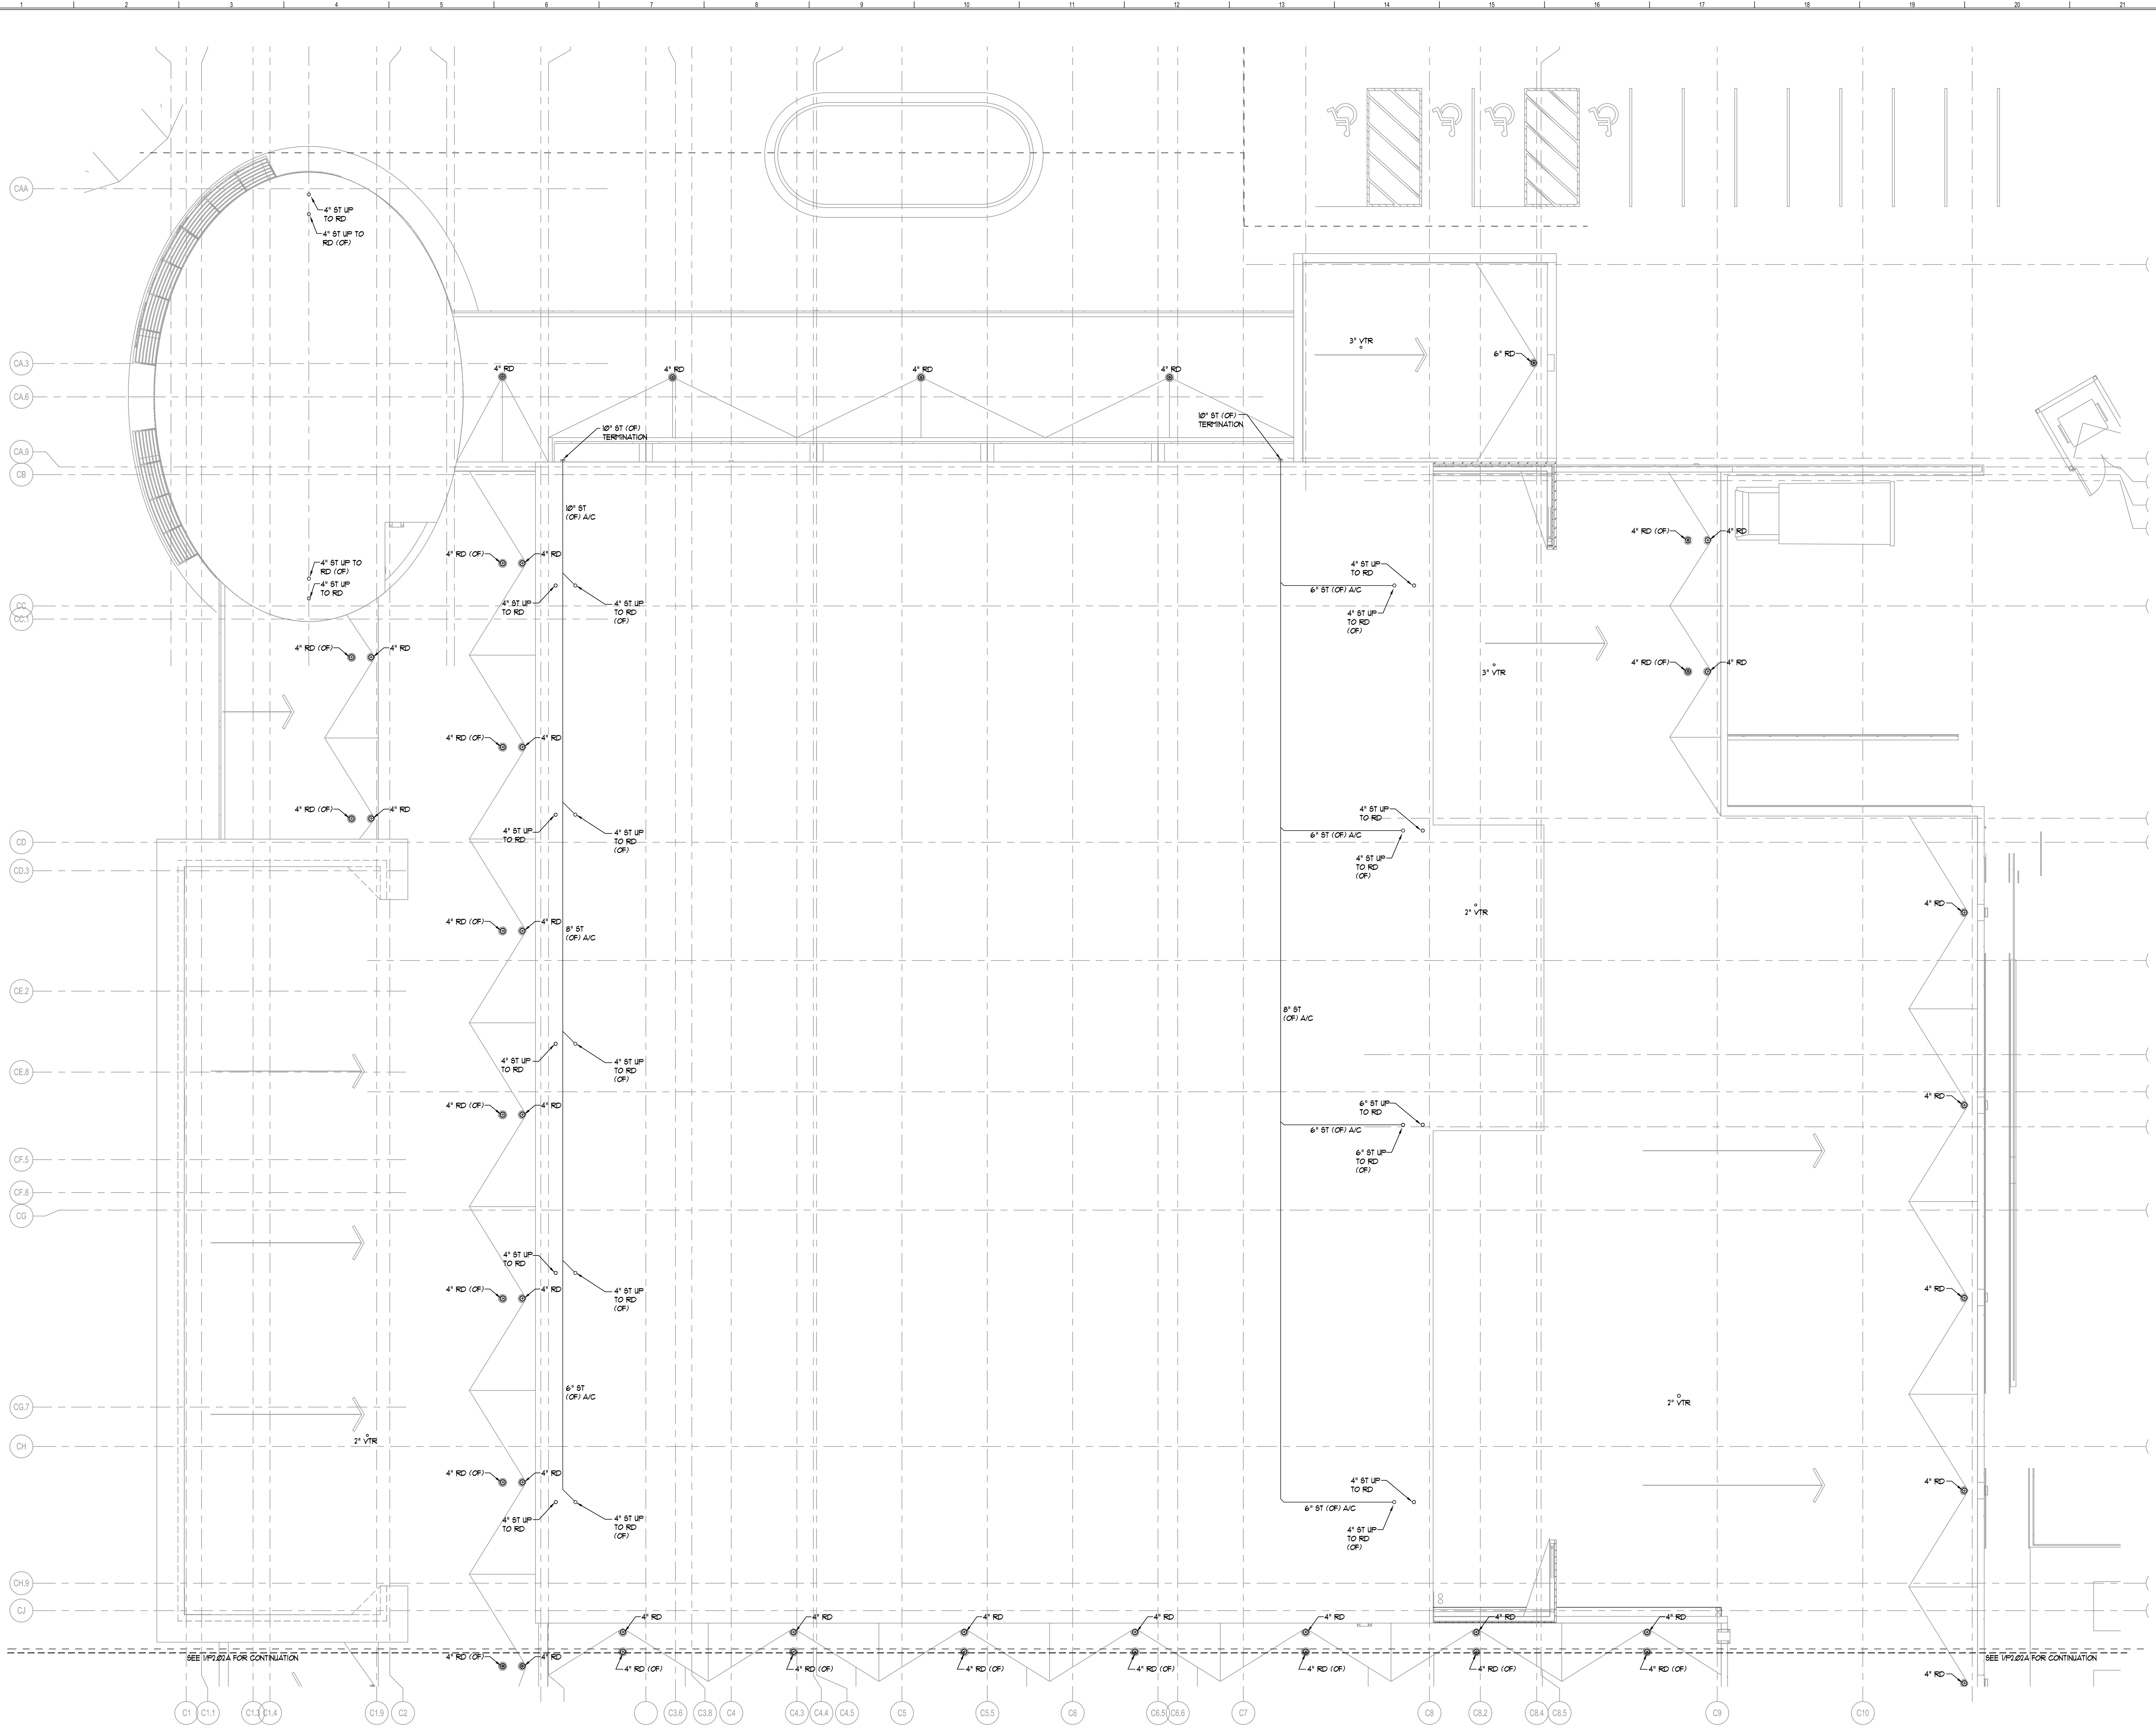

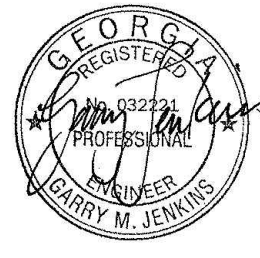

ISSUANCES

No.	Drawing Issue Description	Date
	BUILDING PERMIT	2016.10.17

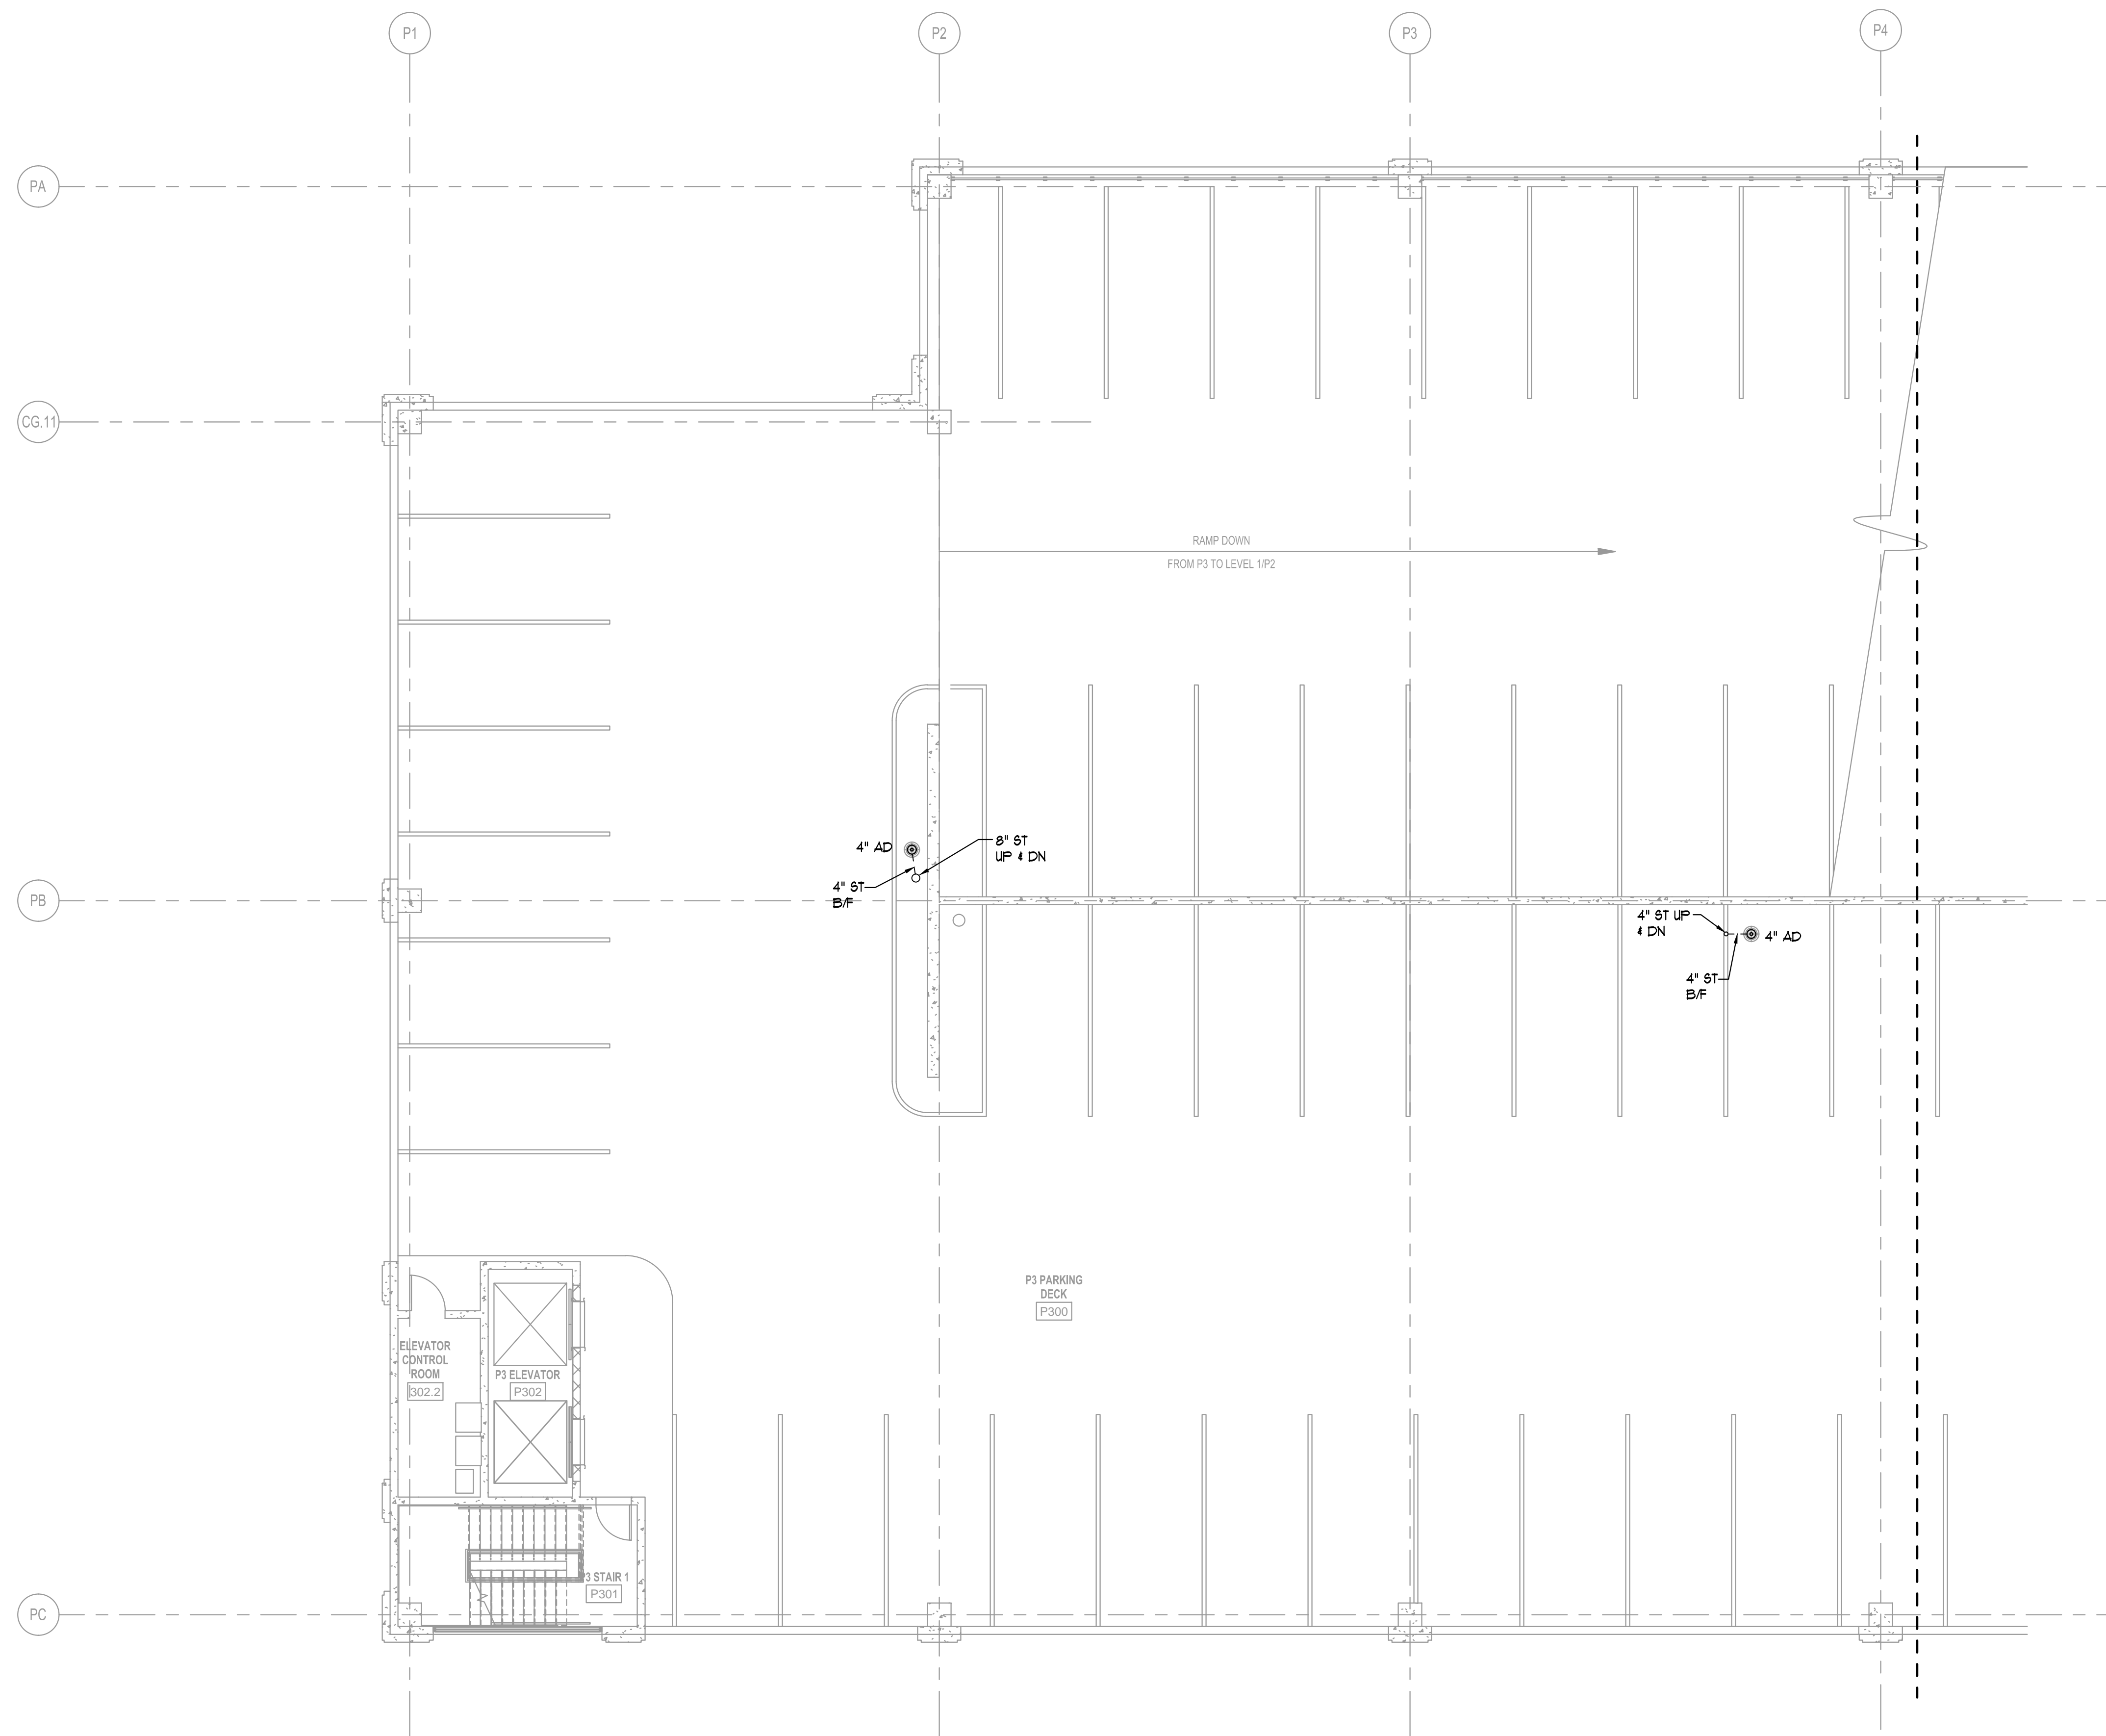

PROVIDE TRAFFIC RATED
AREA DRAINS AS LOCATED
ON ARCHITECTURAL PLANS

1
P2.02C 1/8"=1'-0" **LEVEL P3 ZONE C — PLUMBING**

PROVIDE DRY STANDPIPES
PER NFPA 14/86A

**ALPHARETTA CONFERENCE
CENTER & THE HOTEL AT
AVALON**


9000 AVALON BOULEVARD /
ALPHARETTA, GEORGIA 30009

STORMONT HOSPITALITY GROUP, LLC /
NORTH AMERICAN PROPERTY GROUP


**LEVEL P3
ZONE C
PLUMBING**

K. PRICE	140028
Principal-in-Charge	BW&A Project No.
G. JENKINS	101716
Project Engineer	Date
T. MERCER	
Drawn By	

P2.02C

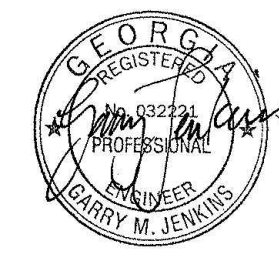

ISSUANCES		
No.	Drawing Issue Description	Date
	BUILDING PERMIT	2016.10.17

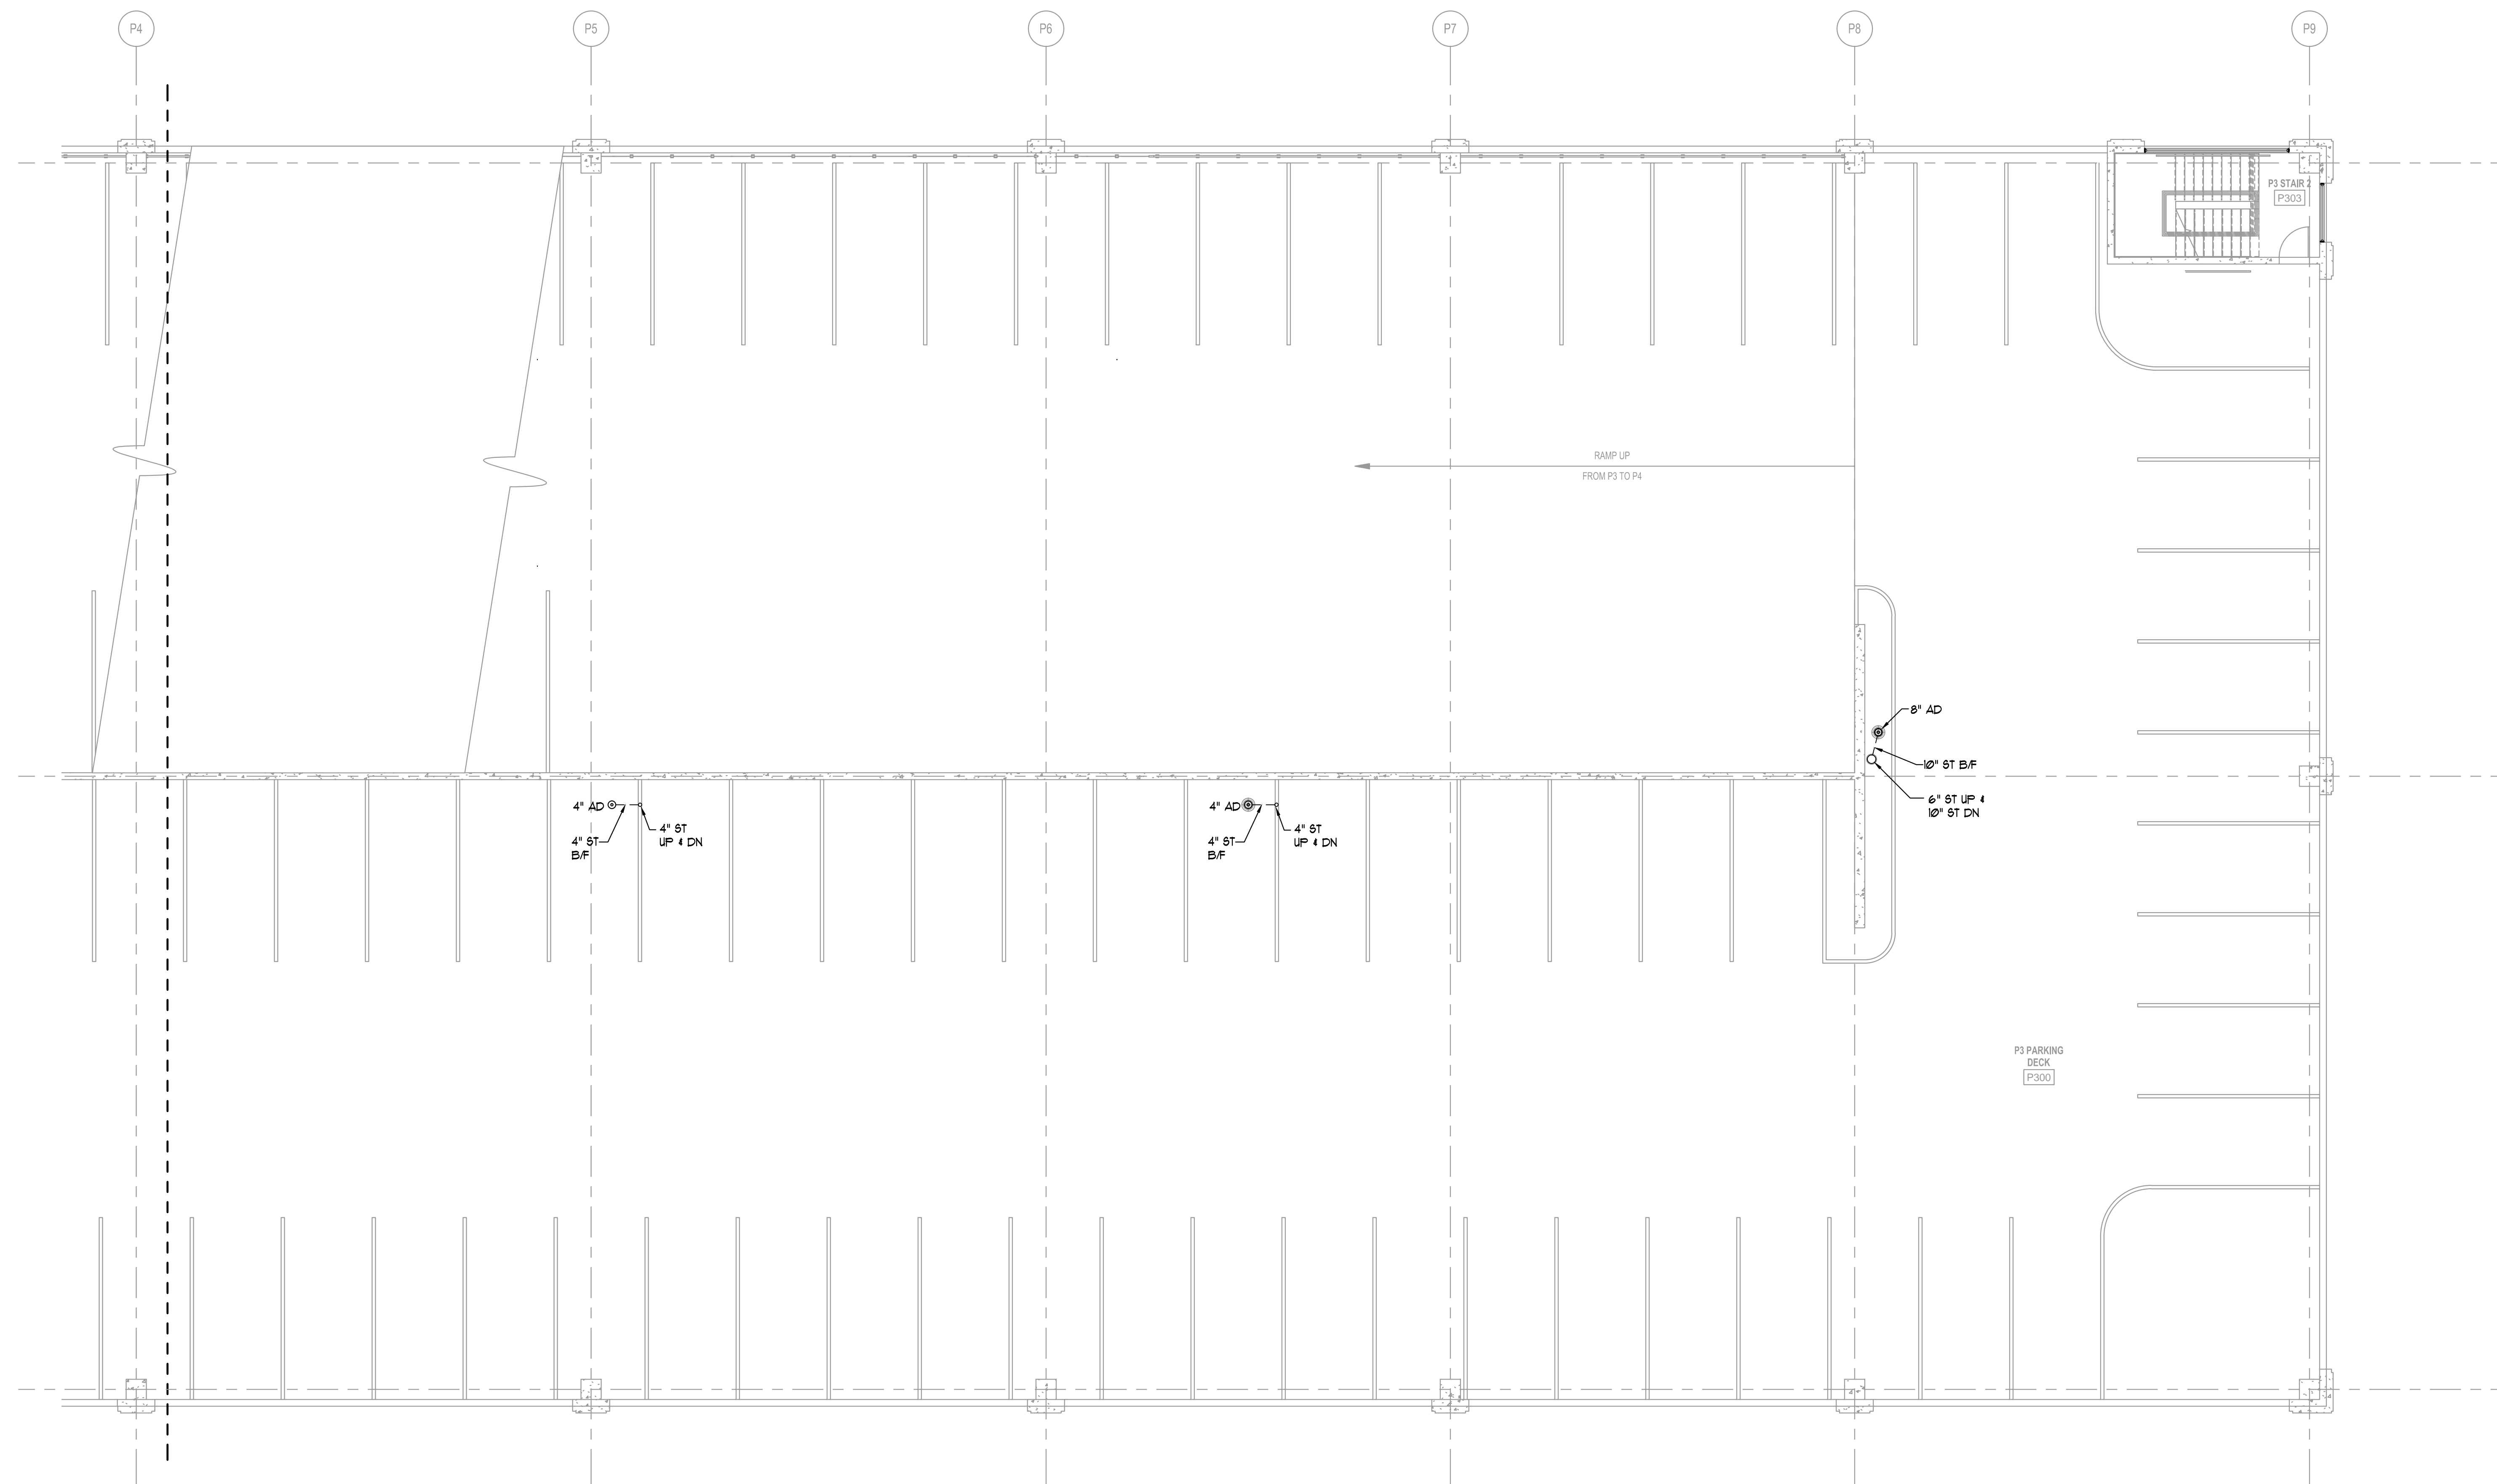

PROVIDE TRAFFIC RATED
AREA DRAINS AS LOCATED
ON ARCHITECTURAL PLANS

1
P2.02D
LEVEL P3 ZONE D — PLUMBING
1/8"=1'-0"

PROVIDE DRY STANDPIPES
PER NFPA 14.8.6A.

ALPHARETTA CONFERENCE
CENTER & THE HOTEL AT
AVALON


9000 AVALON BOULEVARD /
ALPHARETTA, GEORGIA 30009

STORMONT HOSPITALITY GROUP, LLC /
NORTH AMERICAN PROPERTY GROUP

LEVEL P3
ZONE D
PLUMBING


K. PRICE	140028
Principal-in-Charge	BW&A Project No.
G. JENKINS	101716
Project Engineer	Date
T. MERCER	
Checker	

P2.02D

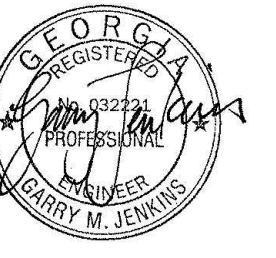

ISSUANCES

No.	Drawing Issue Description	Date
1	BUILDING PERMIT	2016.10.17

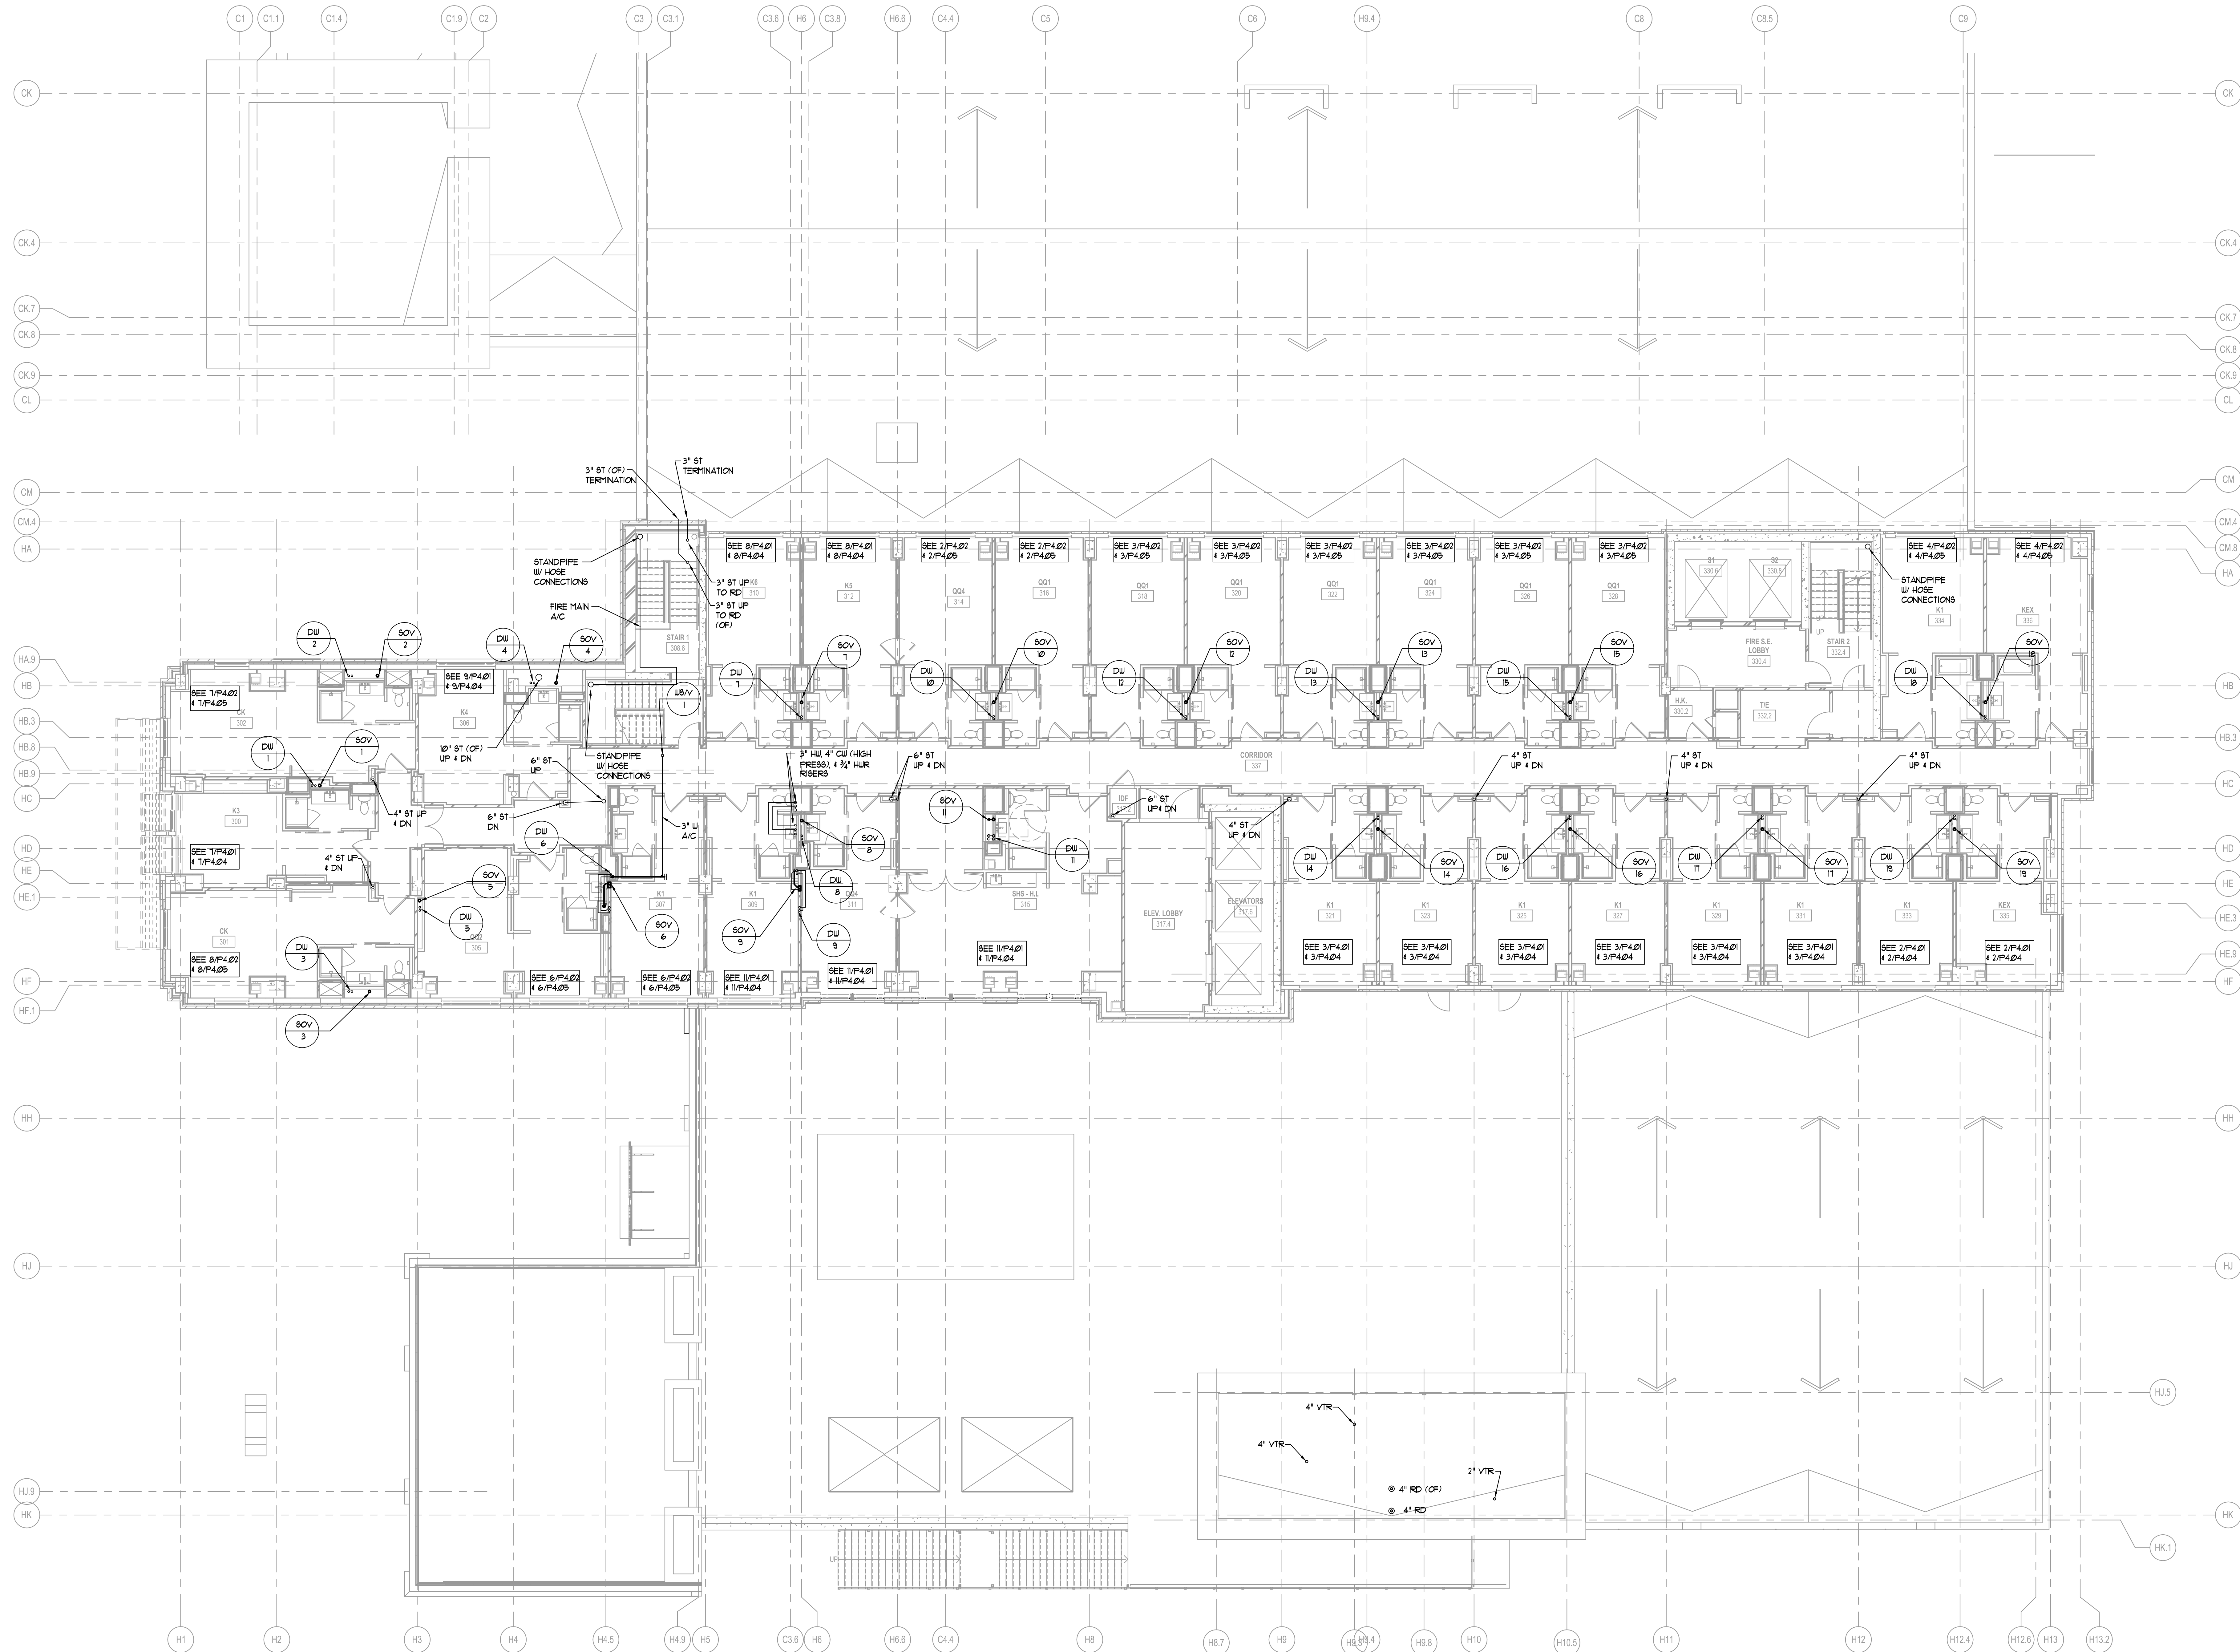

1 LEVEL 3 ZONE A - PLUMBING
P2.03A 1/8" = 1'-0"

ALPHARETTA CONFERENCE CENTER & THE HOTEL AT AVALON


9000 AVALON BOULEVARD /
ALPHARETTA, GEORGIA 30009

STORMONT HOSPITALITY GROUP, LLC /
NORTH AMERICAN PROPERTY GROUP

LEVEL 3 - ZONE A PLUMBING

K. PRICE	140028
Principal in Charge	SH&A Project No.
G. JENKINS	101716
Project Engineer	Date
T. MERCER	
Checker	

P2.03A

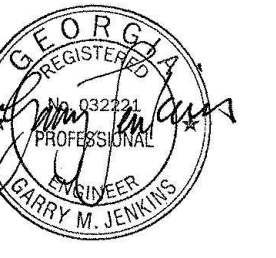

ISSUANCES

No.	Drawing Issue Description	Date
1	BUILDING PERMIT	2016.10.17

ALPHARETTA CONFERENCE
CENTER & THE HOTEL AT
AVALON

9000 AVALON BOULEVARD /
ALPHARETTA, GEORGIA 30009

STORMONT HOSPITALITY GROUP, LLC /
NORTH AMERICAN PROPERTY GROUP


LEVEL 3 - ZONE B
PLUMBING

K. PRICE	140028
Principal-in-Charge	BW&A Project No.
G. JENKINS	101716
Project Engineer	Date
T. MERCER	
Checker	

P2.03B


ISSUED FOR CONSTRUCTION

1 LEVEL 3 - ZONE B PLUMBING
P2.03B 1/8" = 1'-0"

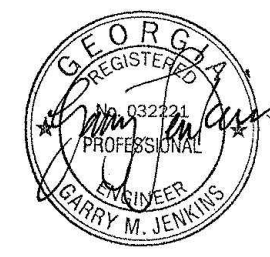

ISSUANCES

No.	Drawing Issue Description	Date
1	BUILDING PERMIT	2016.10.17

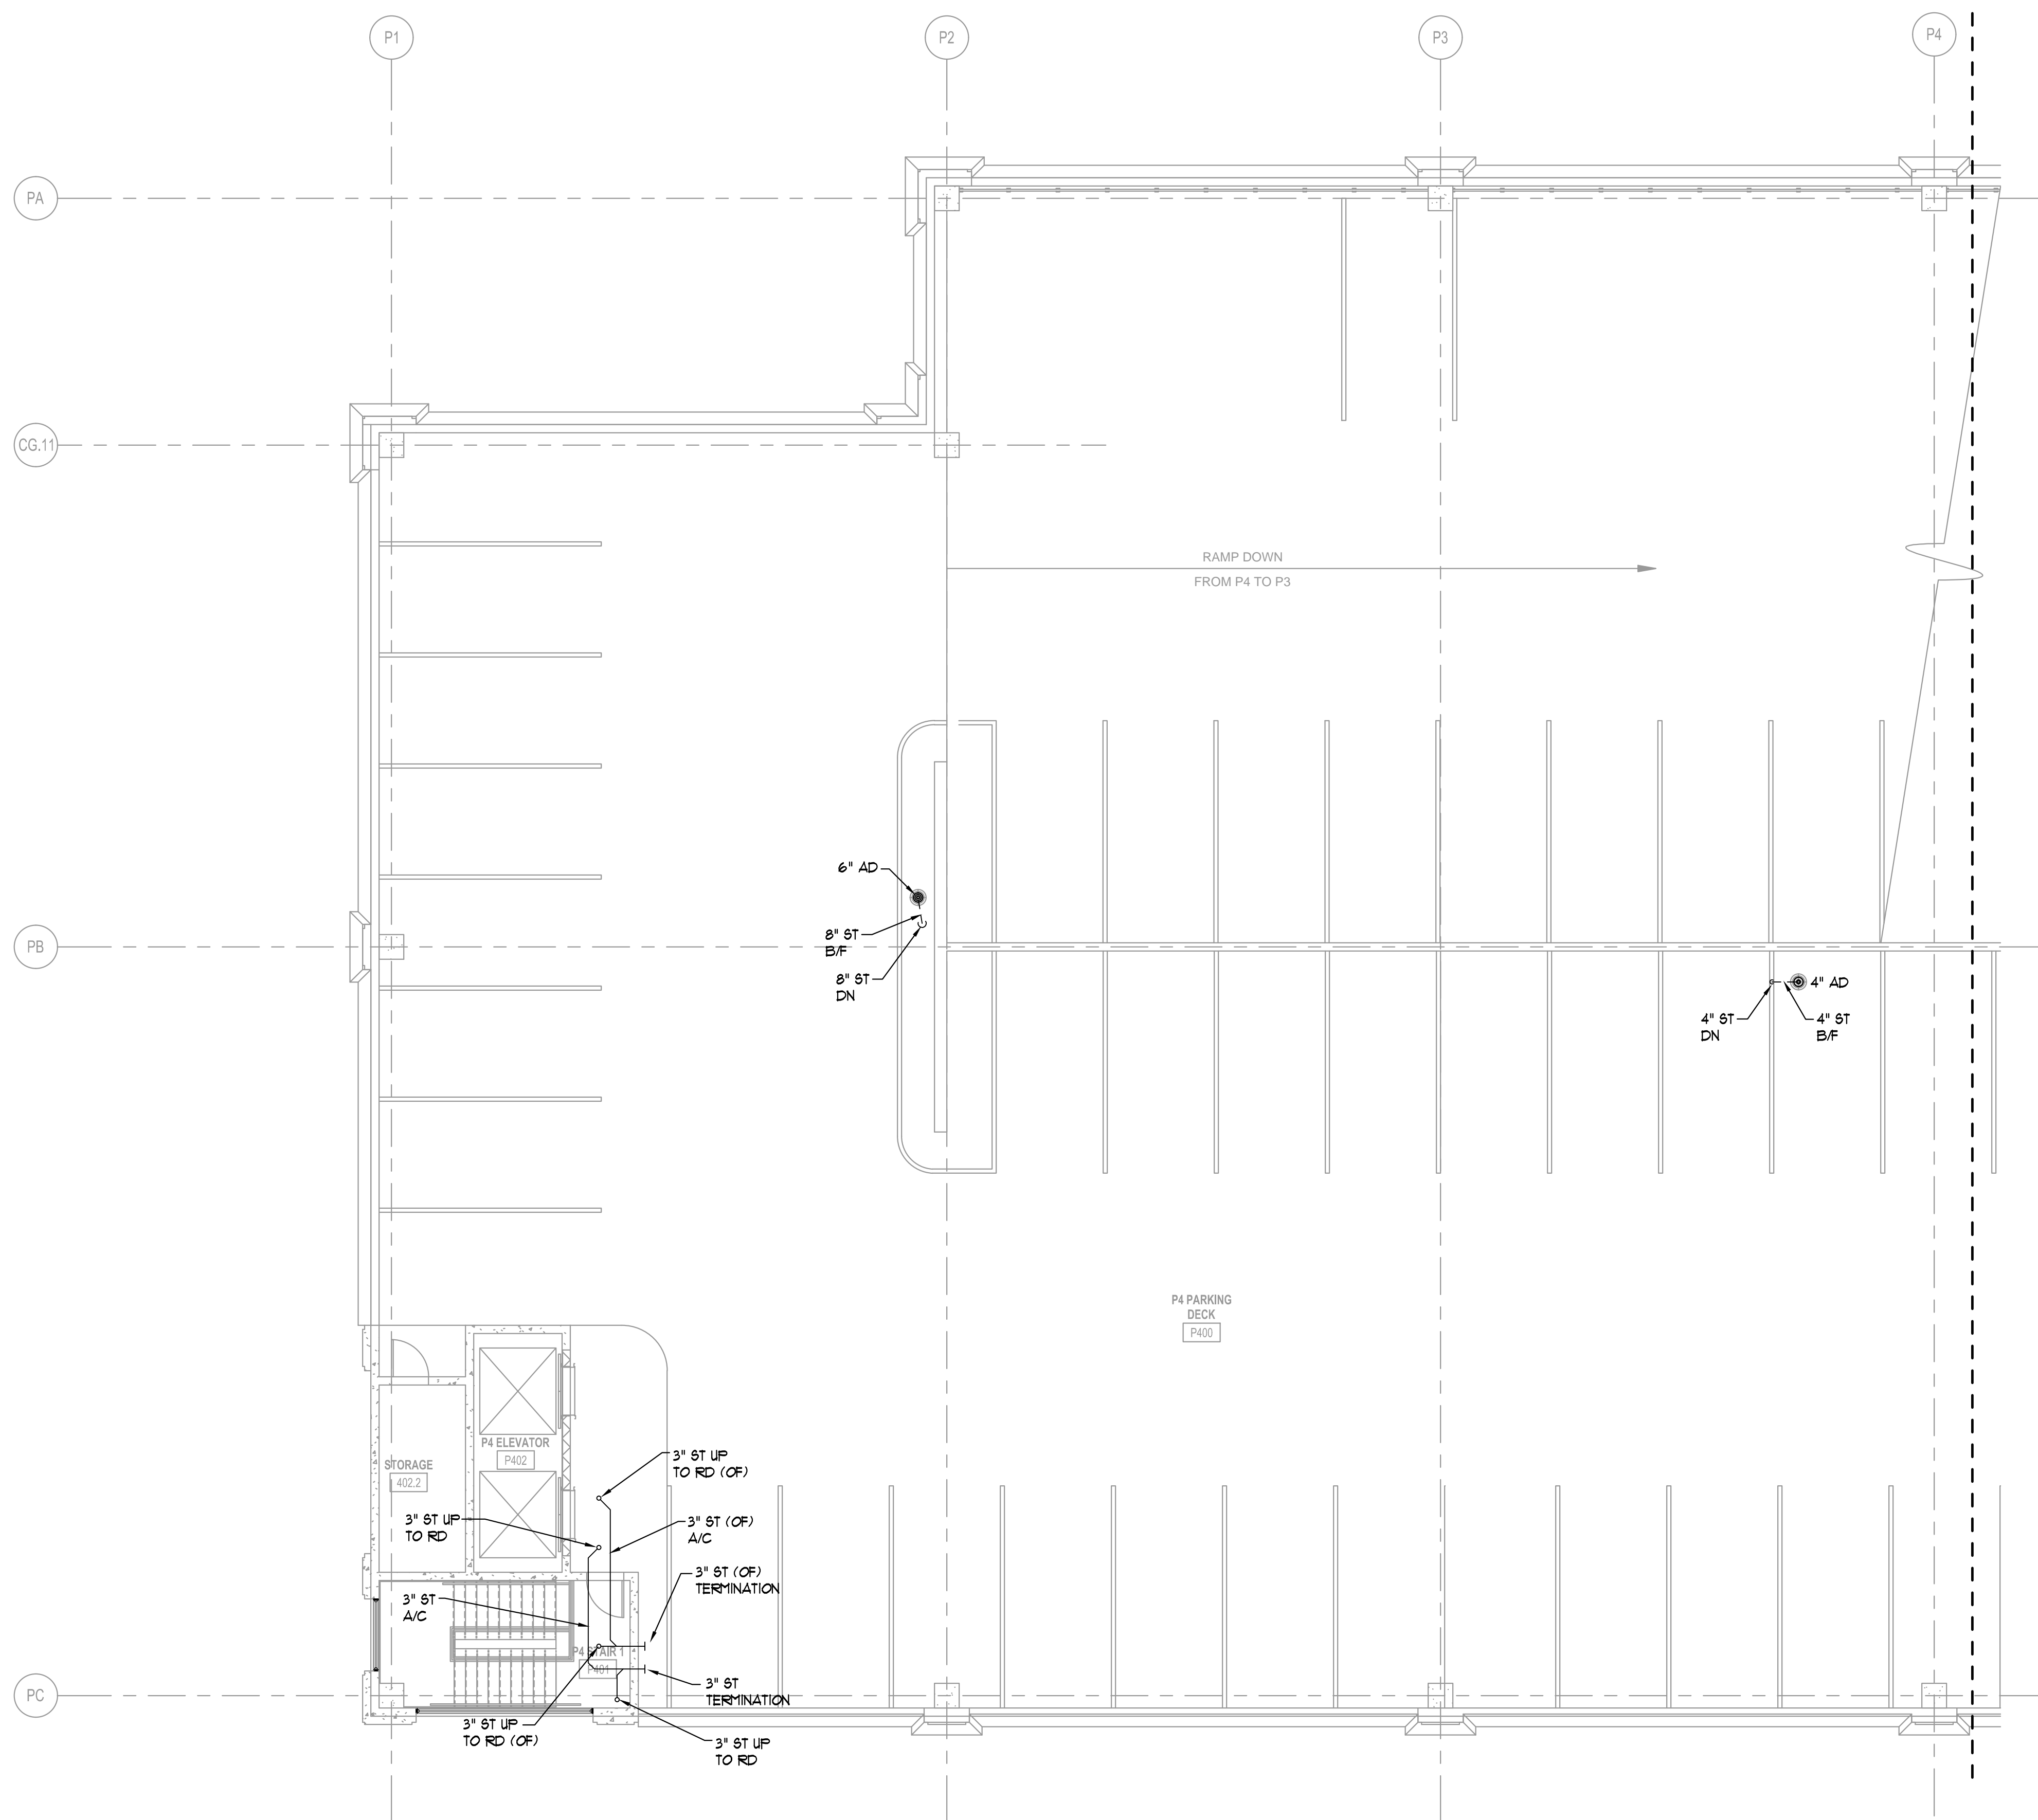

PROVIDE TRAFFIC RATED
AREA DRAINS AS LOCATED
ON ARCHITECTURAL PLANS

1
P2.03C
LEVEL P4 ZONE C — PLUMBING
1/8"=1'-0"

PROVIDE DRY STANDPIPES
PER NFPA 14/86A.

ALPHARETTA CONFERENCE
CENTER & THE HOTEL AT
AVALON


9000 AVALON BOULEVARD /
ALPHARETTA, GEORGIA 30009

▲
STORMONT HOSPITALITY GROUP, LLC /
NORTH AMERICAN PROPERTY GROUP


LEVEL P4
ZONE C
PLUMBING

K. PRICE	140028
Principal-in-Charge	SH&A Project No.
G. JENKINS	101716
Project Engineer	Date
T. MERCER	
Drawn By	

P2.03C

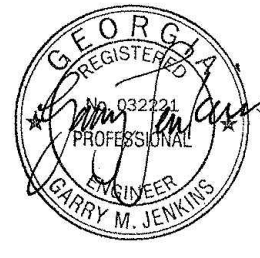

ISSUANCES		
No.	Drawing Issue Description	Date
	BUILDING PERMIT	2016.10.17

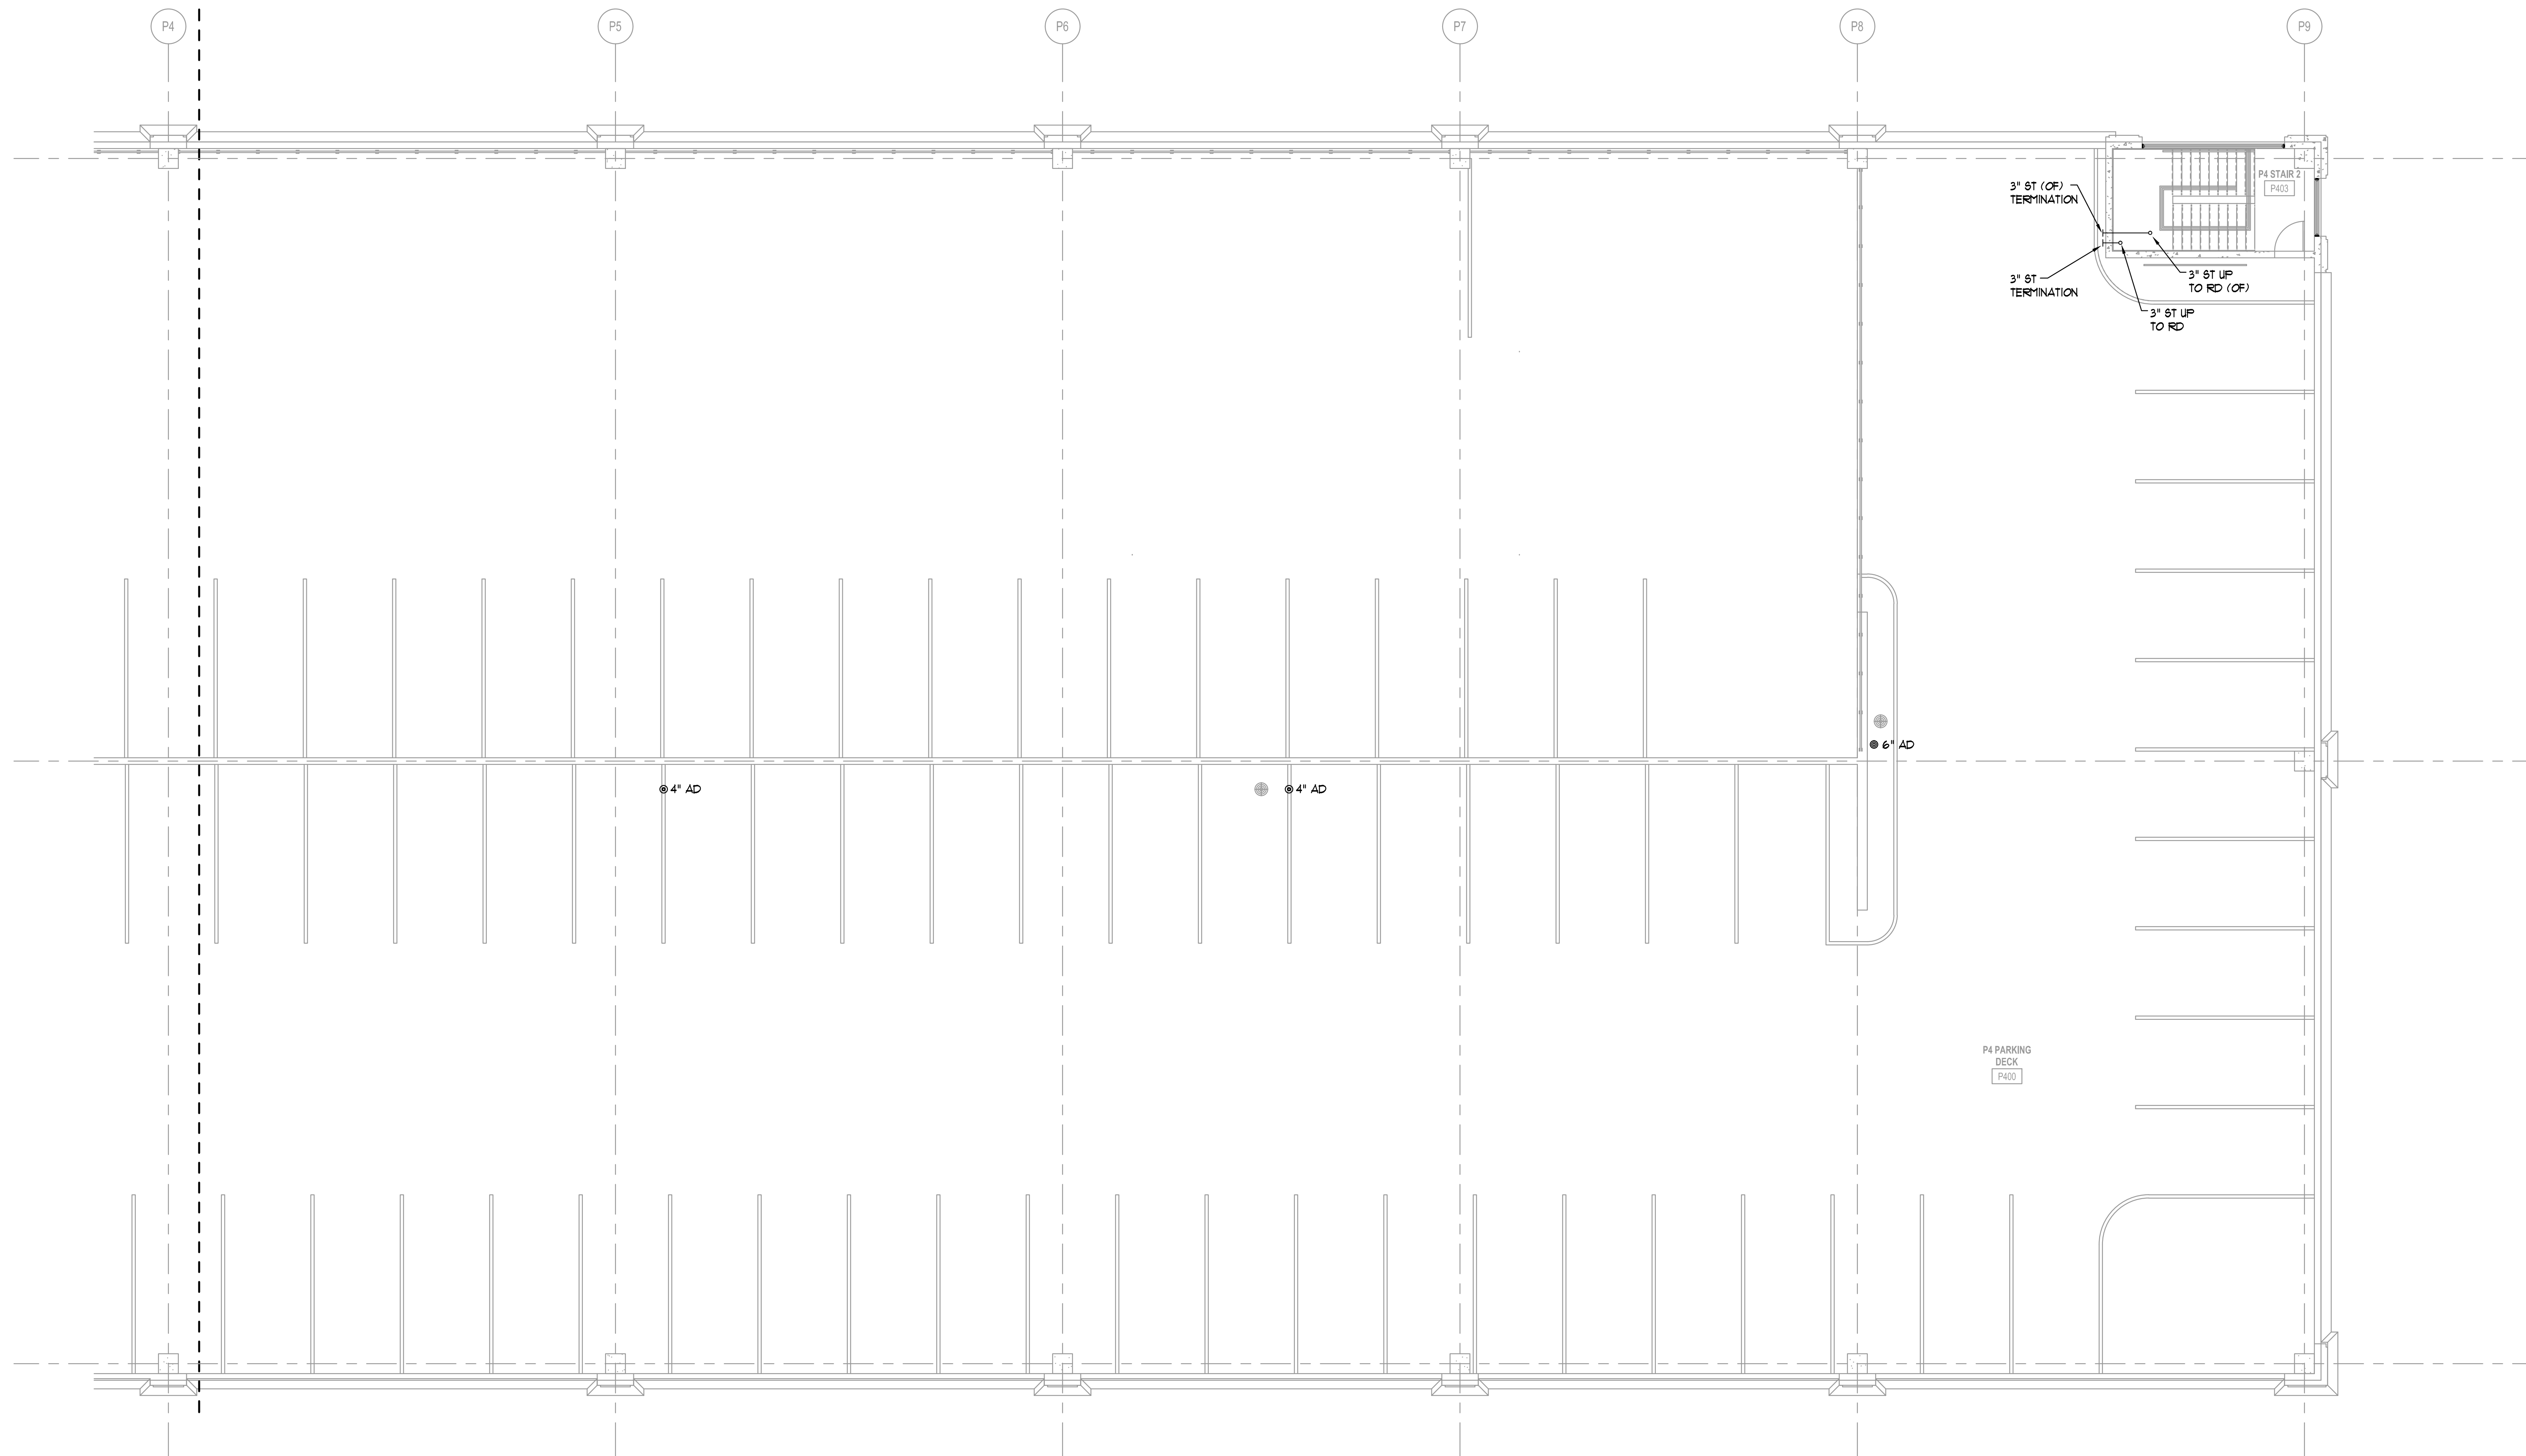

PROVIDE TRAFFIC RATED
AREA DRAINS AS LOCATED
ON ARCHITECTURAL PLANS

LEVEL P4 ZONE D — PLUMBING

PROVIDE DRY STANDPIPES
PER NFPA 1406A

**ALPHARETTA CONFERENCE
CENTER & THE HOTEL AT
AVALON**


9000 AVALON BOULEVARD /
ALPHARETTA, GEORGIA 30009

STORMONT HOSPITALITY GROUP, LLC /
NORTH AMERICAN PROPERTY GROUP

**LEVEL P4
ZONE D
PLUMBING**


K. PRICE	140028
Principal-in-Charge	BW&A Project No.
G. JENKINS	101716
Project Engineer	Date
T. MERCER	
Checker	

P2.03D

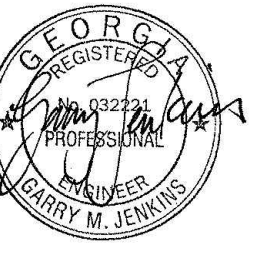


ISSUANCES

No.	Drawing Issue Description	Date
1	BUILDING PERMIT	2016.10.17

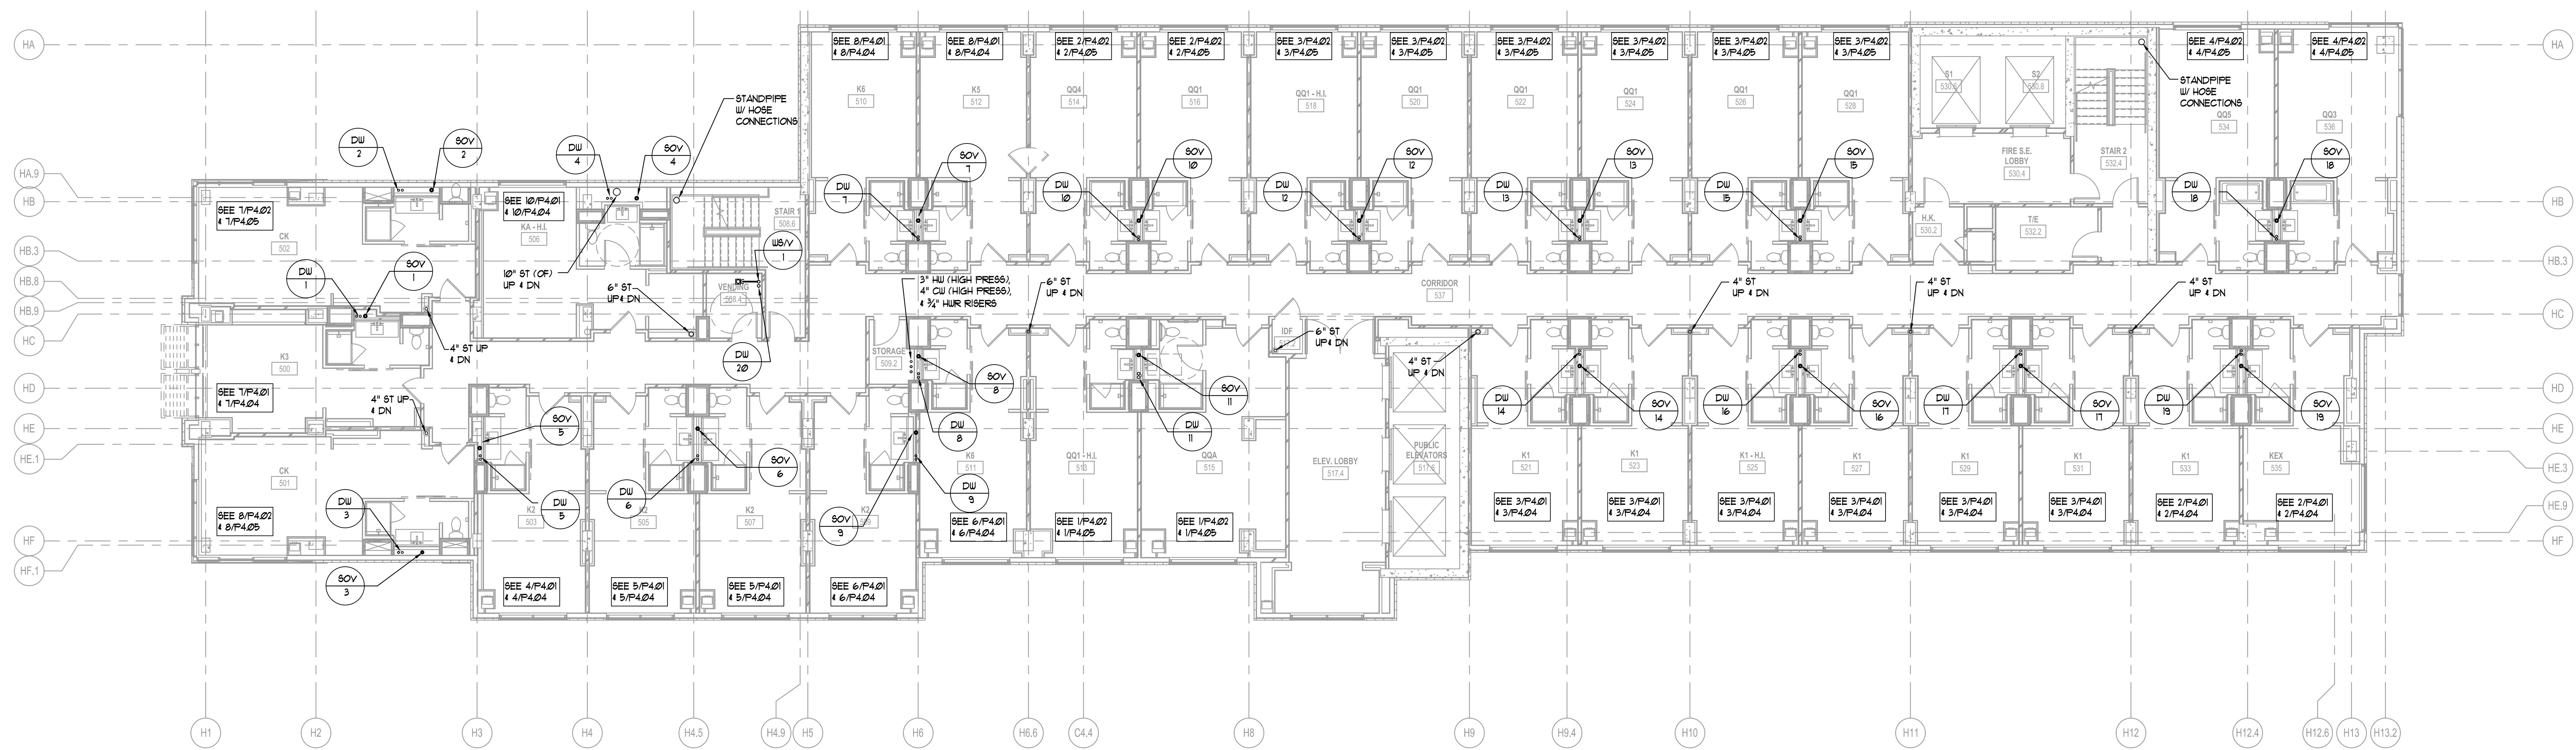

2 LEVEL 5 GUESTROOMS — PLUMBING
P2.04 1/8" = 1'-0"

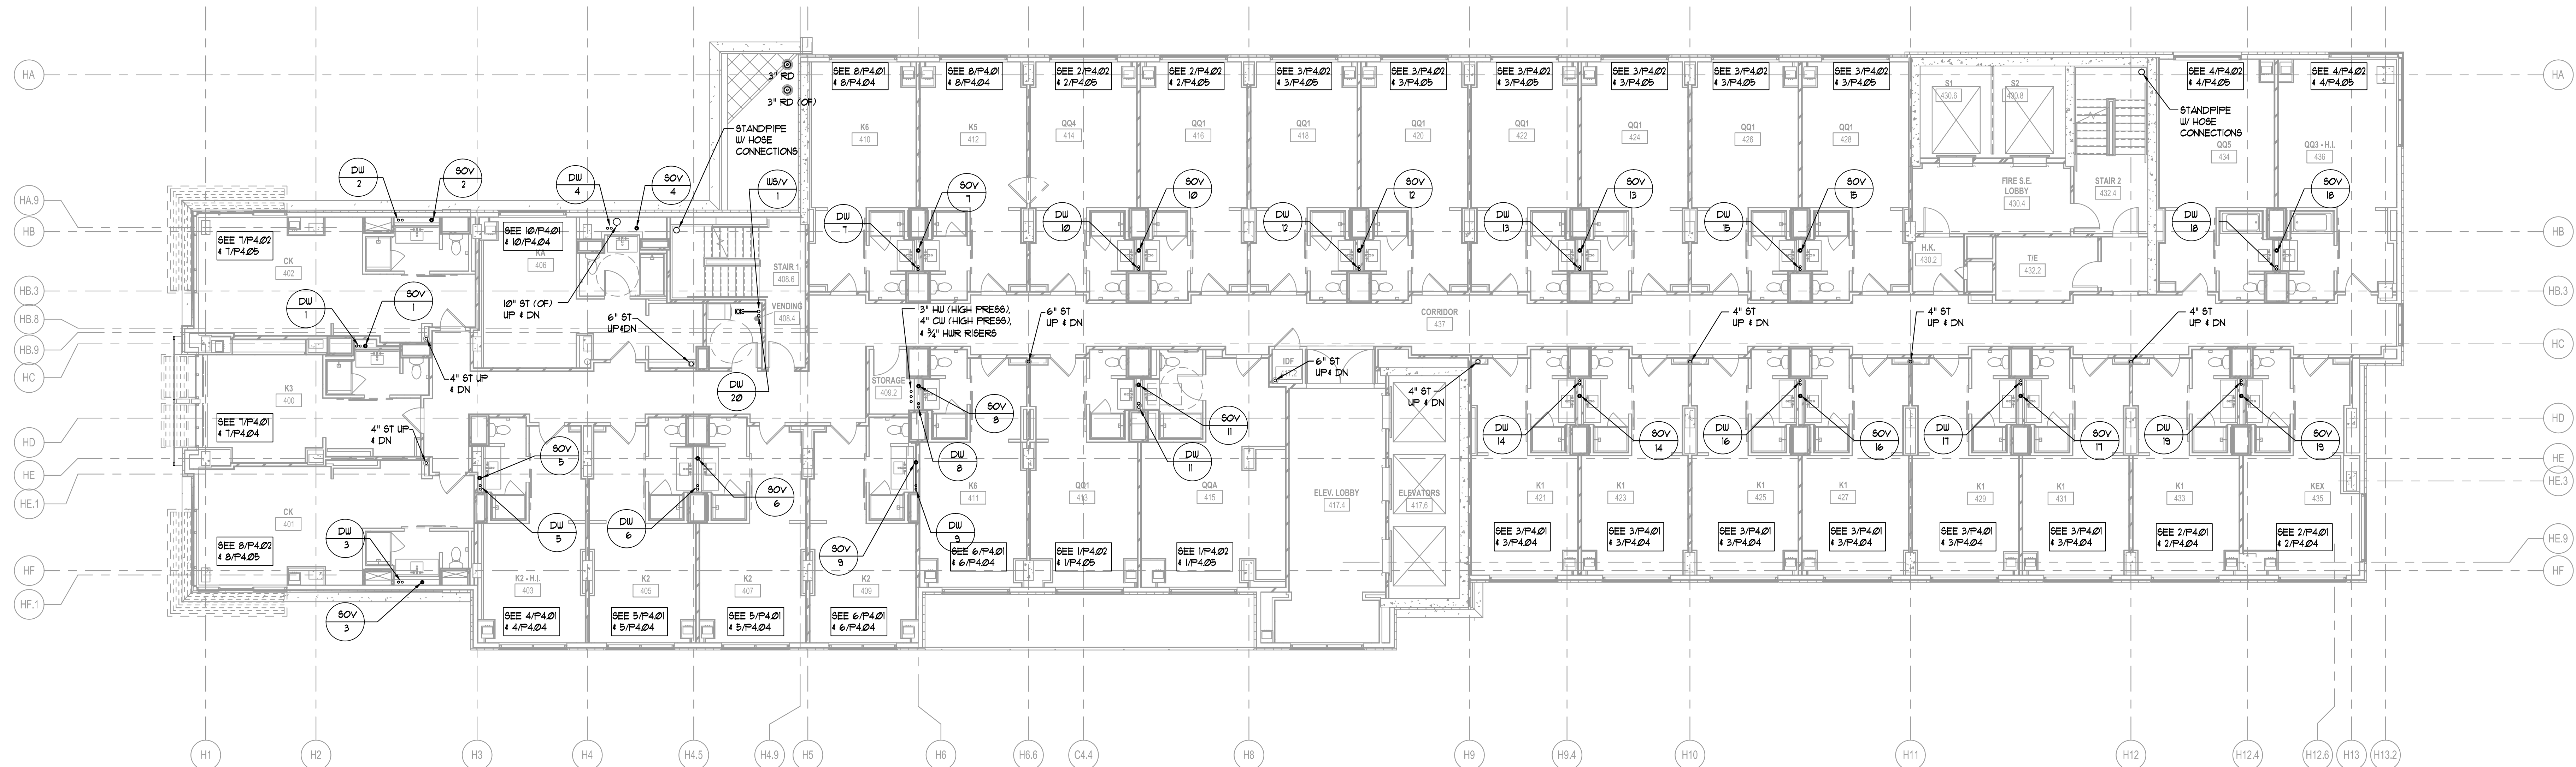

1 LEVEL 4 GUESTROOMS — PLUMBING
P2.04 1/8" = 1'-0"

ALPHARETTA CONFERENCE CENTER & THE HOTEL AT AVALON


9000 AVALON BOULEVARD /
ALPHARETTA, GEORGIA 30009

STORMONT HOSPITALITY GROUP, LLC /
NORTH AMERICAN PROPERTY GROUP


LEVEL 4 & 5 GUESTROOMS PLUMBING

K. PRICE	140028
Principal in Charge	BW&A Project No.
G. JENKINS	101716
Project Engineer	Date
T. MERCER	
Checker	


P2.04

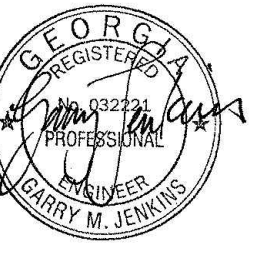

ISSUANCES		
No.	Drawing Issue Description	Date
1	BUILDING PERMIT	2016.10.17

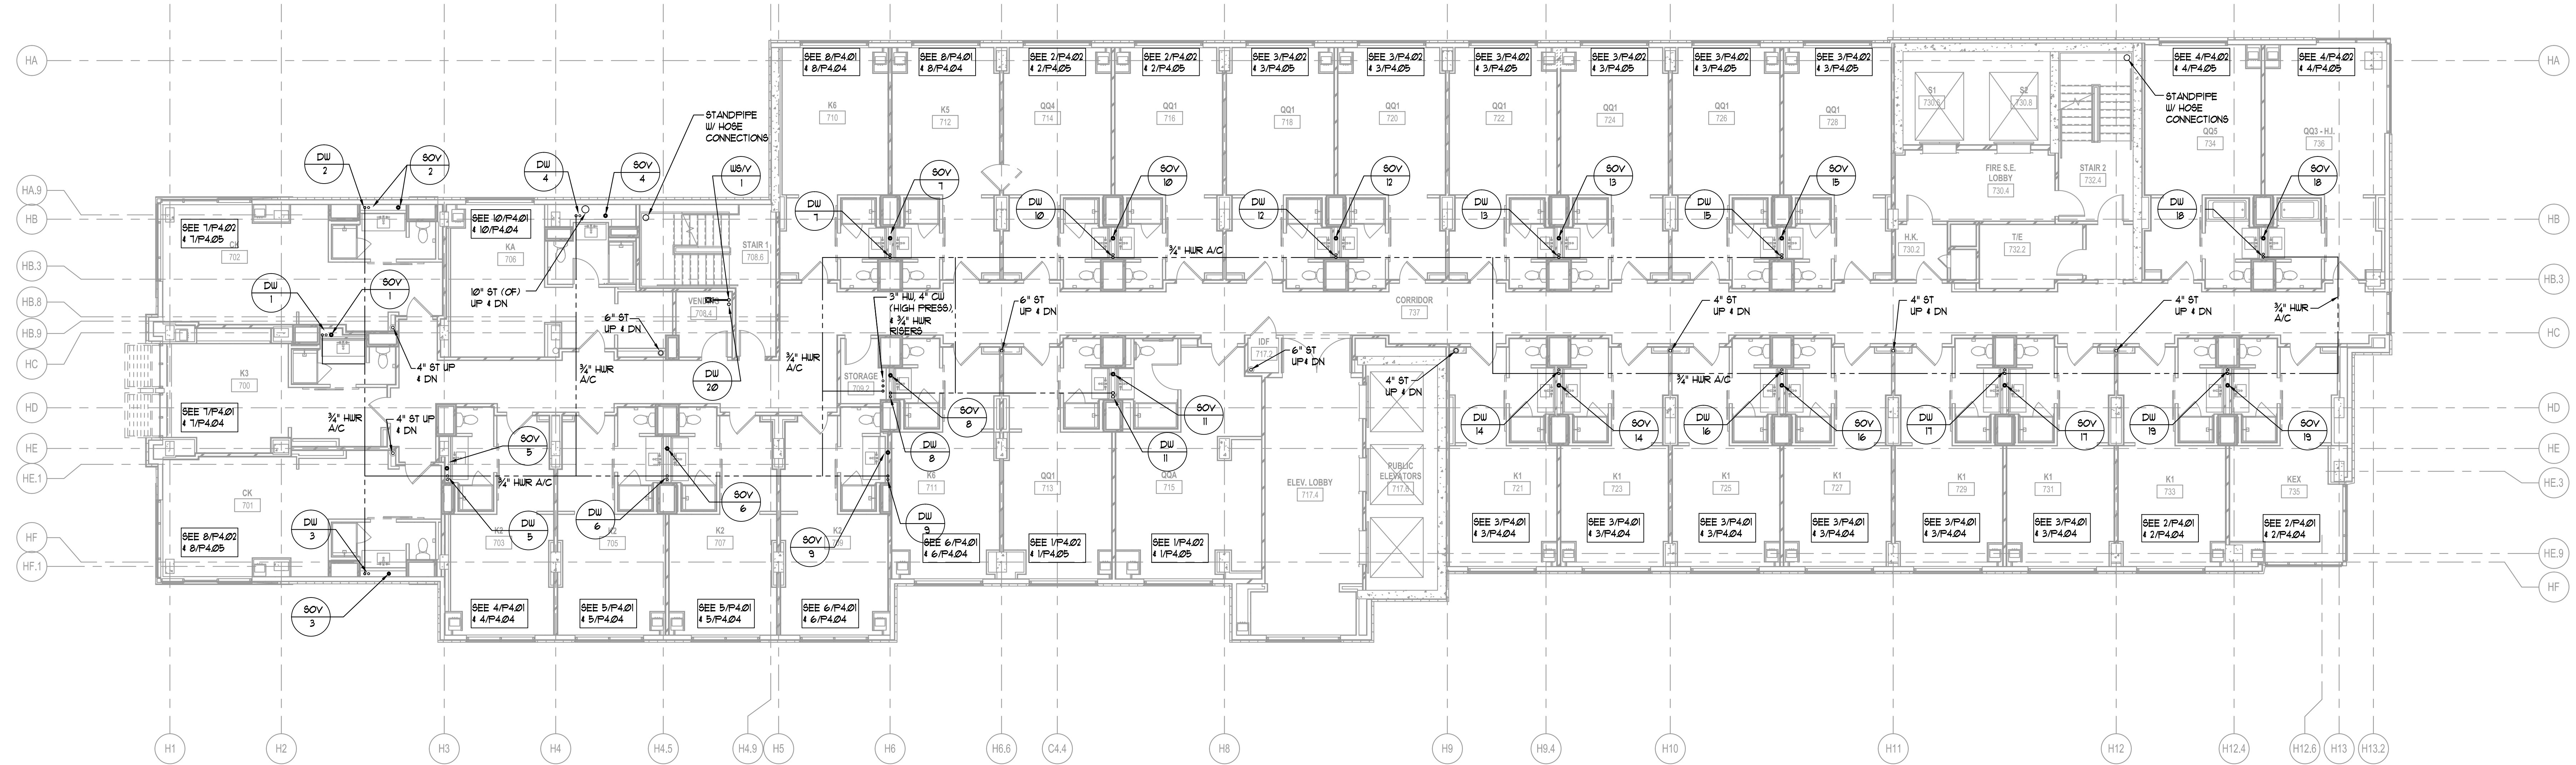

2 LEVEL 7 GUESTROOMS — PLUMBING
P2.06 1/8" = 1'-0"

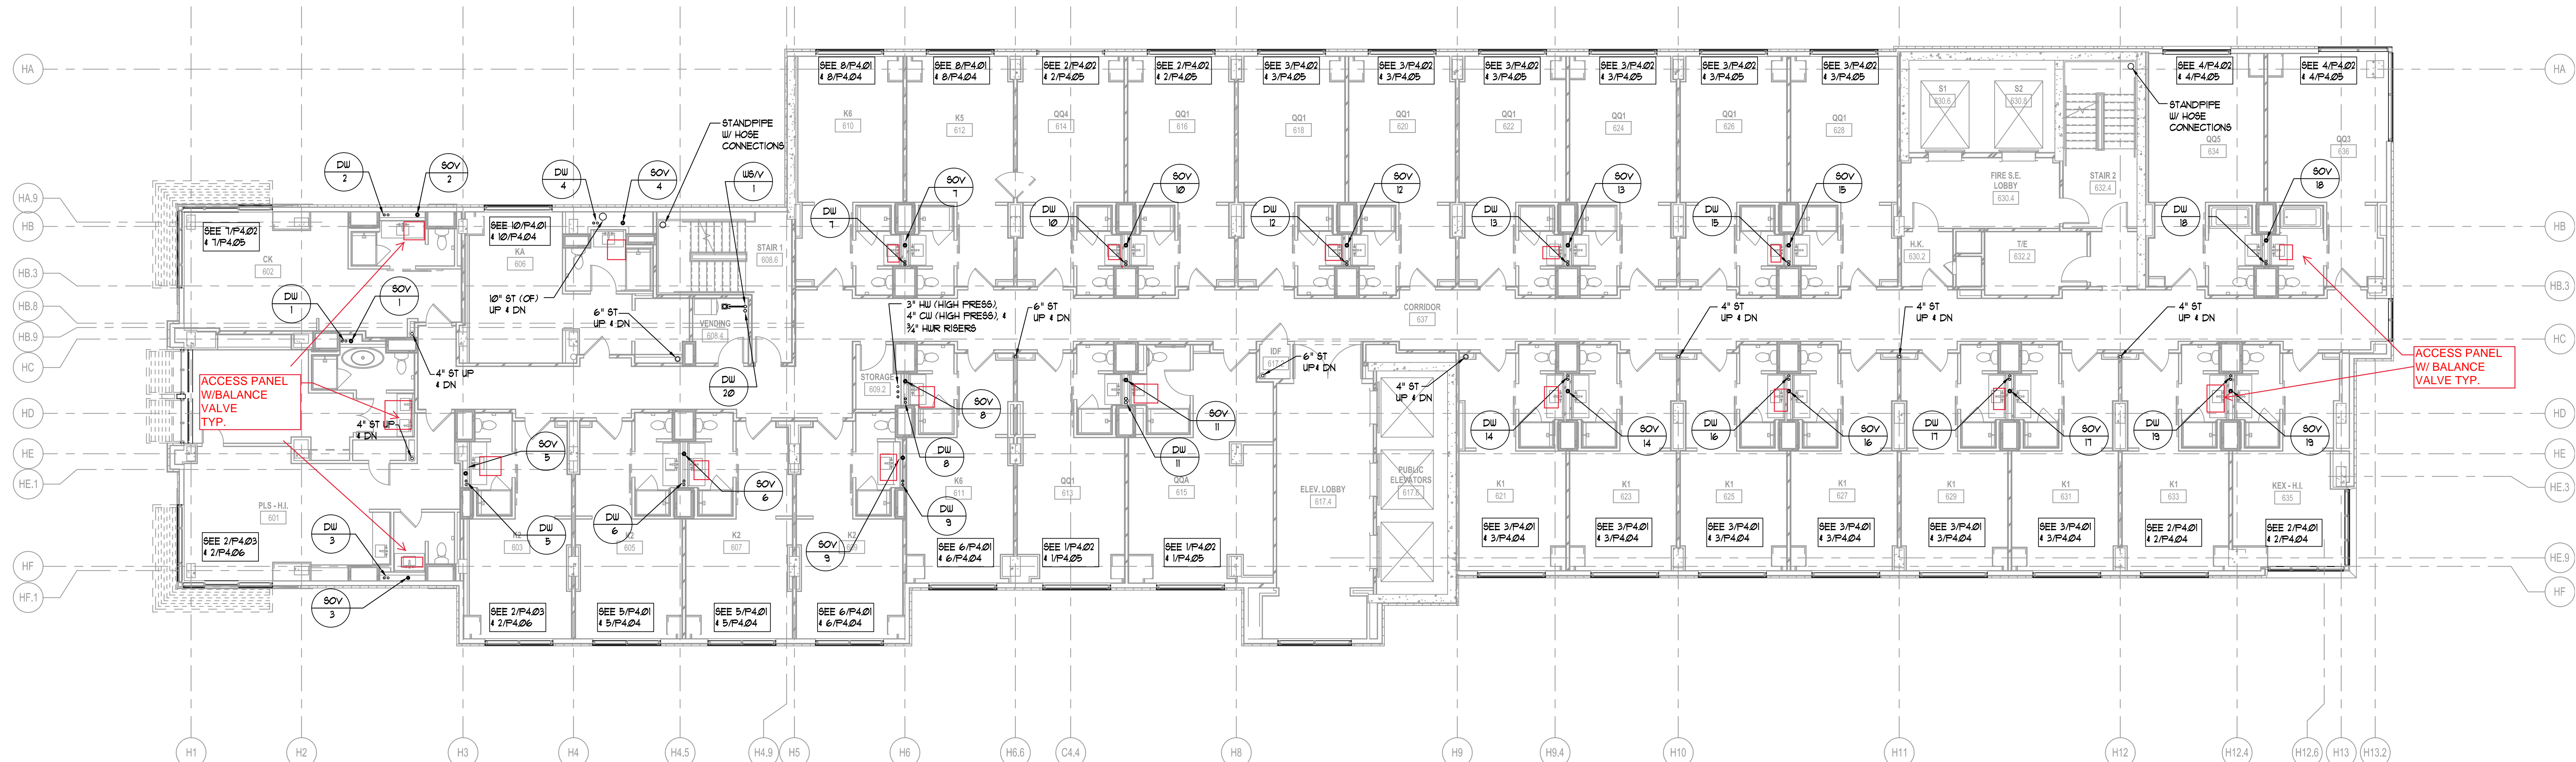

1 LEVEL 6 GUESTROOMS — PLUMBING
P2.06 1/8" = 1'-0"

ALPHARETTA CONFERENCE CENTER & THE HOTEL AT AVALON


9000 AVALON BOULEVARD /
ALPHARETTA, GEORGIA 30009

STORMONT HOSPITALITY GROUP, LLC /
NORTH AMERICAN PROPERTY GROUP

**LEVEL 6 & 7
GUESTROOMS
PLUMBING**


K. PRICE	140028
Principal in Charge	BW&A Project No.
G. JENKINS	101716
Project Engineer	Date
T. MERCER	
Checker	

P2.06

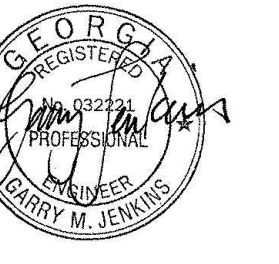


ISSUANCES

No.	Drawing Issue Description	Date
1	BUILDING PERMIT	2016.10.17

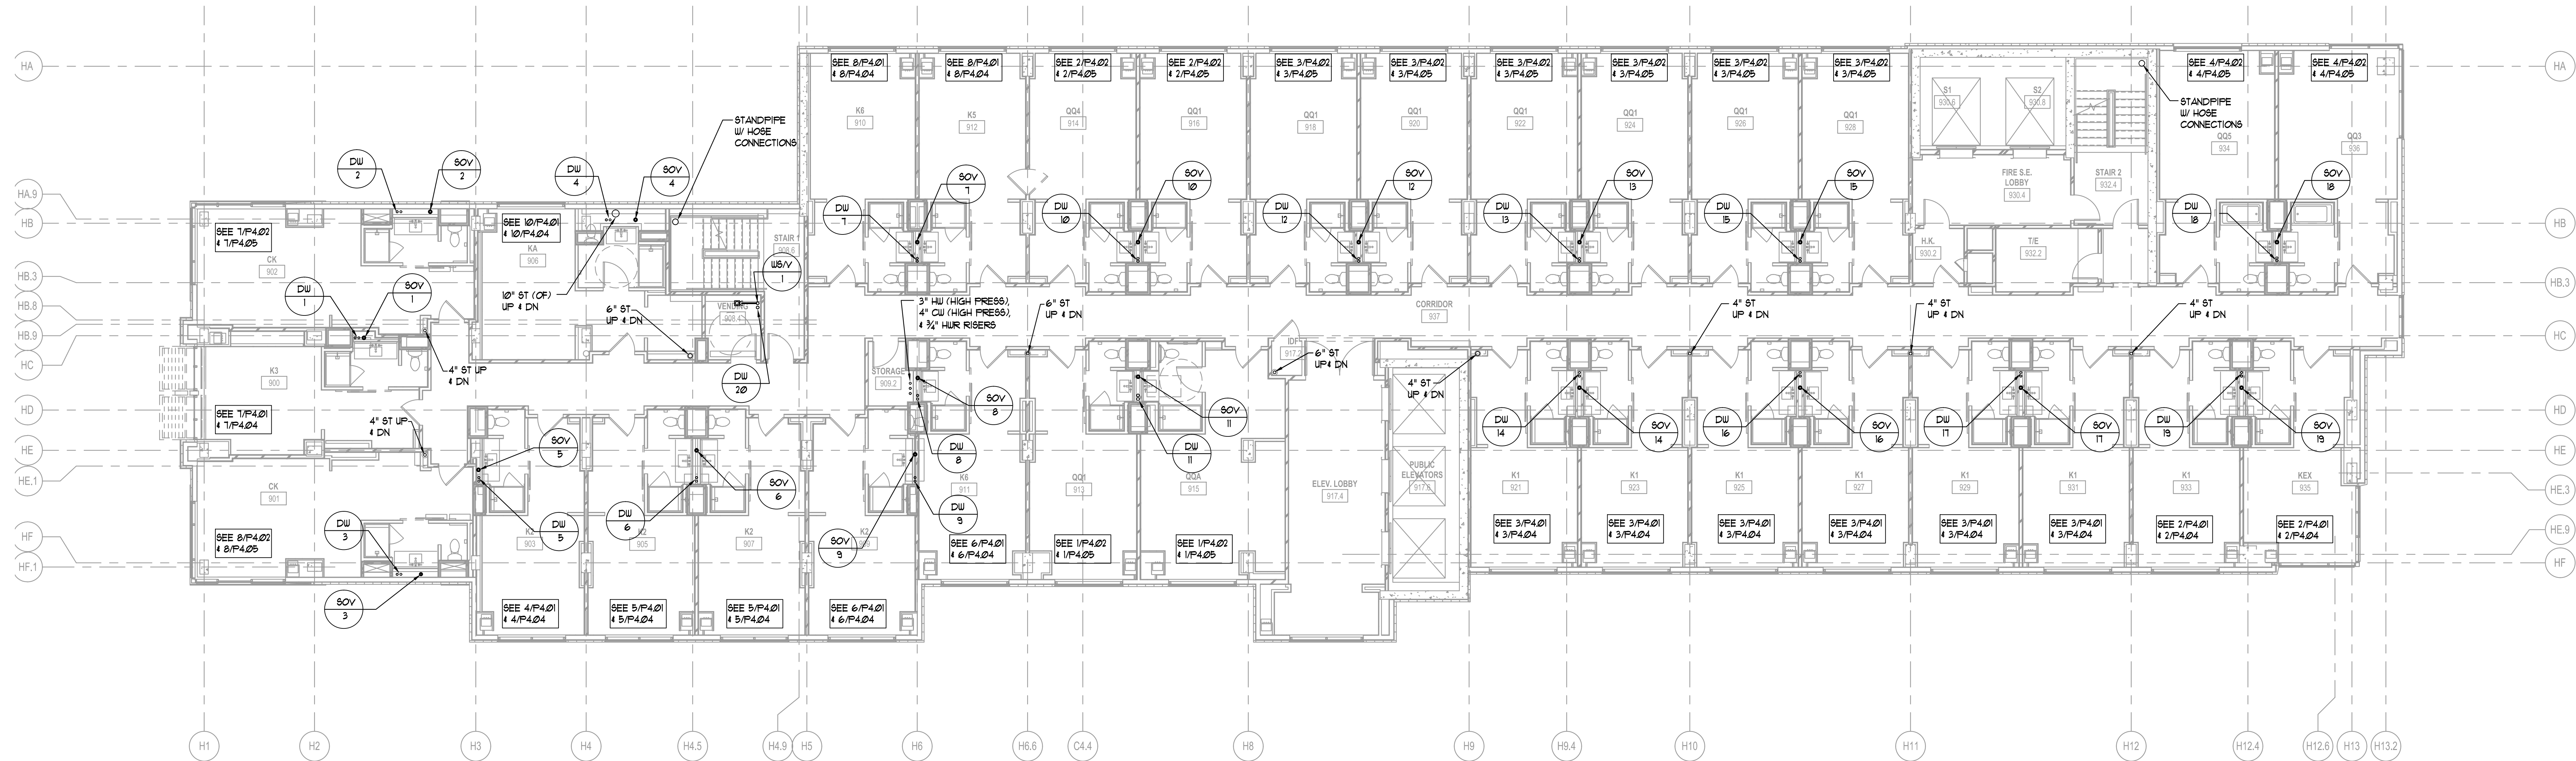

2 LEVEL 9 GUESTROOMS — PLUMBING
P2.08 1/8" = 1'-0"

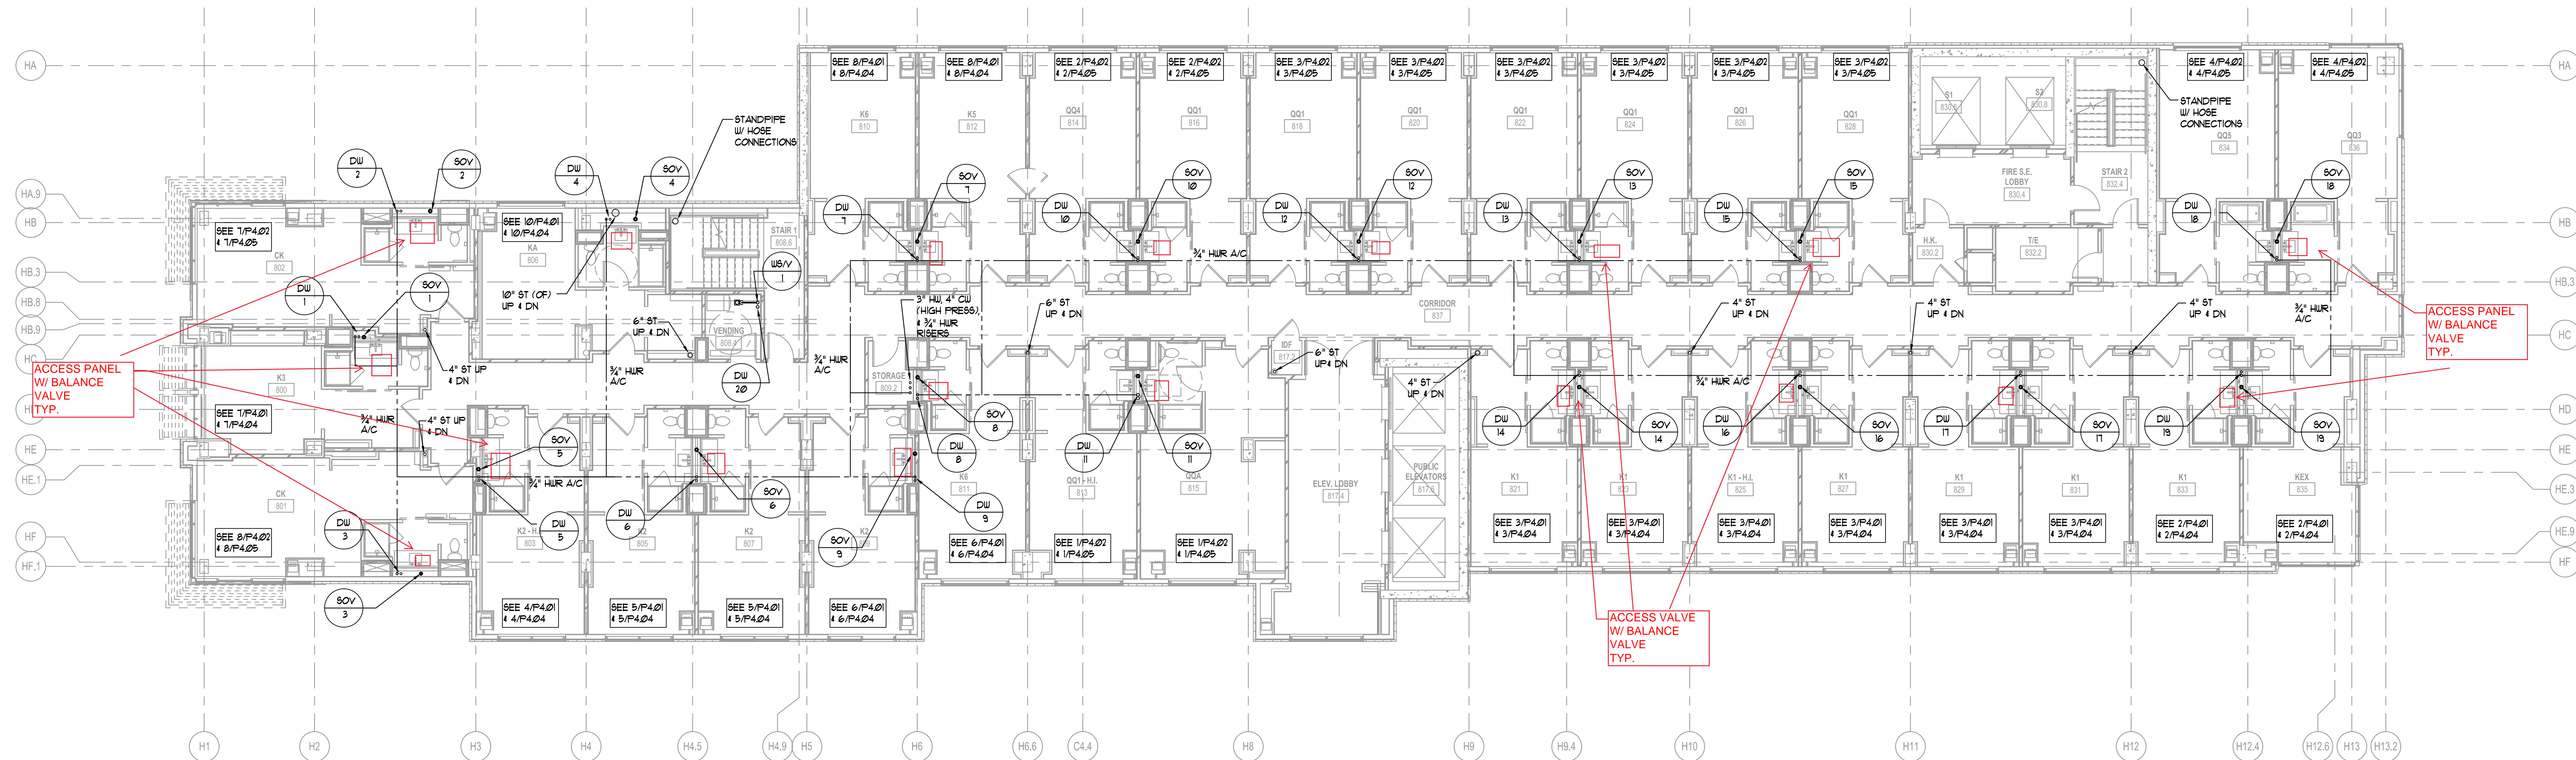

1 LEVEL 8 GUESTROOMS — PLUMBING
P2.08 1/8" = 1'-0"

ALPHARETTA CONFERENCE CENTER & THE HOTEL AT AVALON


9000 AVALON BOULEVARD /
ALPHARETTA, GEORGIA 30009

STORMONT HOSPITALITY GROUP, LLC /
NORTH AMERICAN PROPERTY GROUP


LEVEL 8 & 9 GUESTROOMS PLUMBING

K. PRICE	140028
Principal in Charge	Blank Project No.
G. JENKINS	101716
Project Engineer	Date
T. MERCER	
Checker	


P2.08

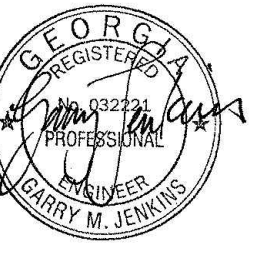

ISSUANCES		
No.	Drawing Issue Description	Date
	BUILDING PERMIT	2016.10.17

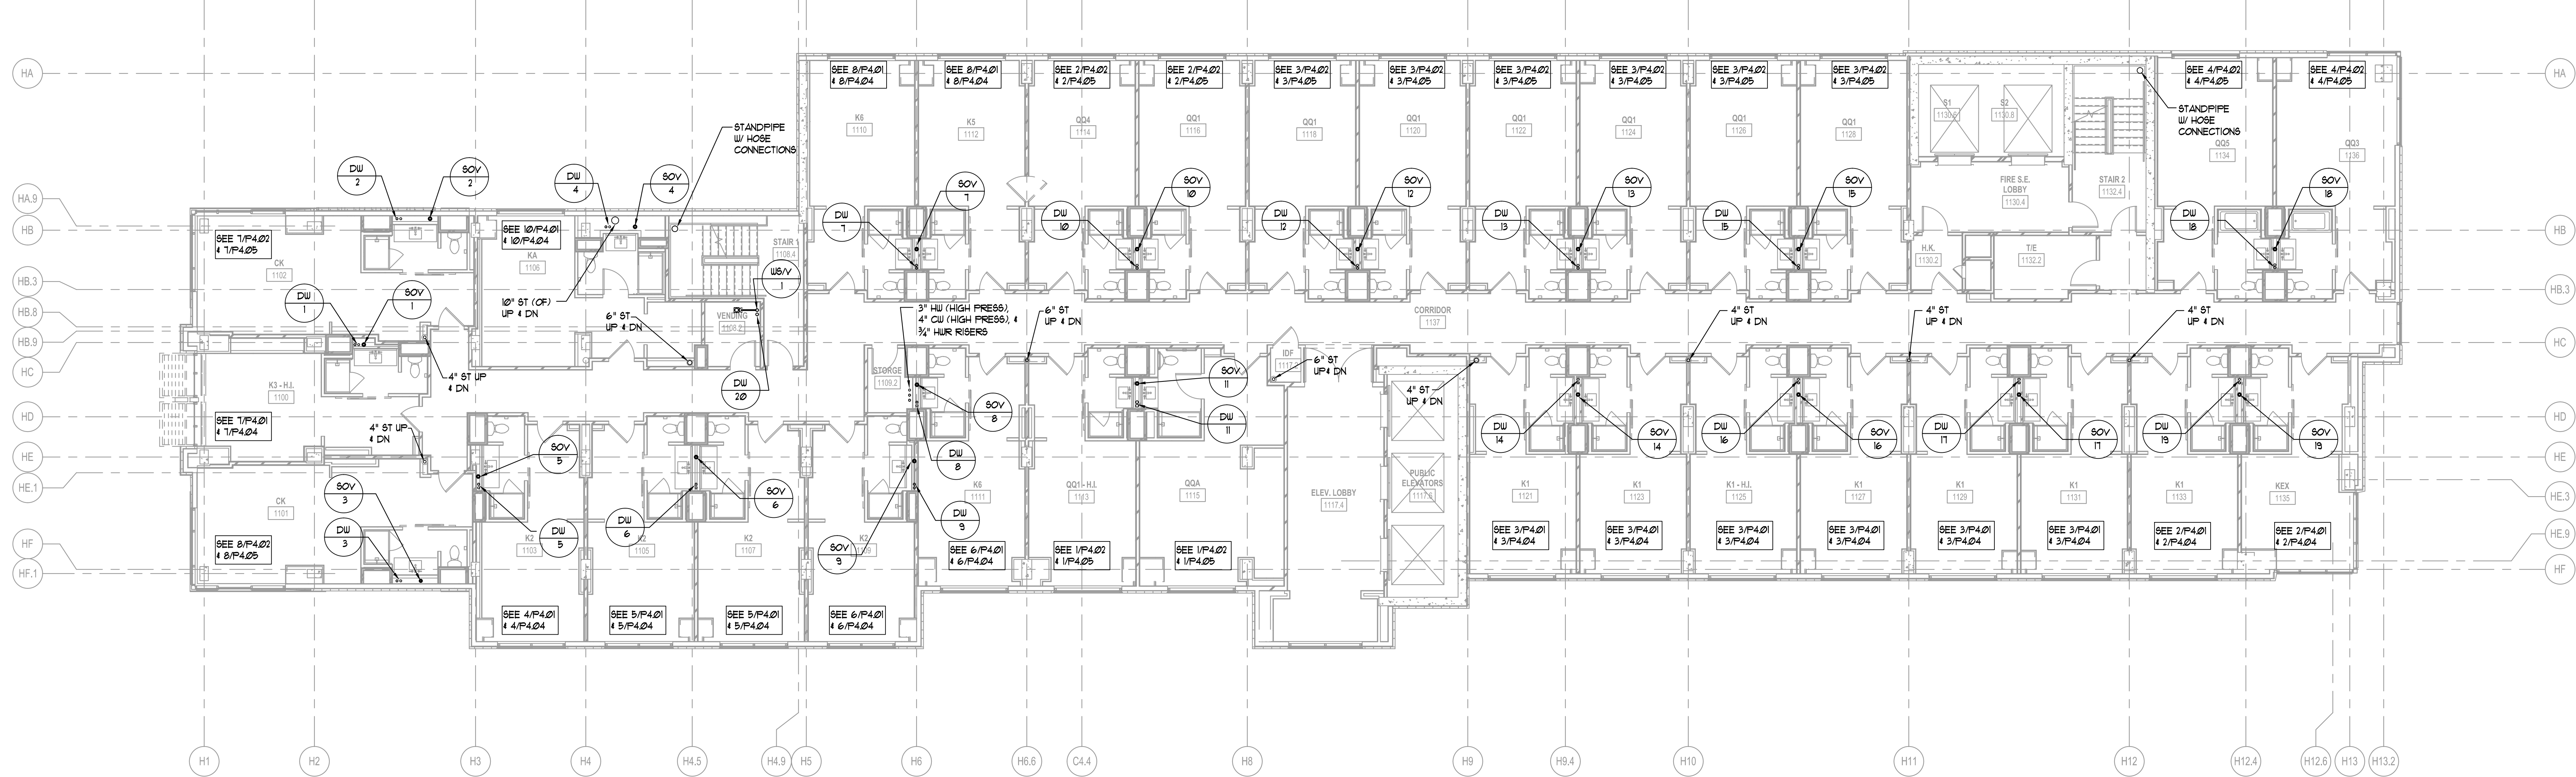

2 LEVEL 11 GUESTROOMS — PLUMBING
P2.10 1/8" = 1'-0"

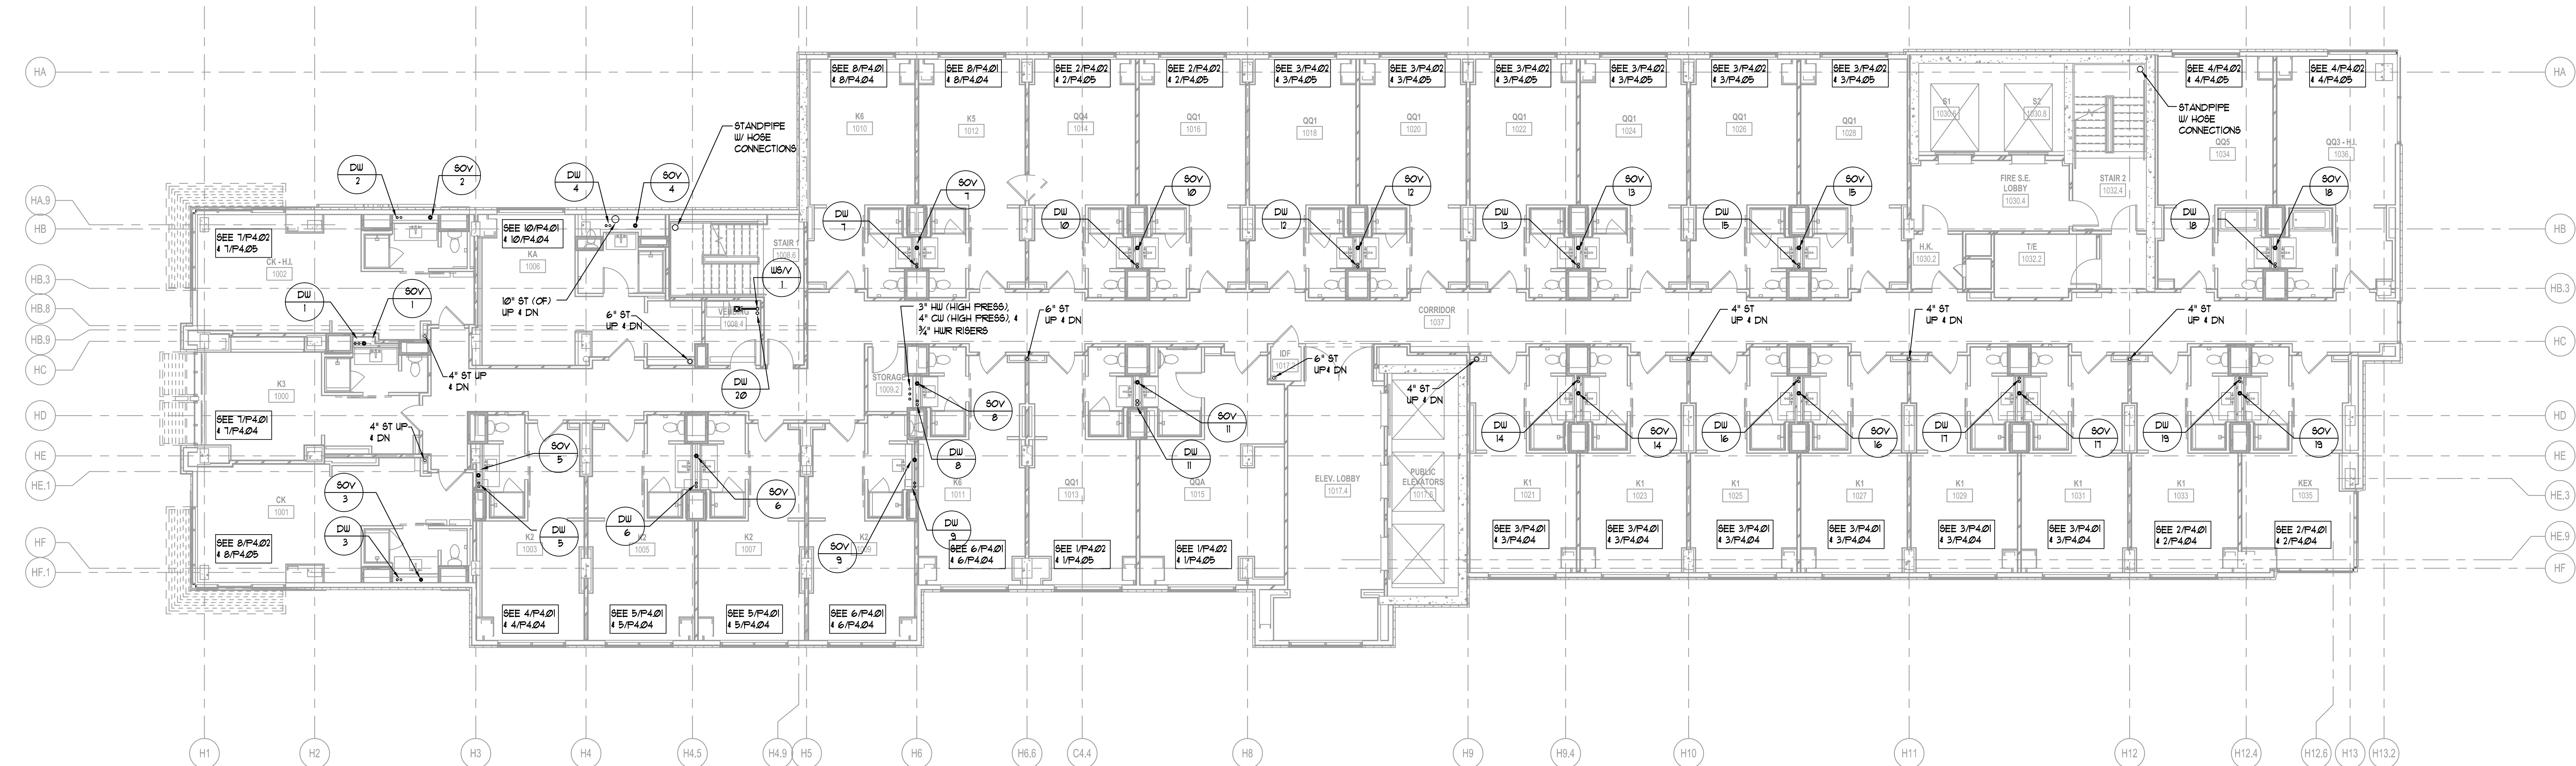

1 LEVEL 10 GUESTROOMS — PLUMBING
P2.10 1/8" = 1'-0"

ALPHARETTA CONFERENCE
CENTER & THE HOTEL AT
AVALON


9000 AVALON BOULEVARD /
ALPHARETTA, GEORGIA 30009

STORMONT HOSPITALITY GROUP, LLC /
NORTH AMERICAN PROPERTY GROUP


LEVEL 10 & 11
GUESTROOMS
PLUMBING

K. PRICE	140028
Principal in Charge	BW&A Project No.
G. JENKINS	101716
Project Engineer	Date
T. MERCER	
Checker	


P2.10

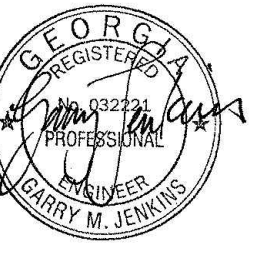

ISSUANCES		
No.	Drawing Issue Description	Date
1	BUILDING PERMIT	2016.10.17

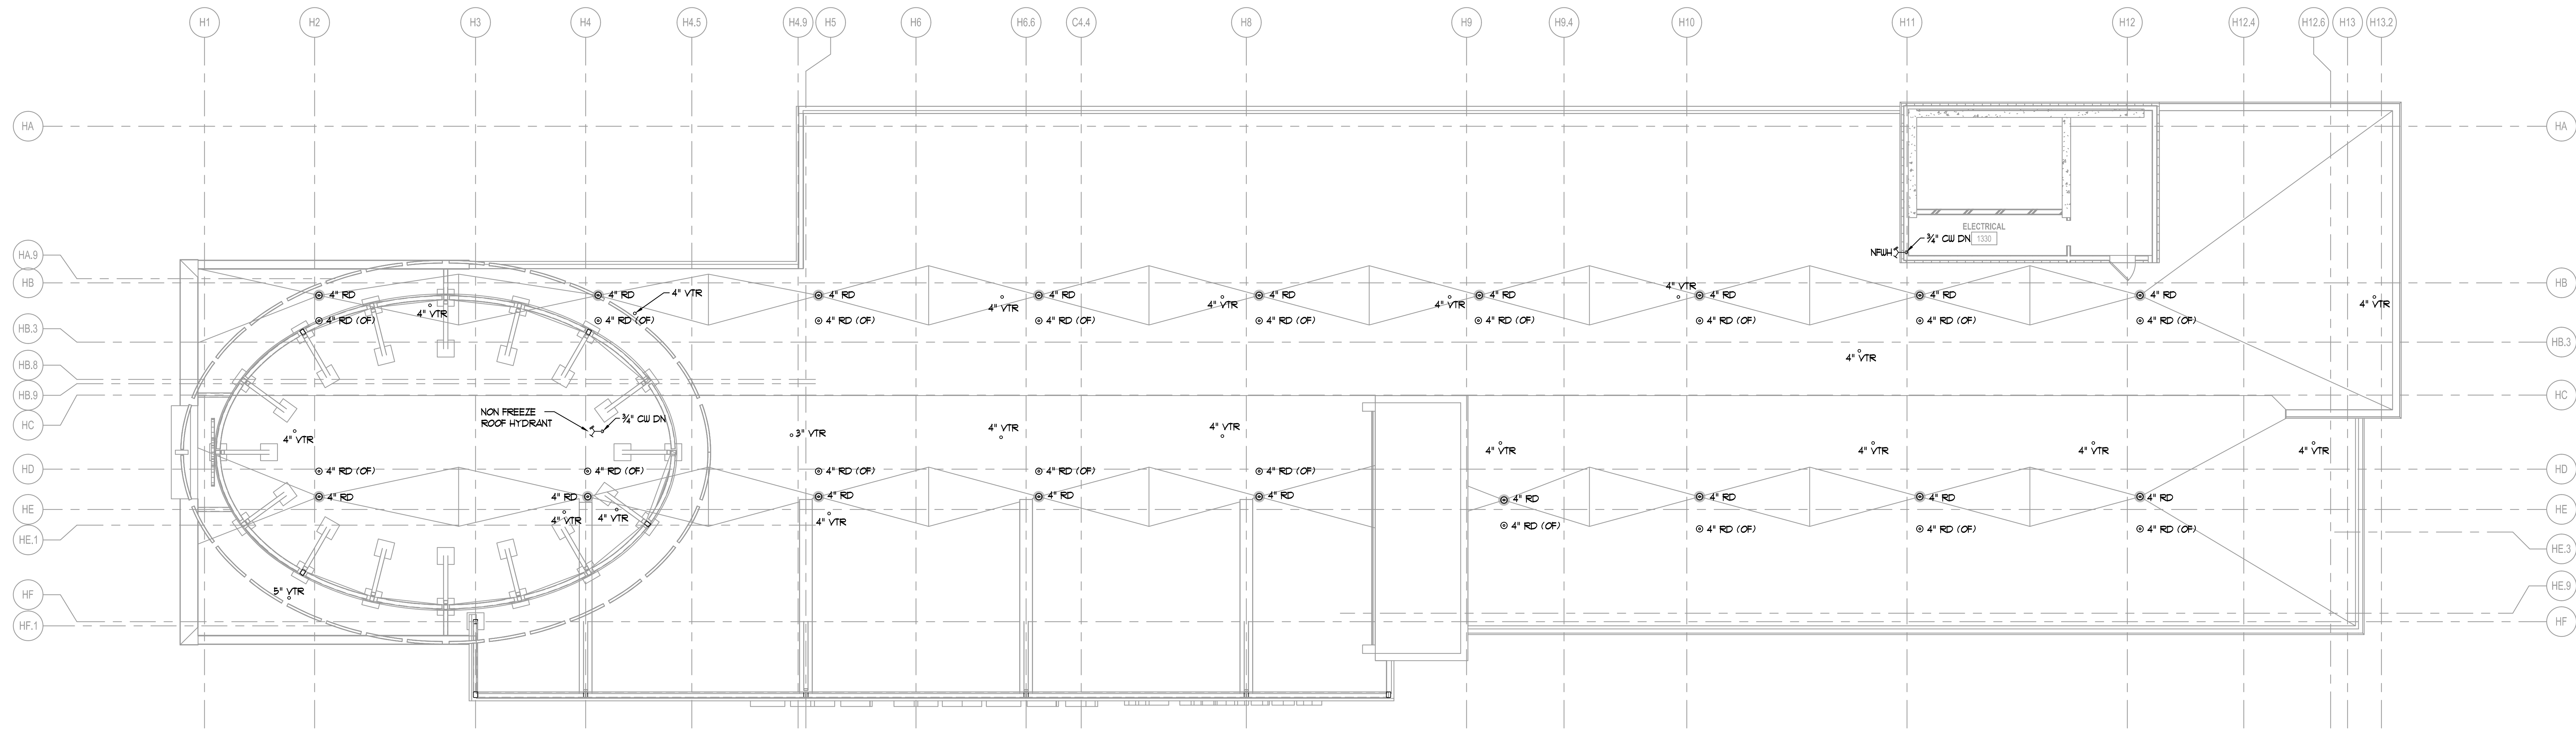

2 LEVEL 13 ROOF — PLUMBING
P2.12 1/8" = 1'-0"

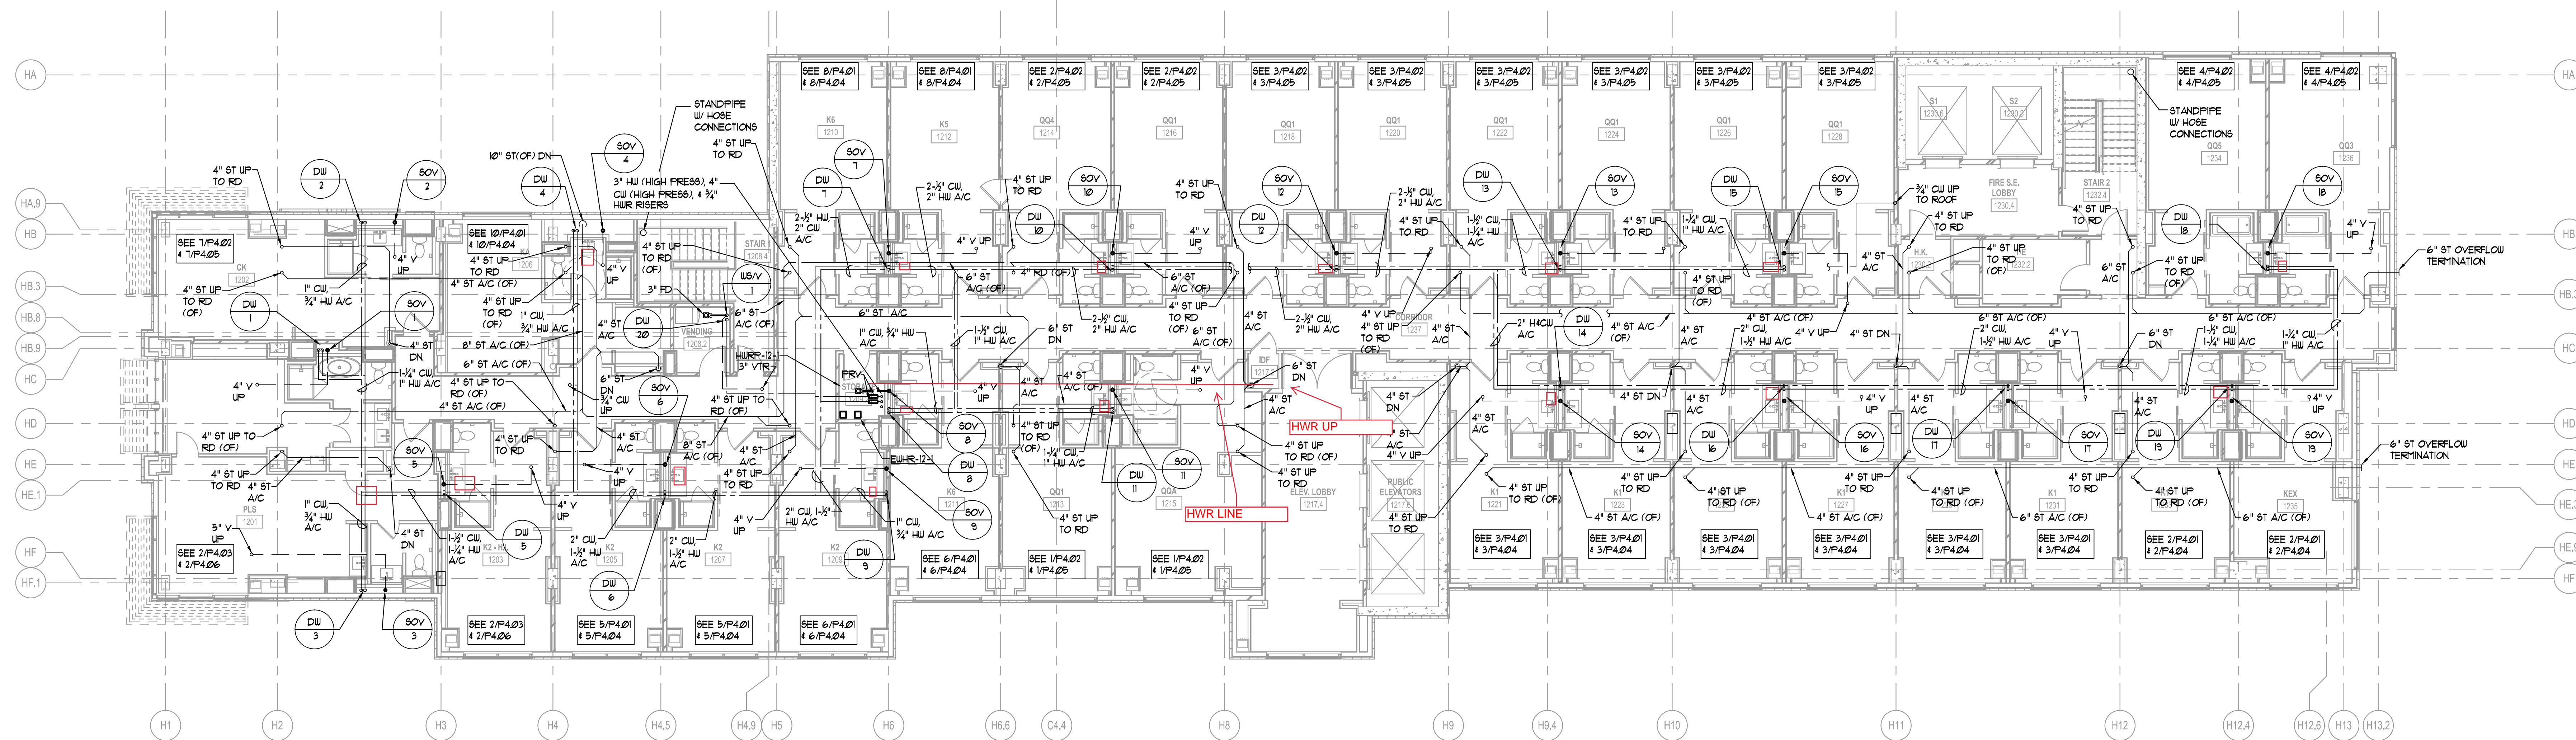

1 LEVEL 12 GUESTROOMS — PLUMBING
P2.12 1/8" = 1'-0"

ALPHARETTA CONFERENCE
CENTER & THE HOTEL AT
AVALON


9000 AVALON BOULEVARD /
ALPHARETTA, GEORGIA 30009

STORMONT HOSPITALITY GROUP, LLC /
NORTH AMERICAN PROPERTY GROUP


LEVEL 12
GUESTROOMS & ROOF
PLUMBING

K. PRICE	140028
Principal in Charge	Block A Project No.
G. JENKINS	101716
Project Engineer	Date
T. MERCER	
Checker	


P2.12

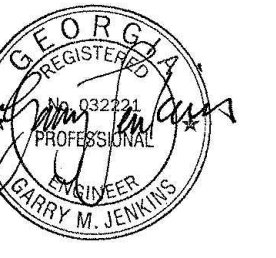


ISSUANCES		
No.	Drawing Issue Description	Date
1	BUILDING PERMIT	2016.10.17

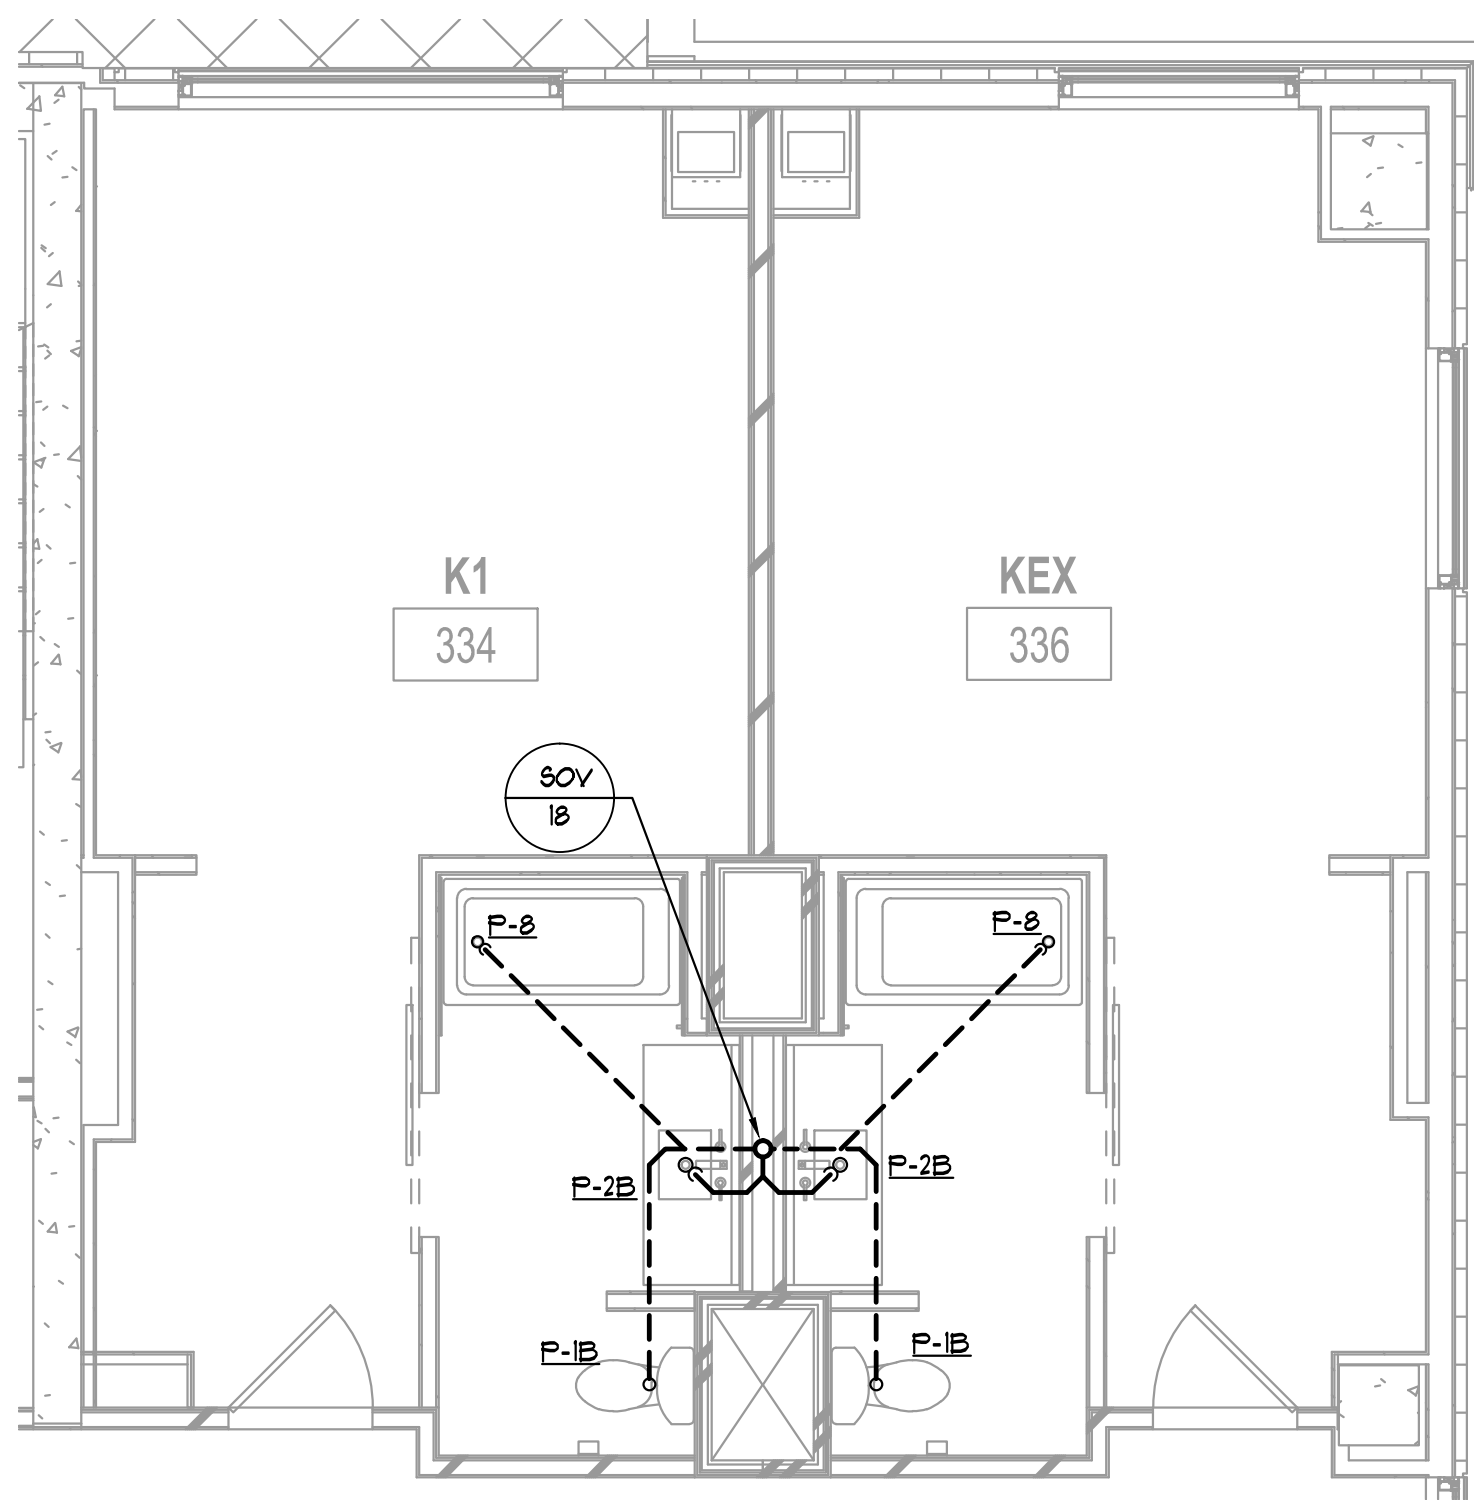


1 K1/KEX PLAN – SANITARY & VENT
P4.01 1/4" = 1'-0"

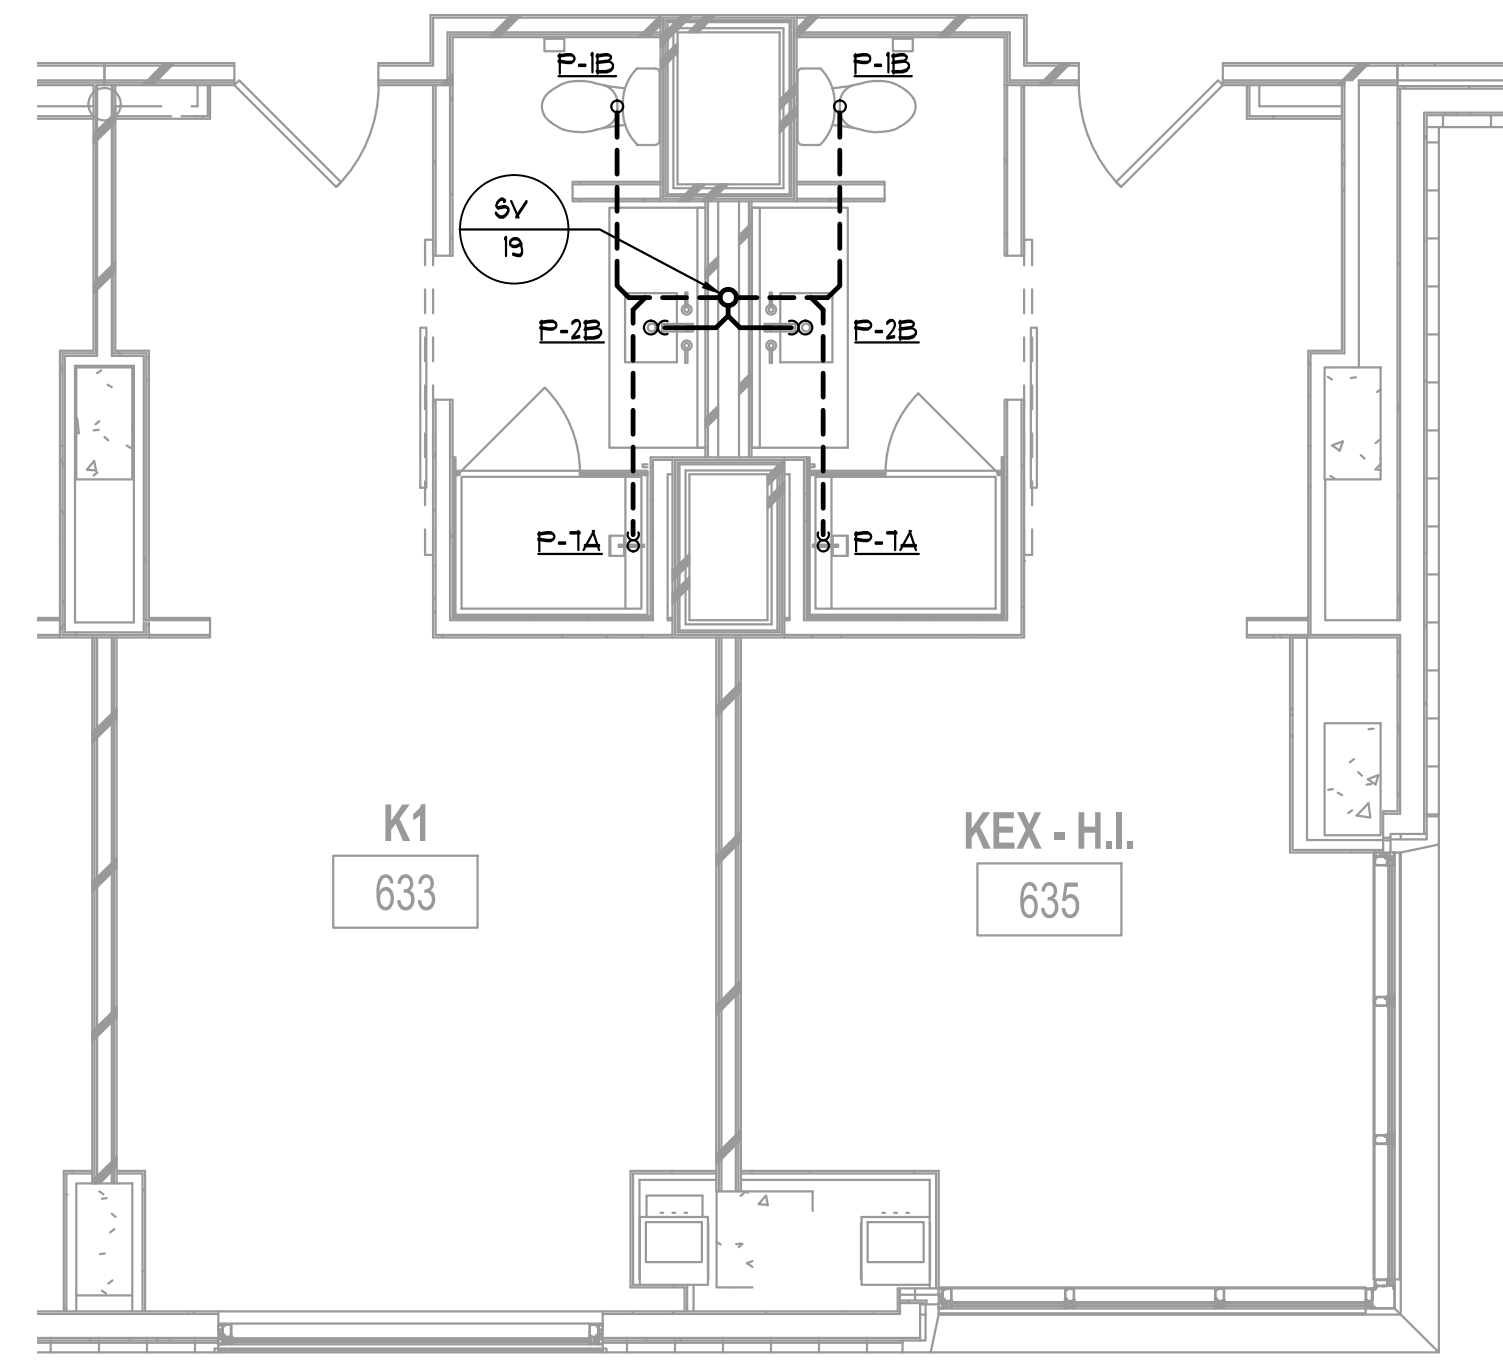


2 K1/KEX PLAN – SANITARY & VENT
P4.01 1/4" = 1'-0"

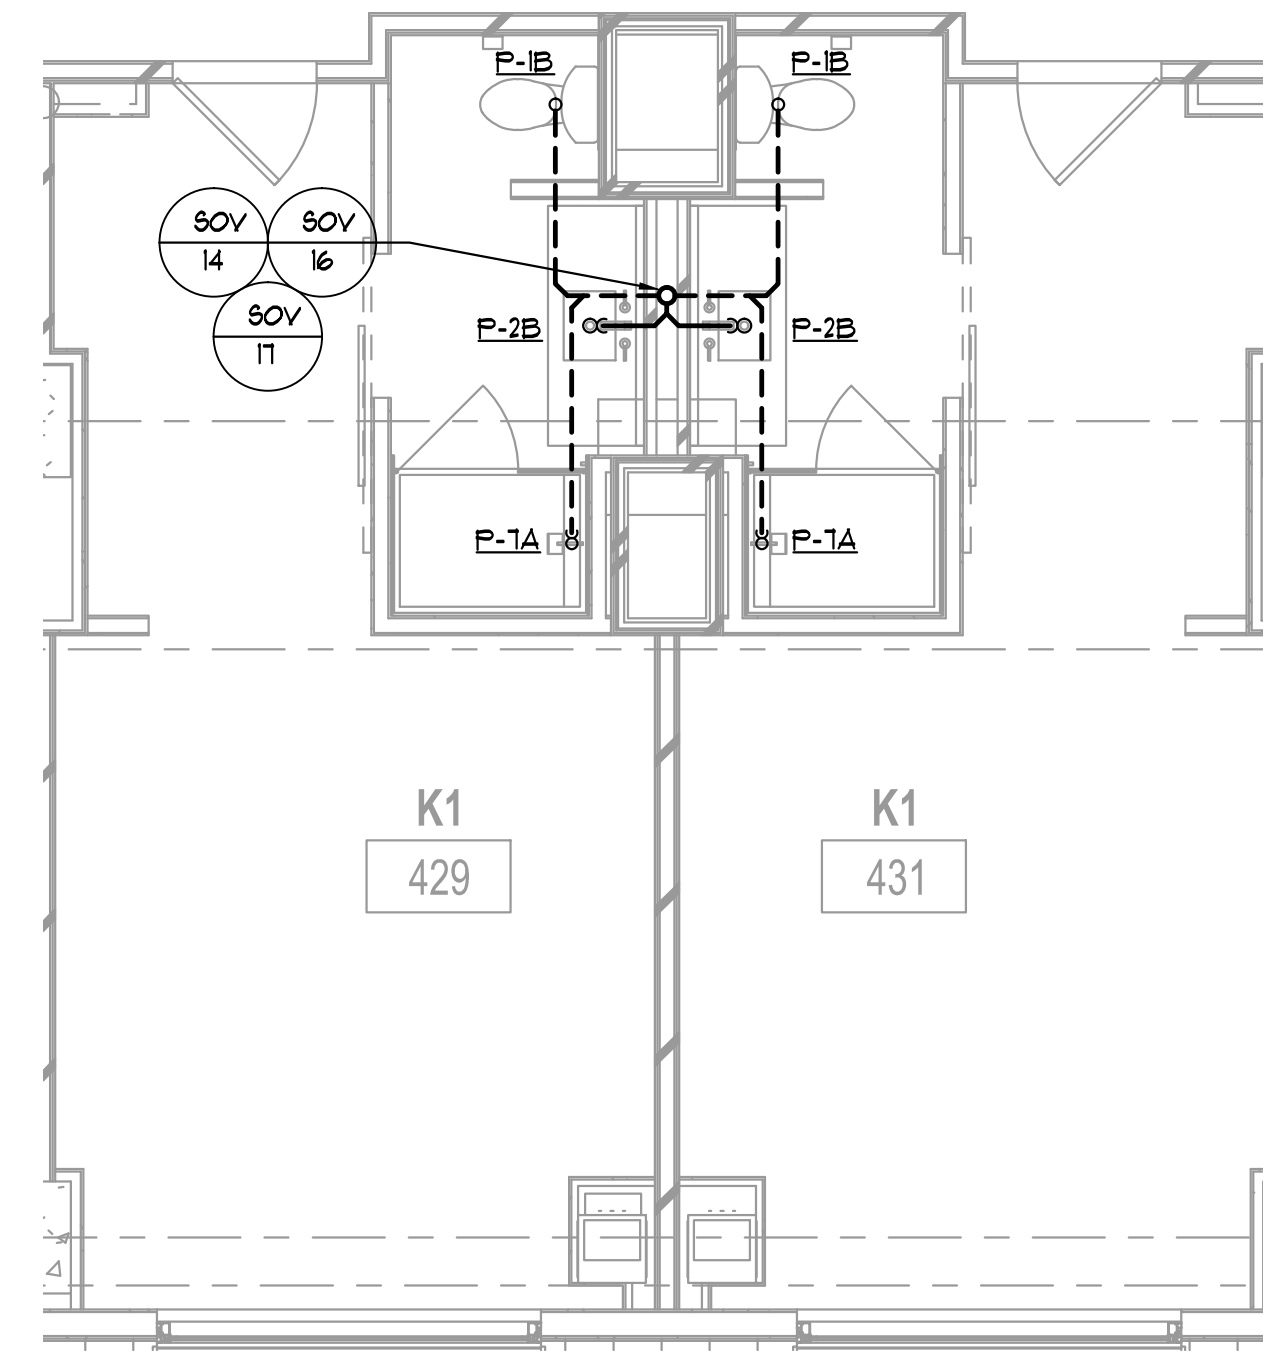


3 K1/K1 PLAN (TYP.) – SANITARY & VENT
P4.01 1/4" = 1'-0"

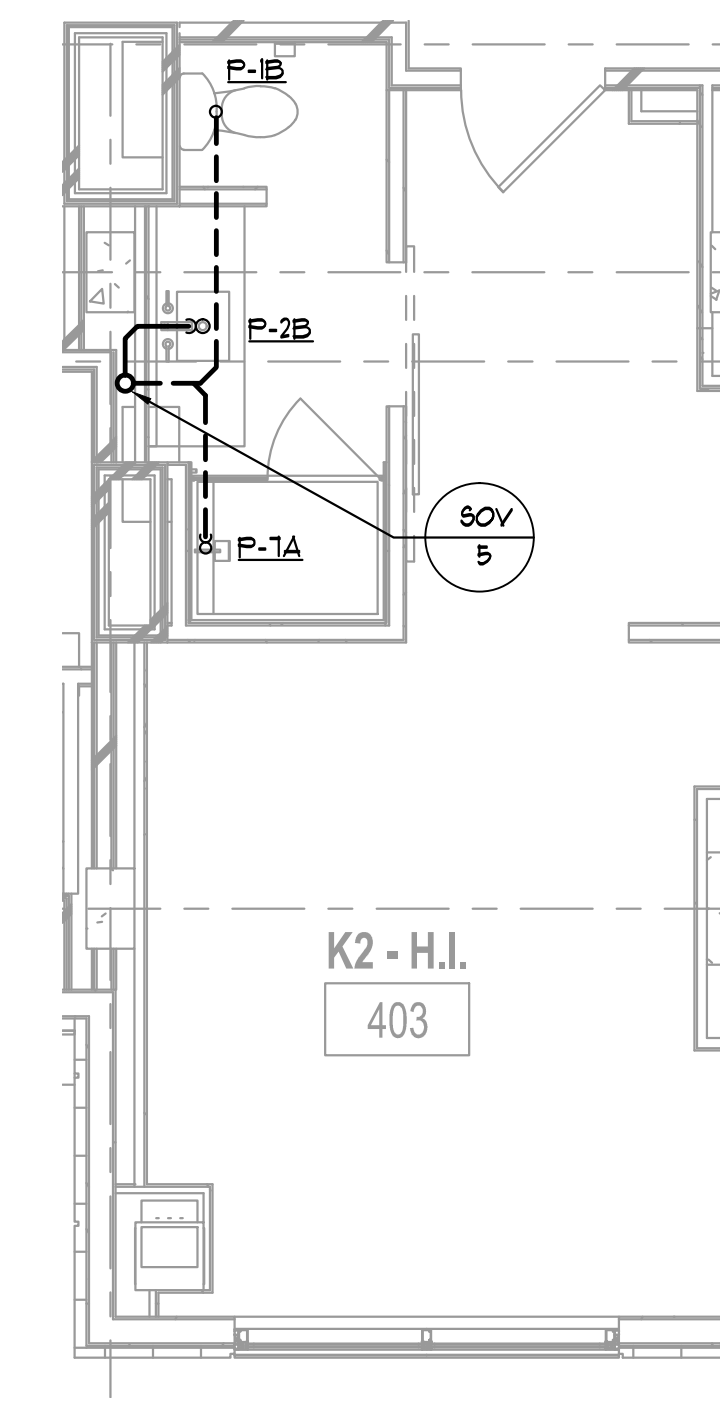


4 K2 PLAN – SANITARY & VENT
P4.01 1/4" = 1'-0"

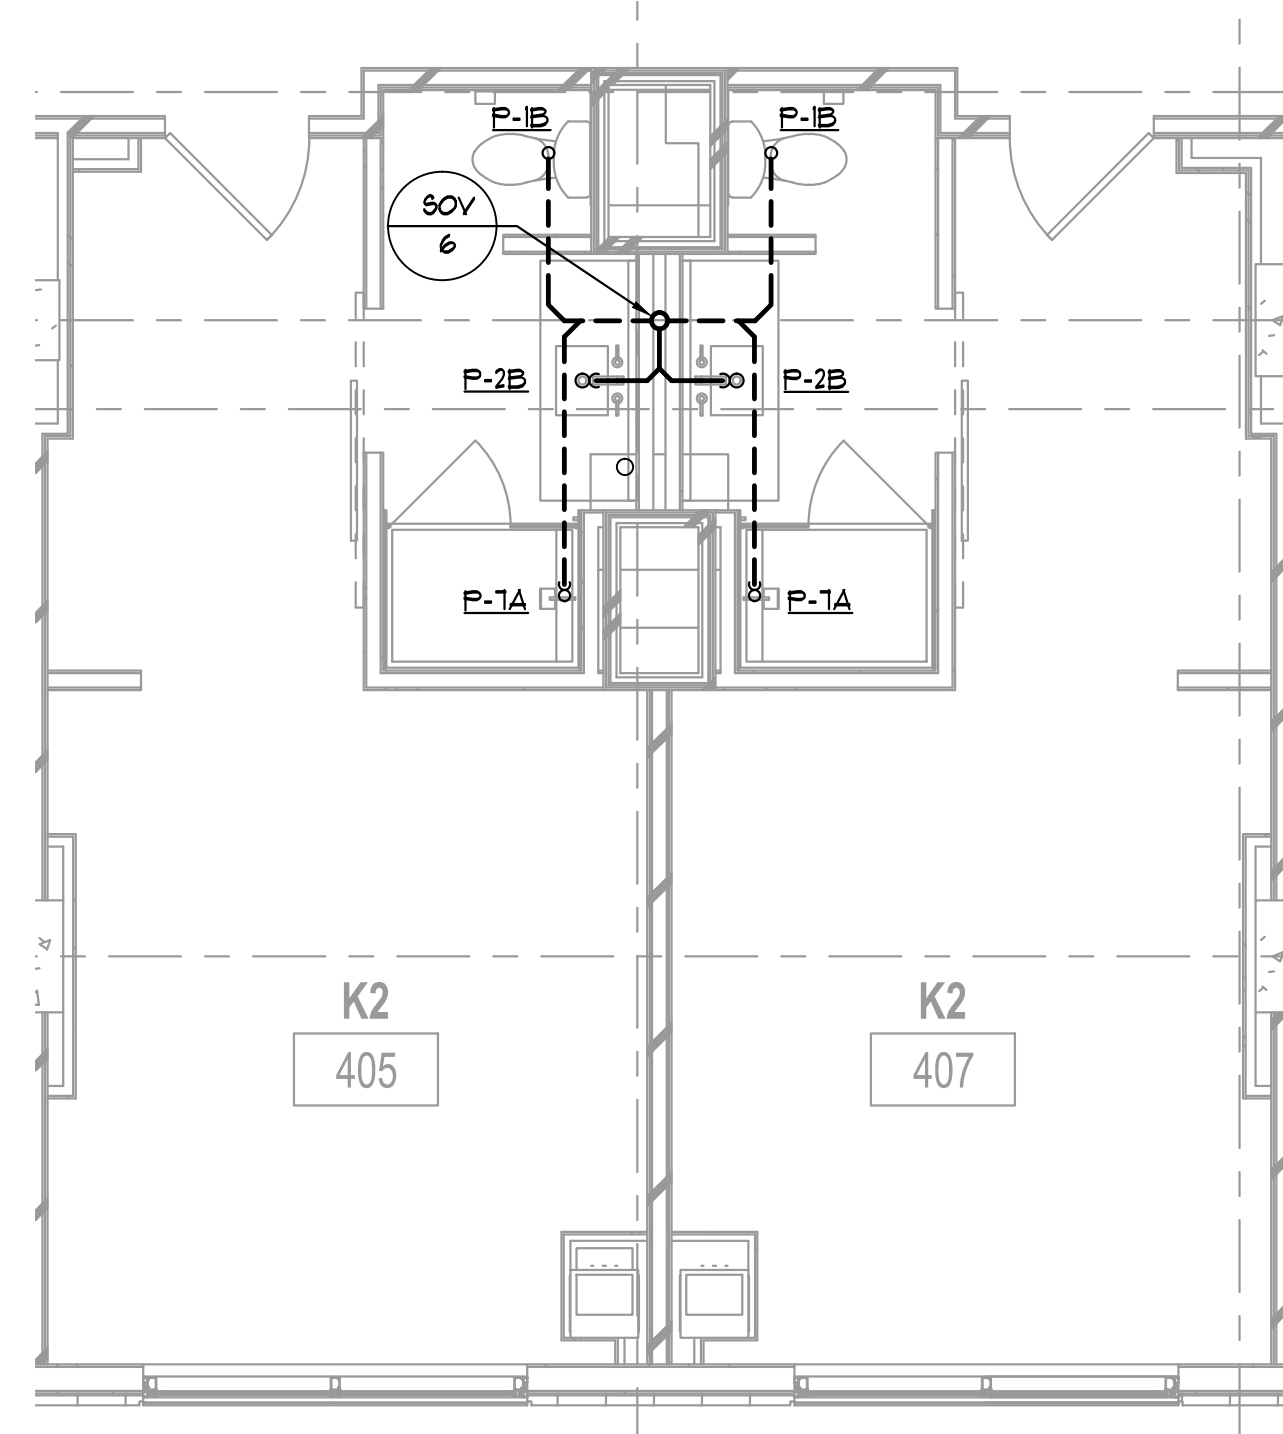


5 K2 PLAN – SANITARY & VENT
P4.01 1/4" = 1'-0"

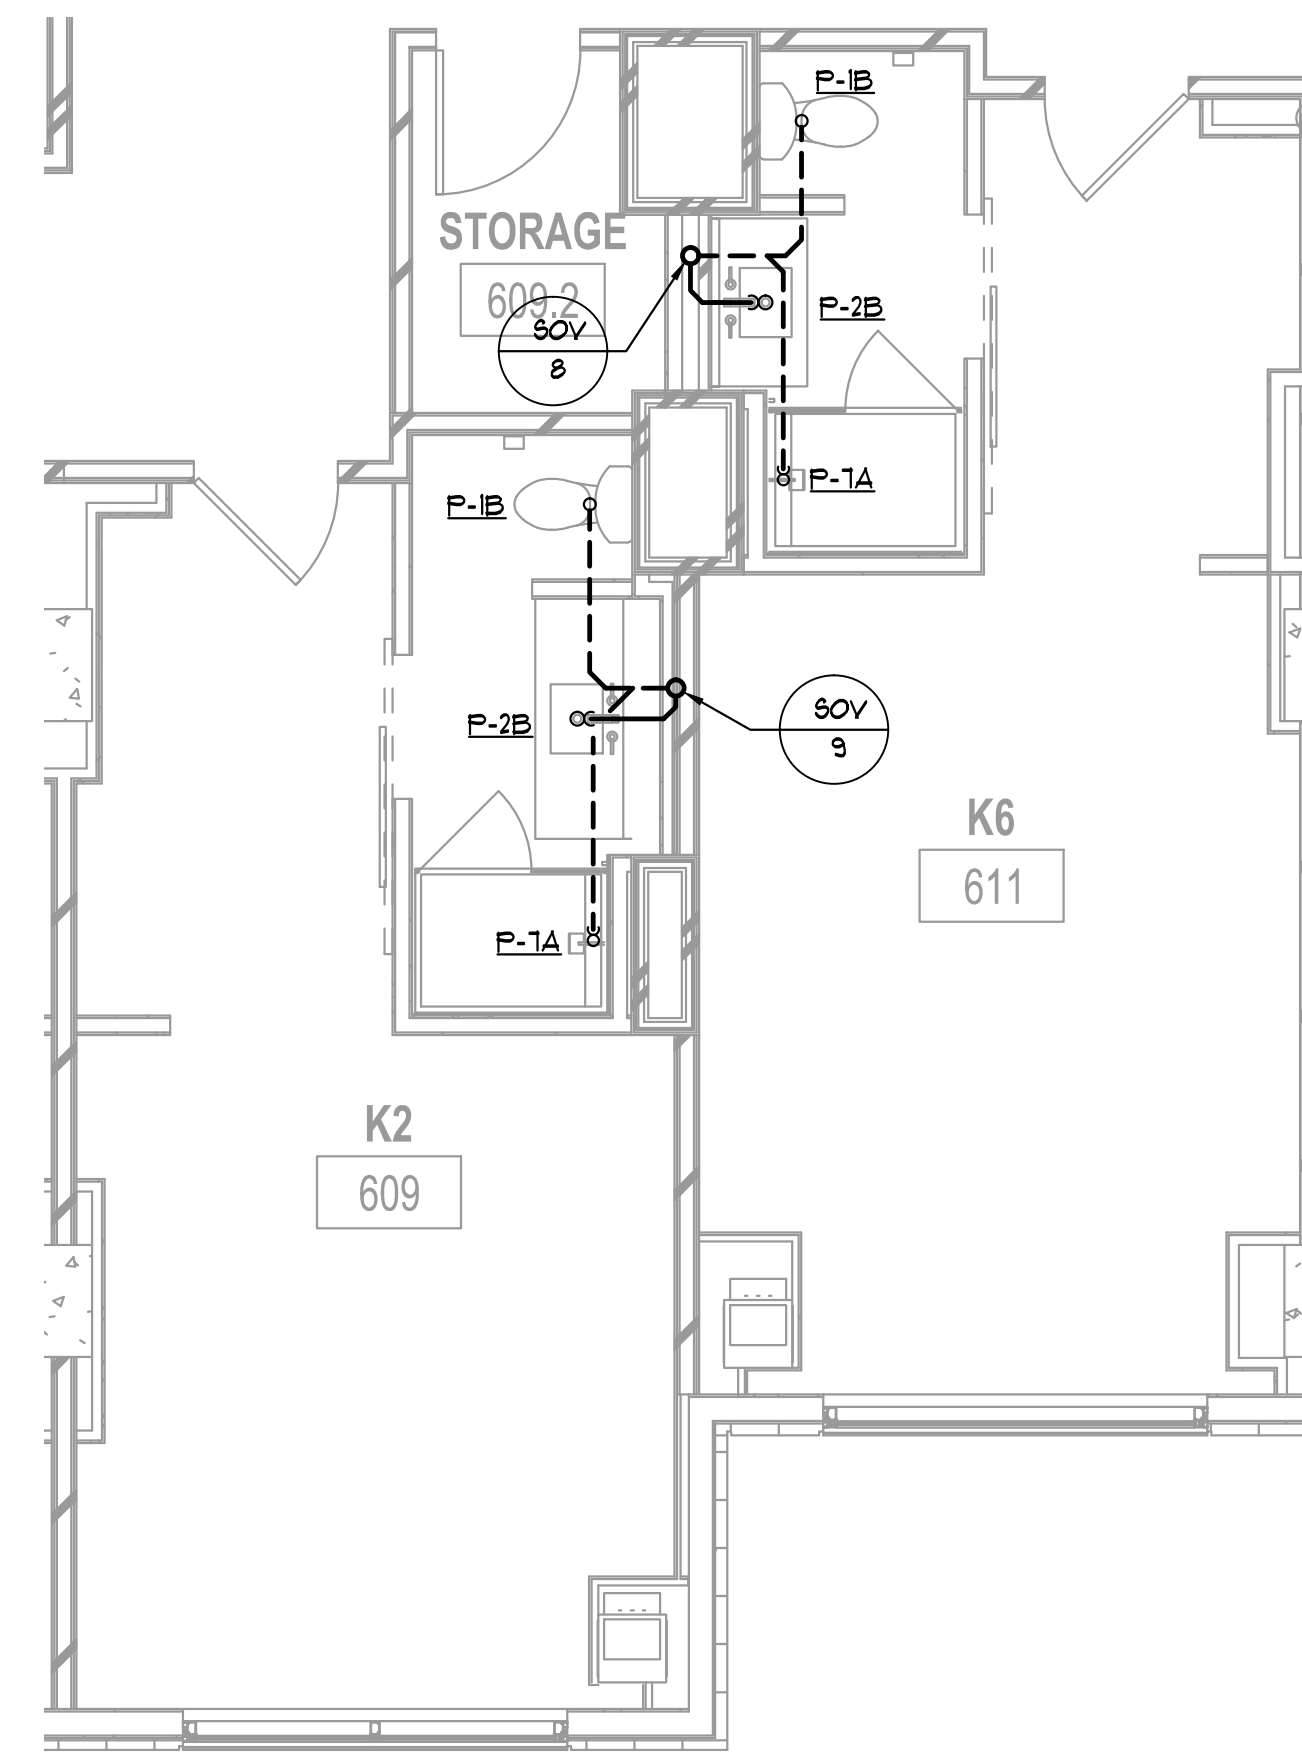


6 K2/K6 PLAN – SANITARY & VENT
P4.01 1/4" = 1'-0"

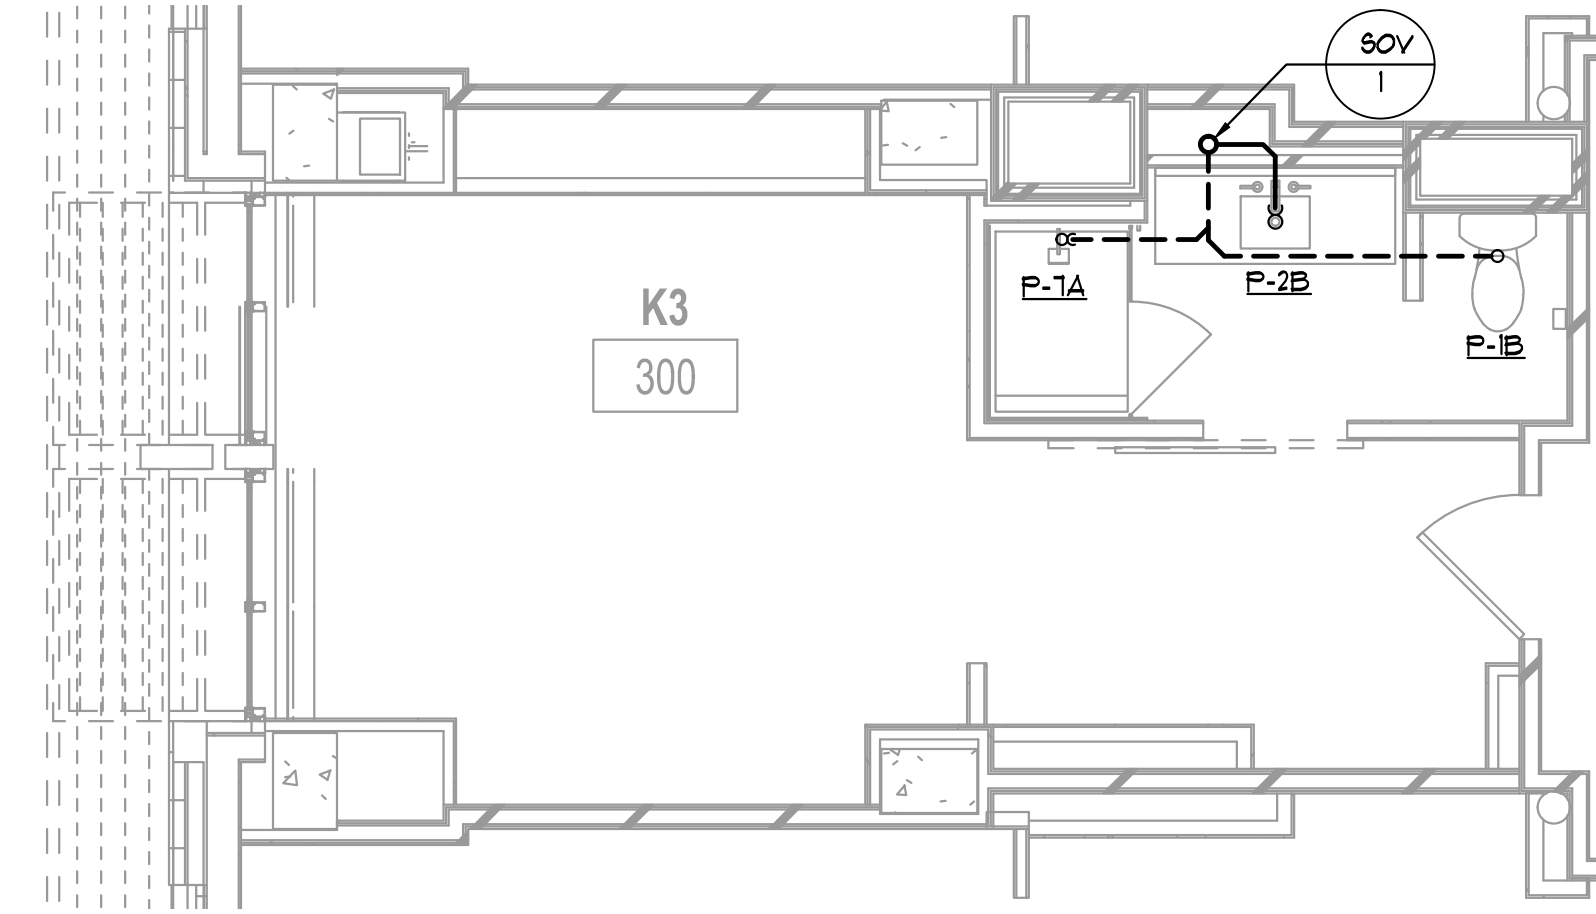


7 K3 PLAN – SANITARY & VENT
P4.01 1/4" = 1'-0"

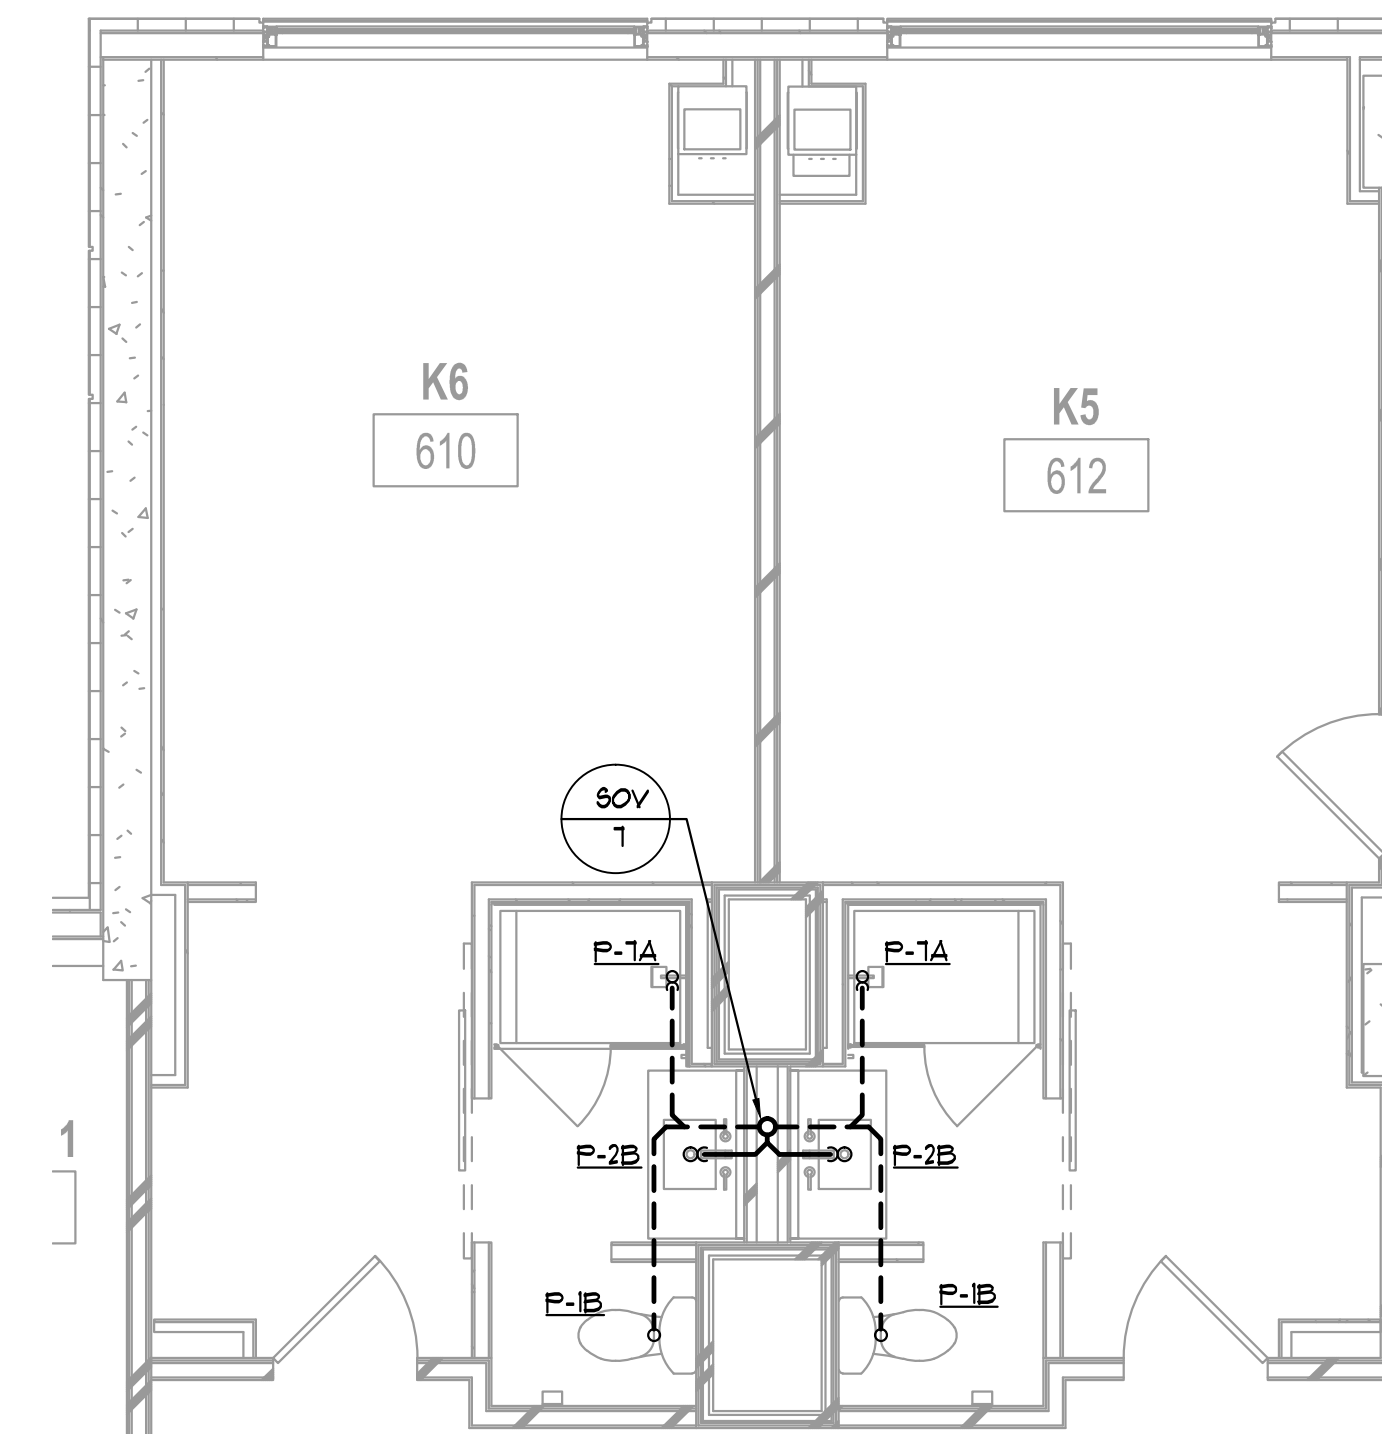


8 K5/K6 PLAN – SANITARY & VENT
P4.01 1/4" = 1'-0"

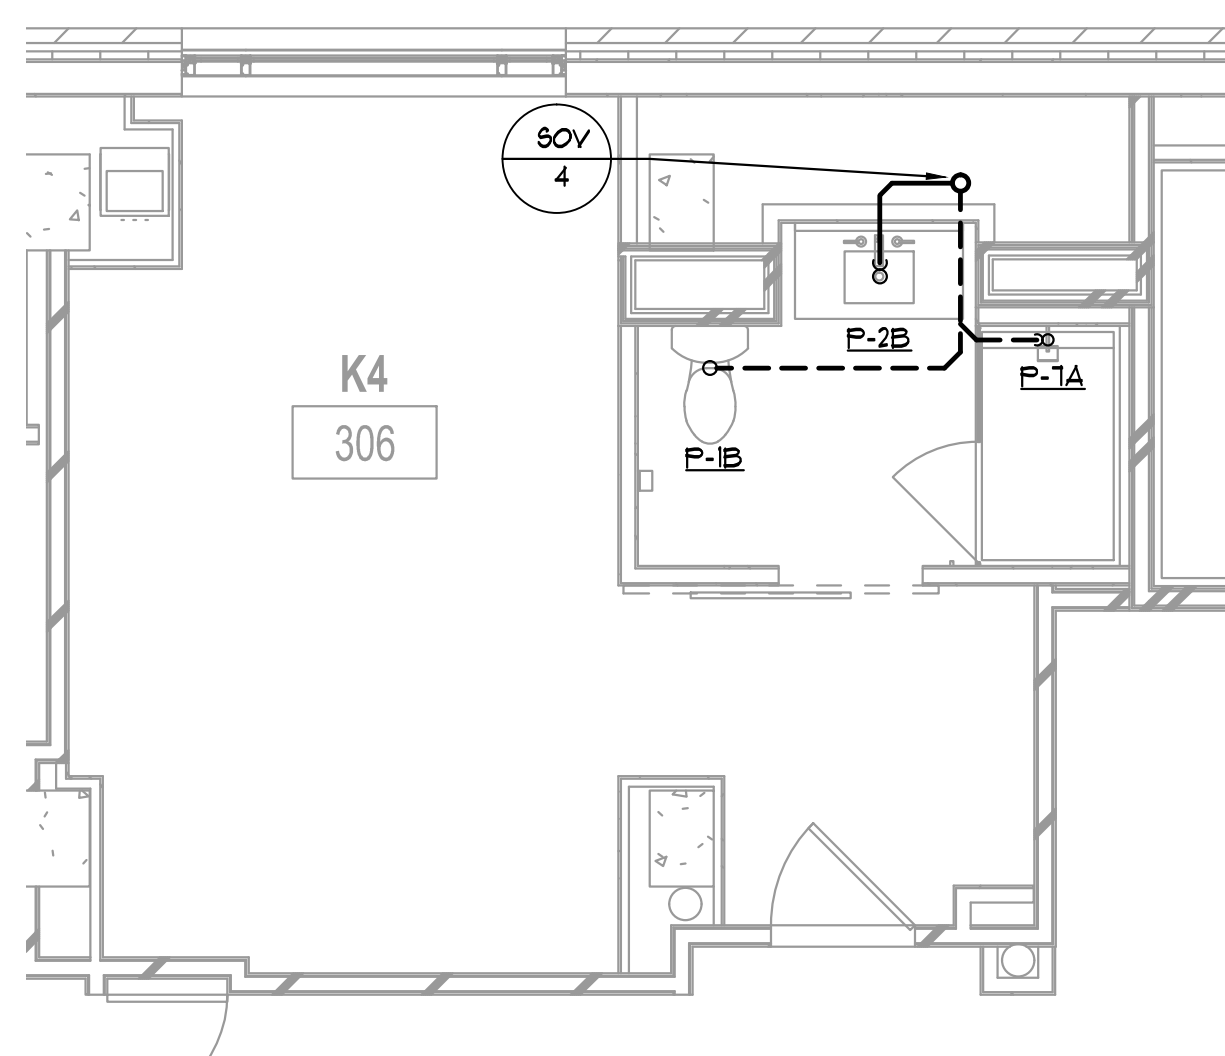

9 K4 PLAN – SANITARY & VENT
P4.01 1/4" = 1'-0"

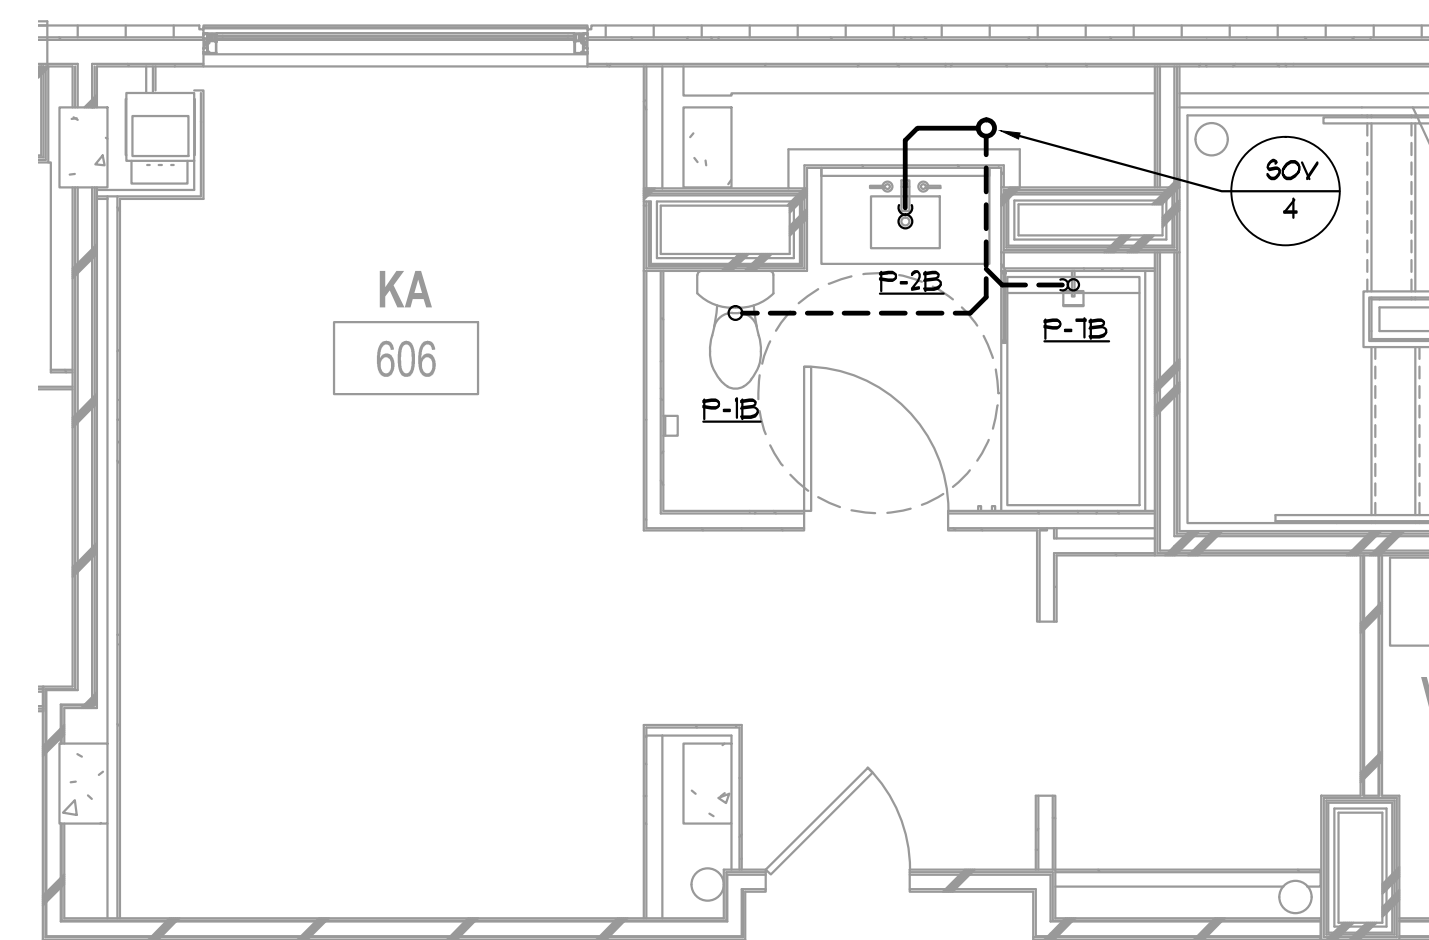

10 KA PLAN – SANITARY & VENT
P4.01 1/4" = 1'-0"

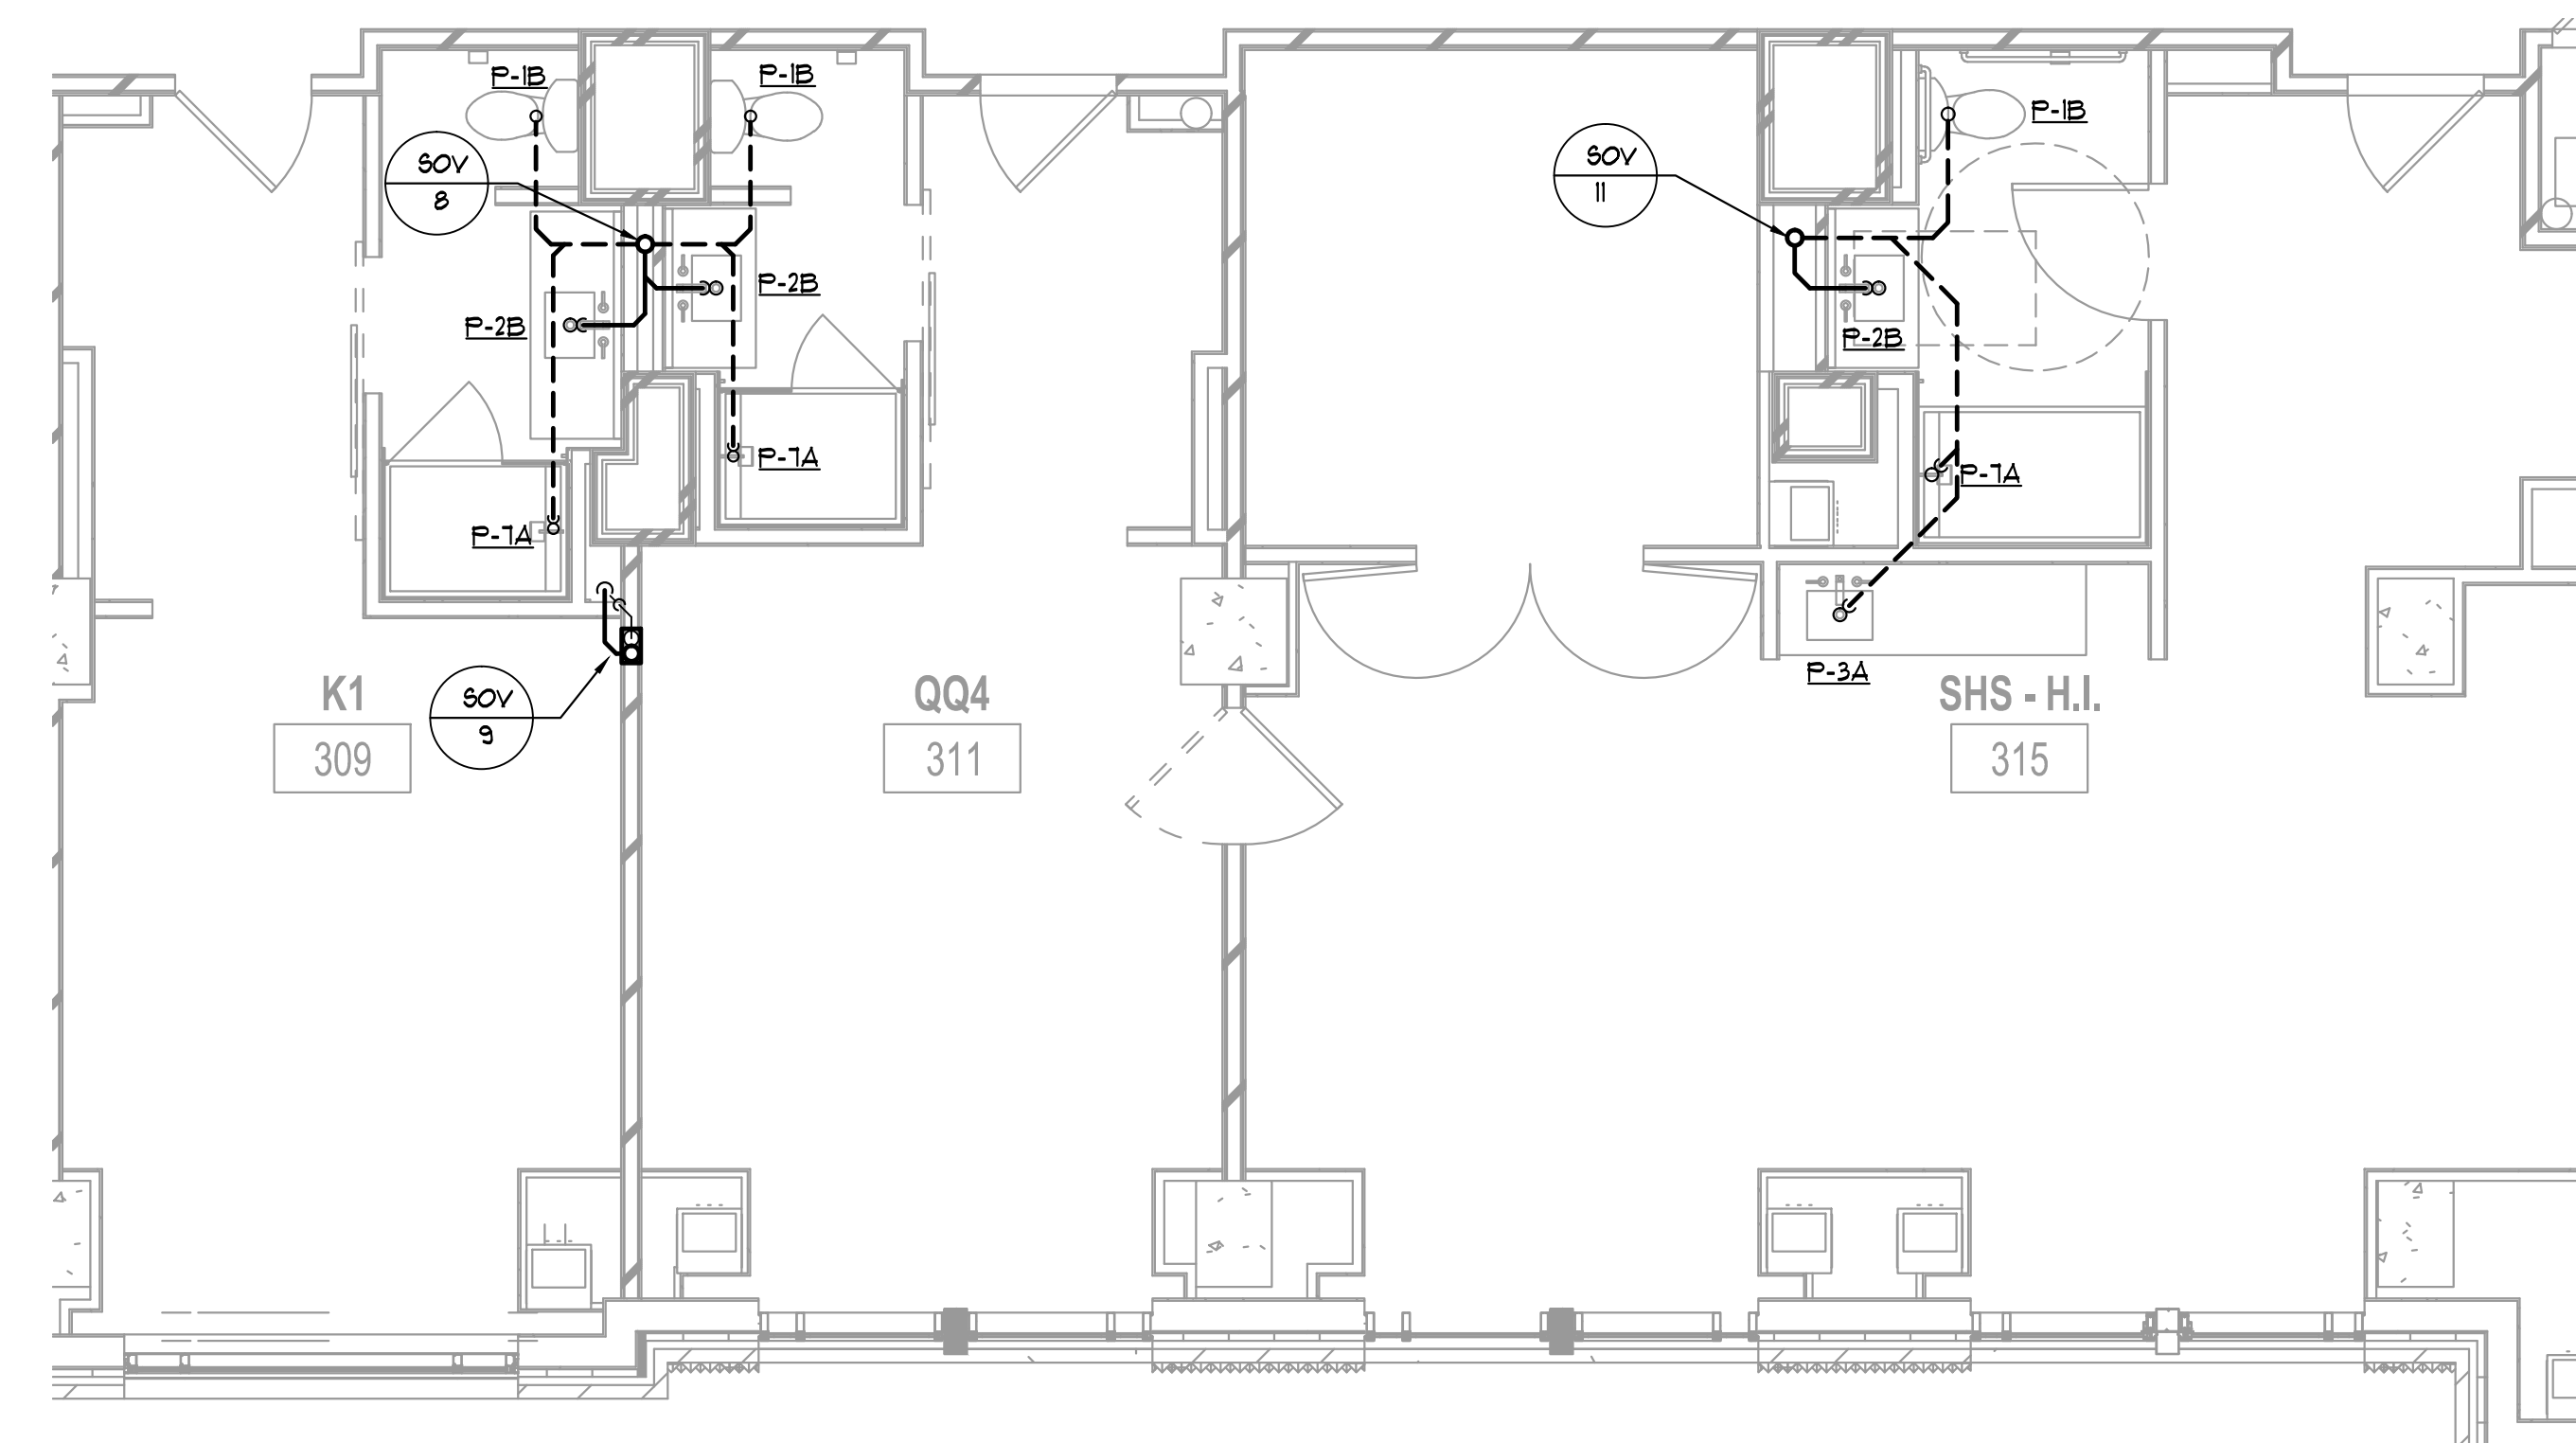

11 K1/QQ4/SHS PLAN – SANITARY & VENT
P4.01 1/4" = 1'-0"

ALPHARETTA CONFERENCE
CENTER & THE HOTEL AT
AVALON


9000 AVALON BOULEVARD /
ALPHARETTA, GEORGIA 30009

STORMONT HOSPITALITY GROUP, LLC /
NORTH AMERICAN PROPERTY GROUP


GUESTROOM PART
PLANS - SANITARY &
VENT

K. PRICE	140028
Principal in Charge	BW&A Project No.
G. JENKINS	101716
Project Engineer	Date
T. MERCER	
Checker	


P4.01

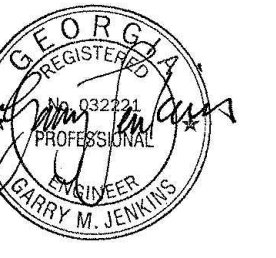


ISSUANCES		
No.	Drawing Issue Description	Date
1	BUILDING PERMIT	2016.10.17

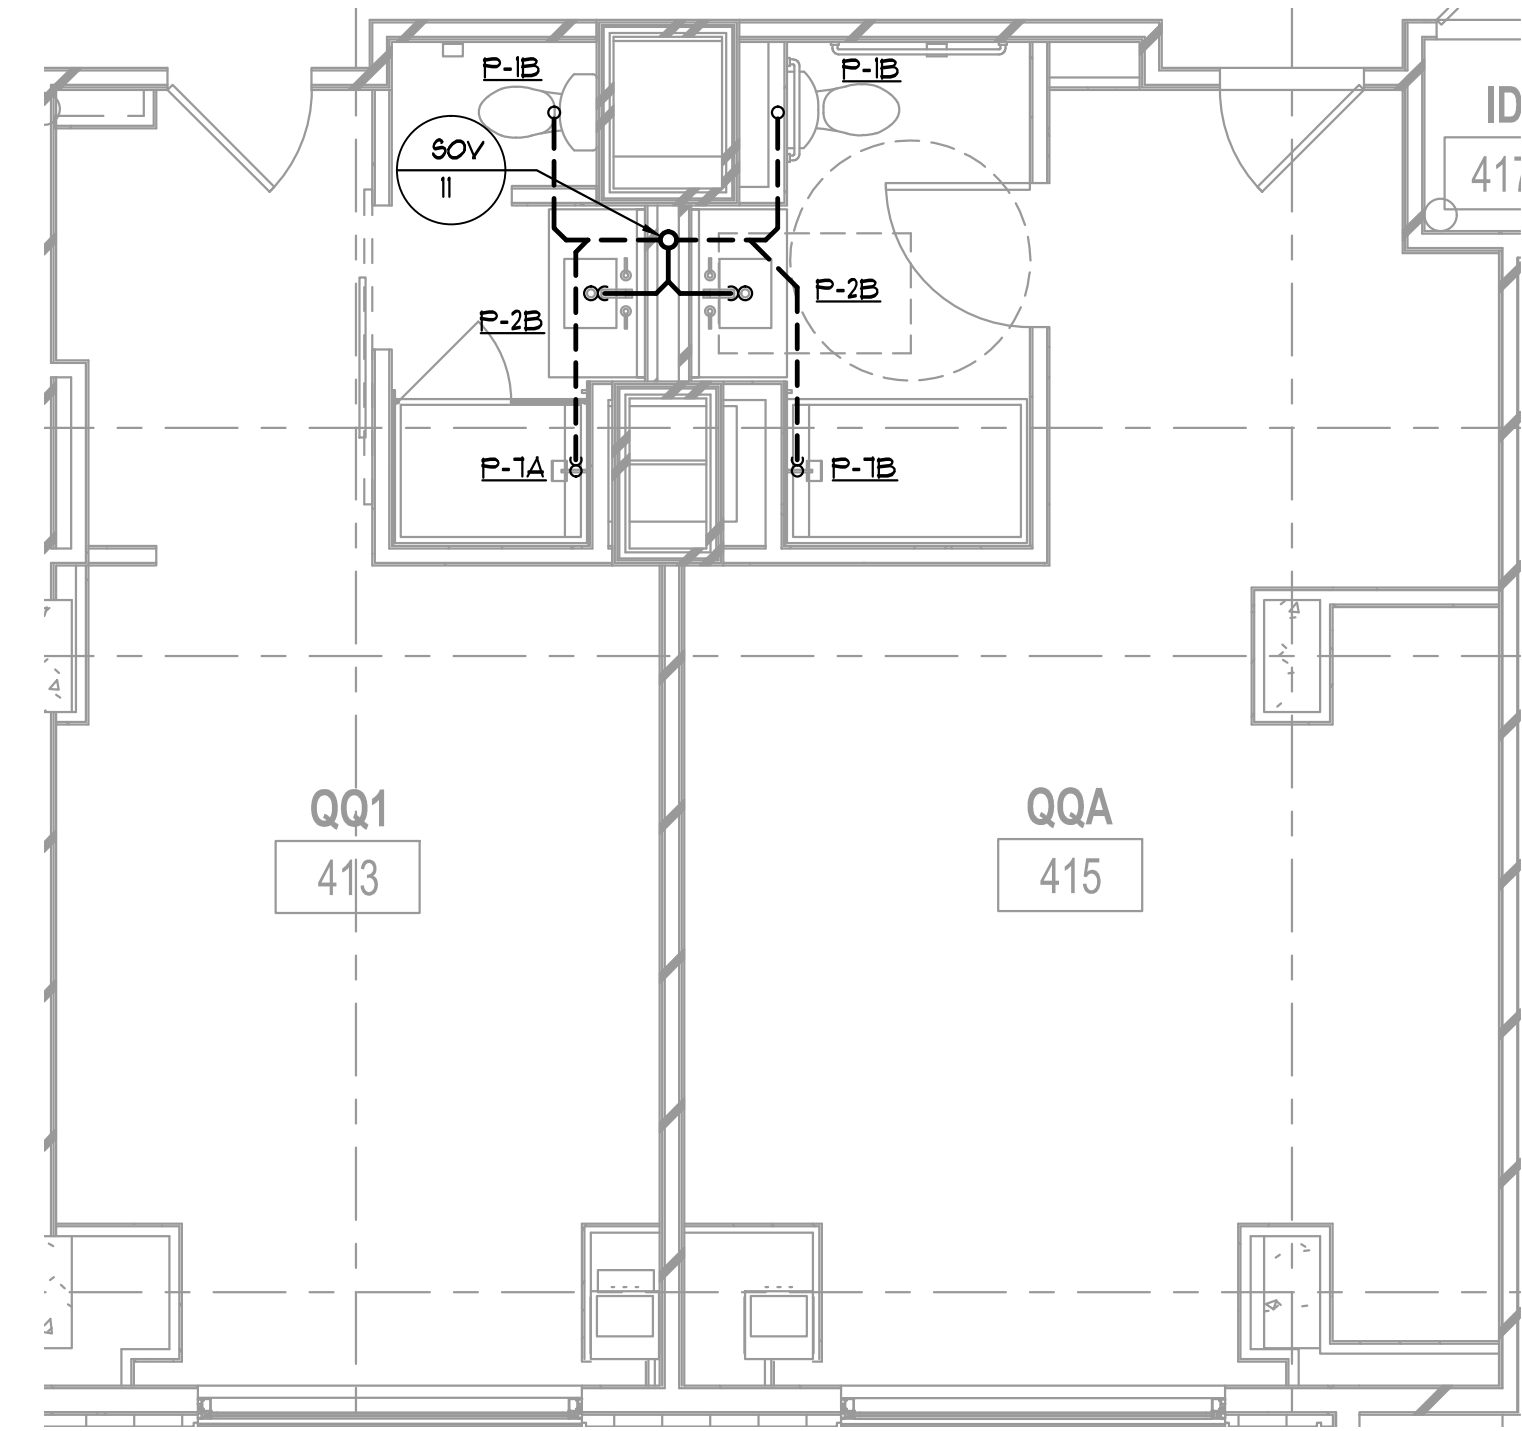


1 QQ1/QQA PLAN – SANITARY & VENT
P4.02 1/4" = 1'-0"

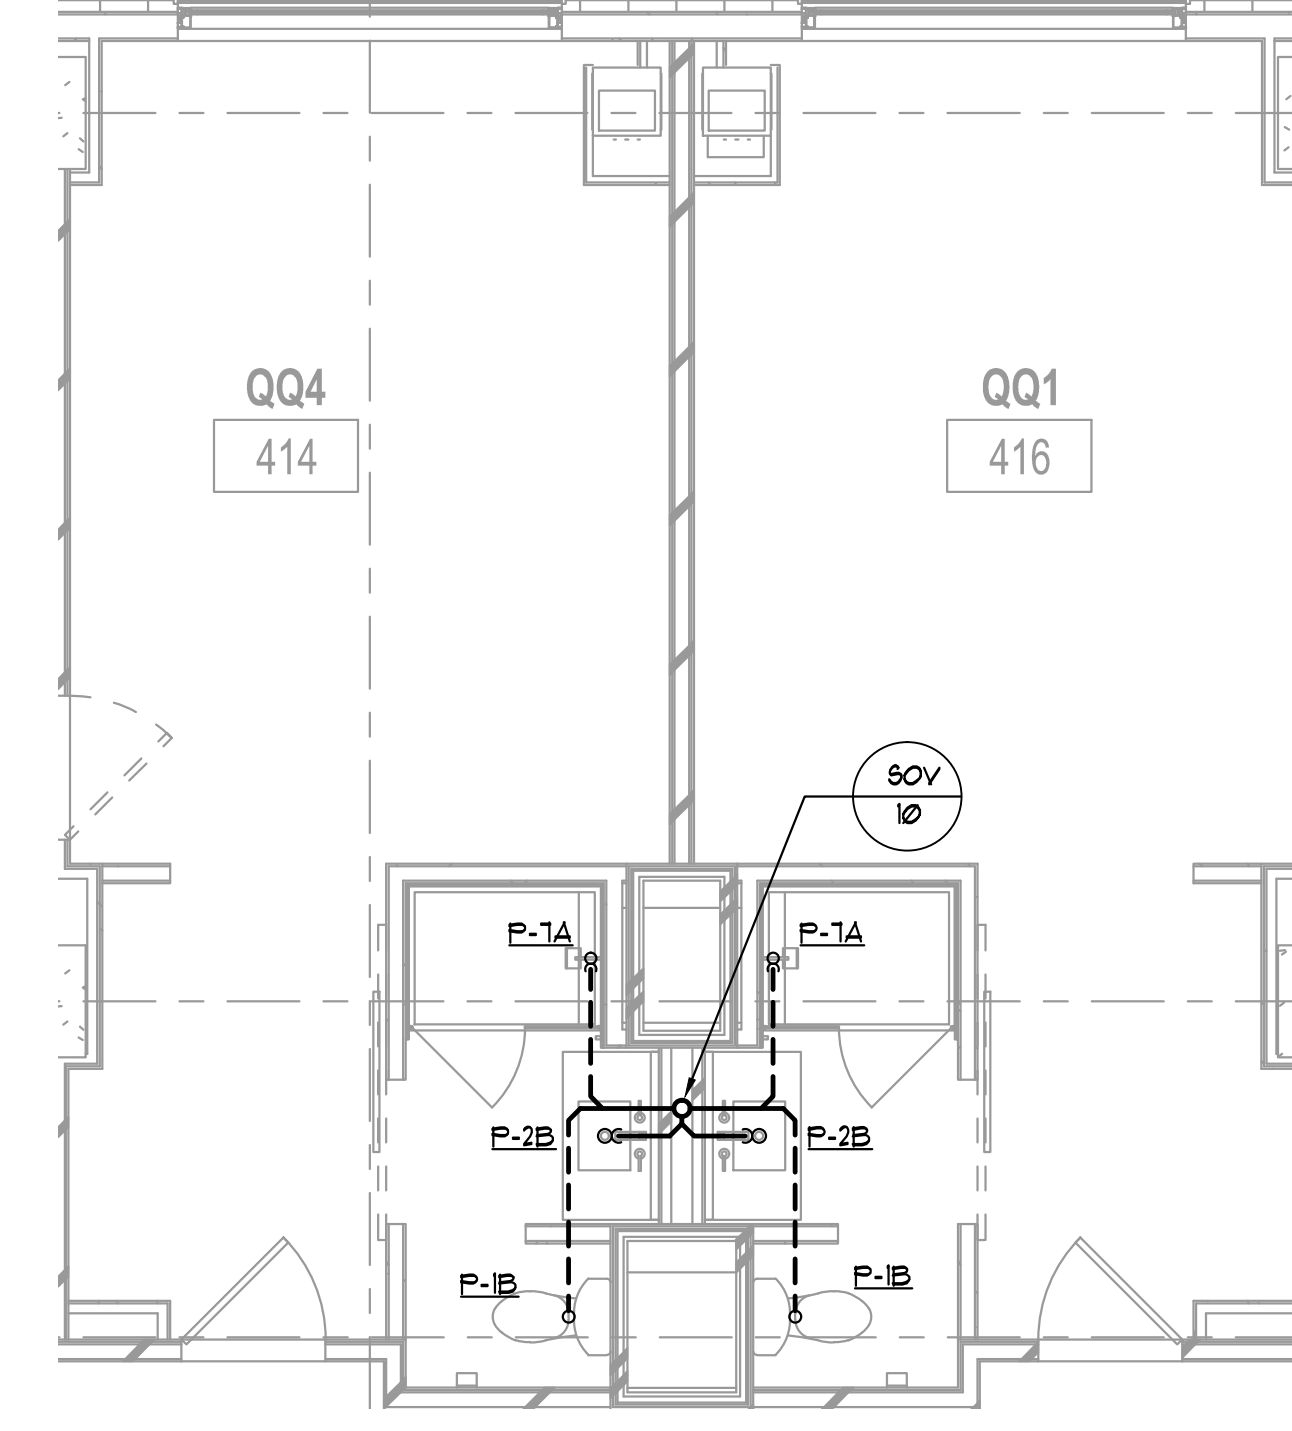


2 QQ4/QQ1 PLAN – SANITARY & VENT
P4.02 1/4" = 1'-0"

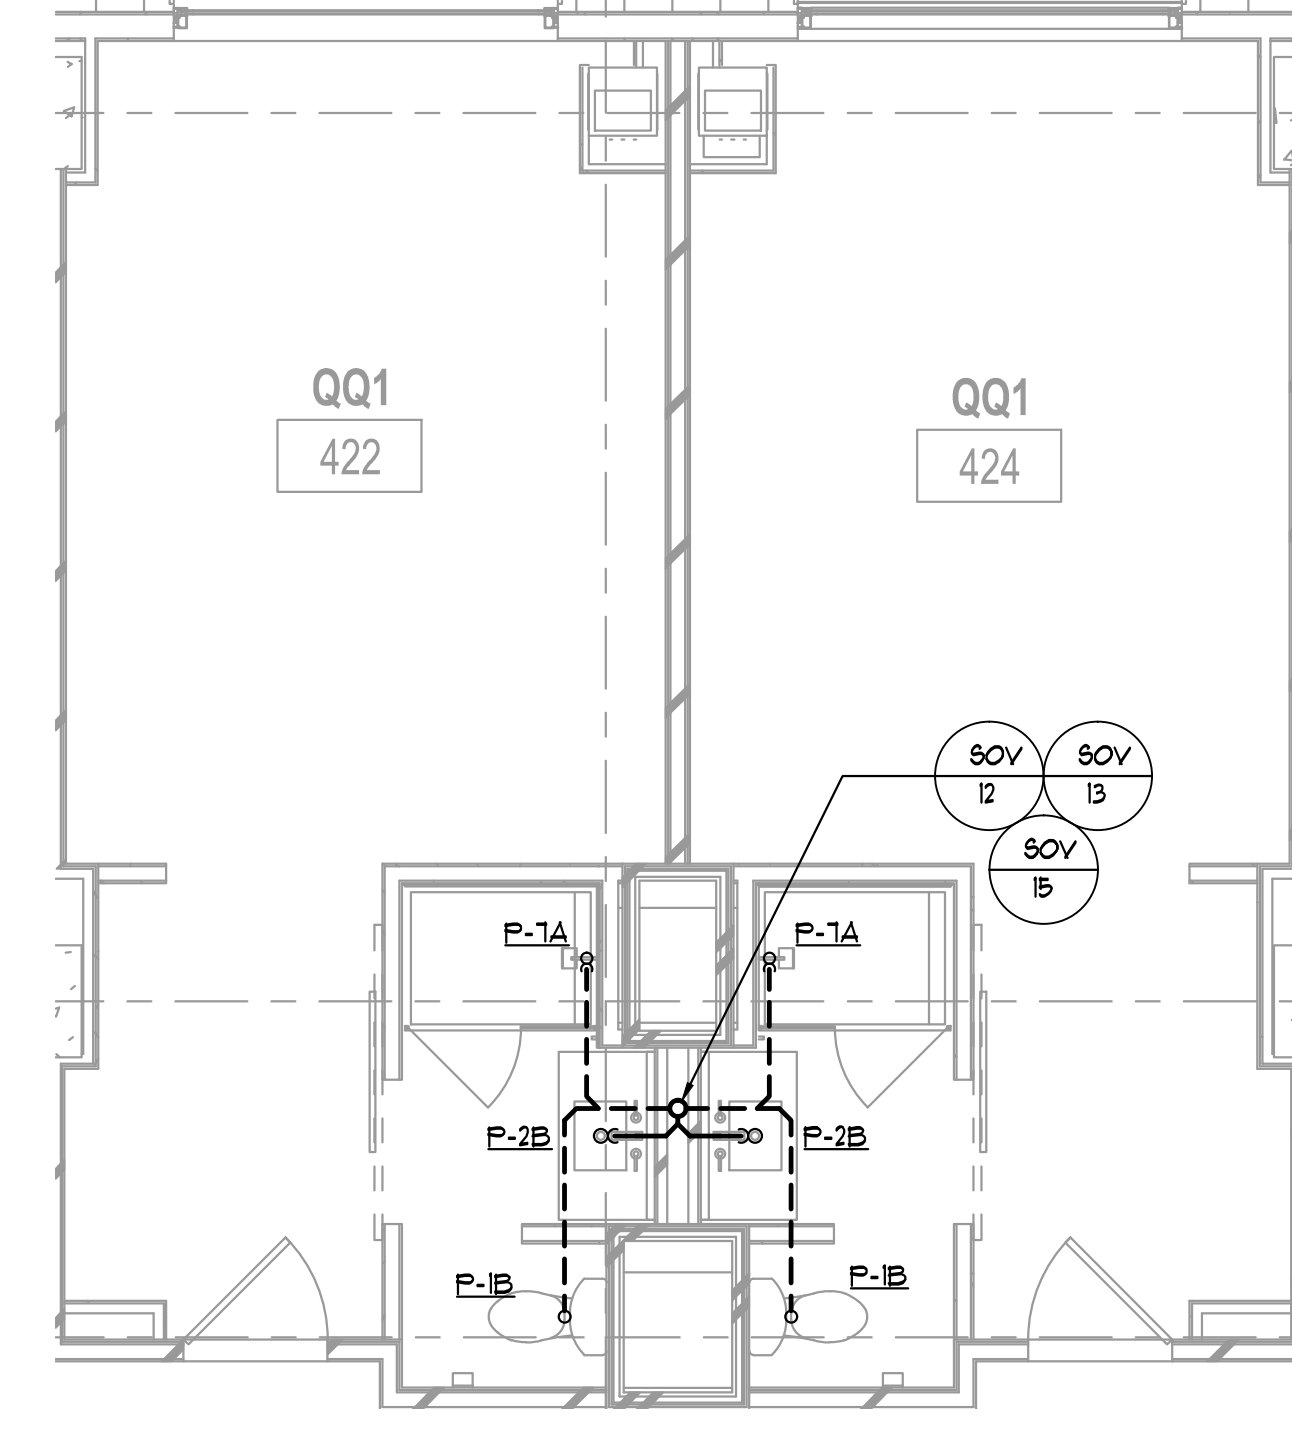


3 QQ1/QQ1 PLAN (TYP.) – SANITARY & VENT
P4.02 1/4" = 1'-0"

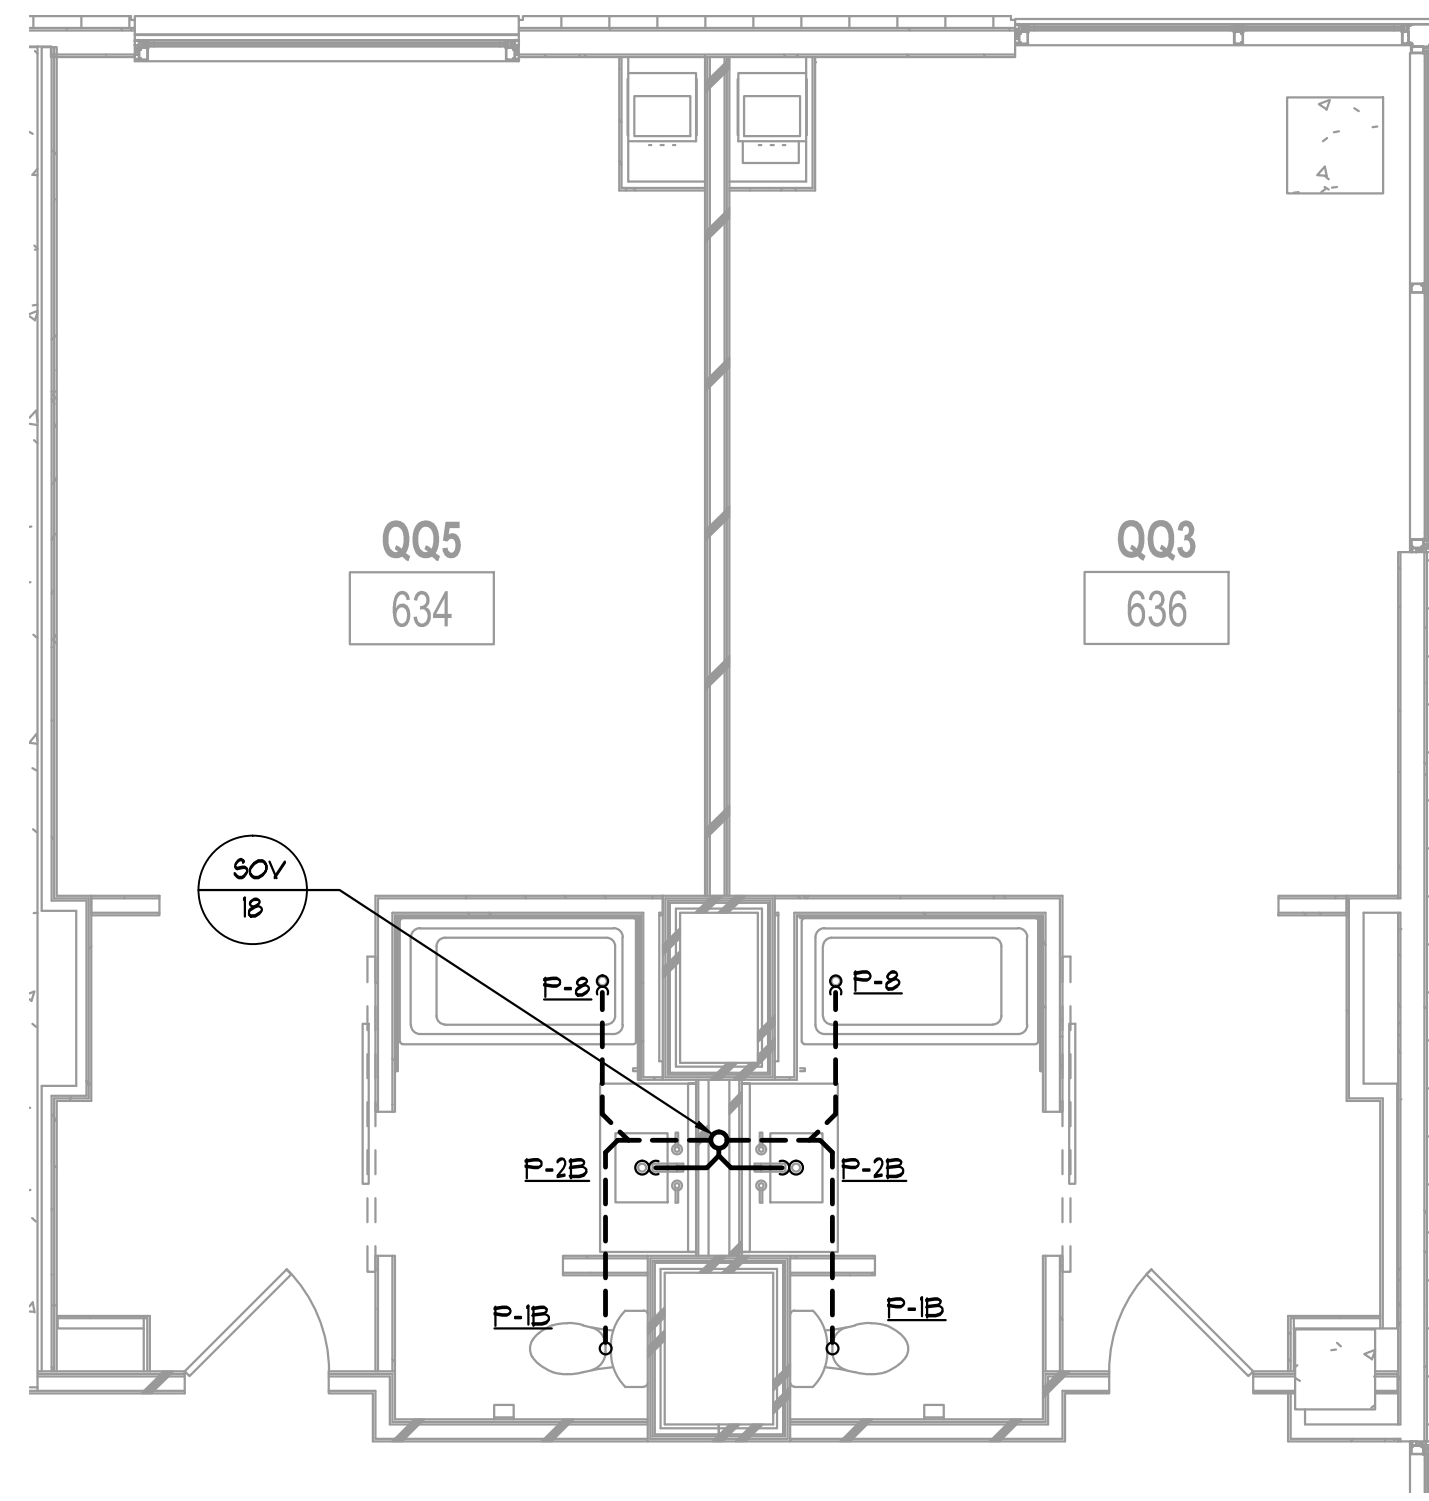


4 QQ3/QQ5 PLAN – SANITARY & VENT
P4.02 1/4" = 1'-0"

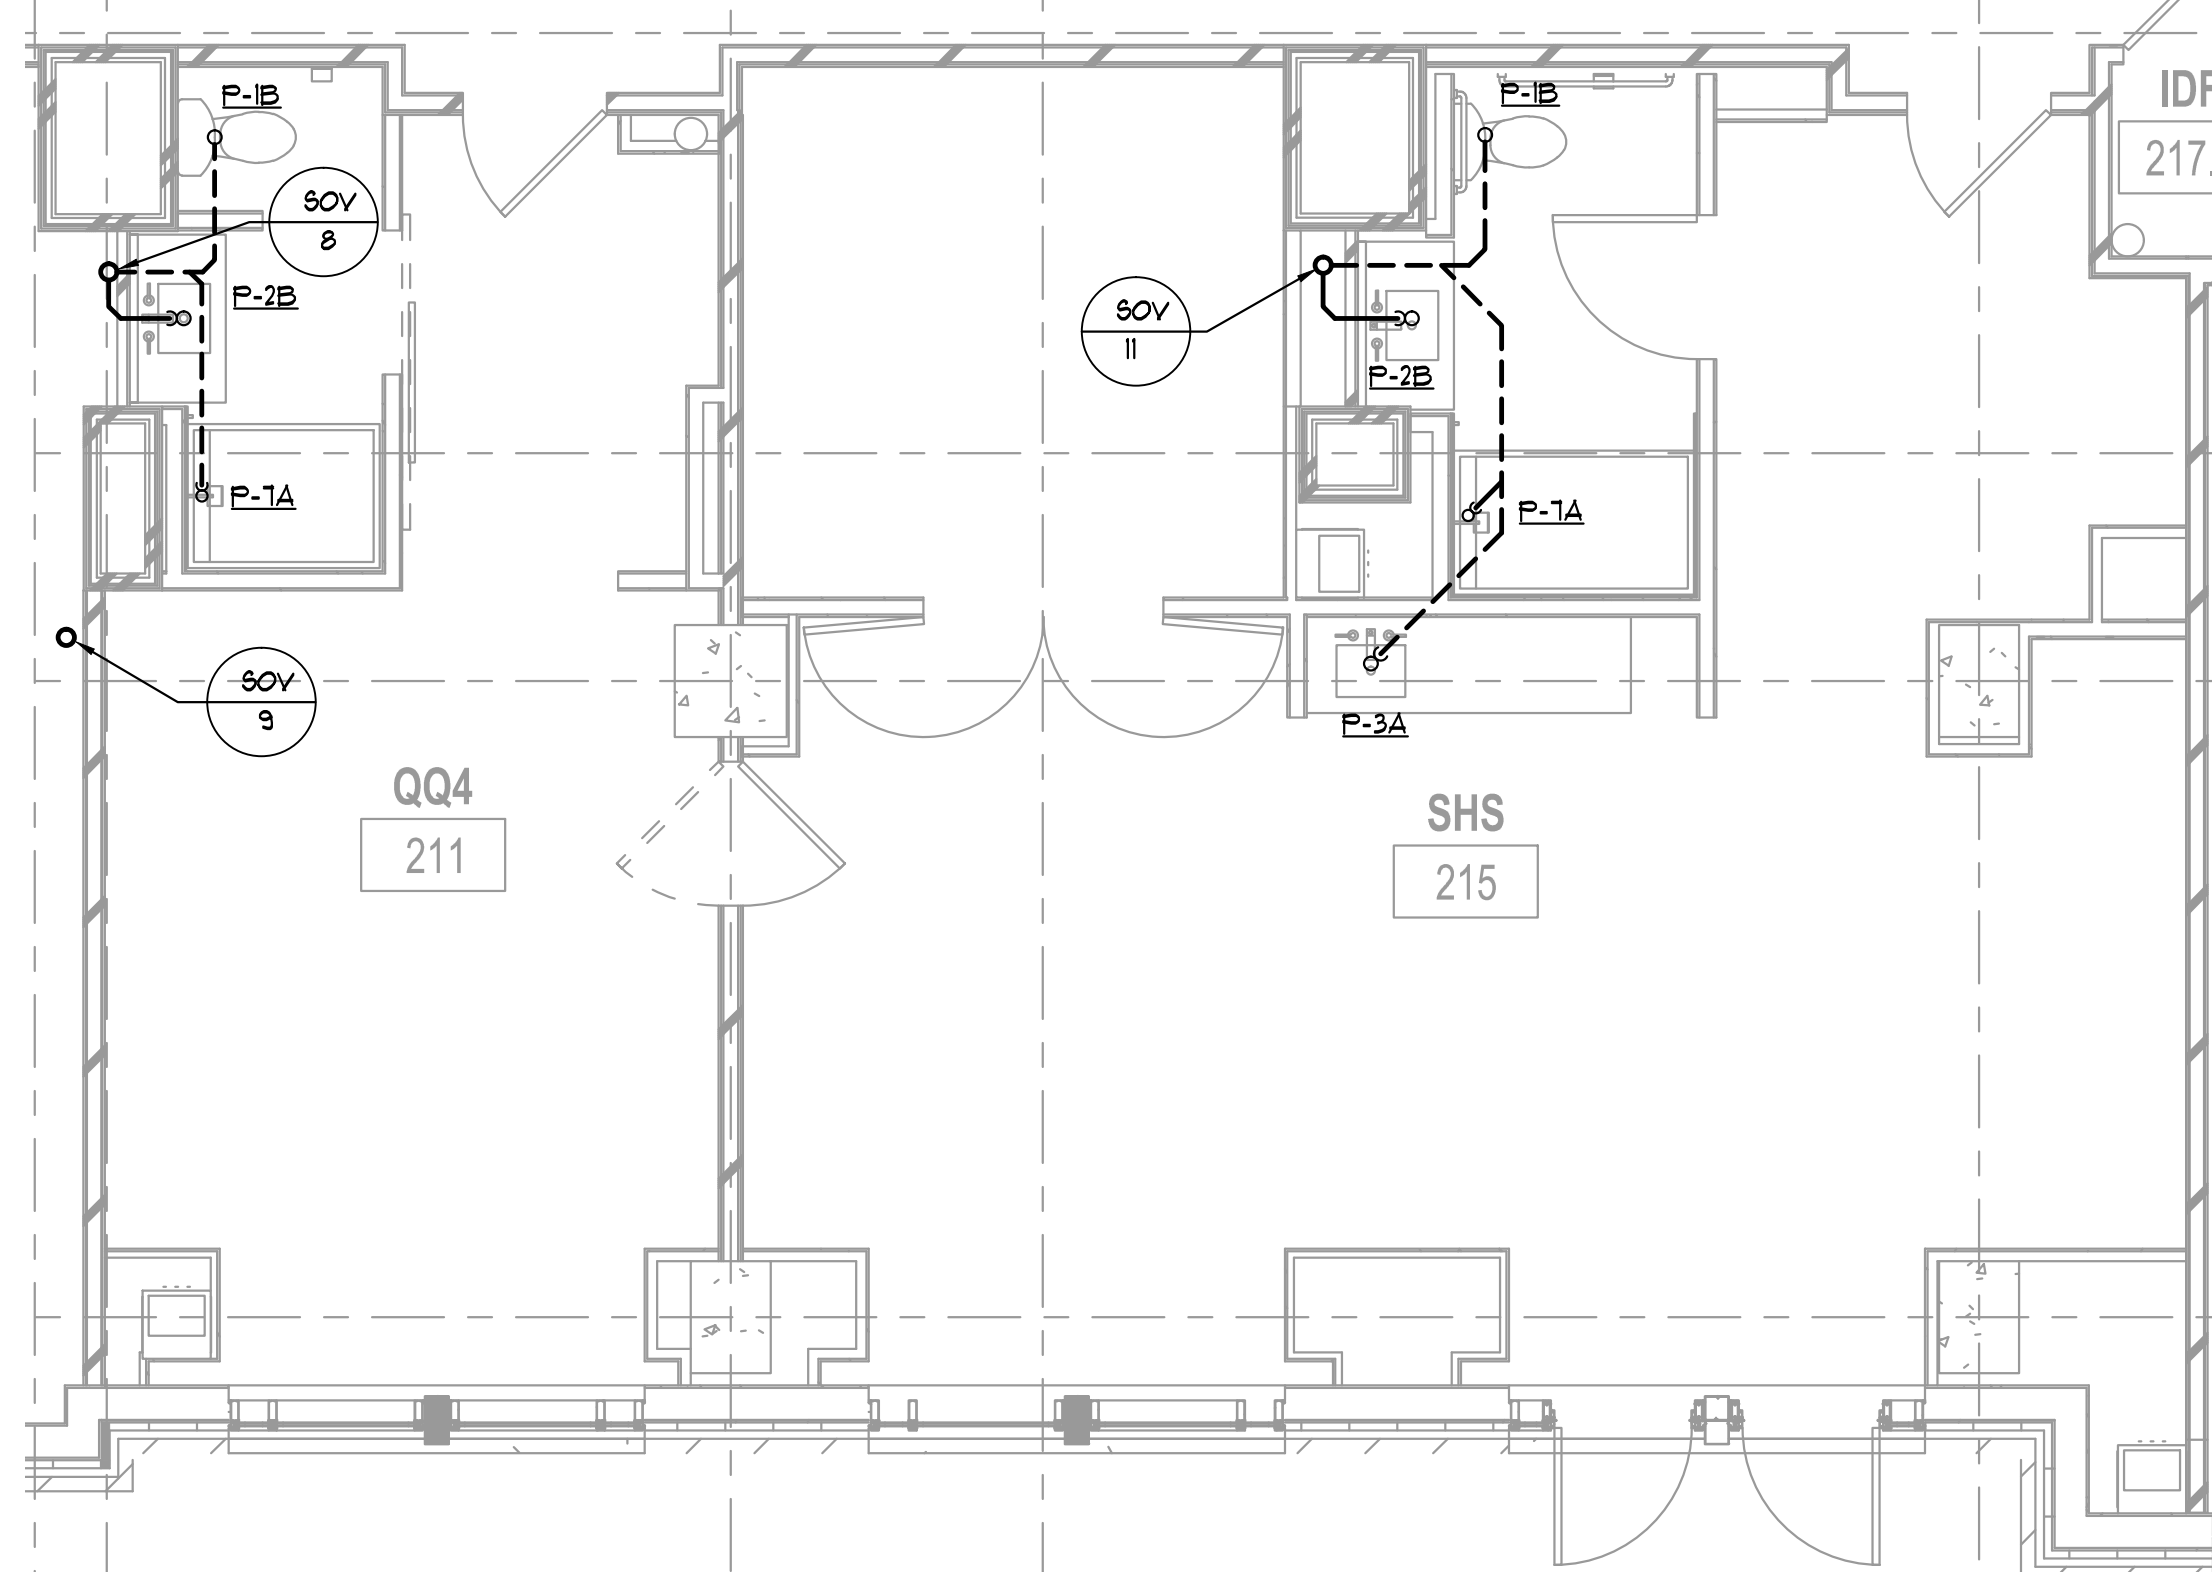


5 QQ4/SHS PLAN – SANITARY & VENT
P4.02 1/4" = 1'-0"

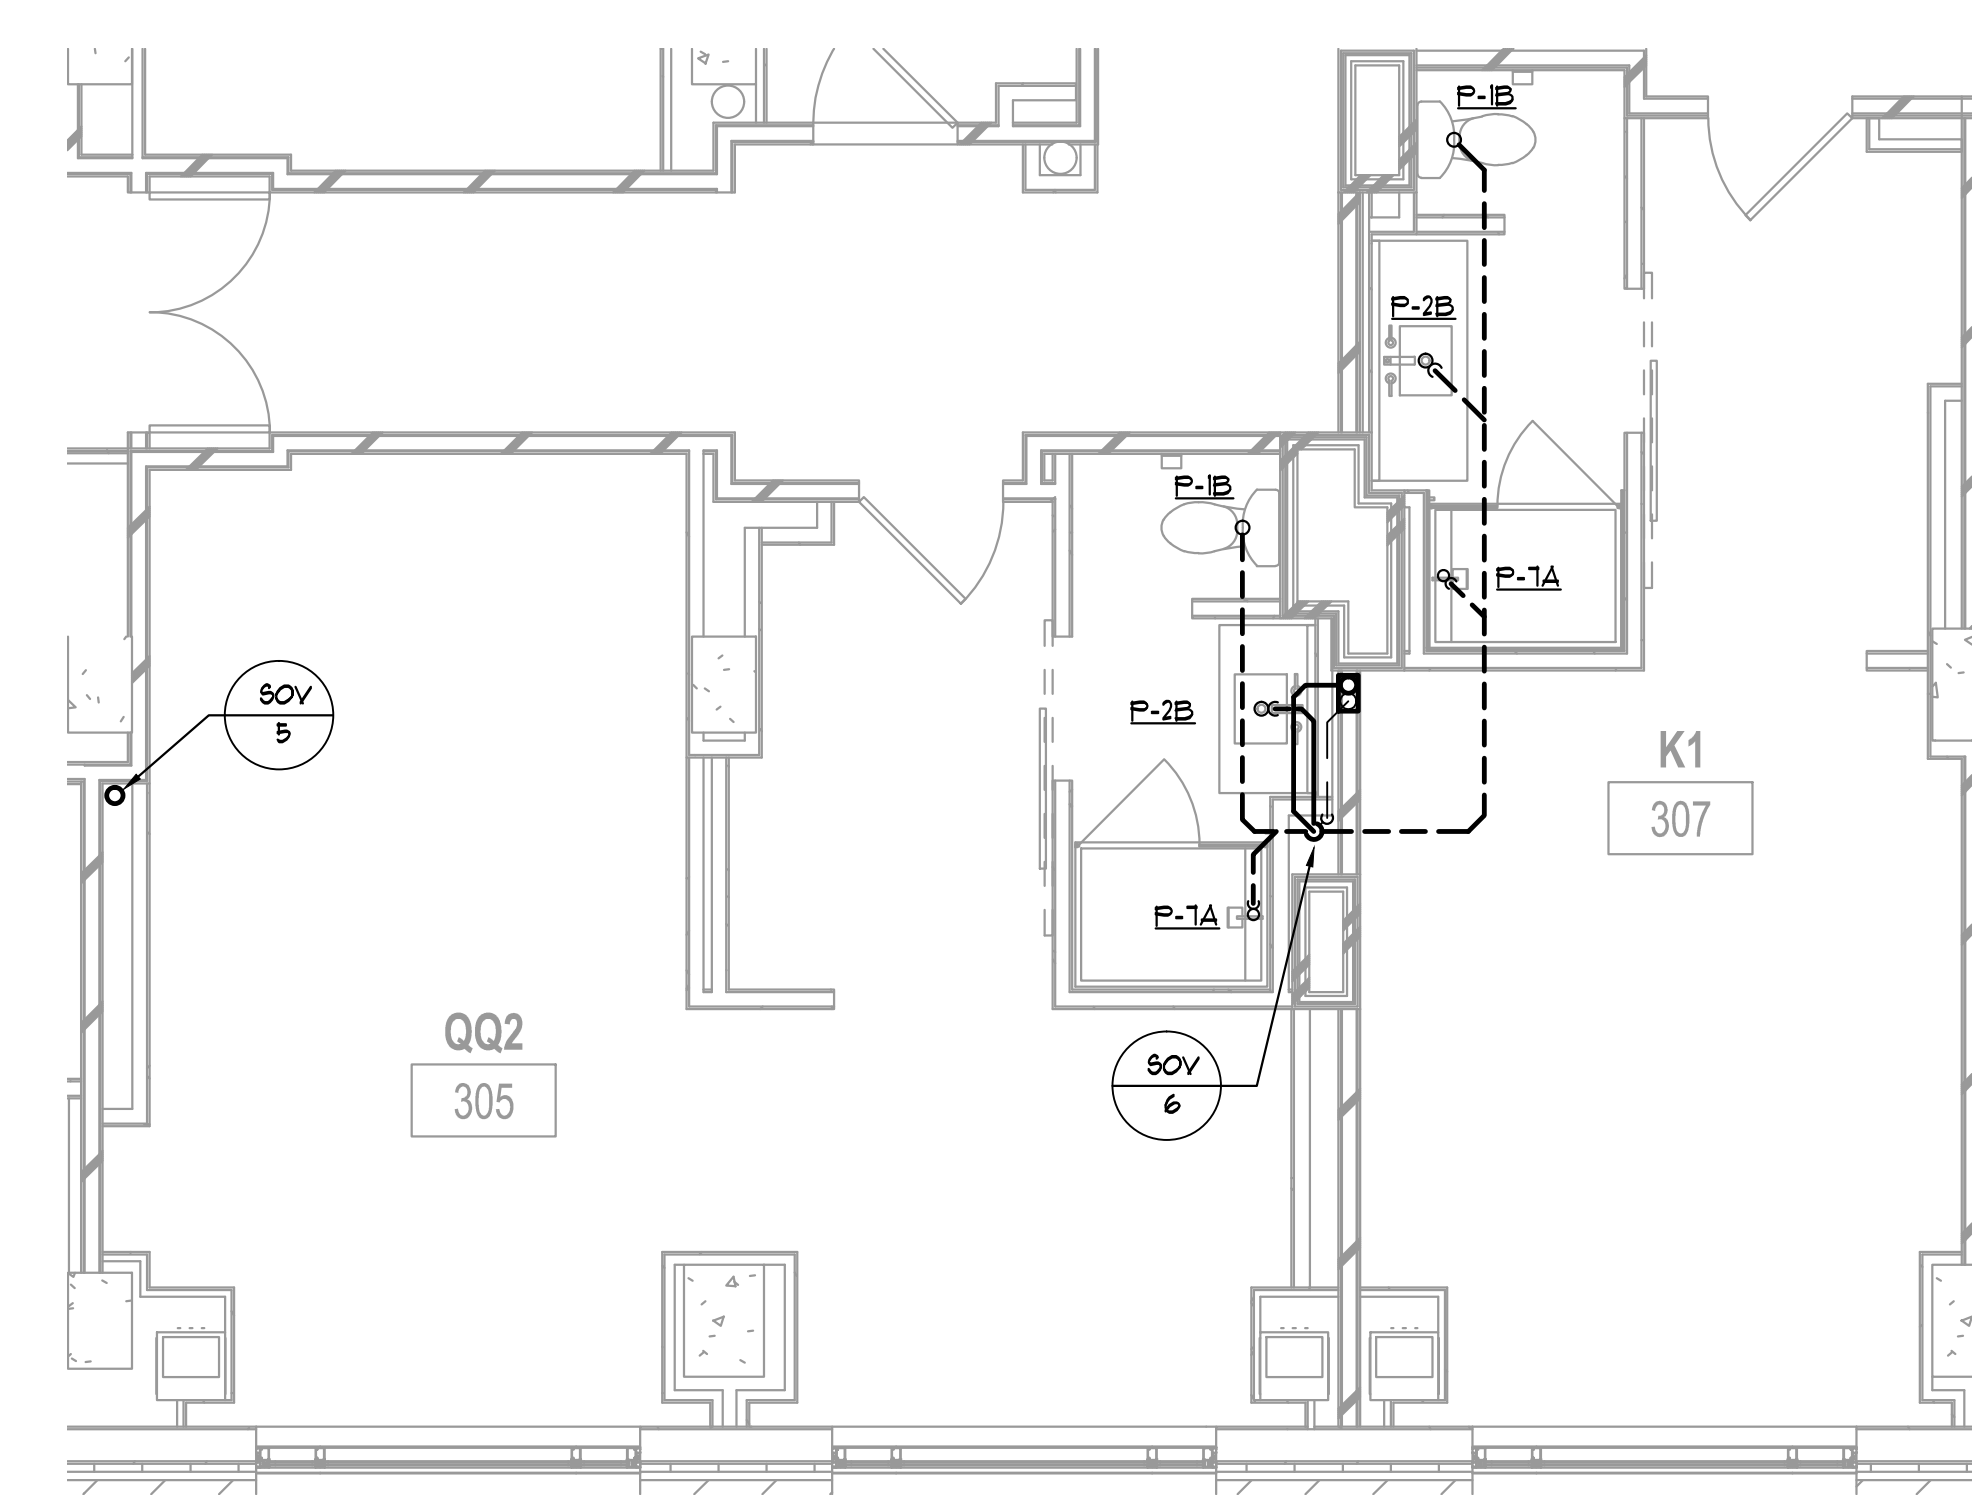

6 QQ2/K1 PLAN – SANITARY & VENT
P4.02 1/4" = 1'-0"

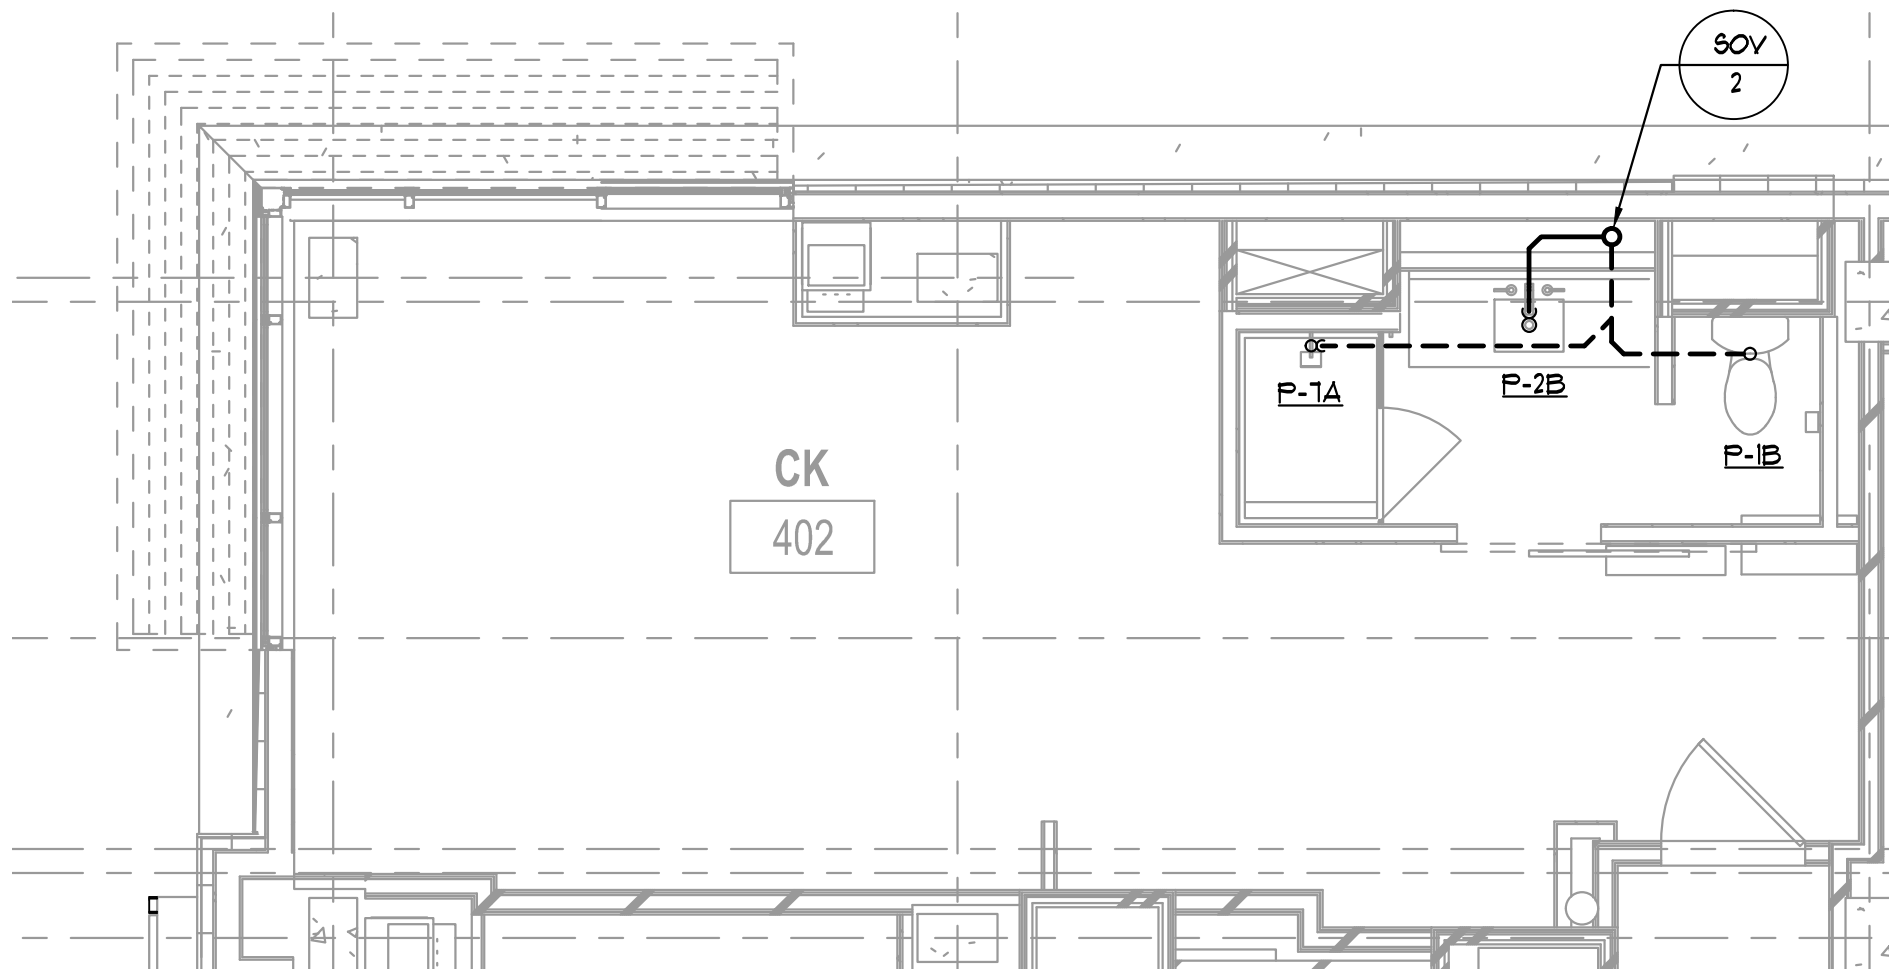

7 CK PLAN – SANITARY & VENT
P4.02 1/4" = 1'-0"

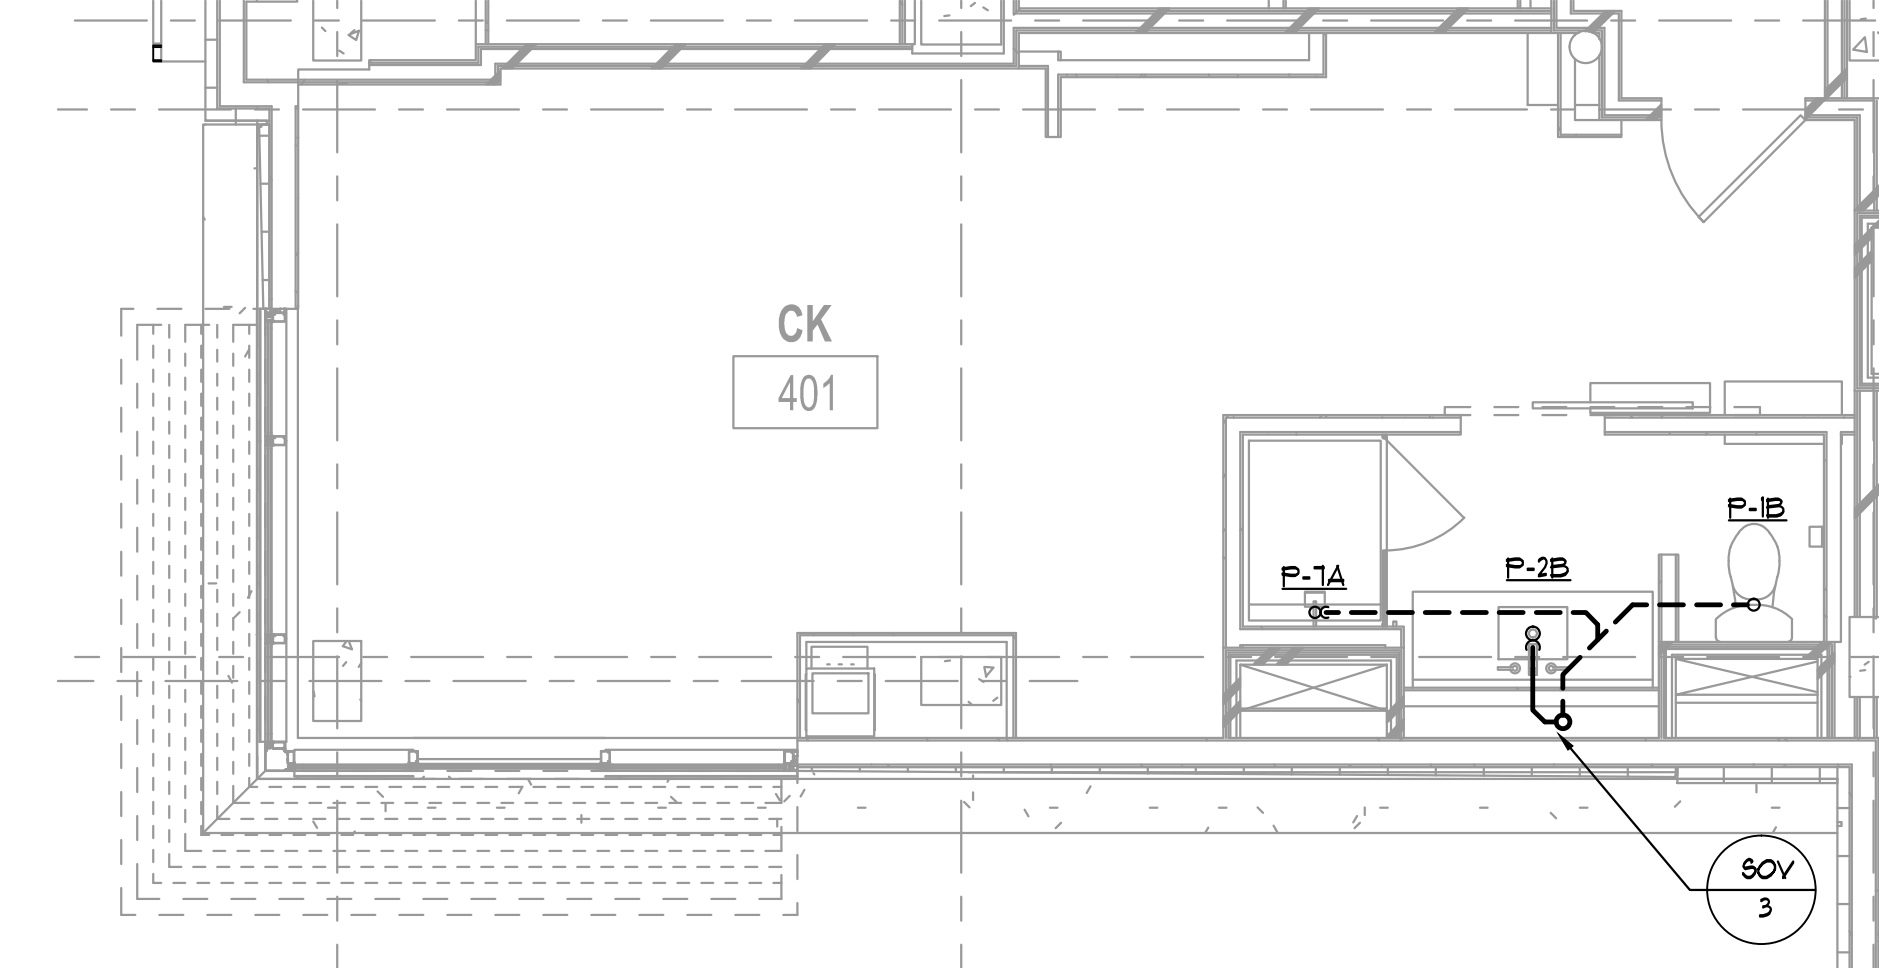

8 CK PLAN – SANITARY & VENT
P4.02 1/4" = 1'-0"

ALPHARETTA CONFERENCE
CENTER & THE HOTEL AT
AVALON

9000 AVALON BOULEVARD /
ALPHARETTA, GEORGIA 30009


STORMONT HOSPITALITY GROUP, LLC /
NORTH AMERICAN PROPERTY GROUP

GUESTROOM PART
PLANS - SANITARY &
VENT


K. PRICE	140028
Principal in Charge	BW&A Project No.
G. JENKINS	101716
Project Engineer	Date
T. MERCER	
Checker	

P4.02


ISSUED FOR CONSTRUCTION

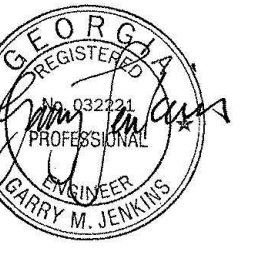


ISSUANCES		
No.	Drawing Issue Description	Date
	BUILDING PERMIT	2016.10.17

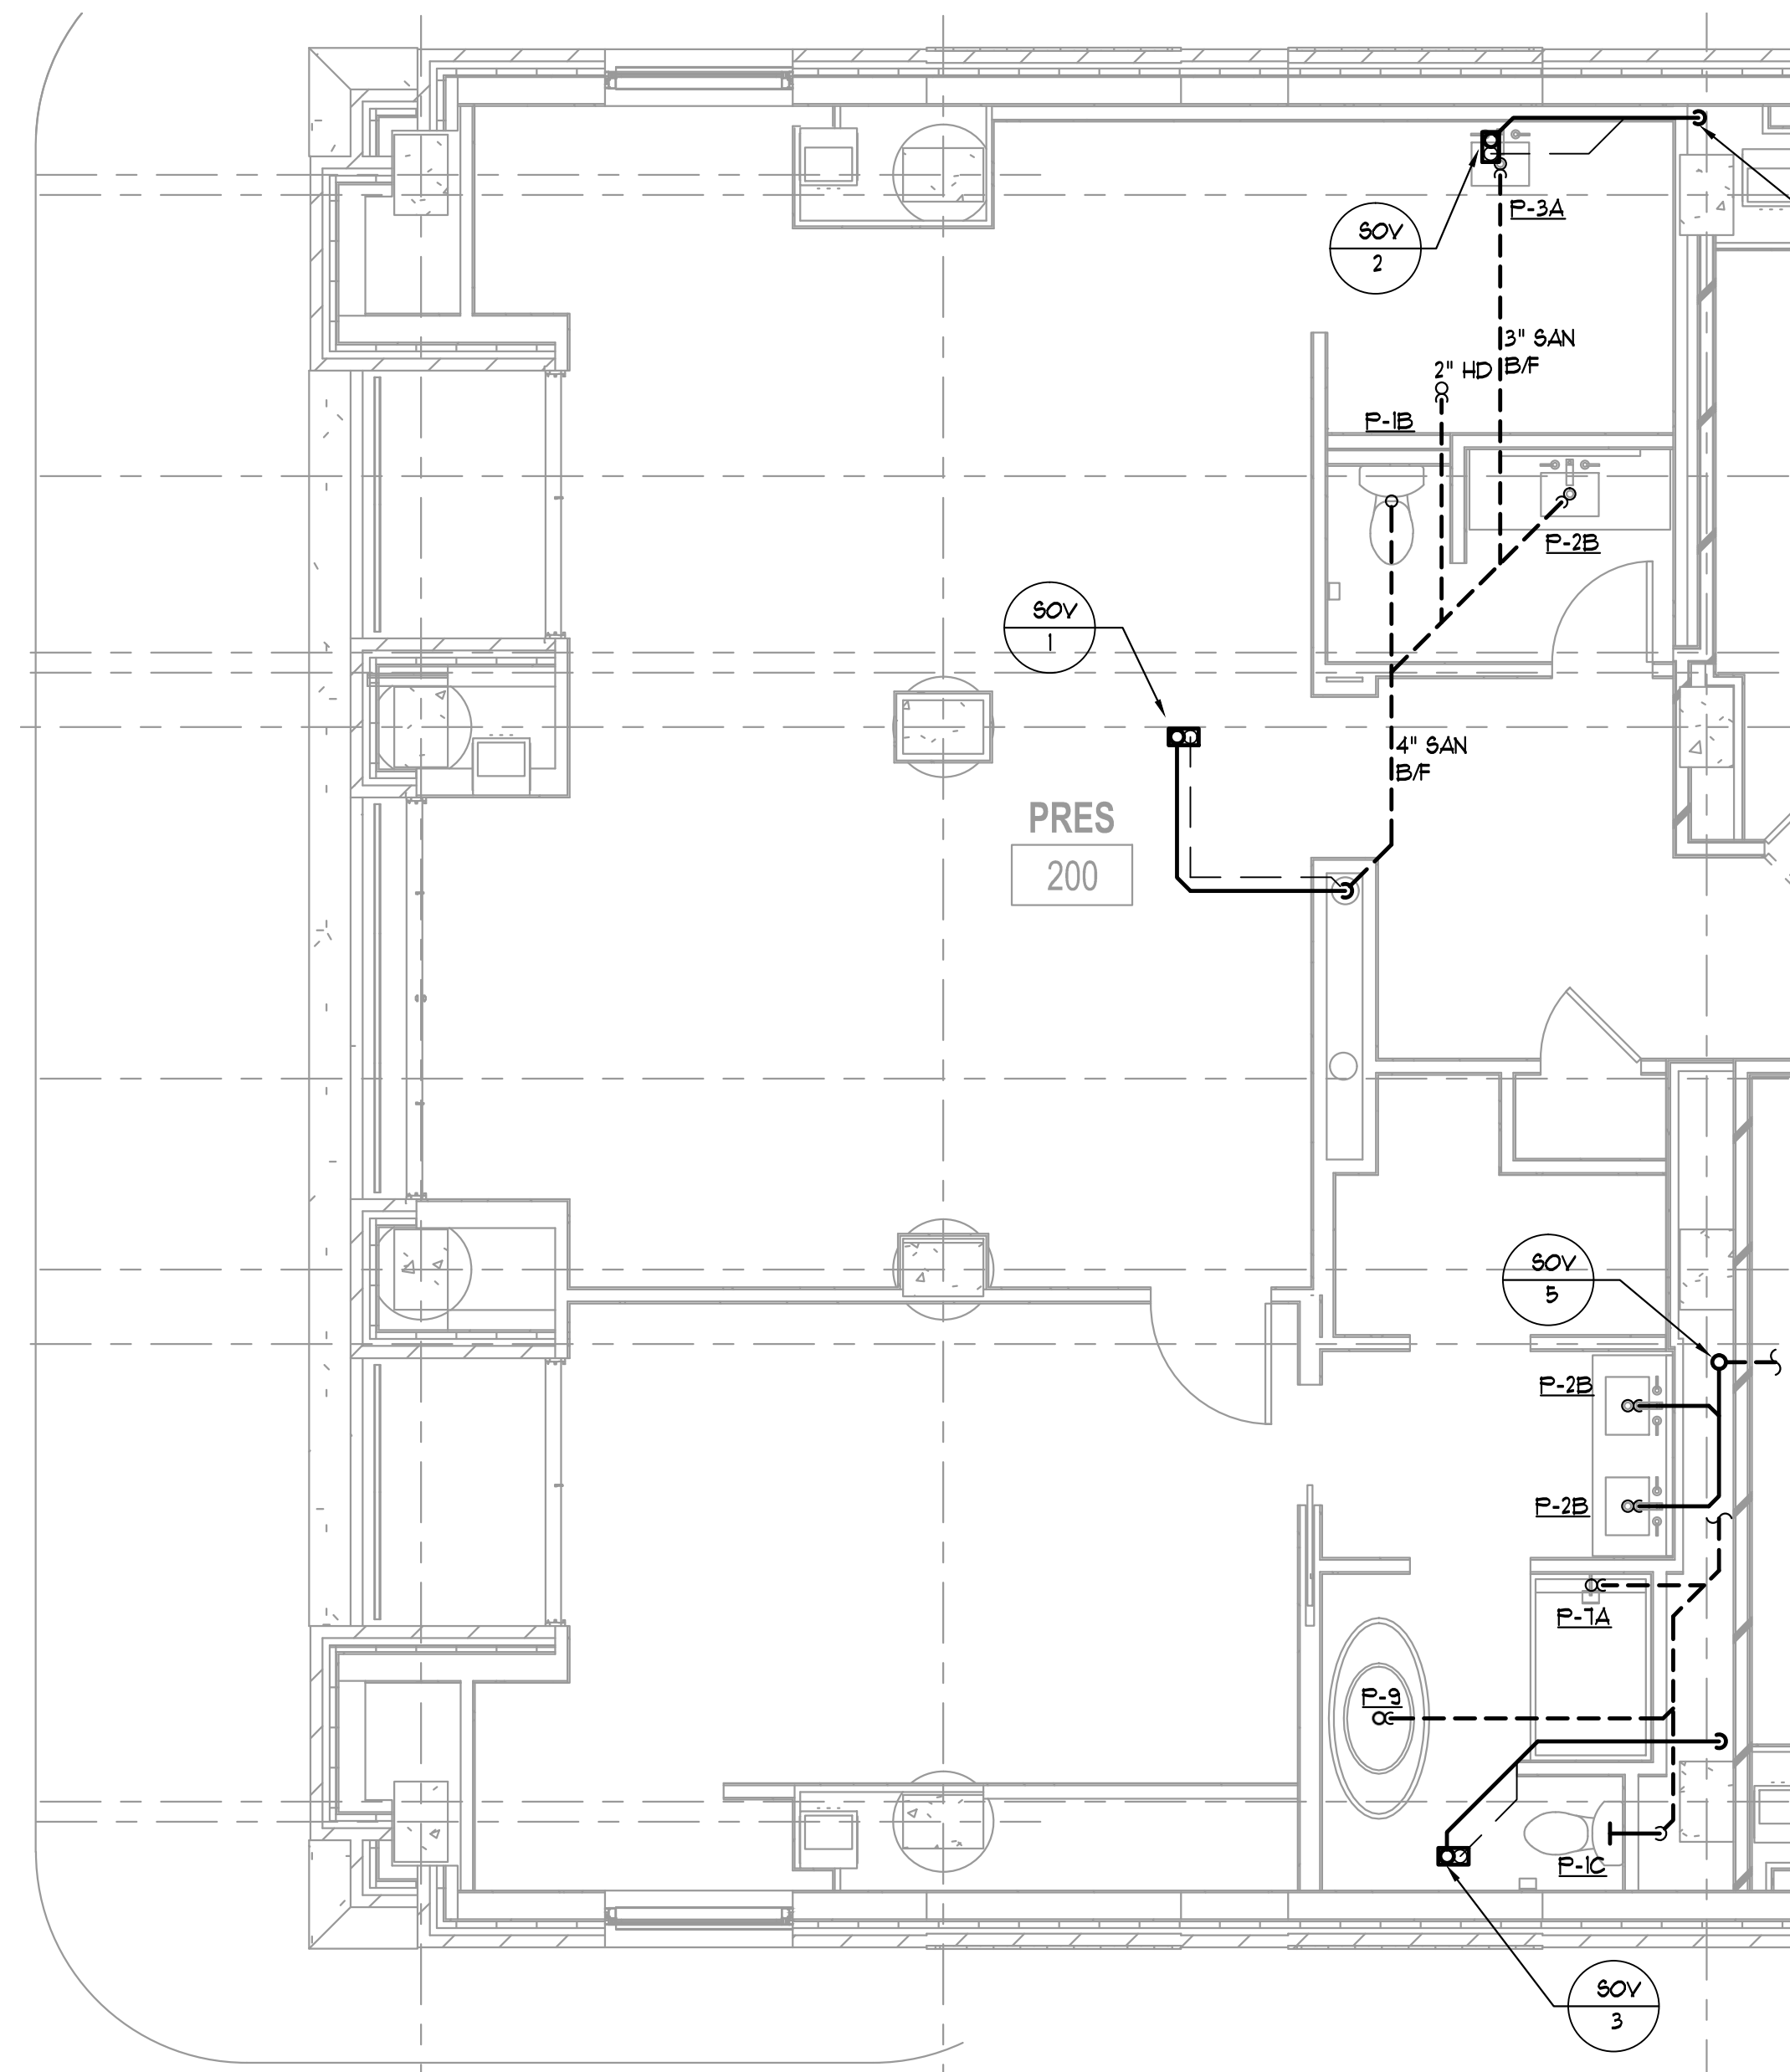


1 PRES PLAN - SANITARY & VENT
P4.03 1/4" = 1'-0"

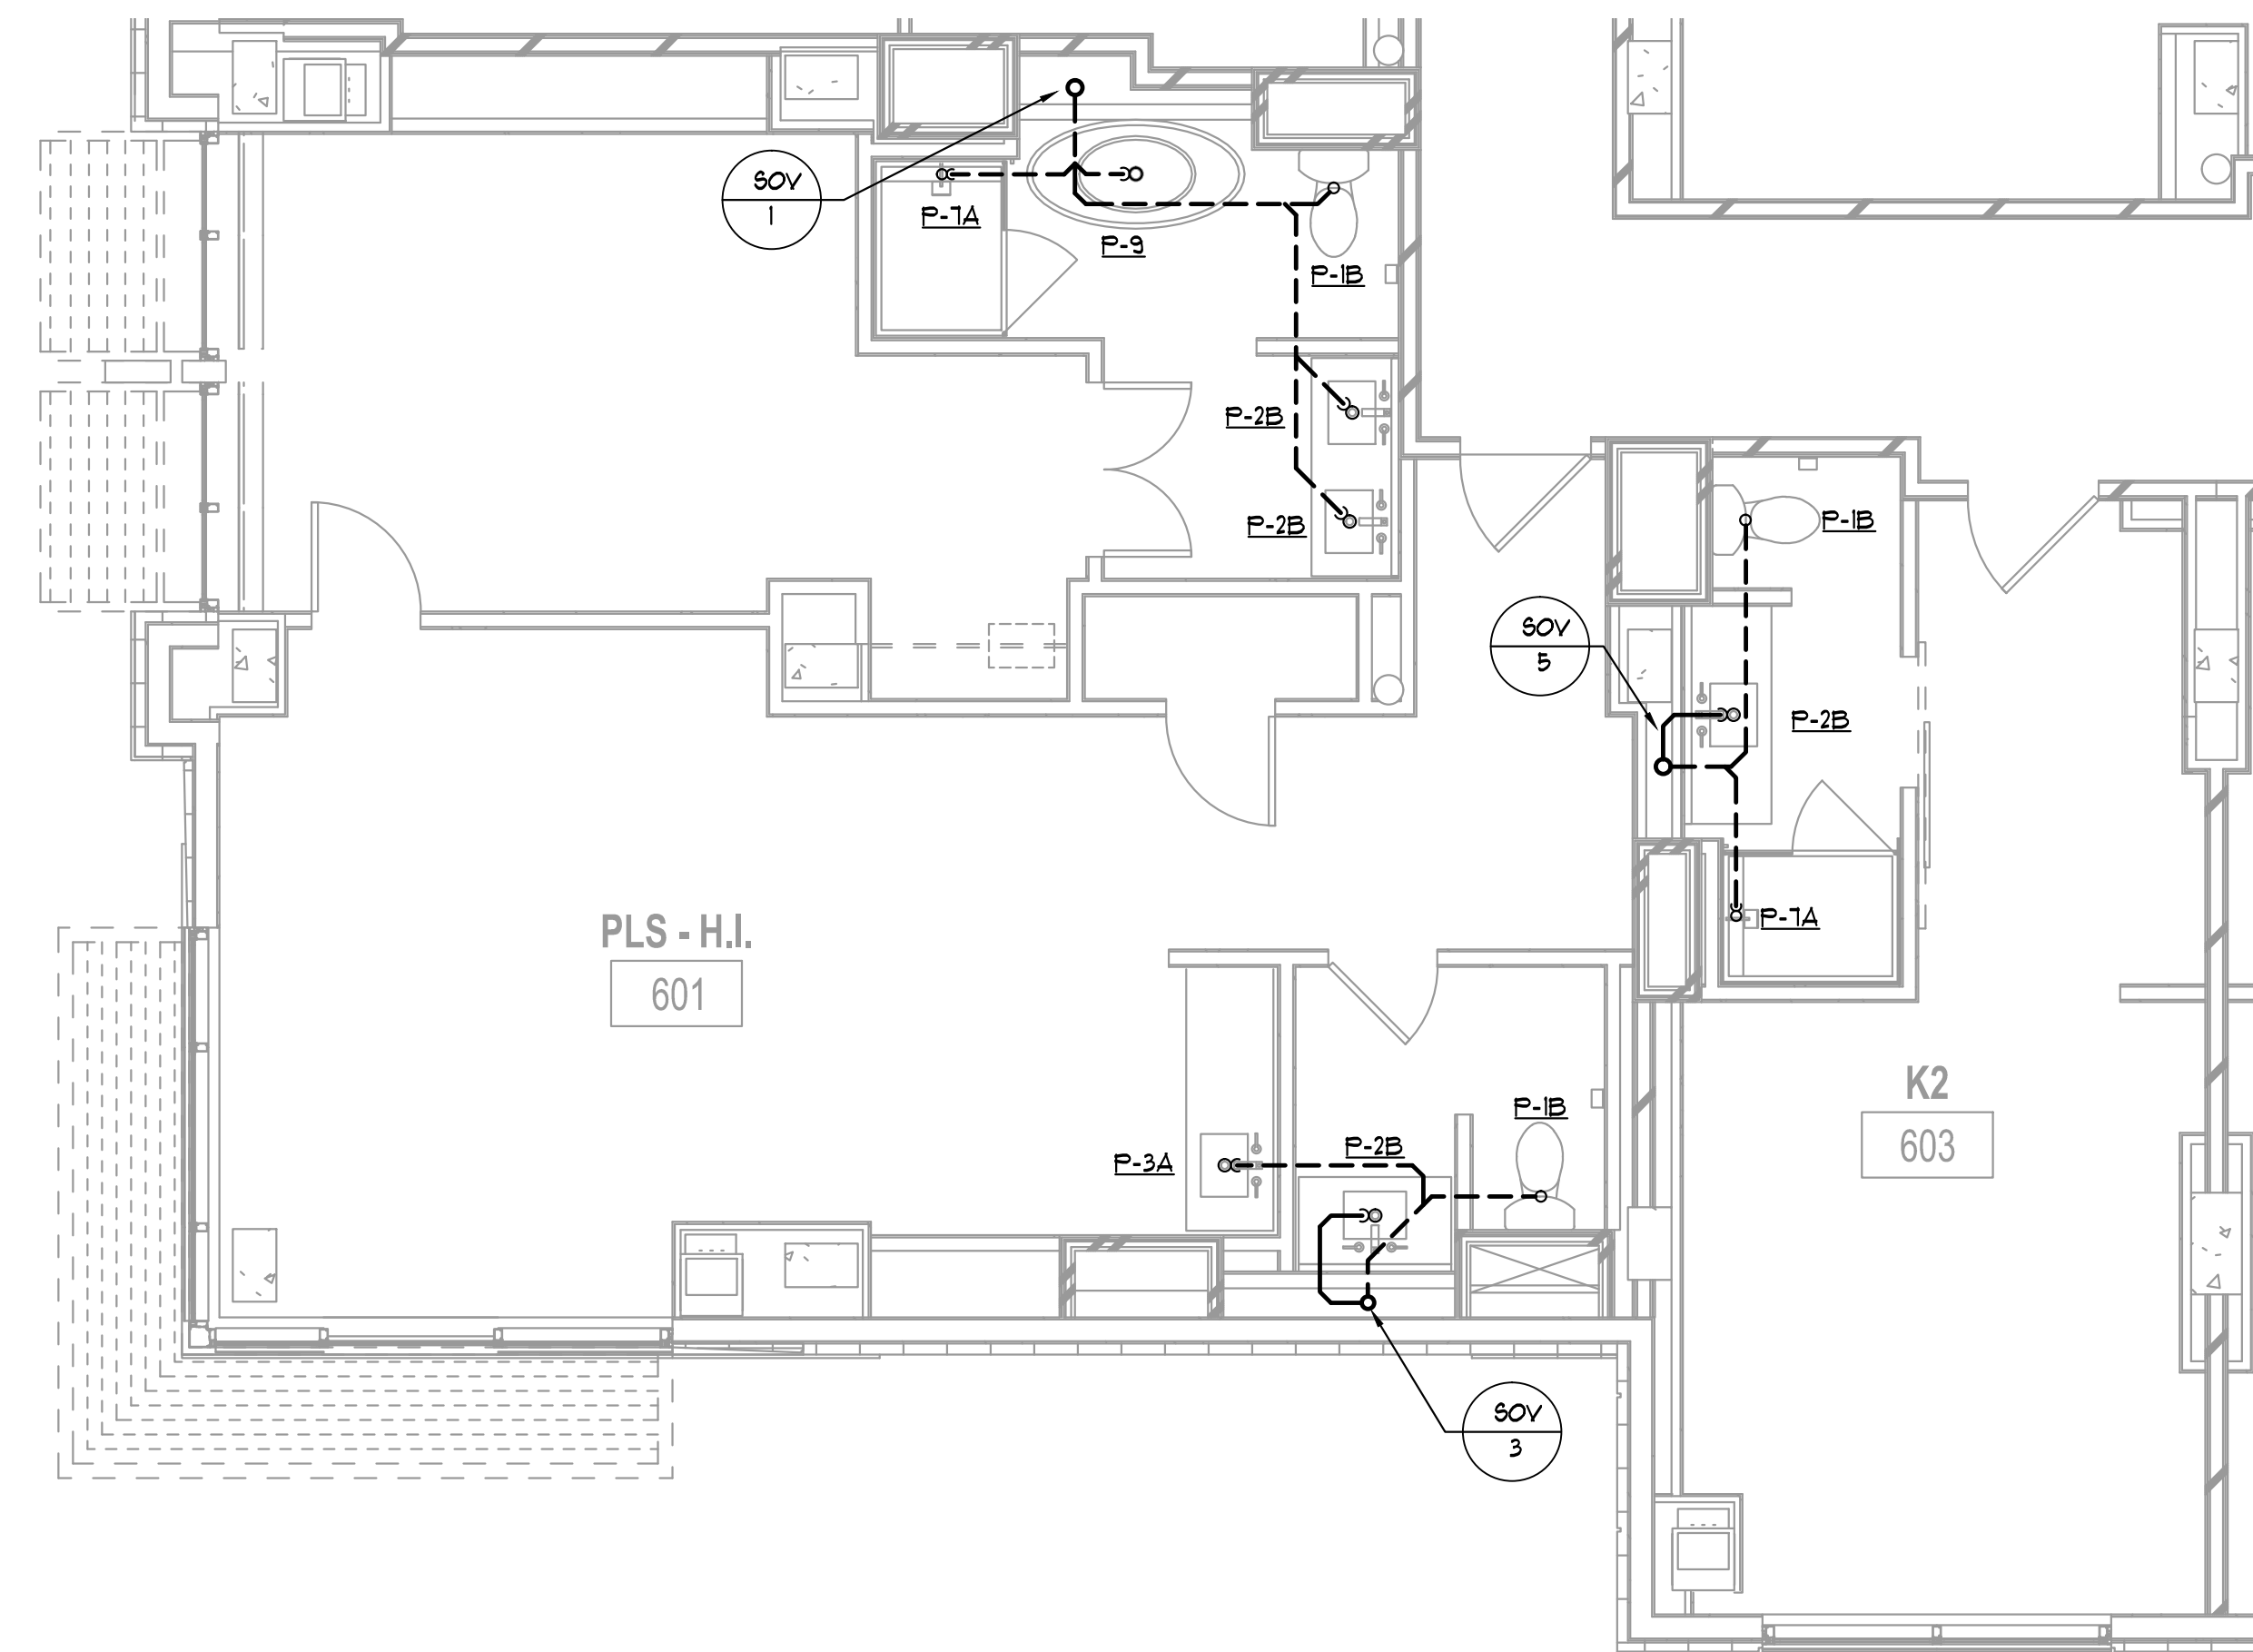

2 PLS/K2 PLAN - SANITARY & VENT
P4.03 1/4" = 1'-0"

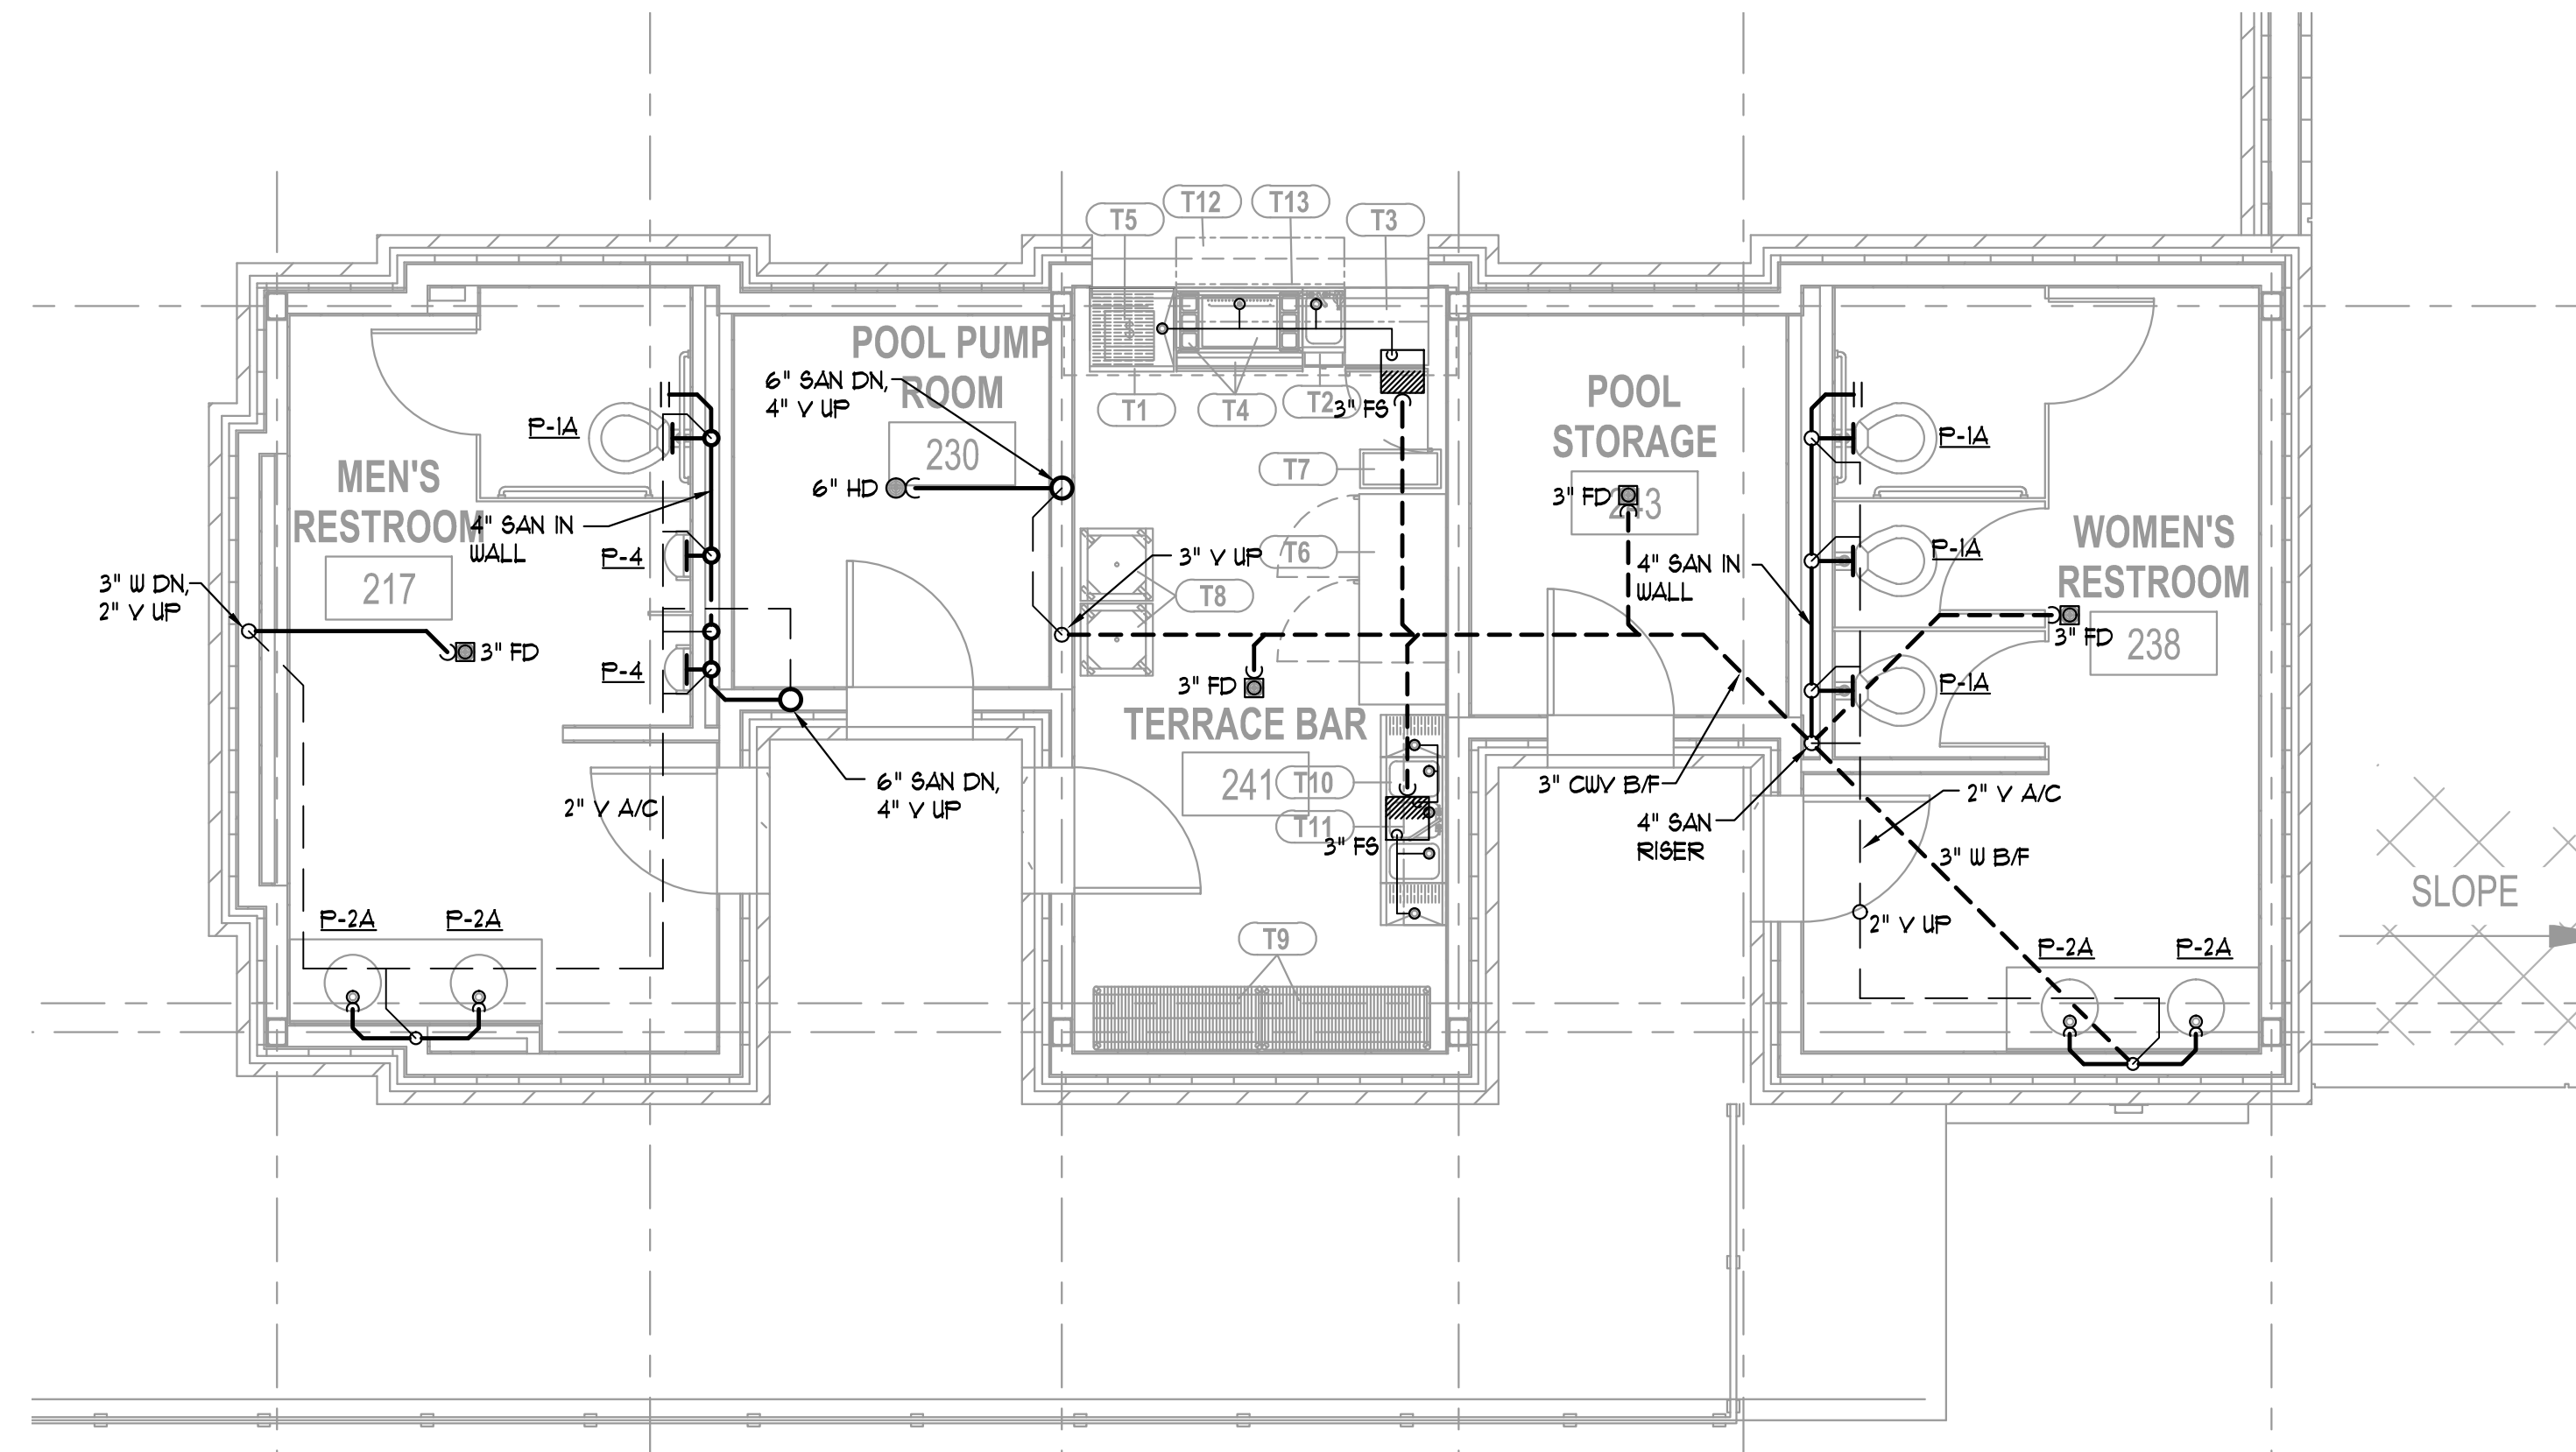

3 POOL RESTROOMS & TERRACE BAR PLAN – SANITARY & VENT
P4.03 1/4" = 1'-0"

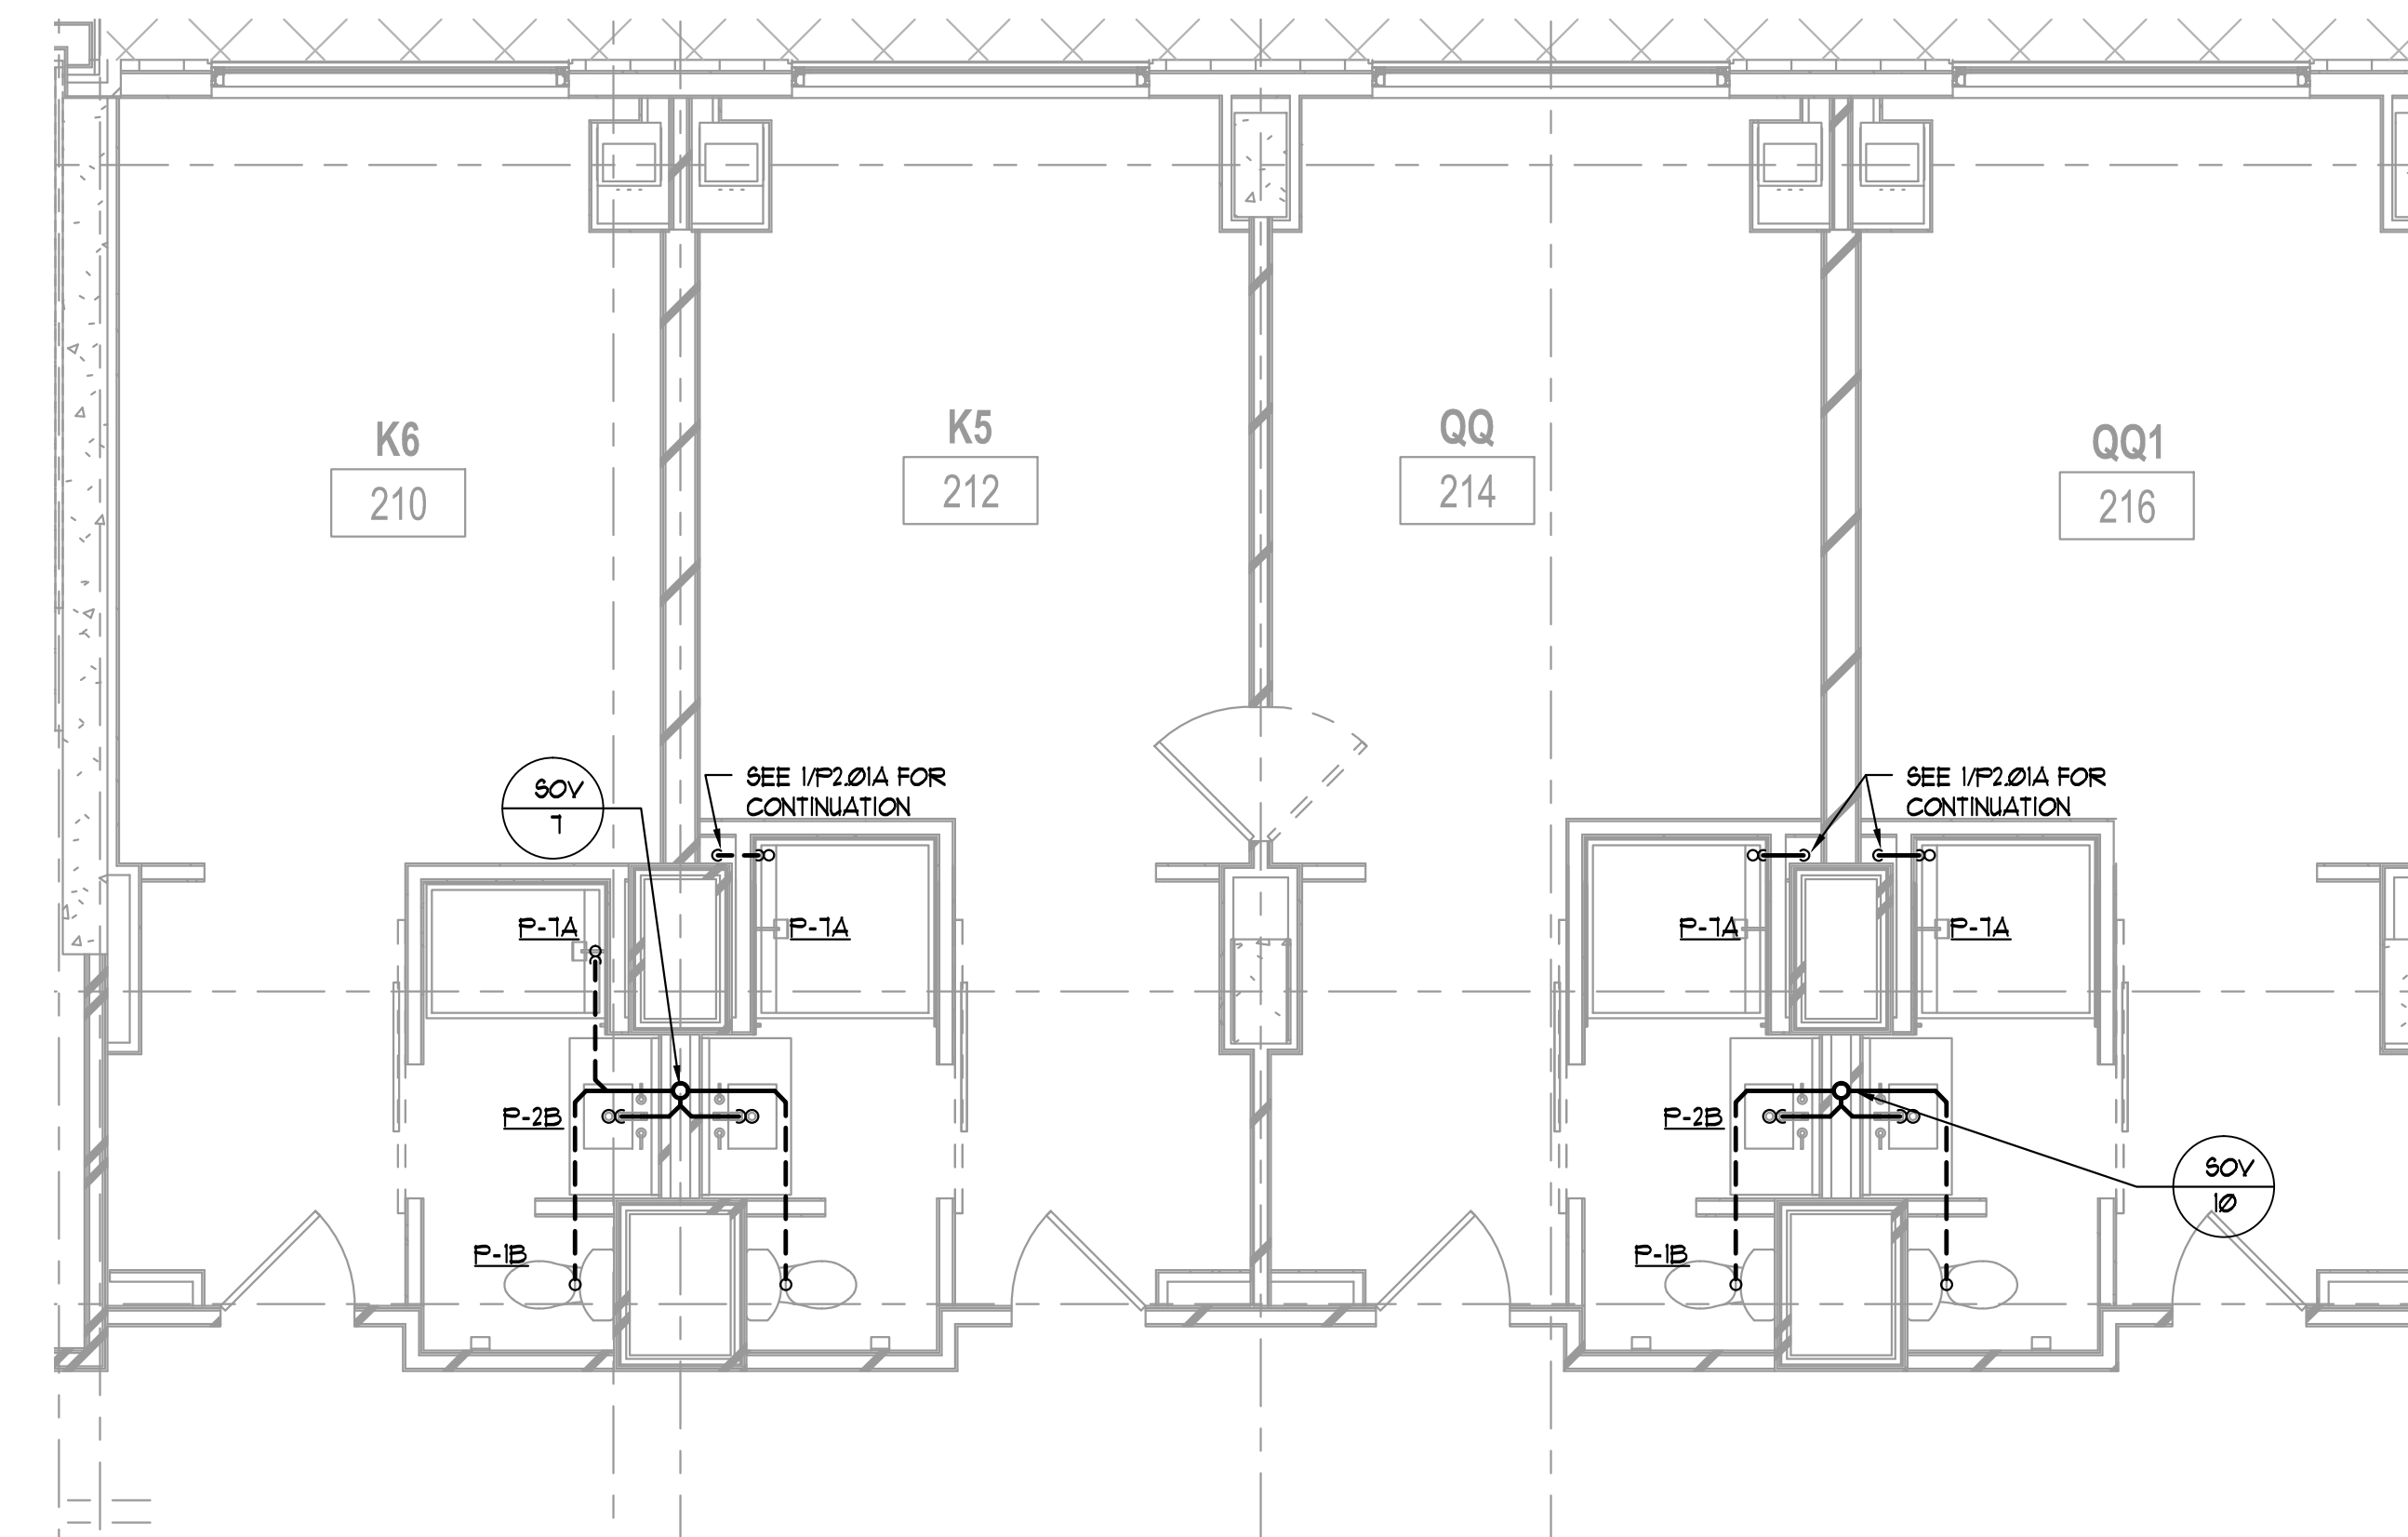

4 LEVEL 2 K5, QQ, & QQ1 PLAN – SANITARY & VENT
P4.03 1/4" = 1'-0"

ALPHARETTA CONFERENCE
CENTER & THE HOTEL AT
AVALON


9000 AVALON BOULEVARD /
ALPHARETTA, GEORGIA 30009

TORMONT HOSPITALITY GROUP, LLC
NORTH AMERICAN PROPERTY GROUP


GUESTROOM PART PLANS - SANITARY & VENT

PRICE	140028
Principal-in-Charge	BRISA Project No.
JENKINS	10/17/16
Project Engineer	Date
MERCER	


P4.03

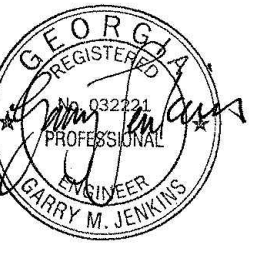


ISSUANCES		
No.	Drawing Issue Description	Date
1	BUILDING PERMIT	2016.10.17

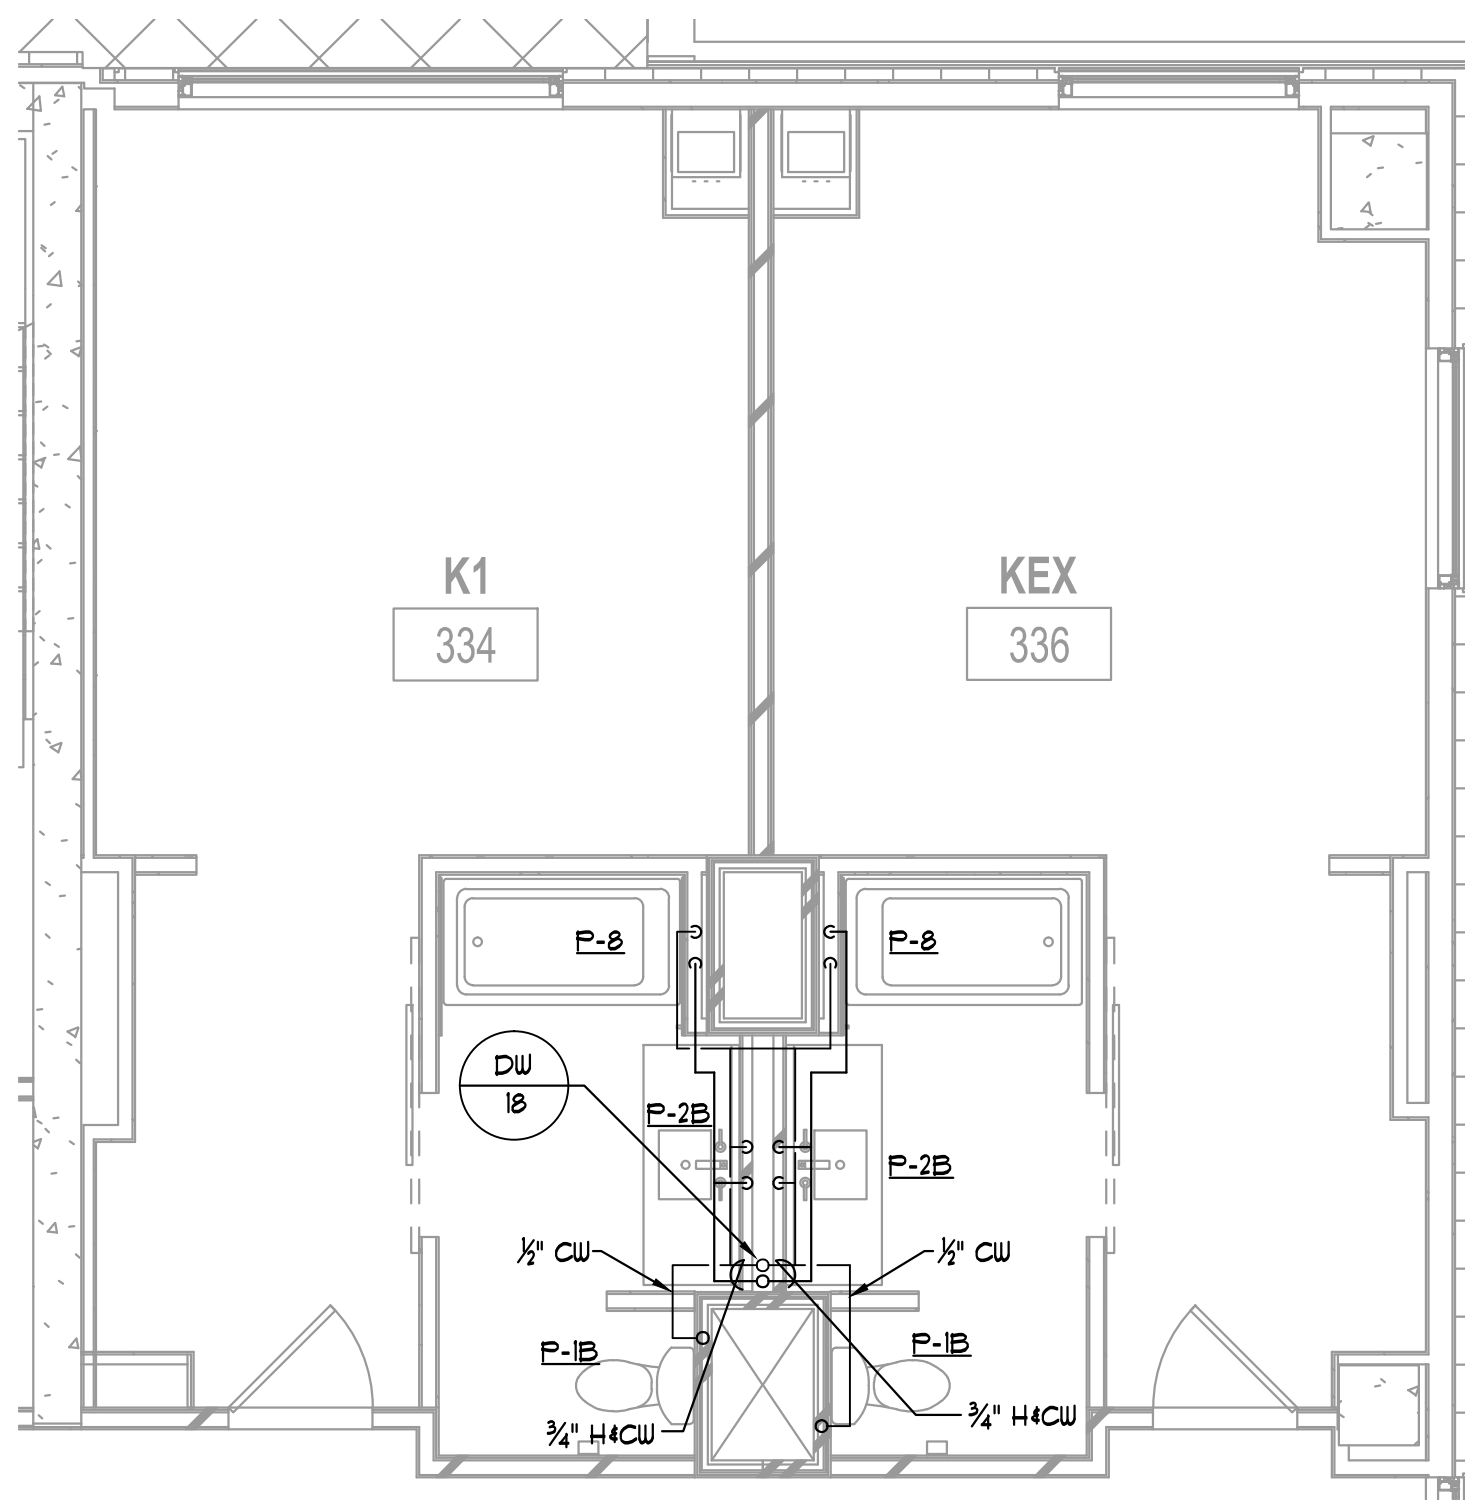


1 K1/KEX PLAN — DOMESTIC WATER
P4.04 1/4" = 1'-0"

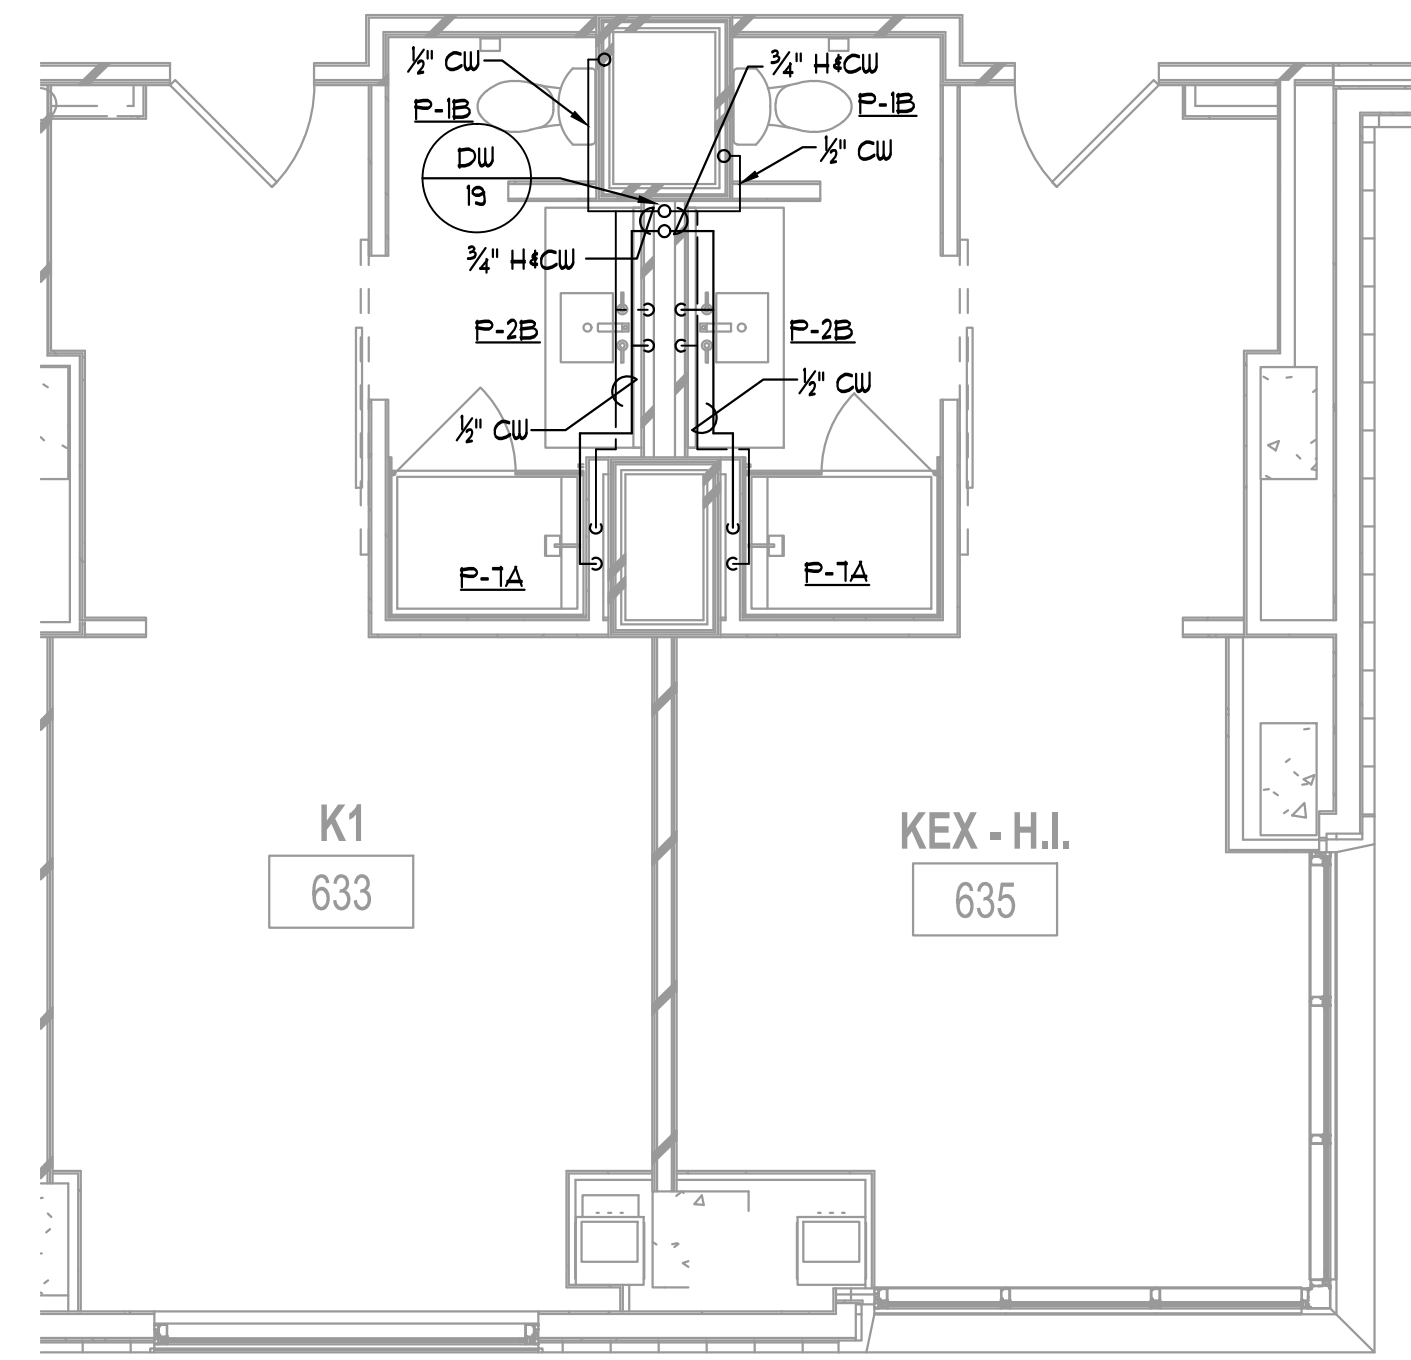


2 K1/KEX PLAN — DOMESTIC WATER
P4.04 1/4" = 1'-0"

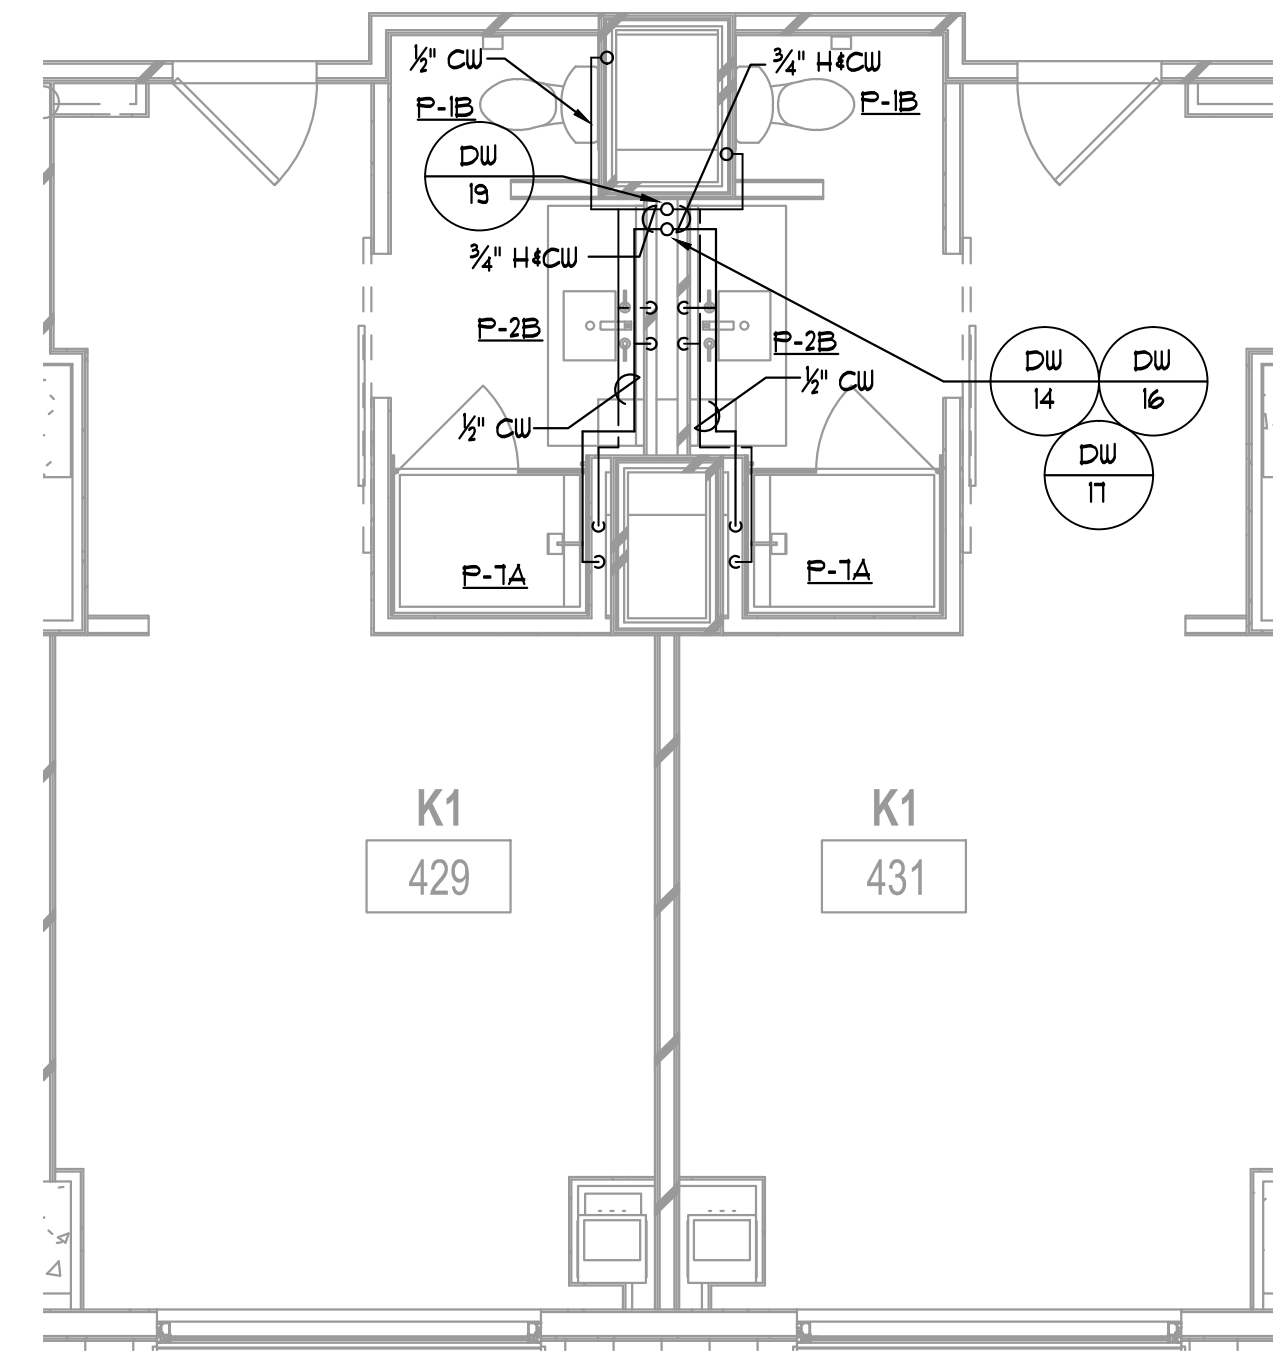


3 K1/K1 PLAN (TYP.) — DOMESTIC WATER
P4.04 1/4" = 1'-0"

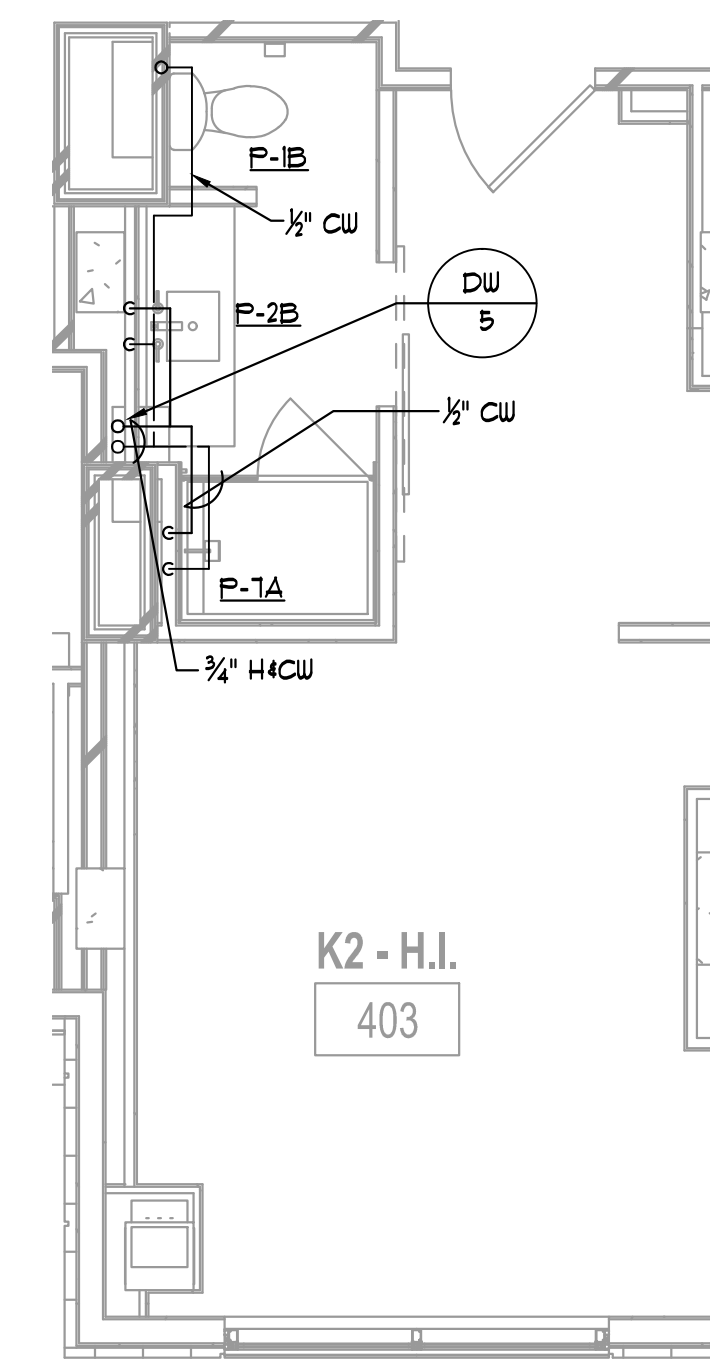


4 K2 PLAN — DOMESTIC WATER
P4.04 1/4" = 1'-0"

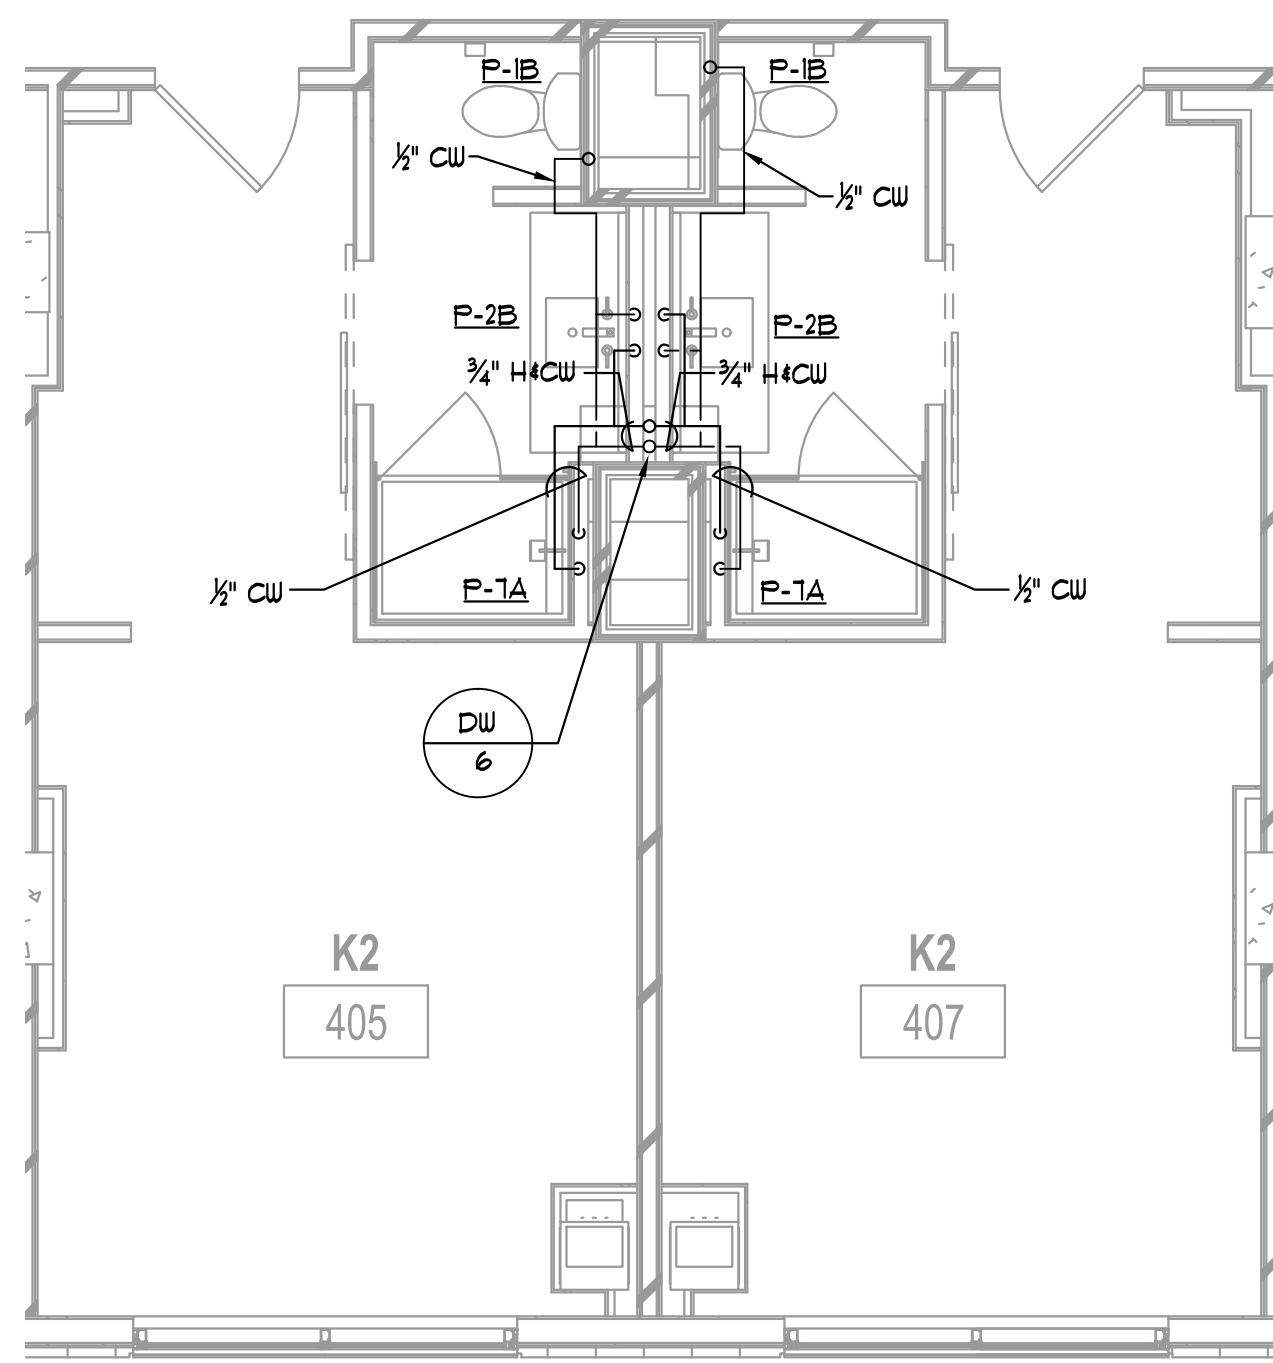


5 K2 PLAN — DOMESTIC WATER
P4.04 1/4" = 1'-0"

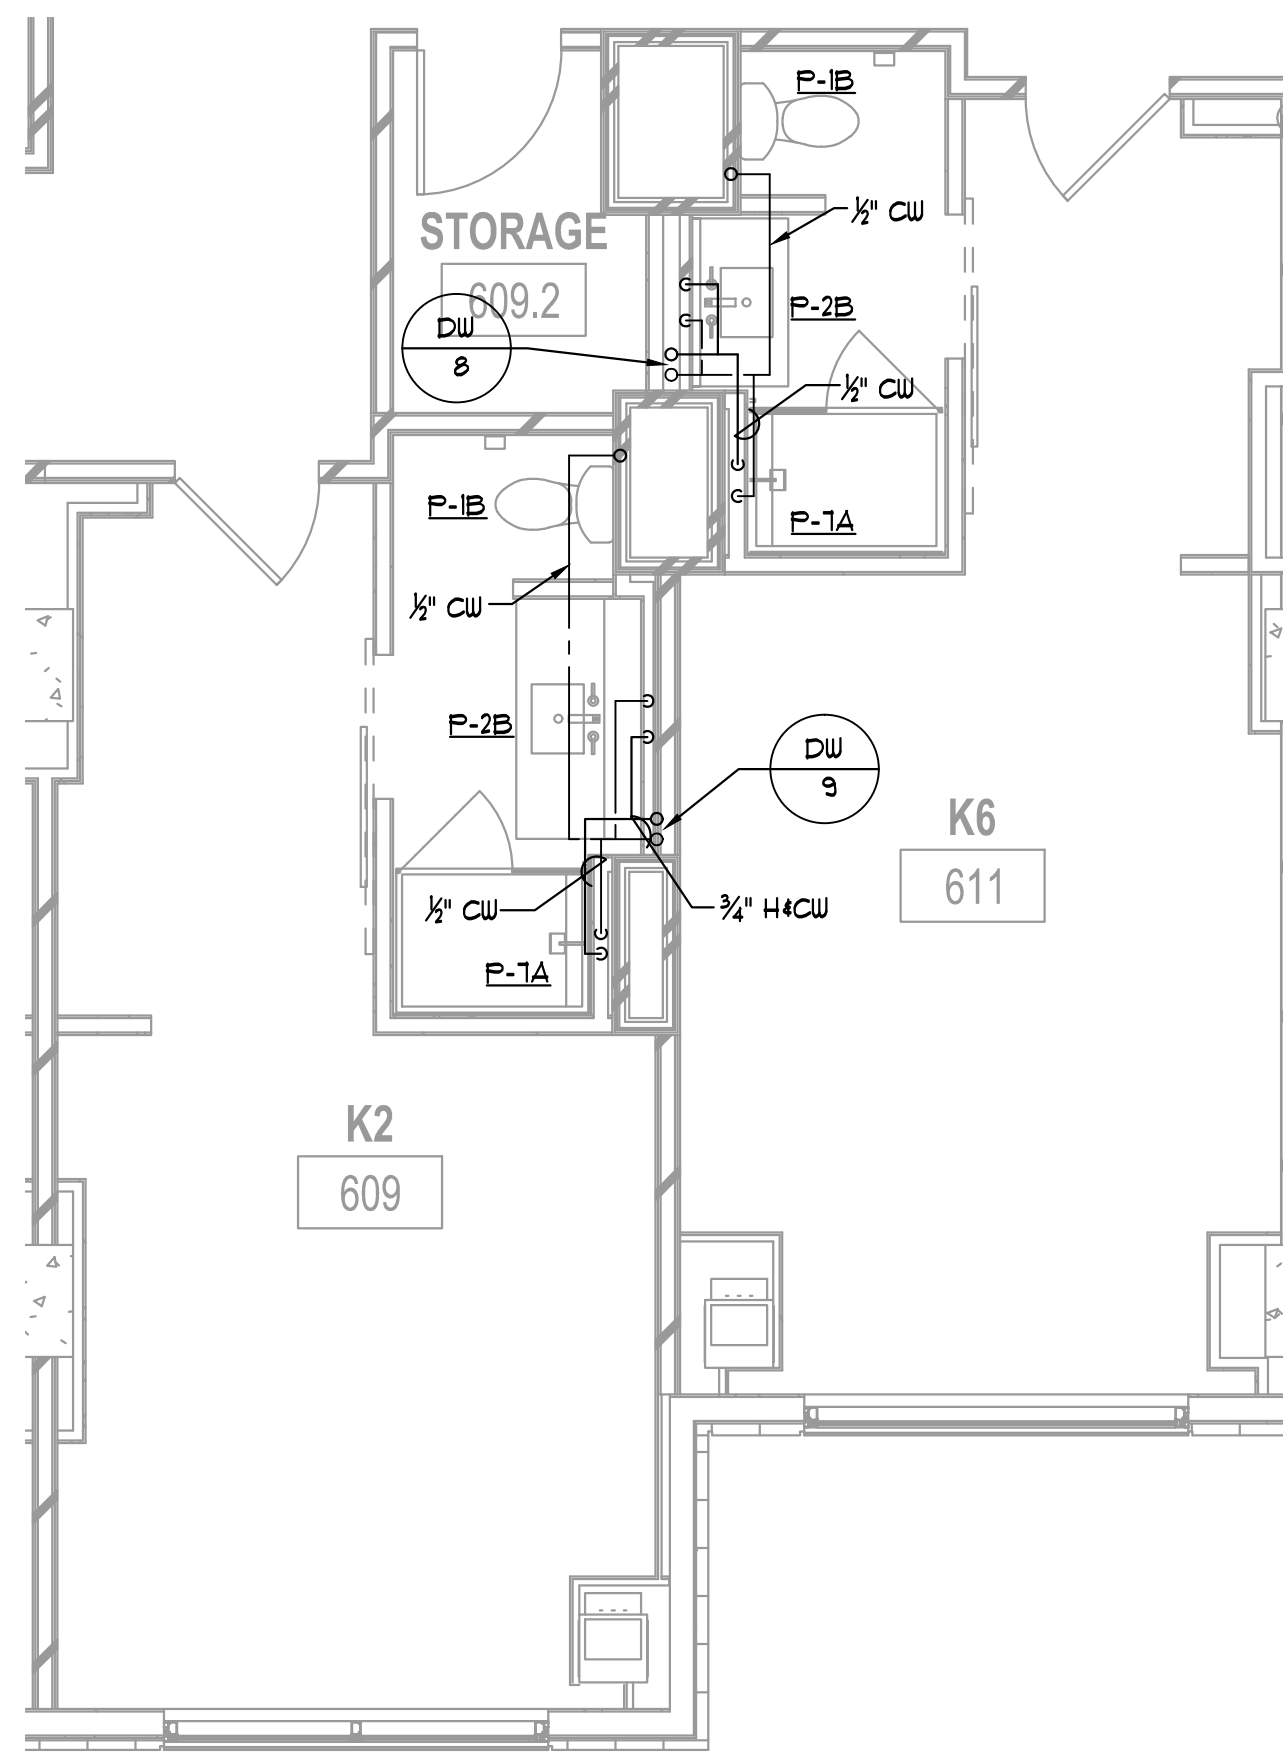


6 K2/K6 PLAN — DOMESTIC WATER
P4.04 1/4" = 1'-0"

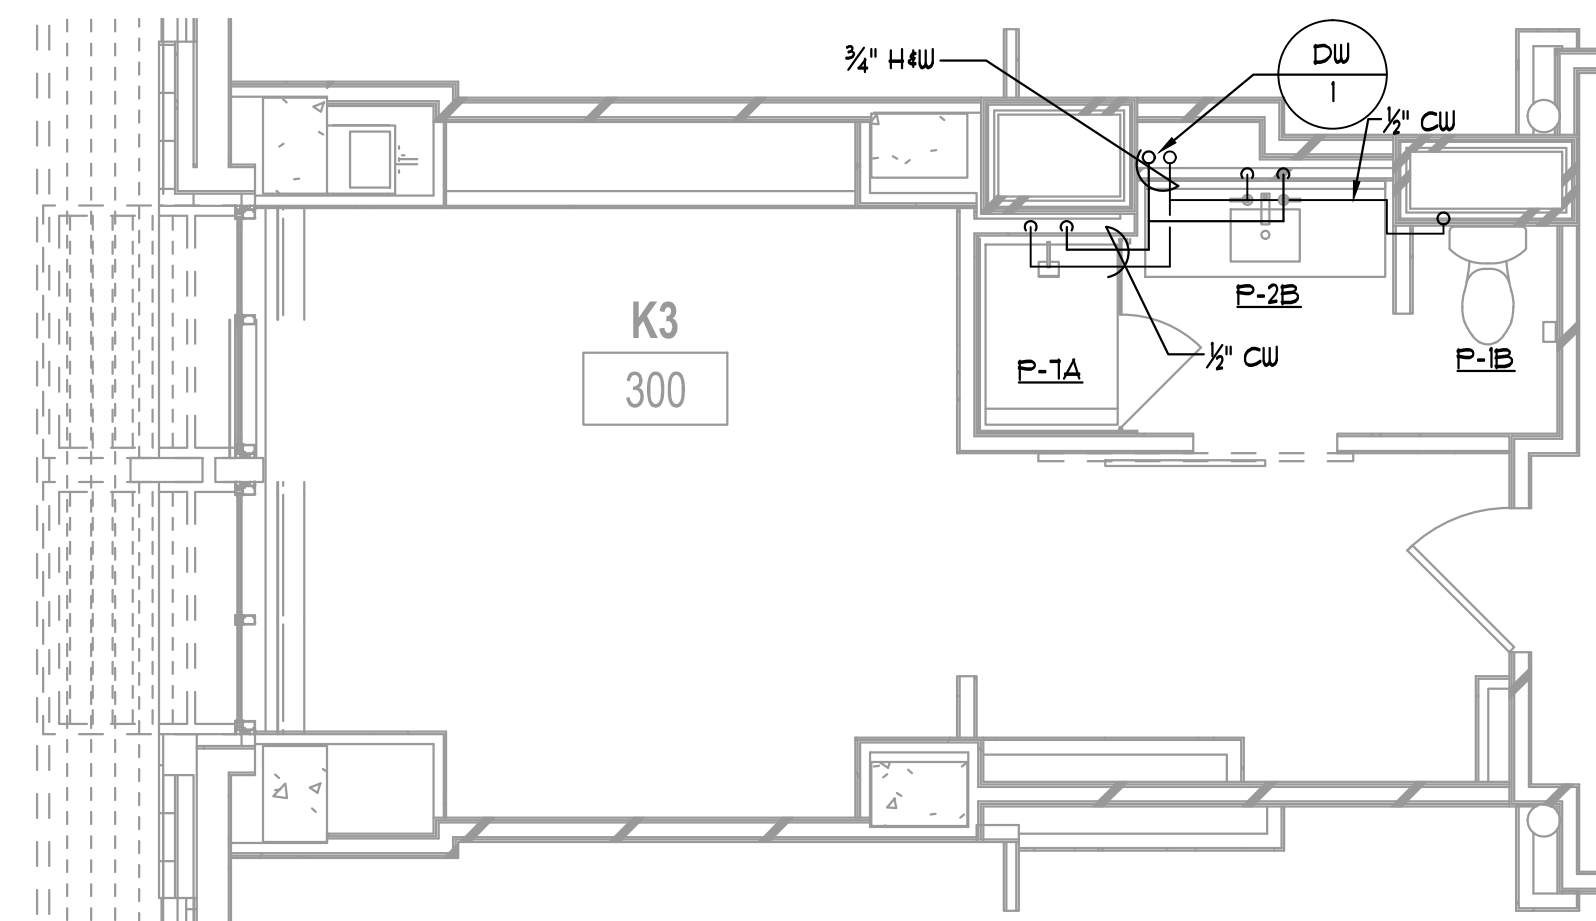


7 K3 PLAN — DOMESTIC WATER
P4.04 1/4" = 1'-0"

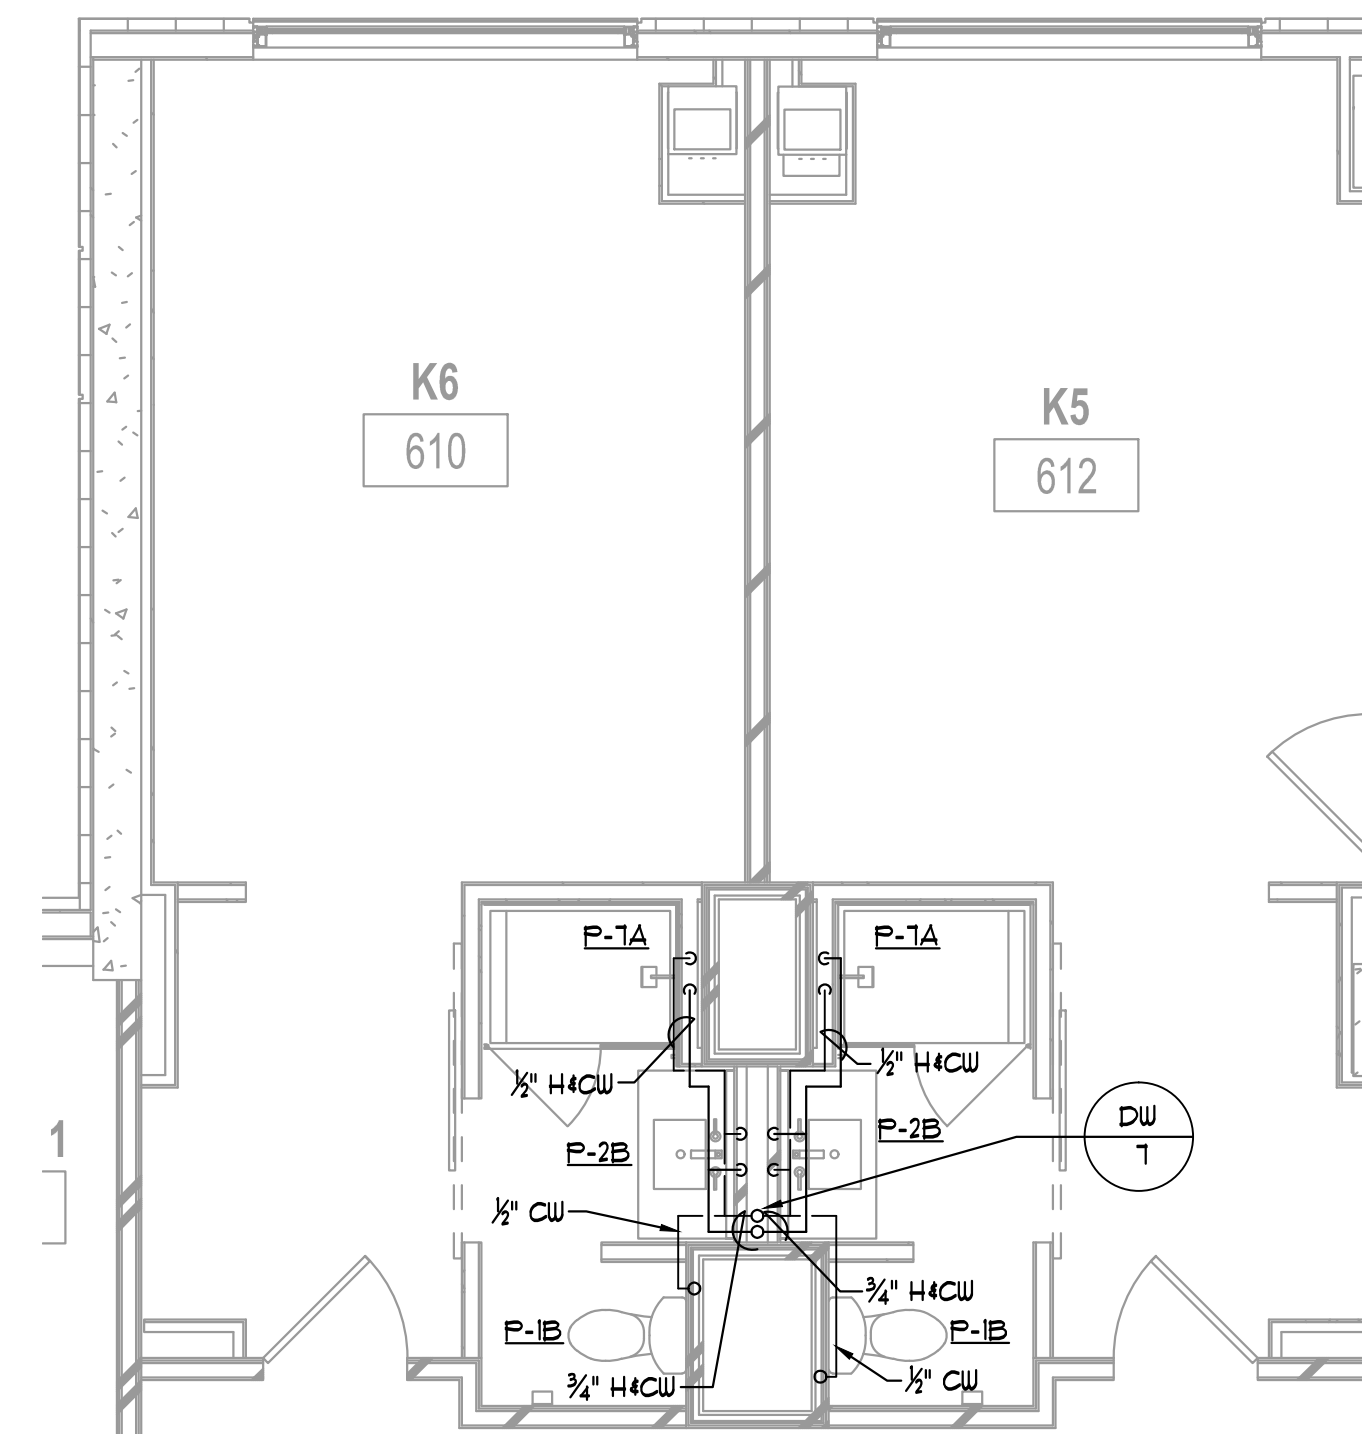


8 K5/K6 PLAN — DOMESTIC WATER
P4.04 1/4" = 1'-0"

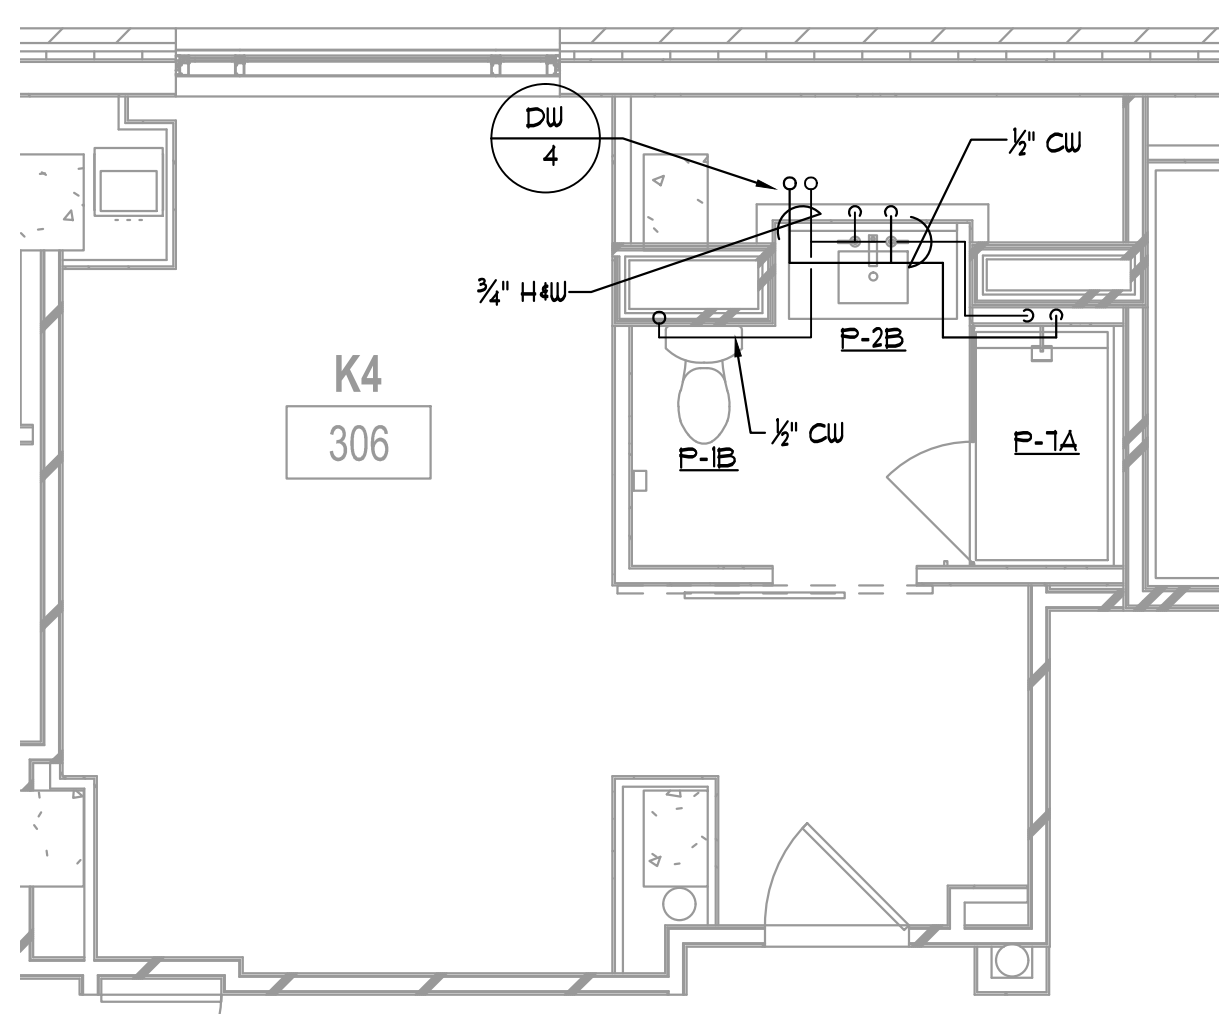

9 K4 PLAN — DOMESTIC WATER
P4.04 1/4" = 1'-0"

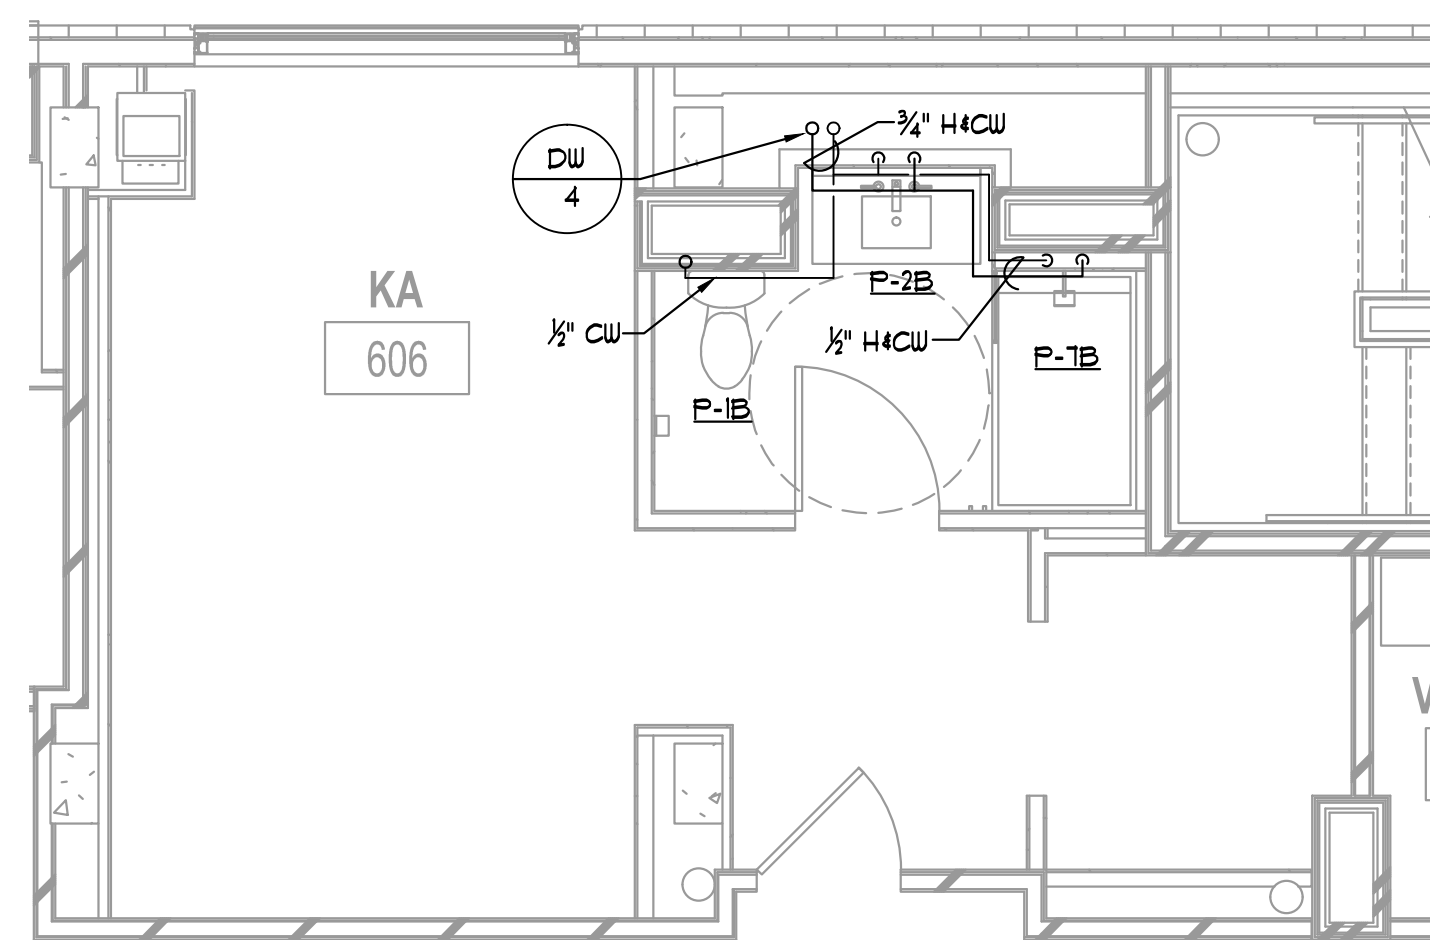

10 KA PLAN — DOMESTIC WATER
P4.04 1/4" = 1'-0"

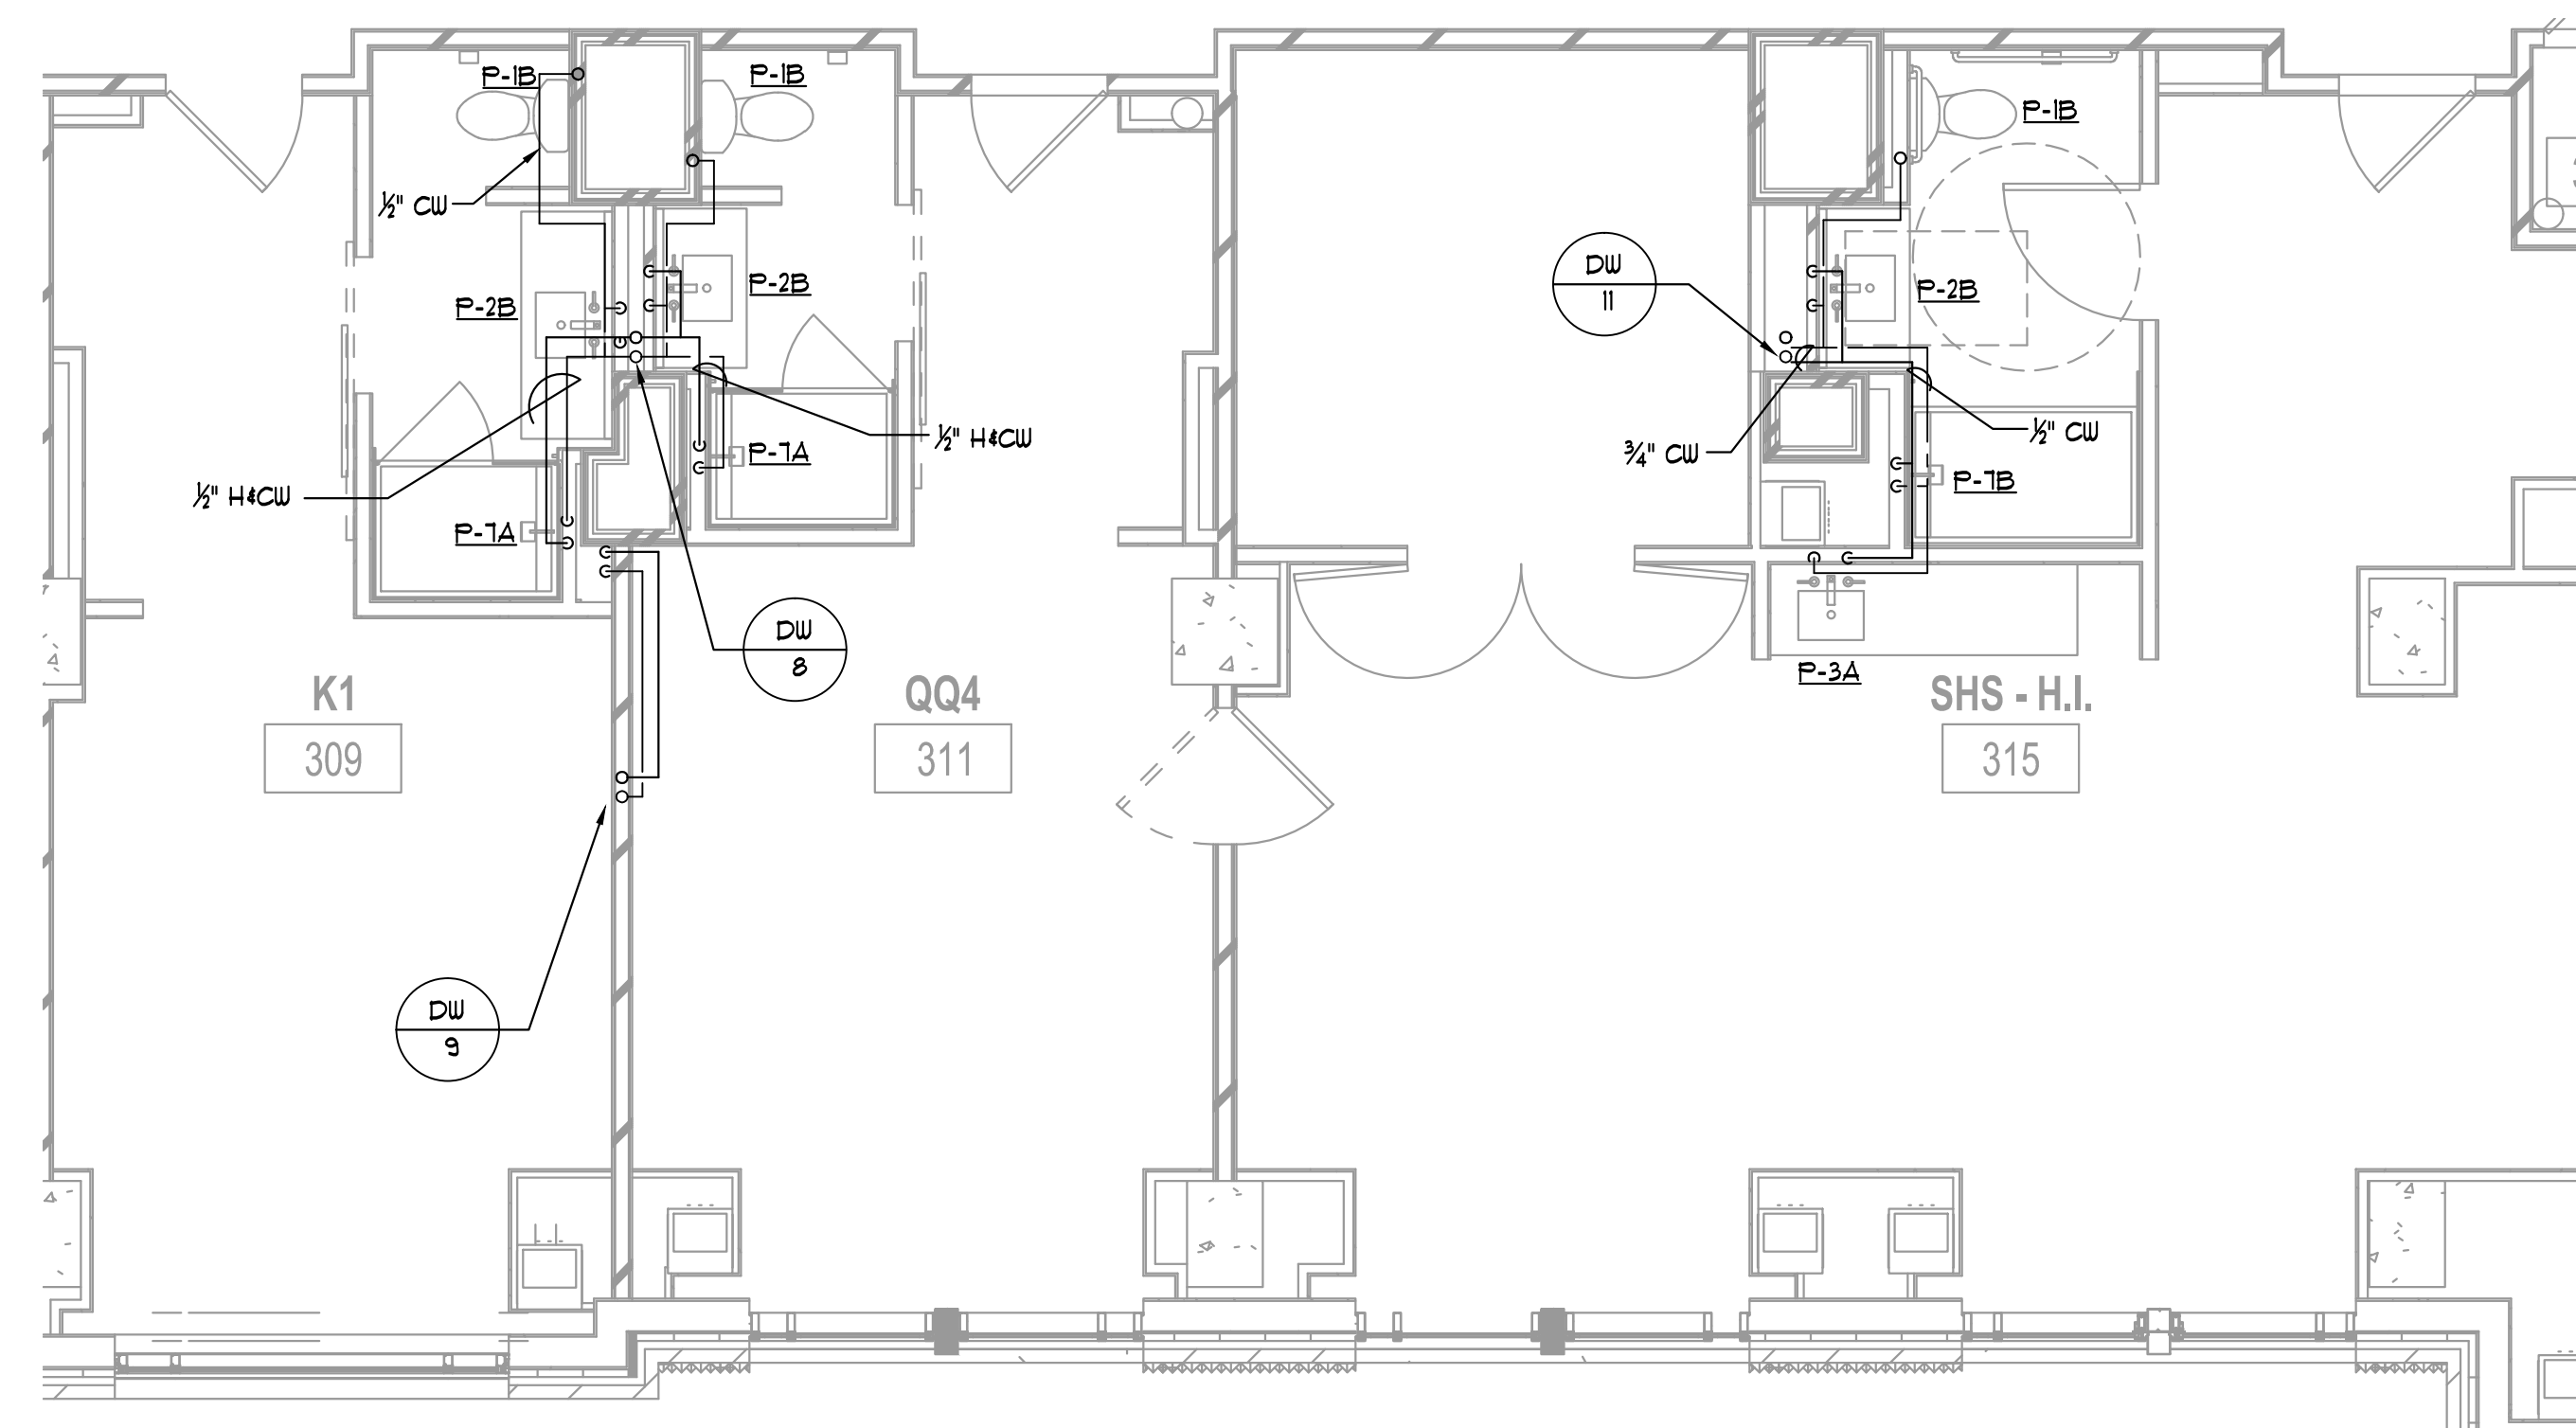

11 K1/QQ4/SHS PLAN — DOMESTIC WATER
P4.04 1/4" = 1'-0"

ALPHARETTA CONFERENCE CENTER & THE HOTEL AT AVALON


9000 AVALON BOULEVARD /
ALPHARETTA, GEORGIA 30009

STORMONT HOSPITALITY GROUP, LLC /
NORTH AMERICAN PROPERTY GROUP


GUESTROOM PART PLANS - DOMESTIC WATER

K. PRICE	140028
Principal in Charge	BW&A Project No.
G. JENKINS	101716
Project Engineer	Date
T. MERCER	
Checker	


P4.04

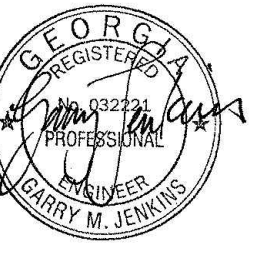


ISSUANCES		
No.	Drawing Issue Description	Date
1	BUILDING PERMIT	2016.10.17

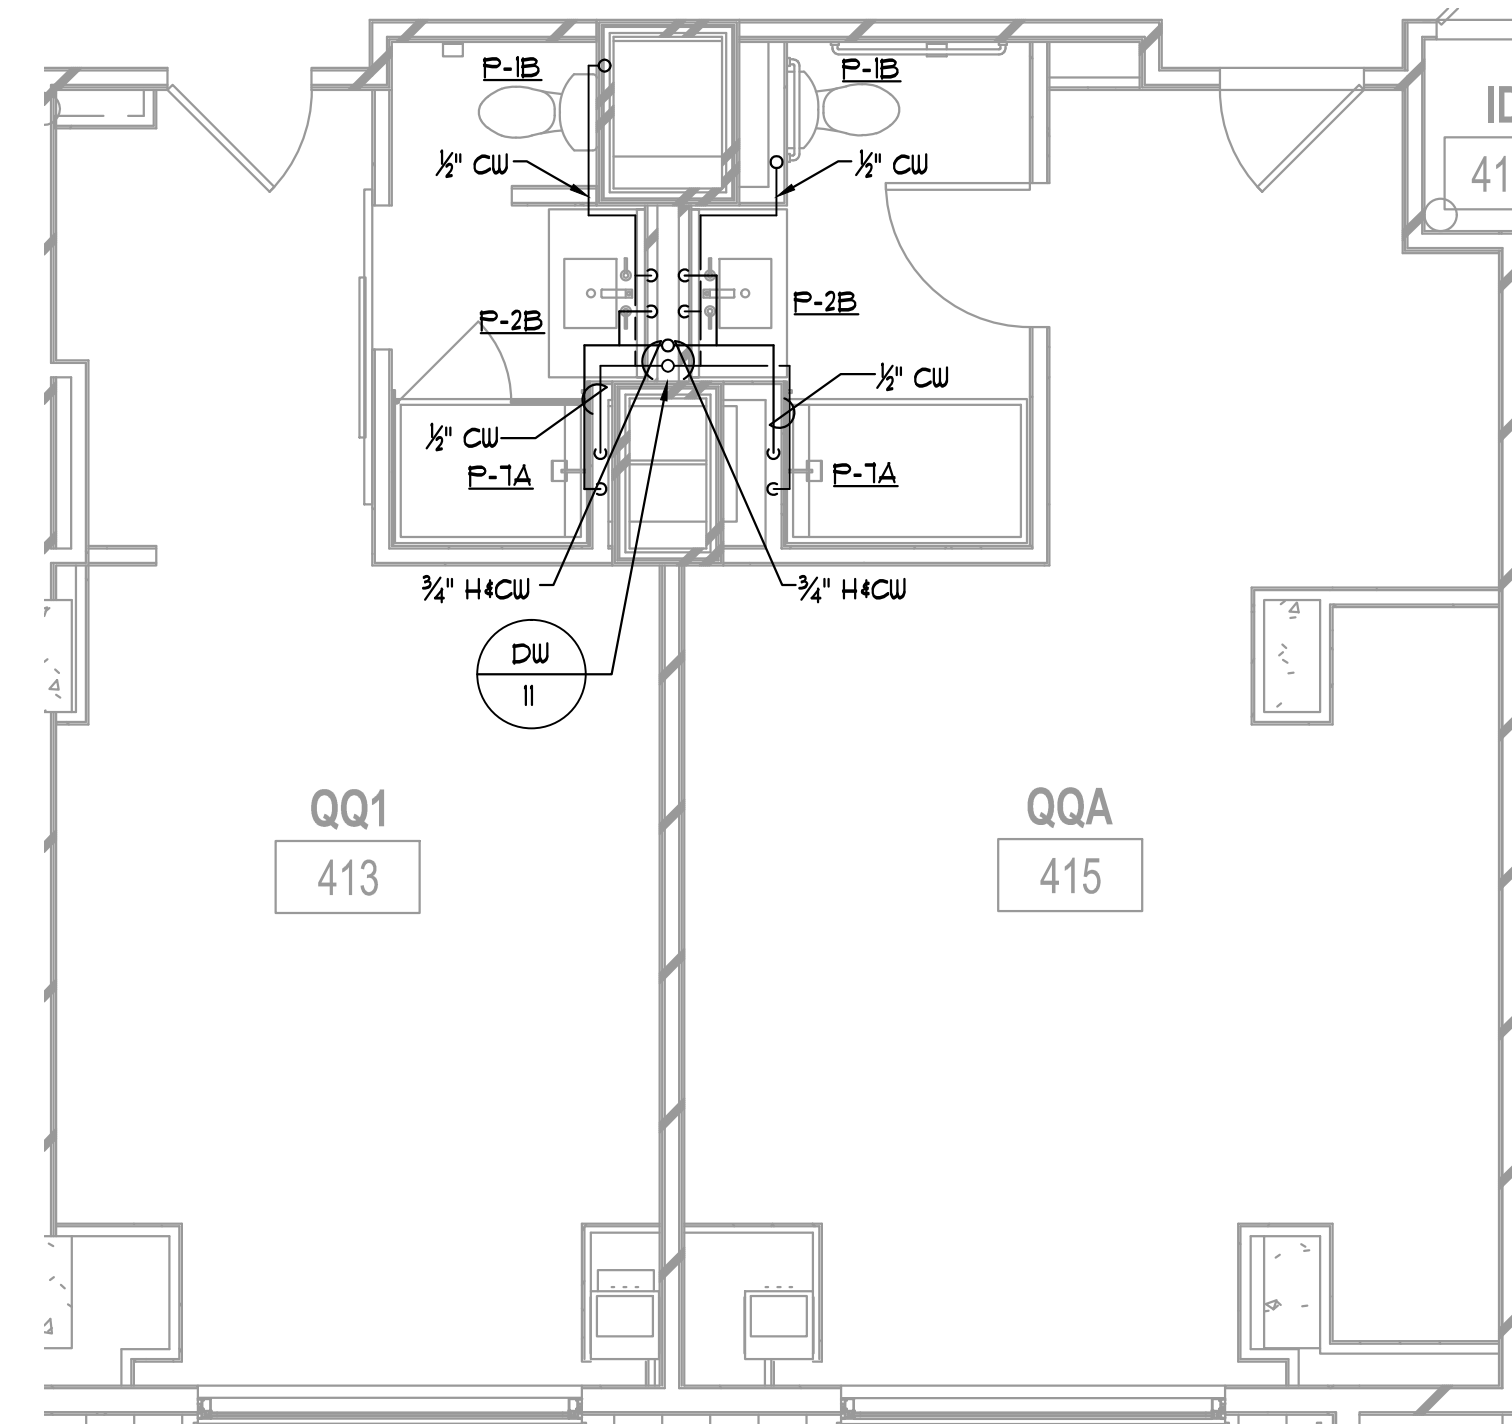


1 QQ1/QQA PLAN — DOMESTIC WATER
P4.05 1/4" = 1'-0"

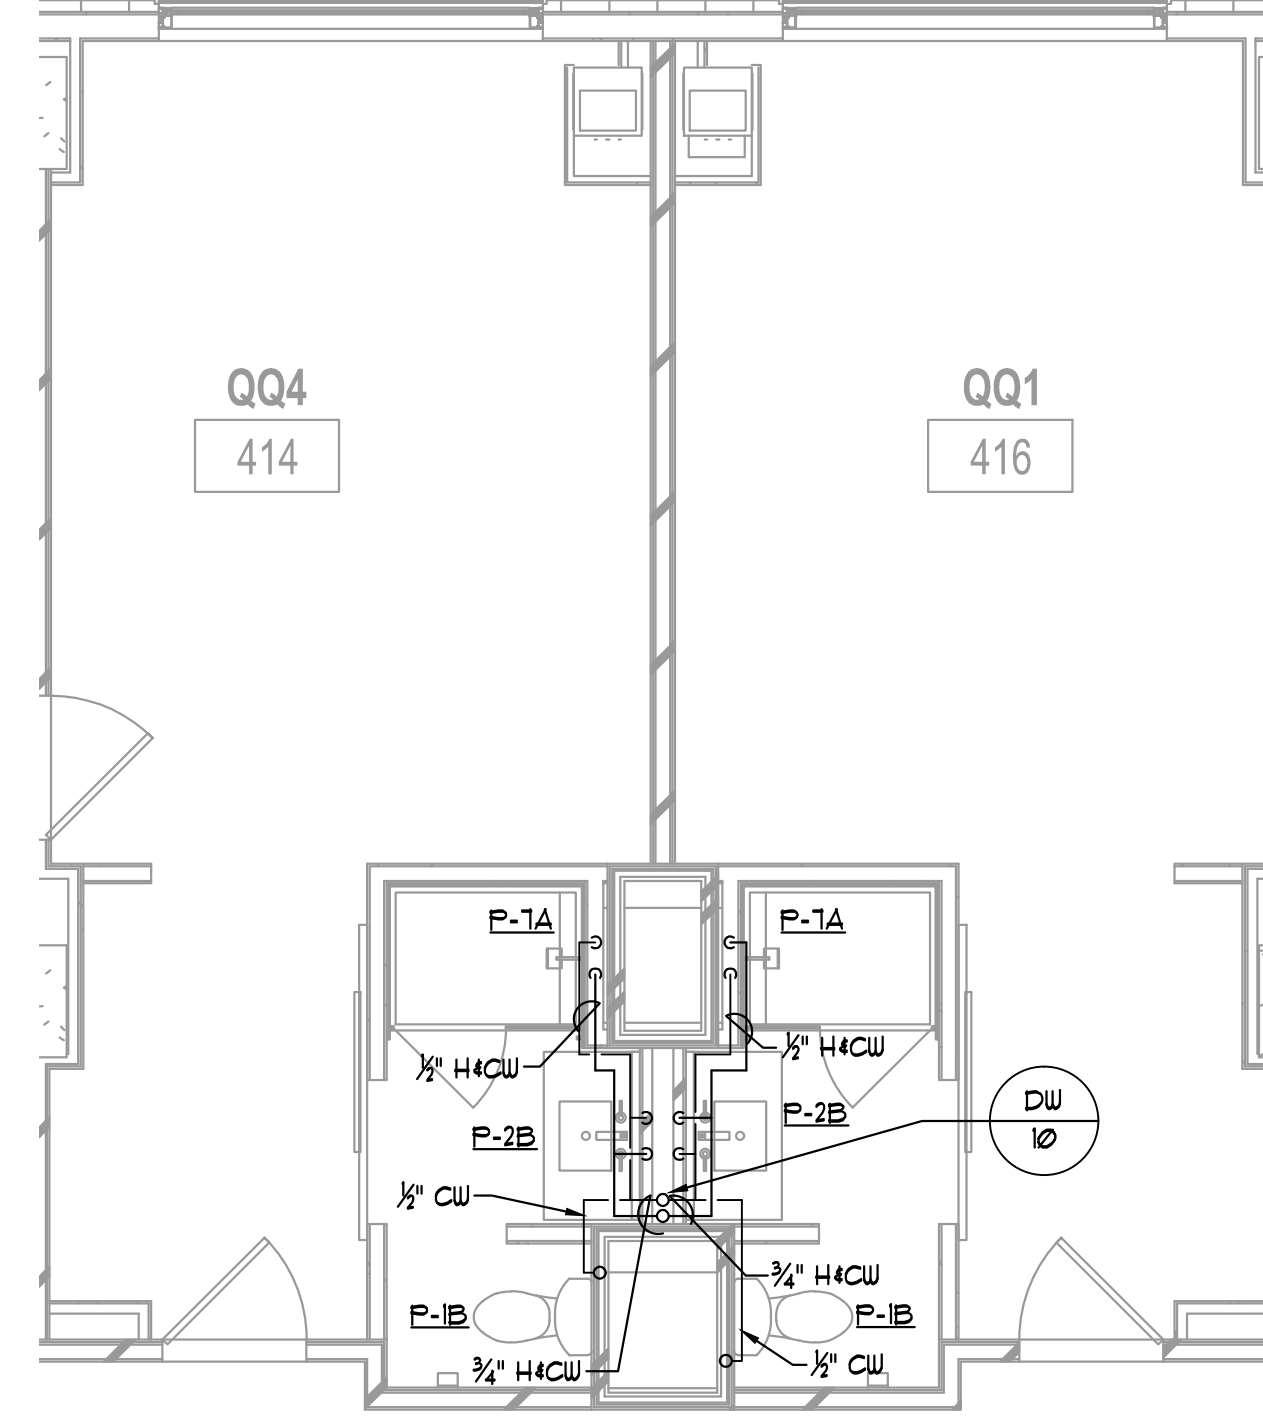


2 QQ4/QQ1 PLAN — DOMESTIC WATER
P4.05 1/4" = 1'-0"

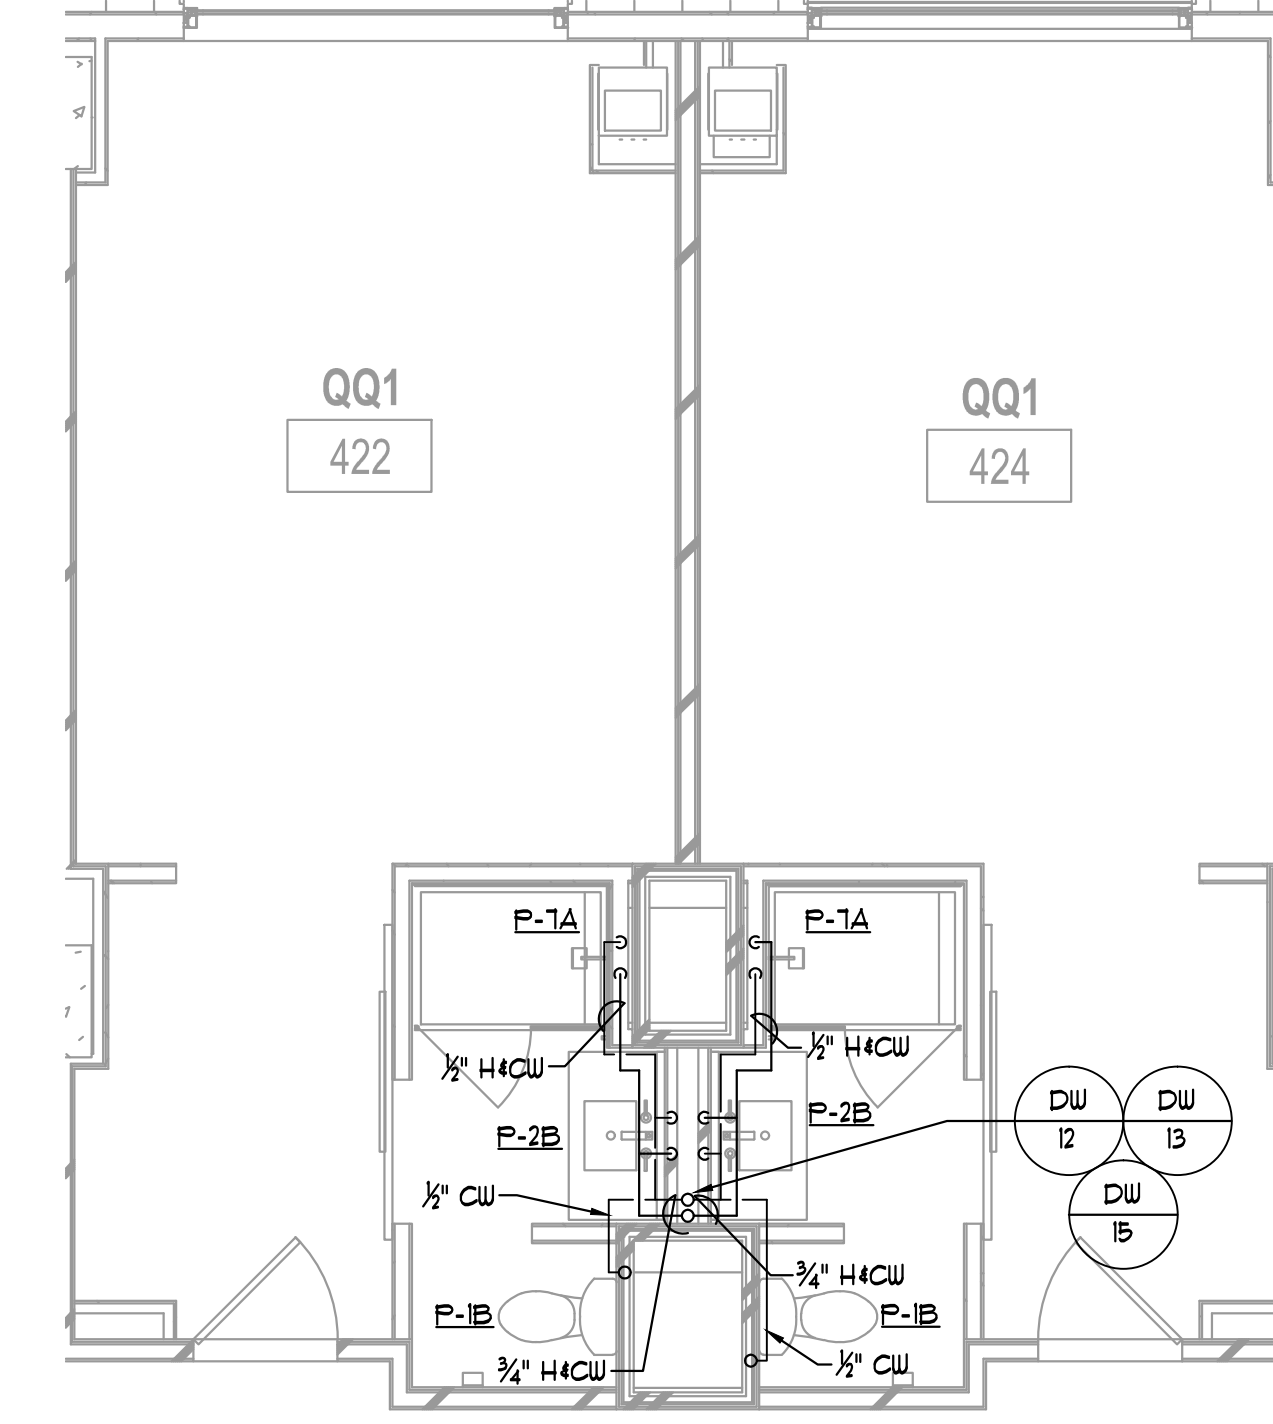


3 QQ1/QQ1 PLAN (TYP.)— DOMESTIC WATER
P4.05 1/4" = 1'-0"

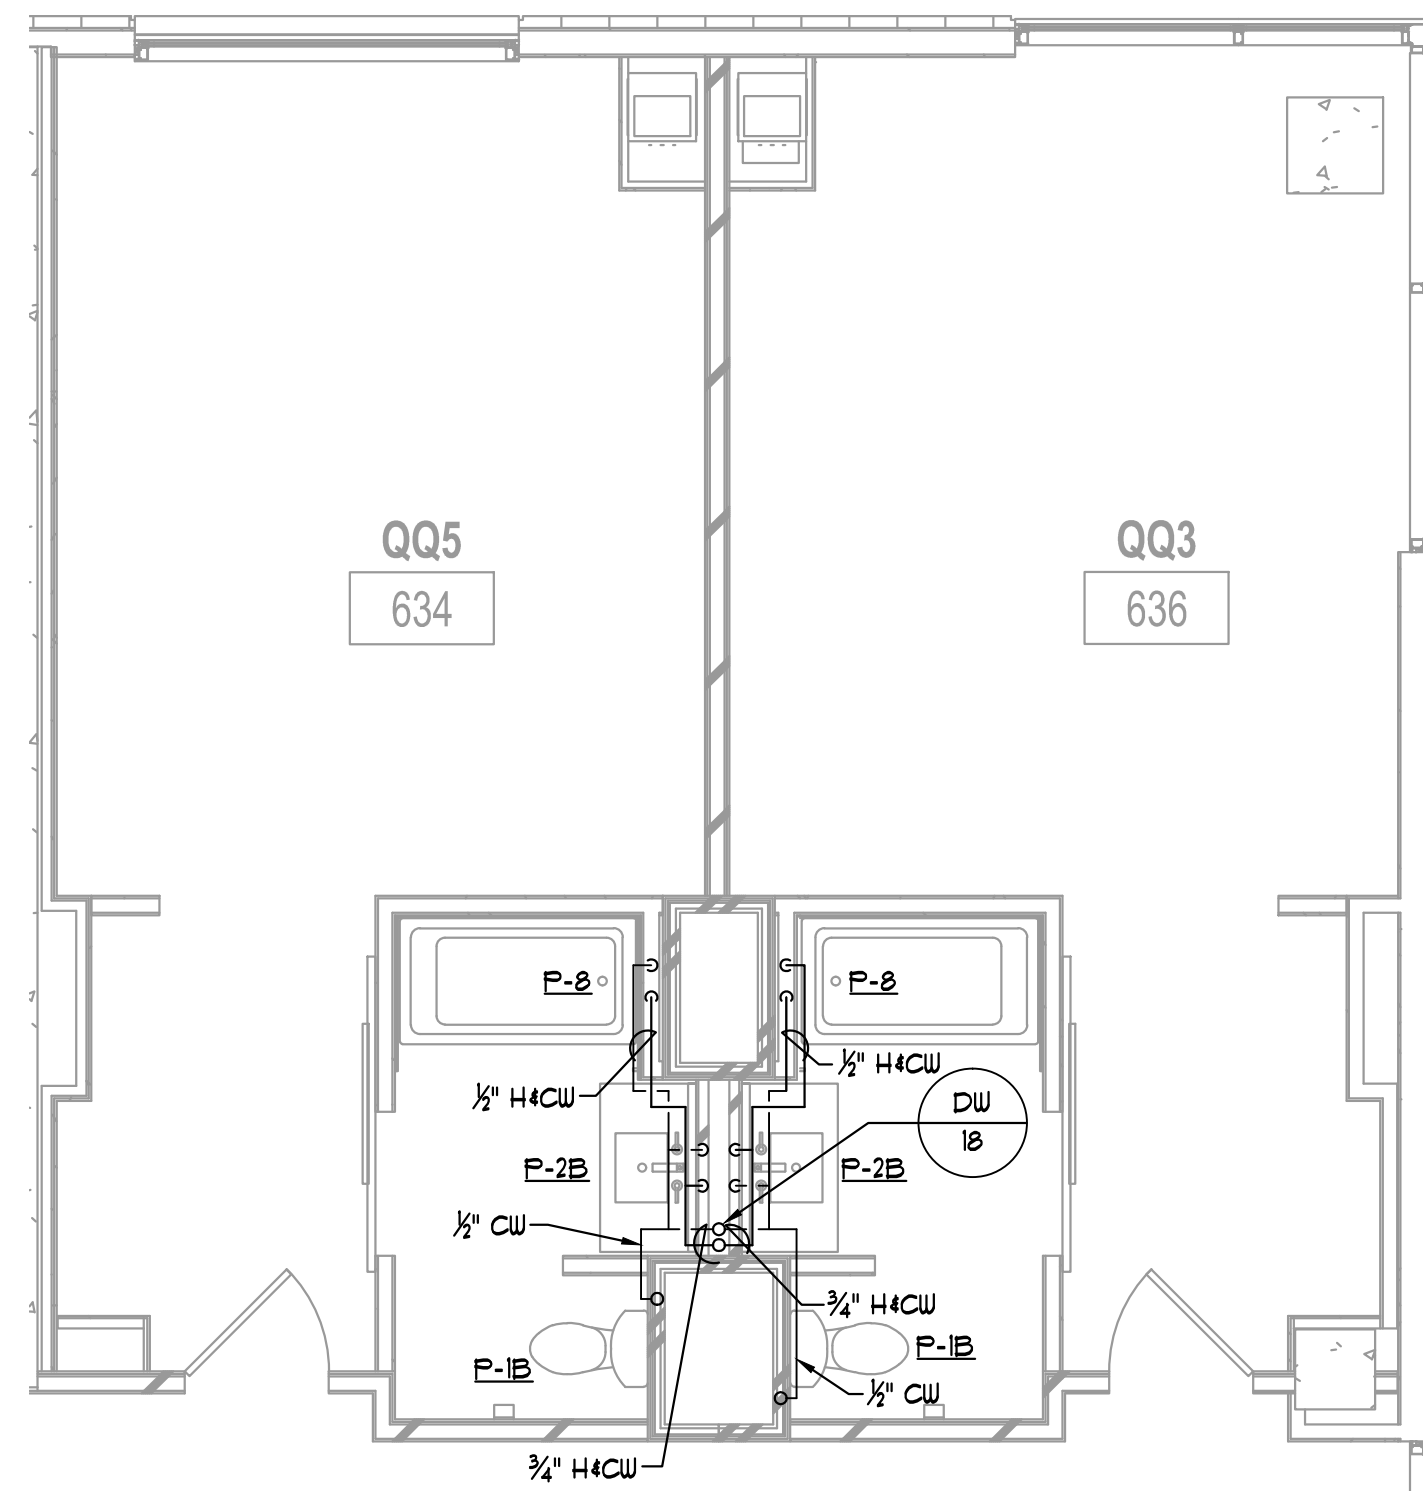


4 QQ3/QQ5 PLAN — DOMESTIC WATER
P4.05 1/4" = 1'-0"

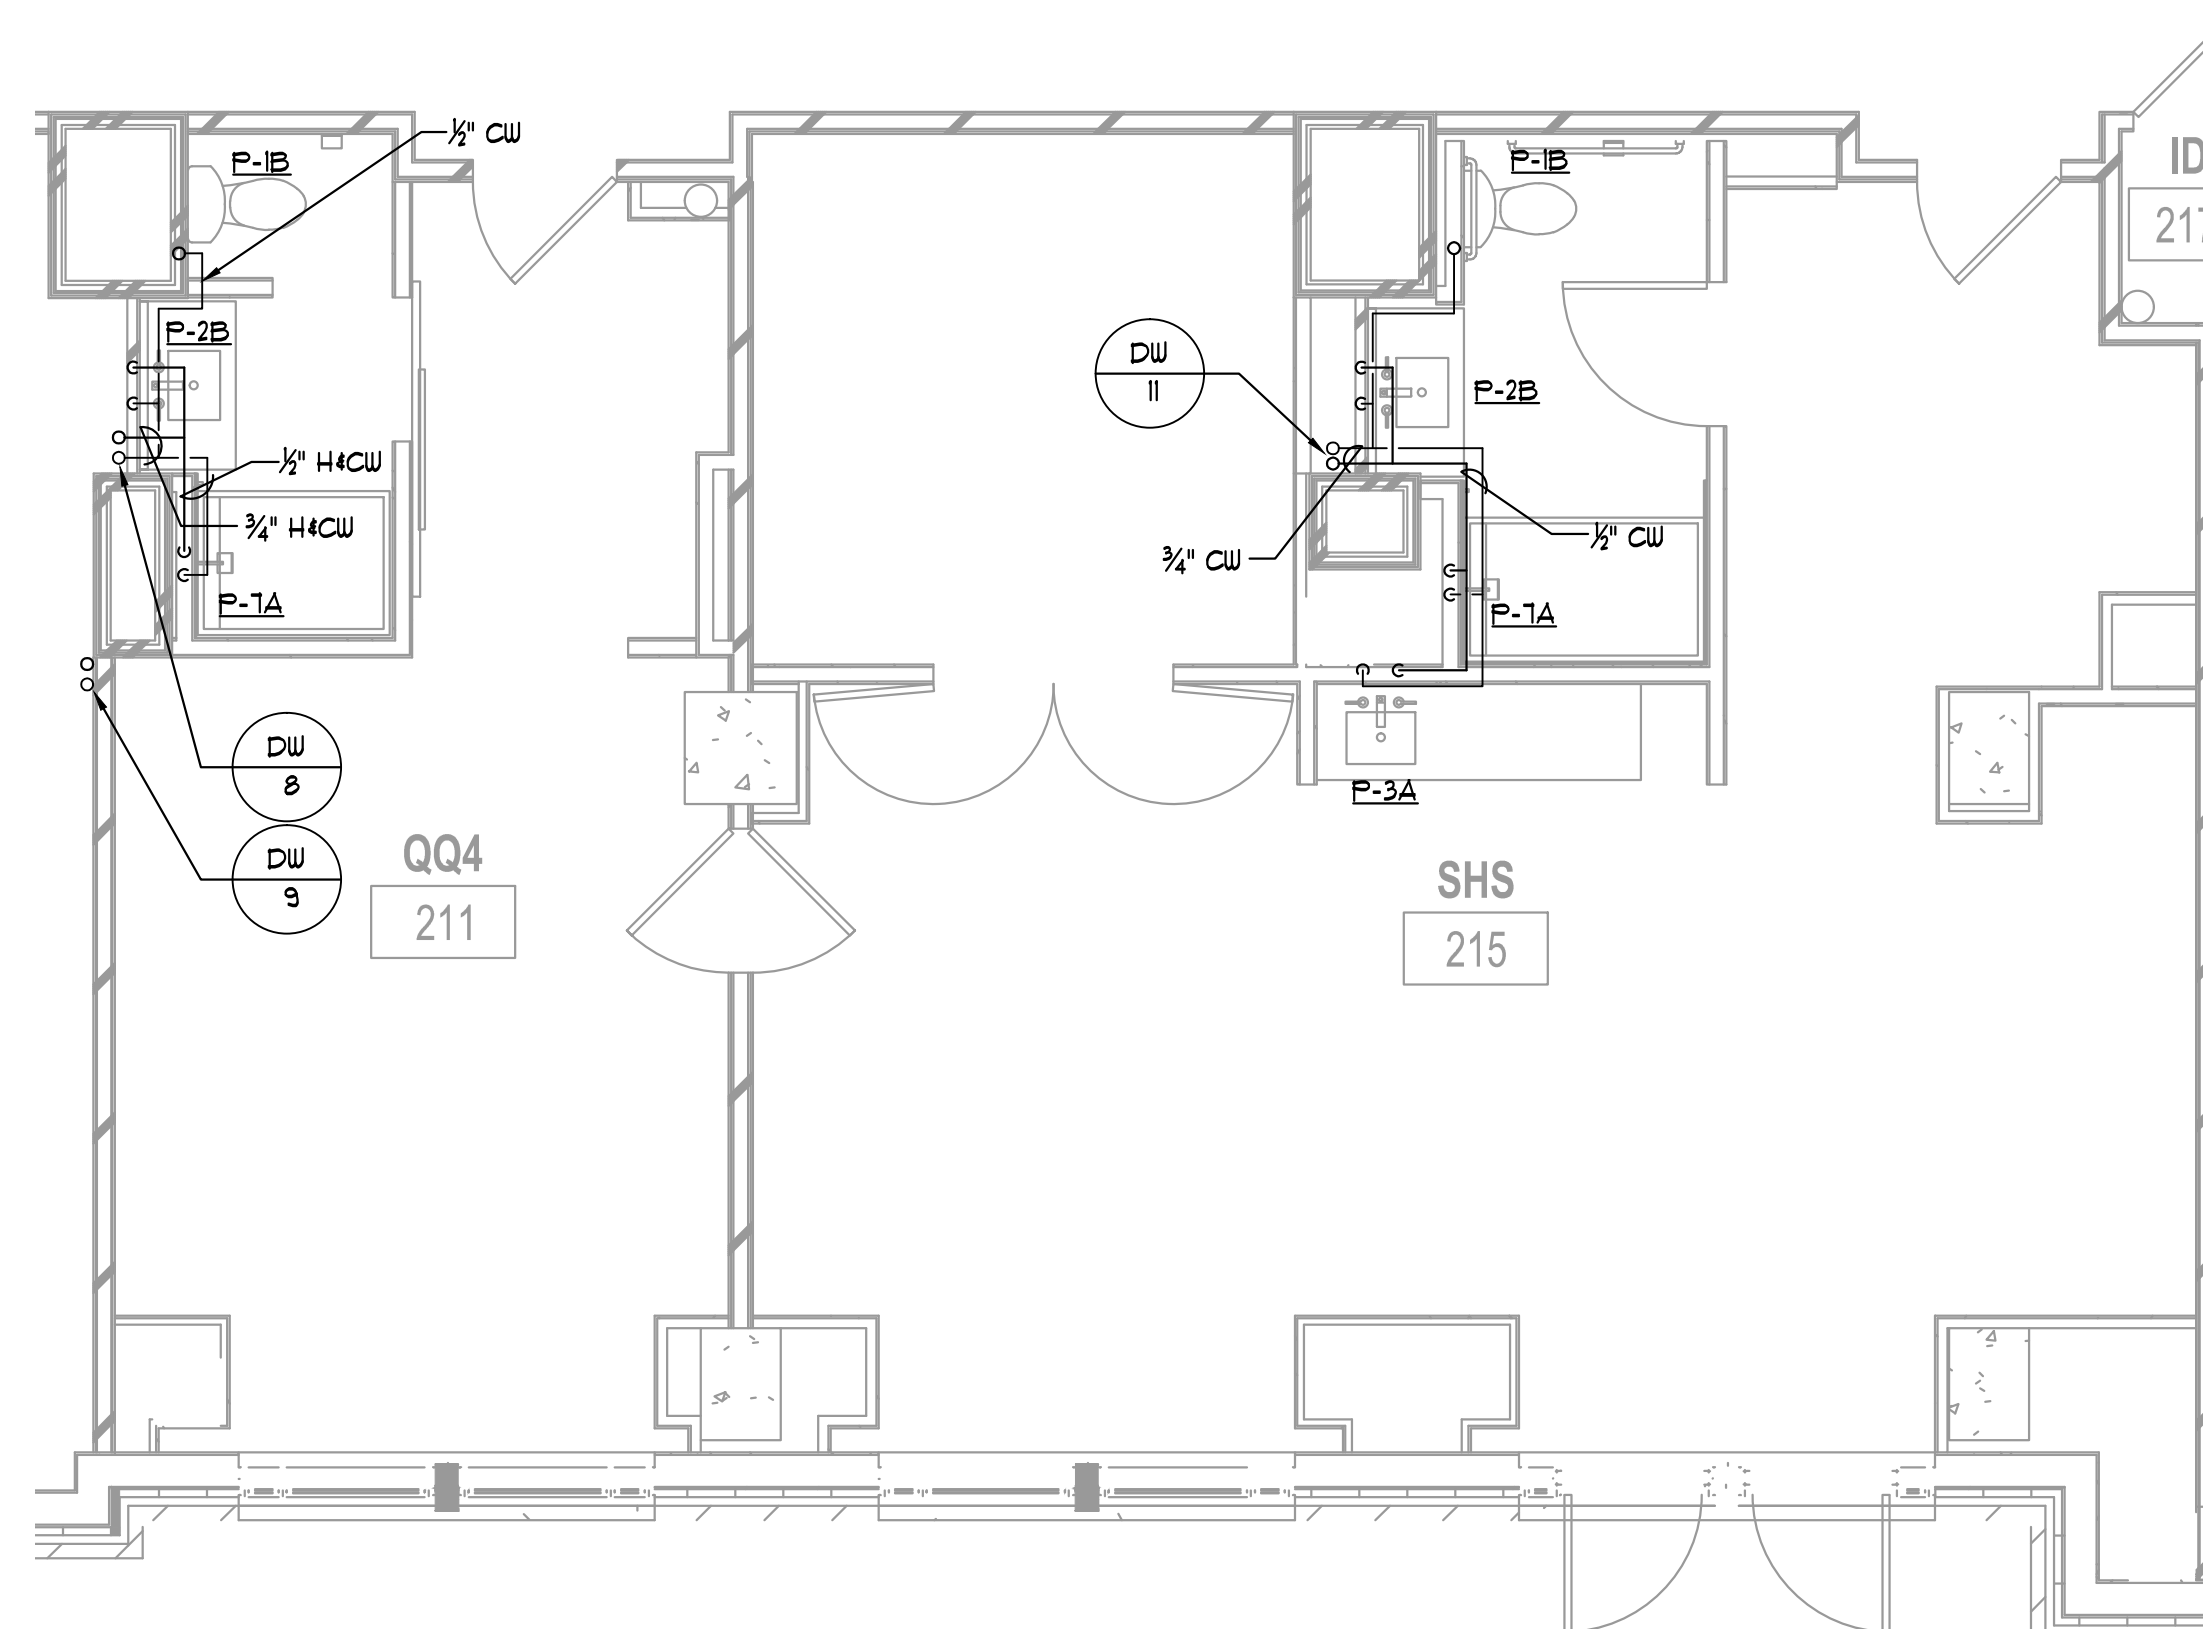


5 QQ4/SHS PLAN — DOMESTIC WATER
P4.05 1/4" = 1'-0"

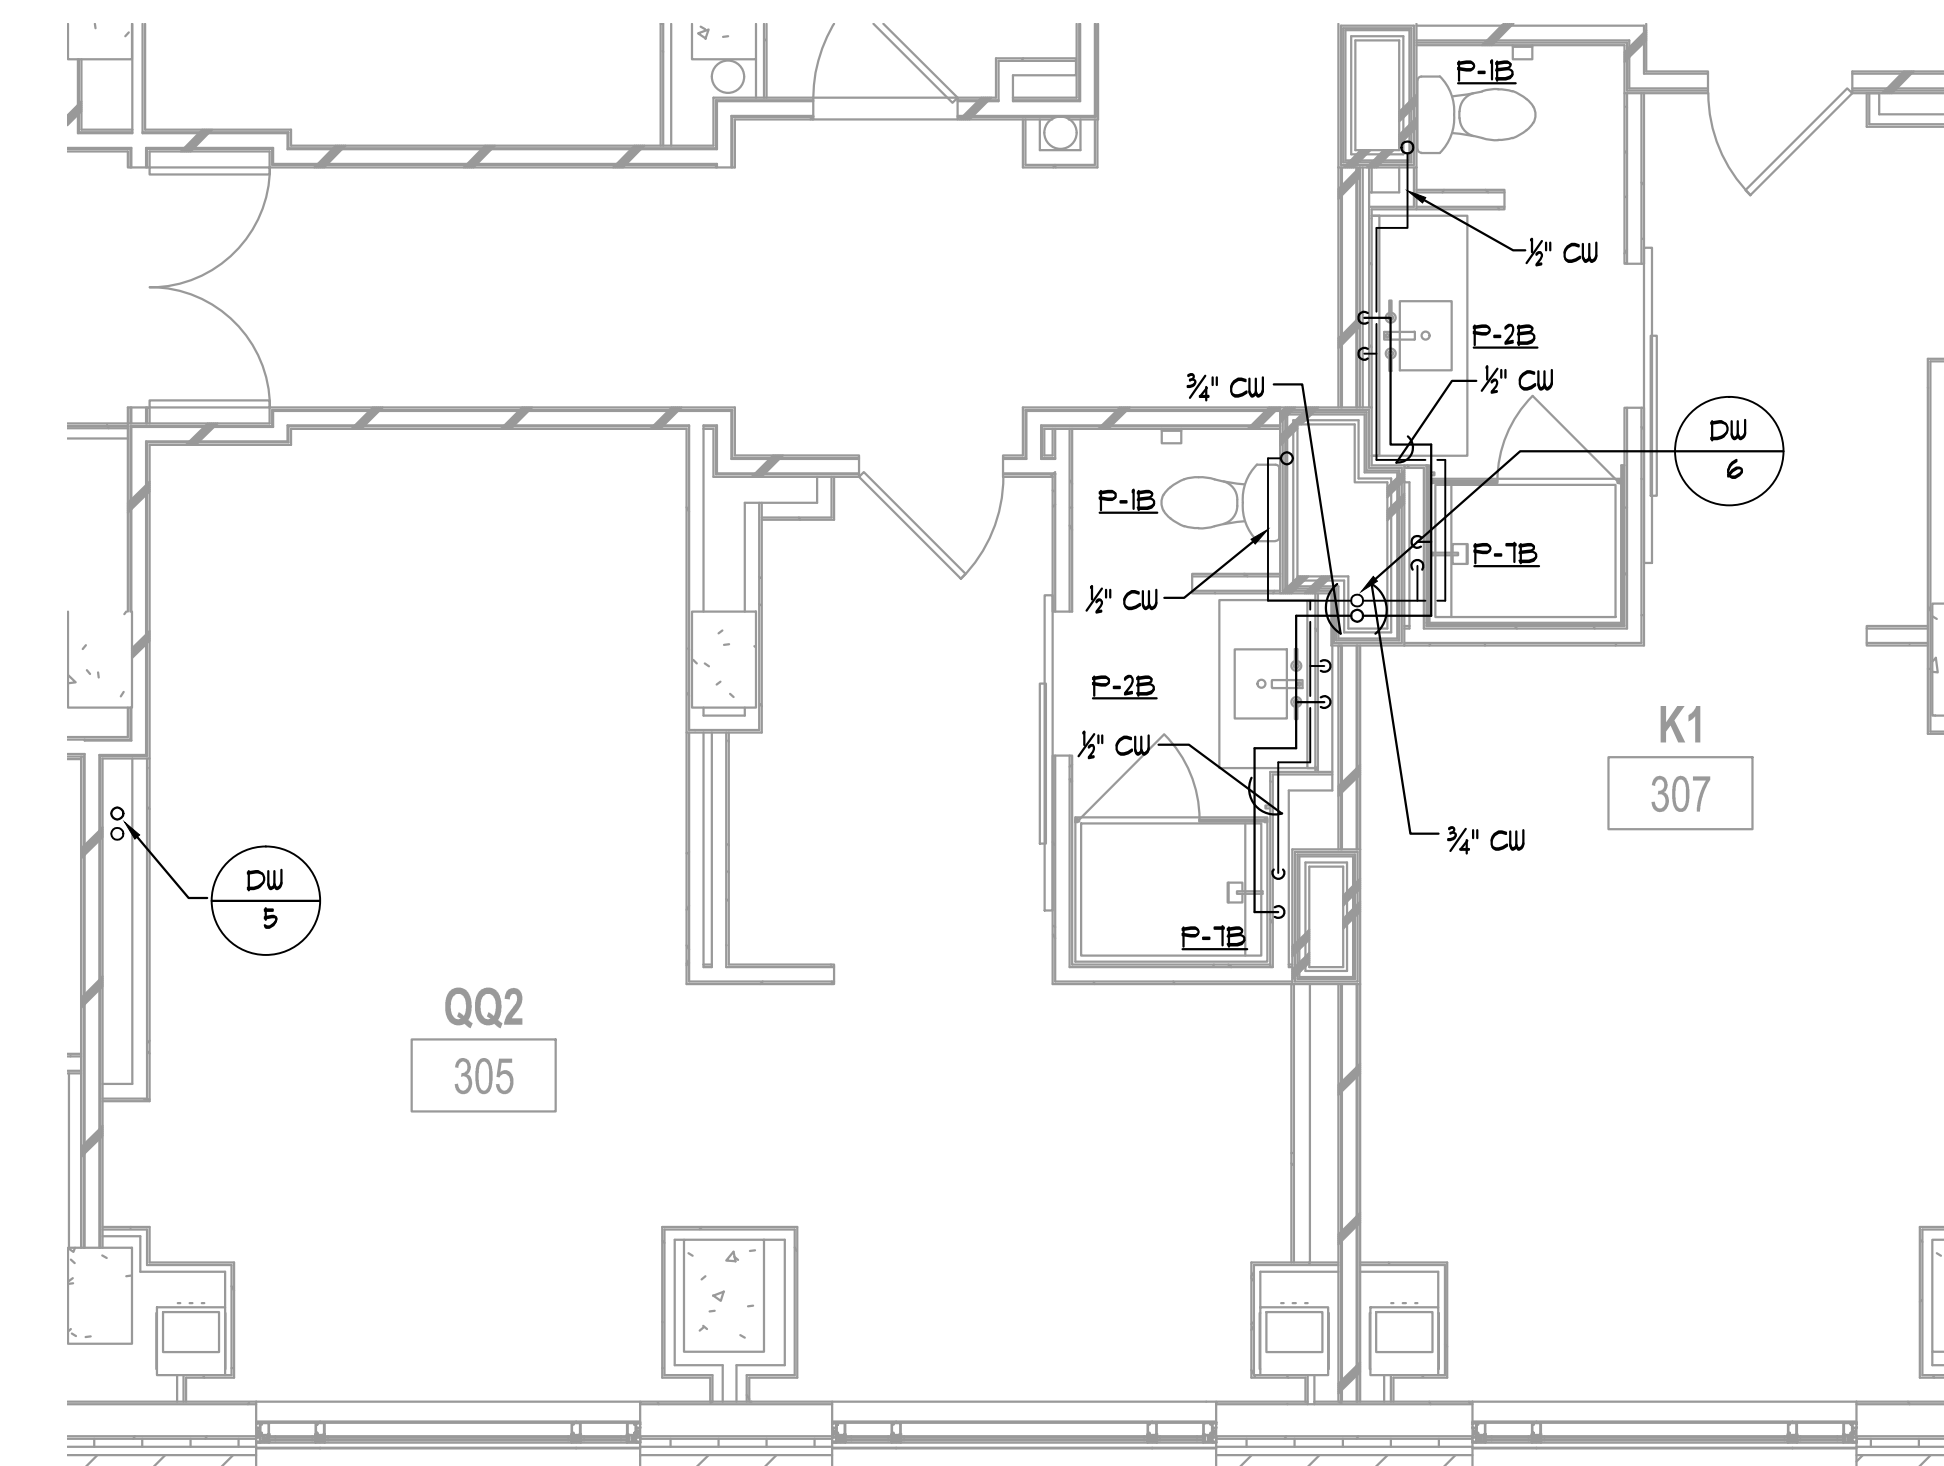

6 QQ2/K1 PLAN — DOMESTIC WATER
P4.05 1/4" = 1'-0"

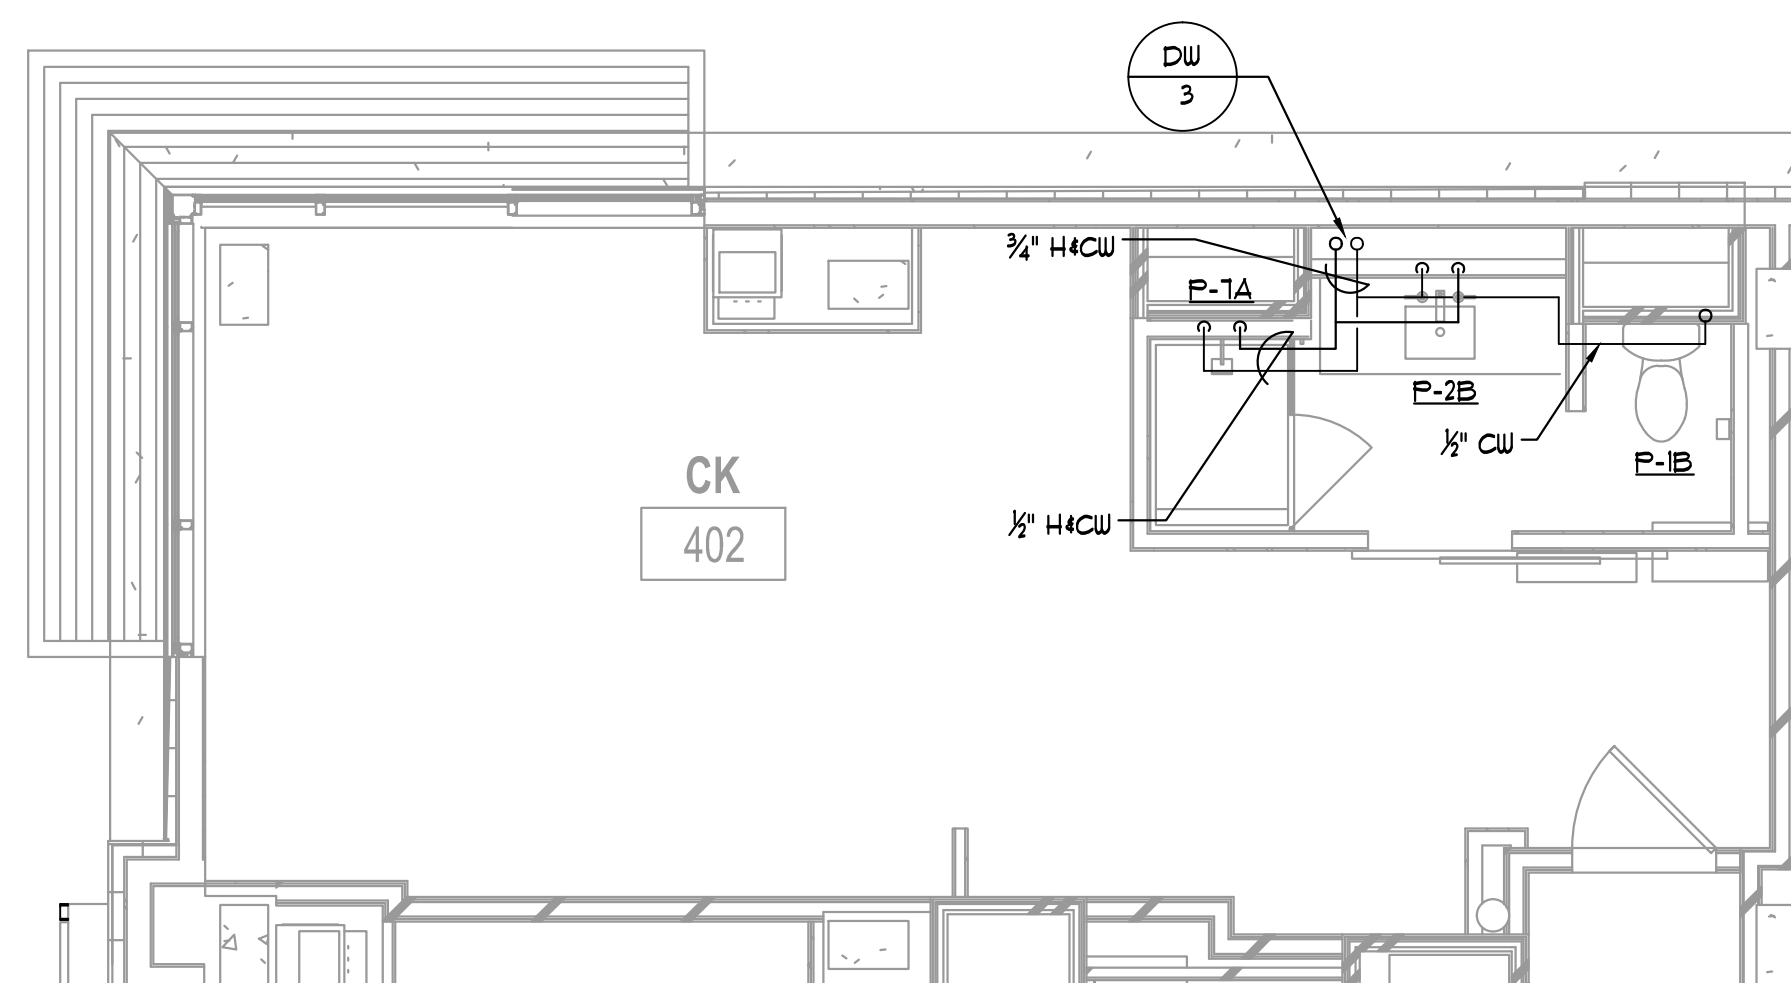

7 CK PLAN — DOMESTIC WATER
P4.05 1/4" = 1'-0"

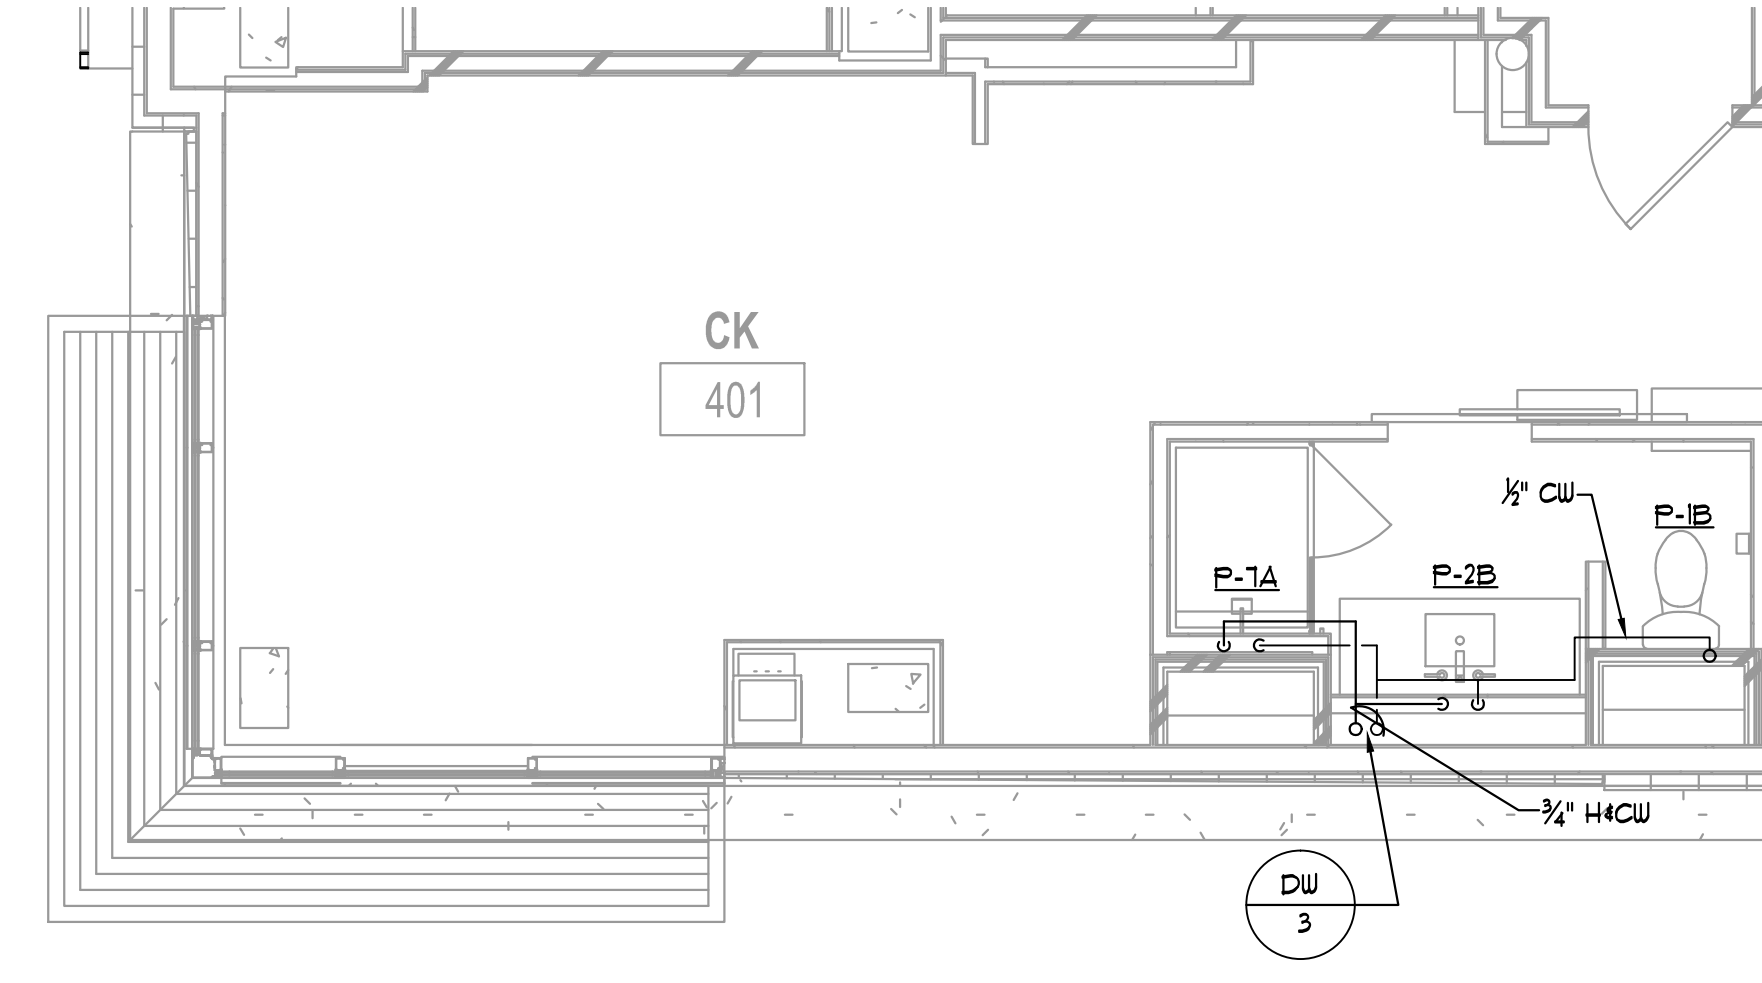

8 CK PLAN — DOMESTIC WATER
P4.05 1/4" = 1'-0"

ALPHARETTA CONFERENCE
CENTER & THE HOTEL AT
AVALON

9000 AVALON BOULEVARD /
ALPHARETTA, GEORGIA 30009


STORMONT HOSPITALITY GROUP, LLC /
NORTH AMERICAN PROPERTY GROUP

GUESTROOM PART
PLANS - DOMESTIC
WATER


K. PRICE	140028
Principal in Charge	BW&A Project No.
G. JENKINS	101716
Project Engineer	Date
T. MERCER	
Checker	

P4.05


ISSUED FOR CONSTRUCTION

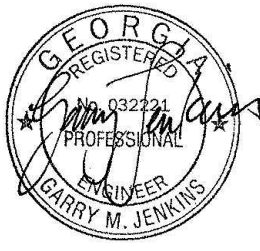


ISSUANCES		
No.	Drawing Issue Description	Date
	BUILDING PERMIT	2016.10.17

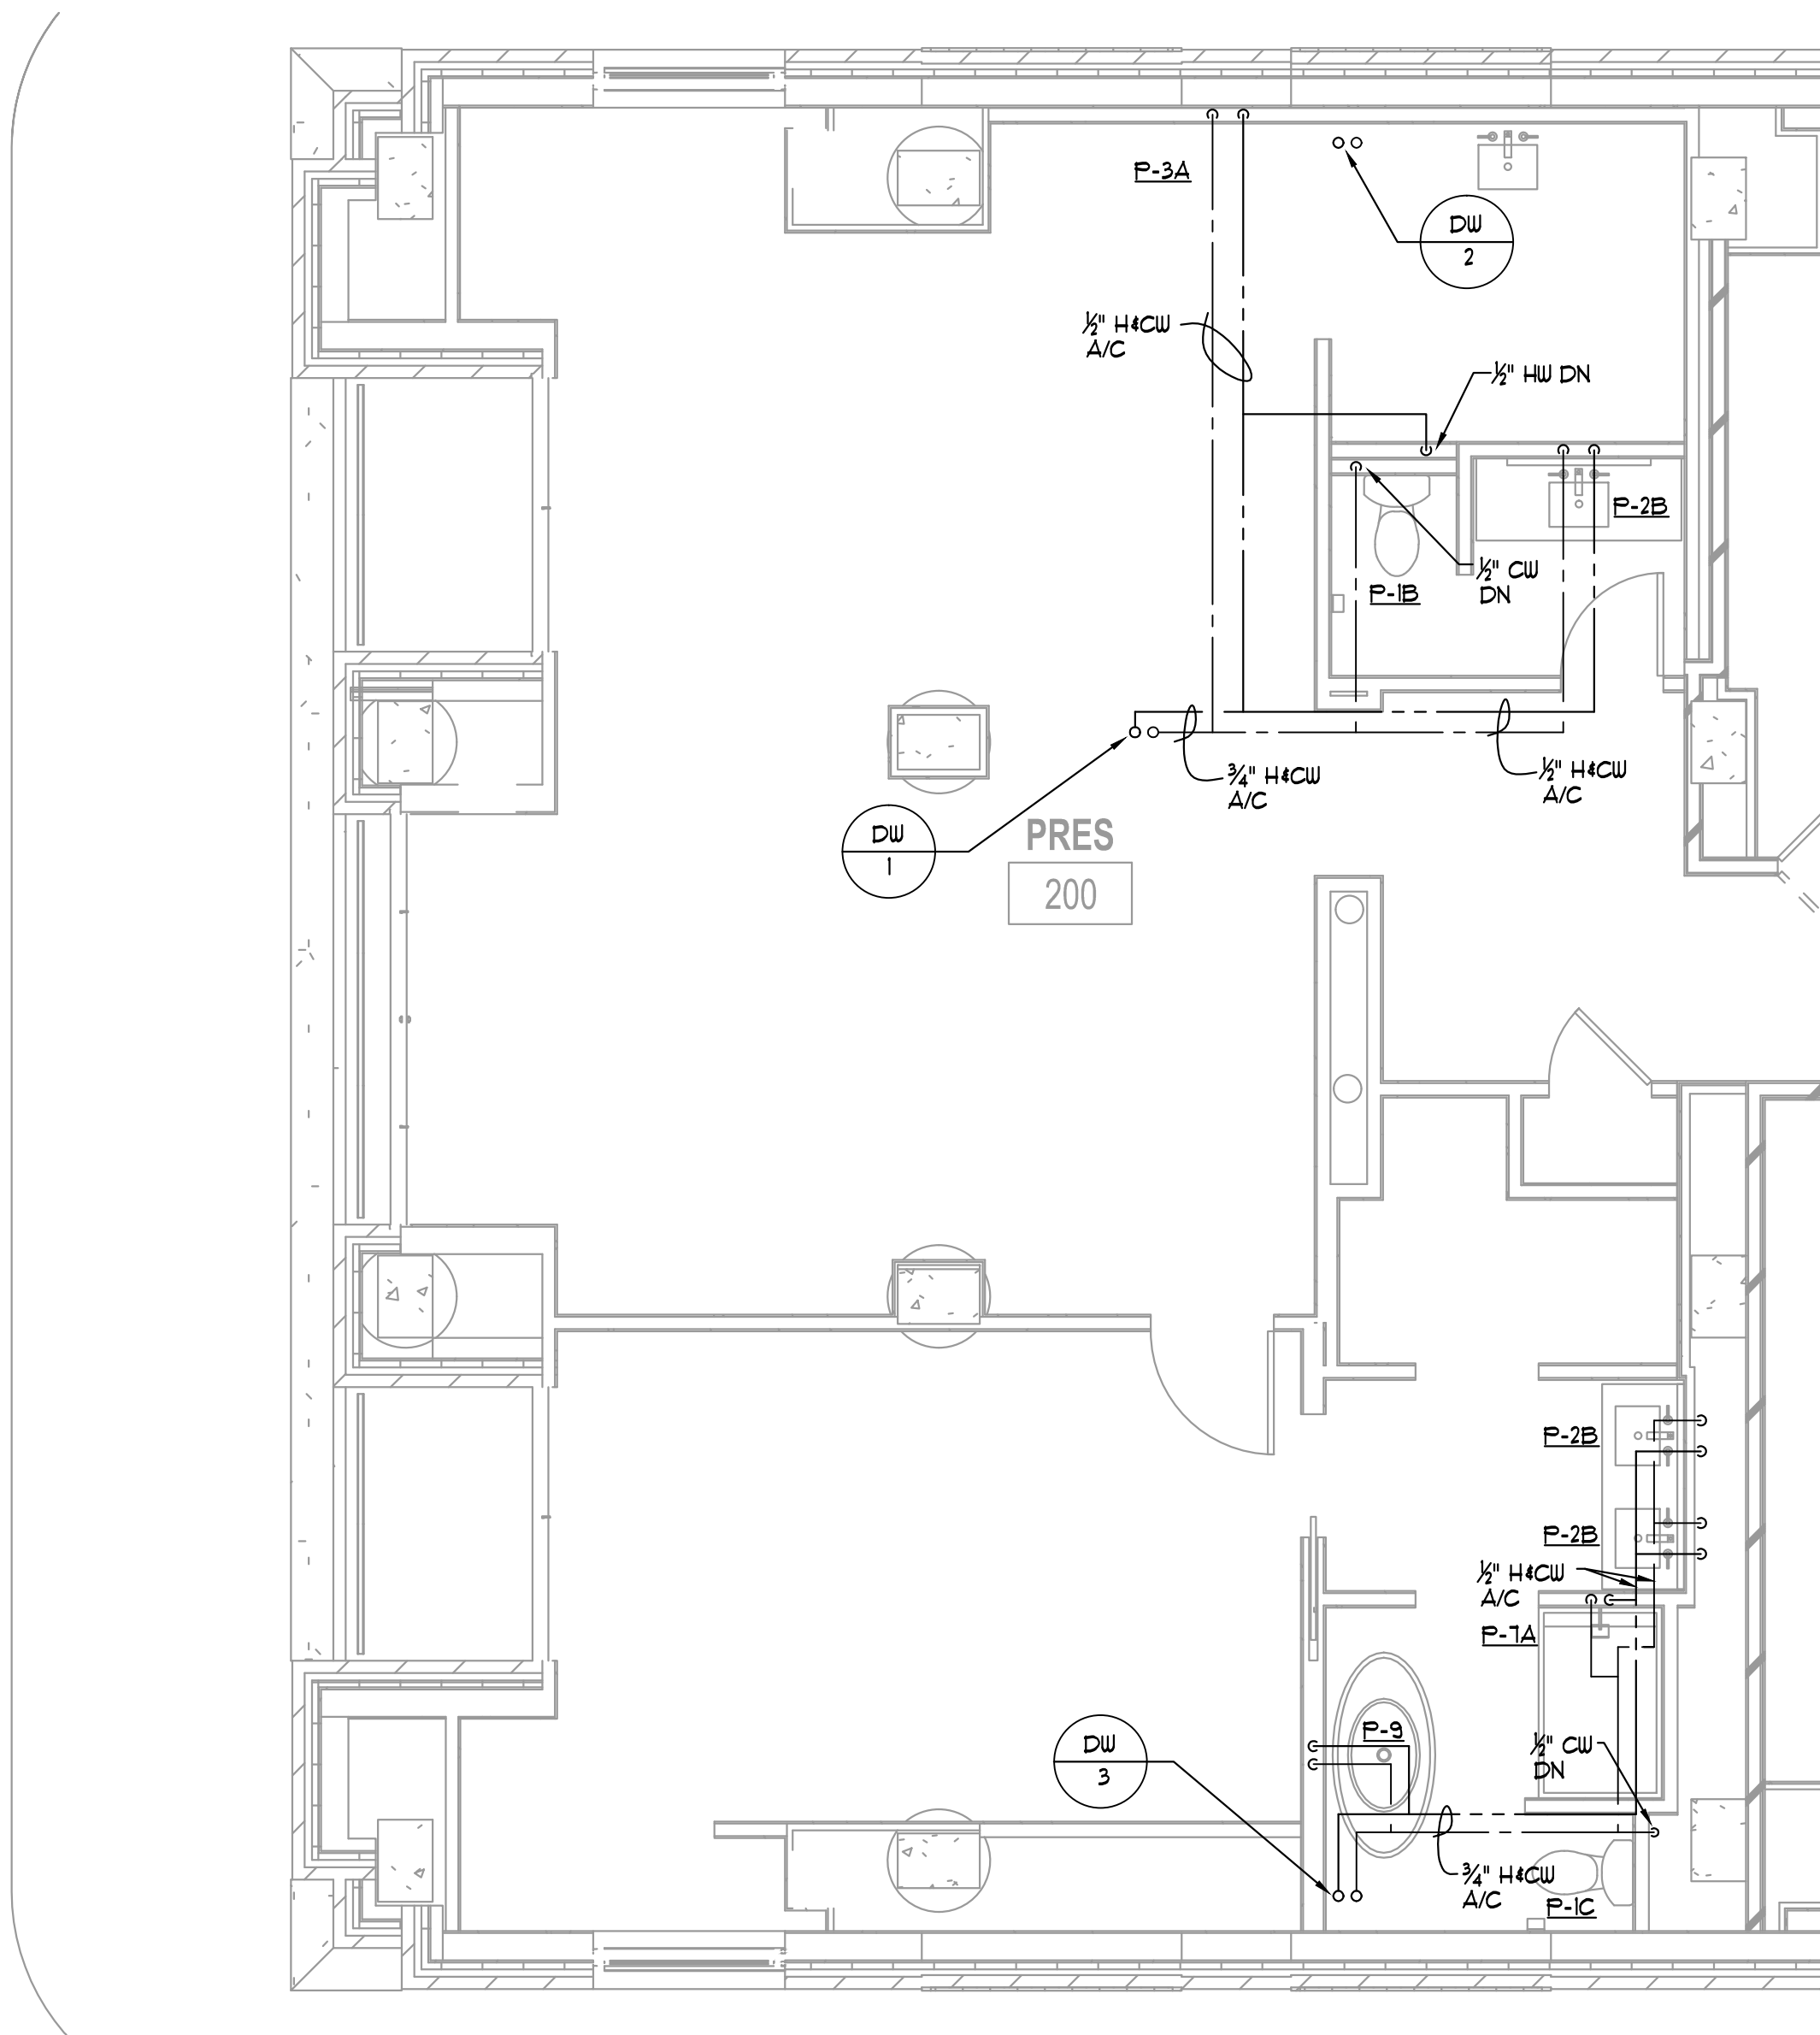

1 PRES PLAN — DOMESTIC WATER
P4.06 1/4" = 1'-0"

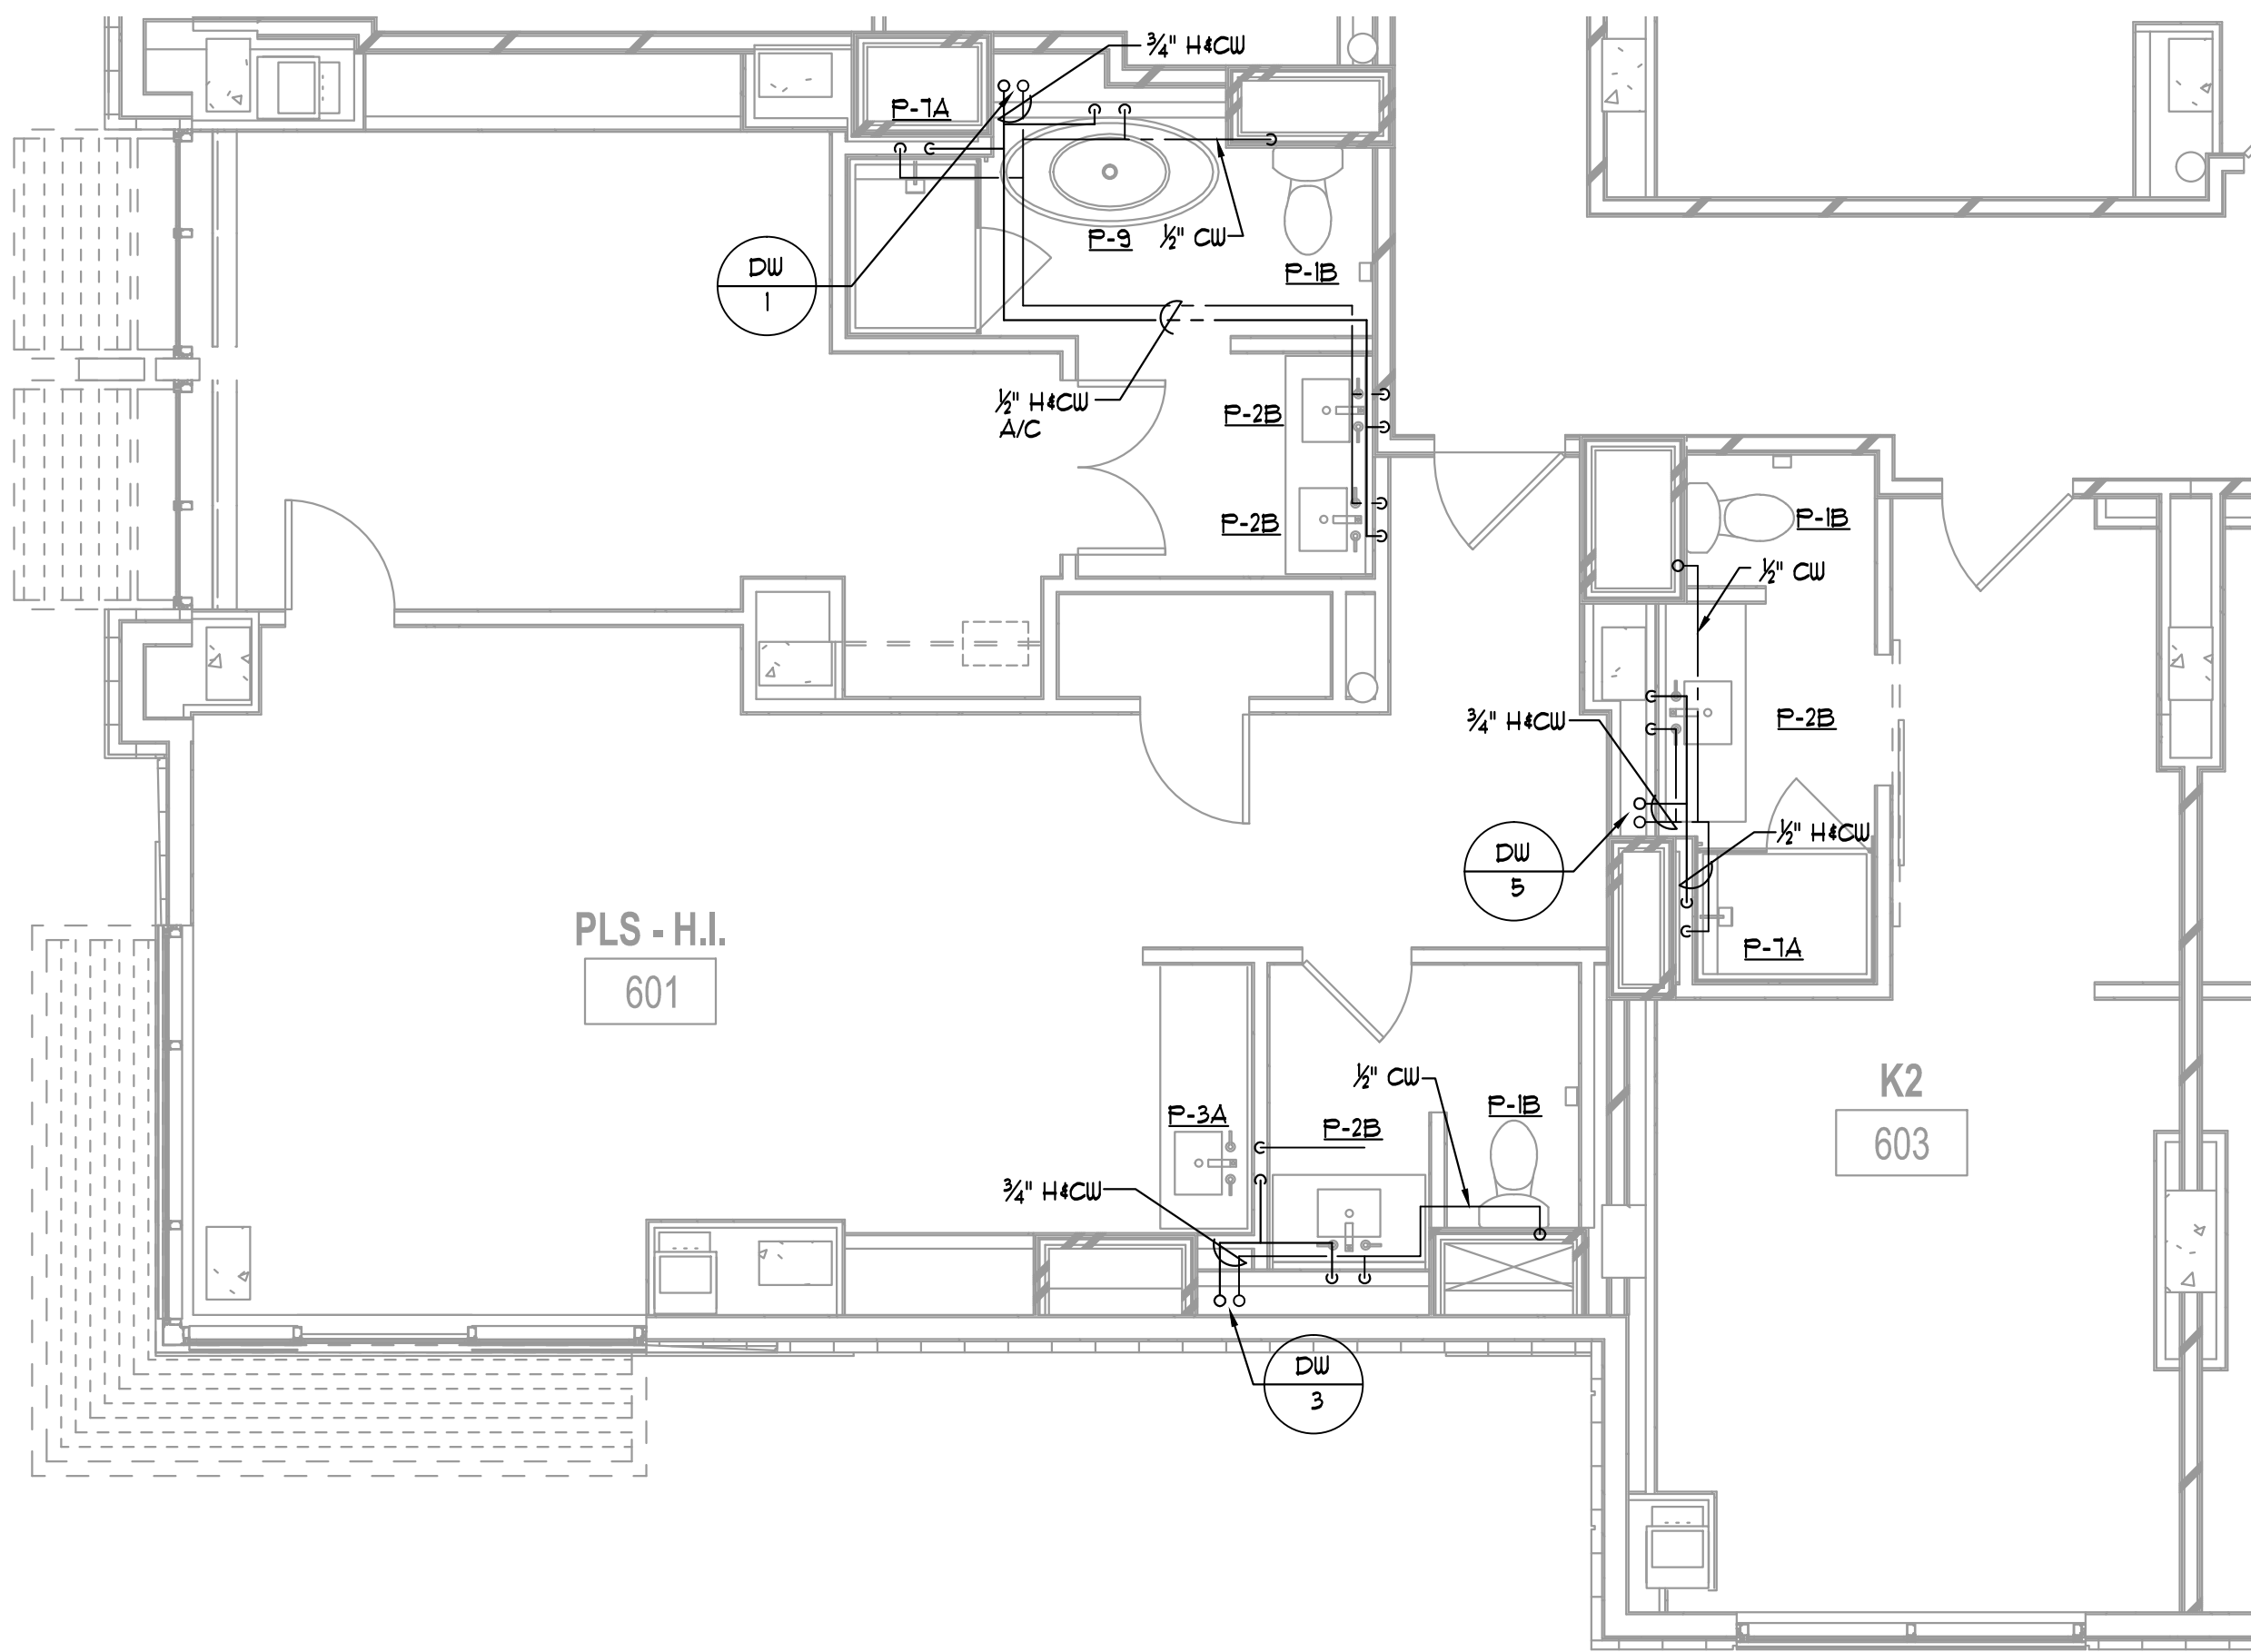

2 PLS/K2 PLAN — DOMESTIC WATER
P4.06 1/4" = 1'-0"

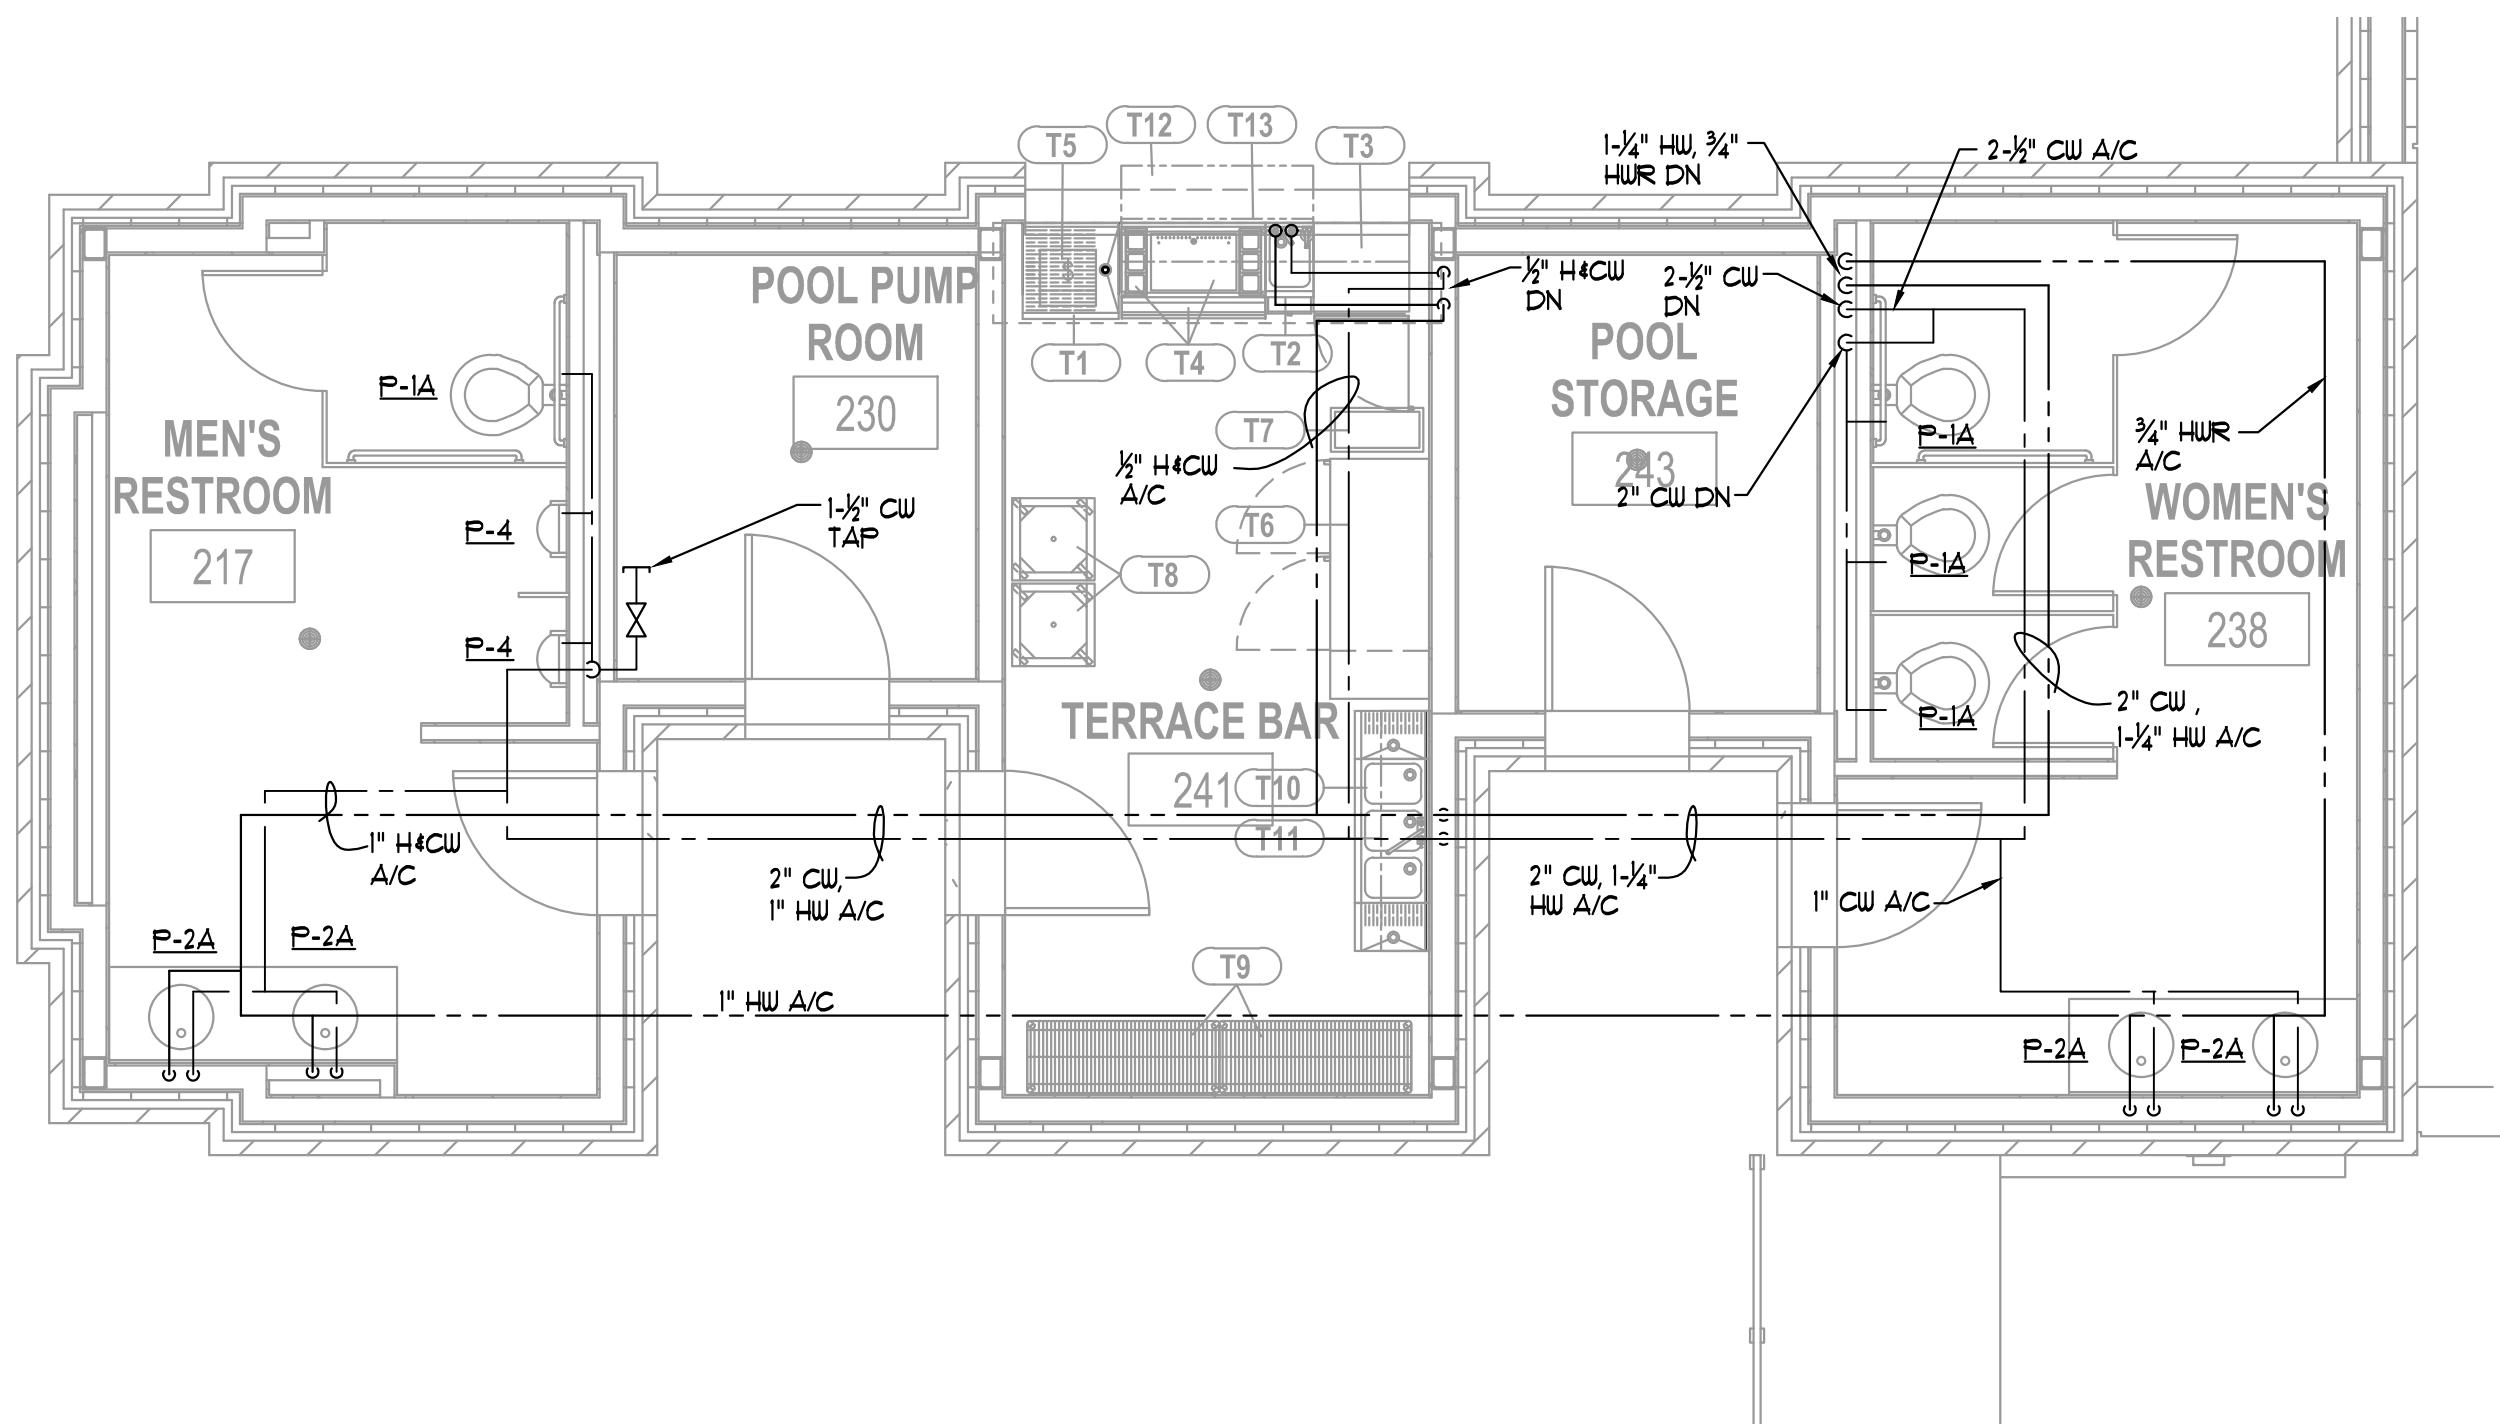

3 POOL RESTROOMS & TERRACE BAR PLAN — DOMESTIC WATER
P4.06 1/4" = 1'-0"

**ALPHARETTA CONFERENCE
CENTER & THE HOTEL AT
AVALON**


9000 AVALON BOULEVARD /
ALPHARETTA, GEORGIA 30009

STORMONT HOSPITALITY GROUP, LLC /
NORTH AMERICAN PROPERTY GROUP

**GUESTROOM PART
PLANS - DOMESTIC
WATER**


K. PRICE	140028
Principal-in-Charge	BW&A Project No.
G. JENKINS	101716
Project Engineer	Date
T. MERCER	
Checker	

P4.06

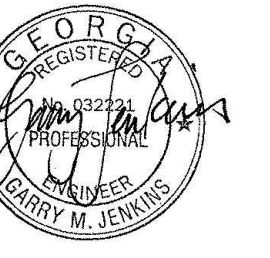


ISSUANCES


No.	Drawing Issue Description	Date
1	BUILDING PERMIT	2016.10.17

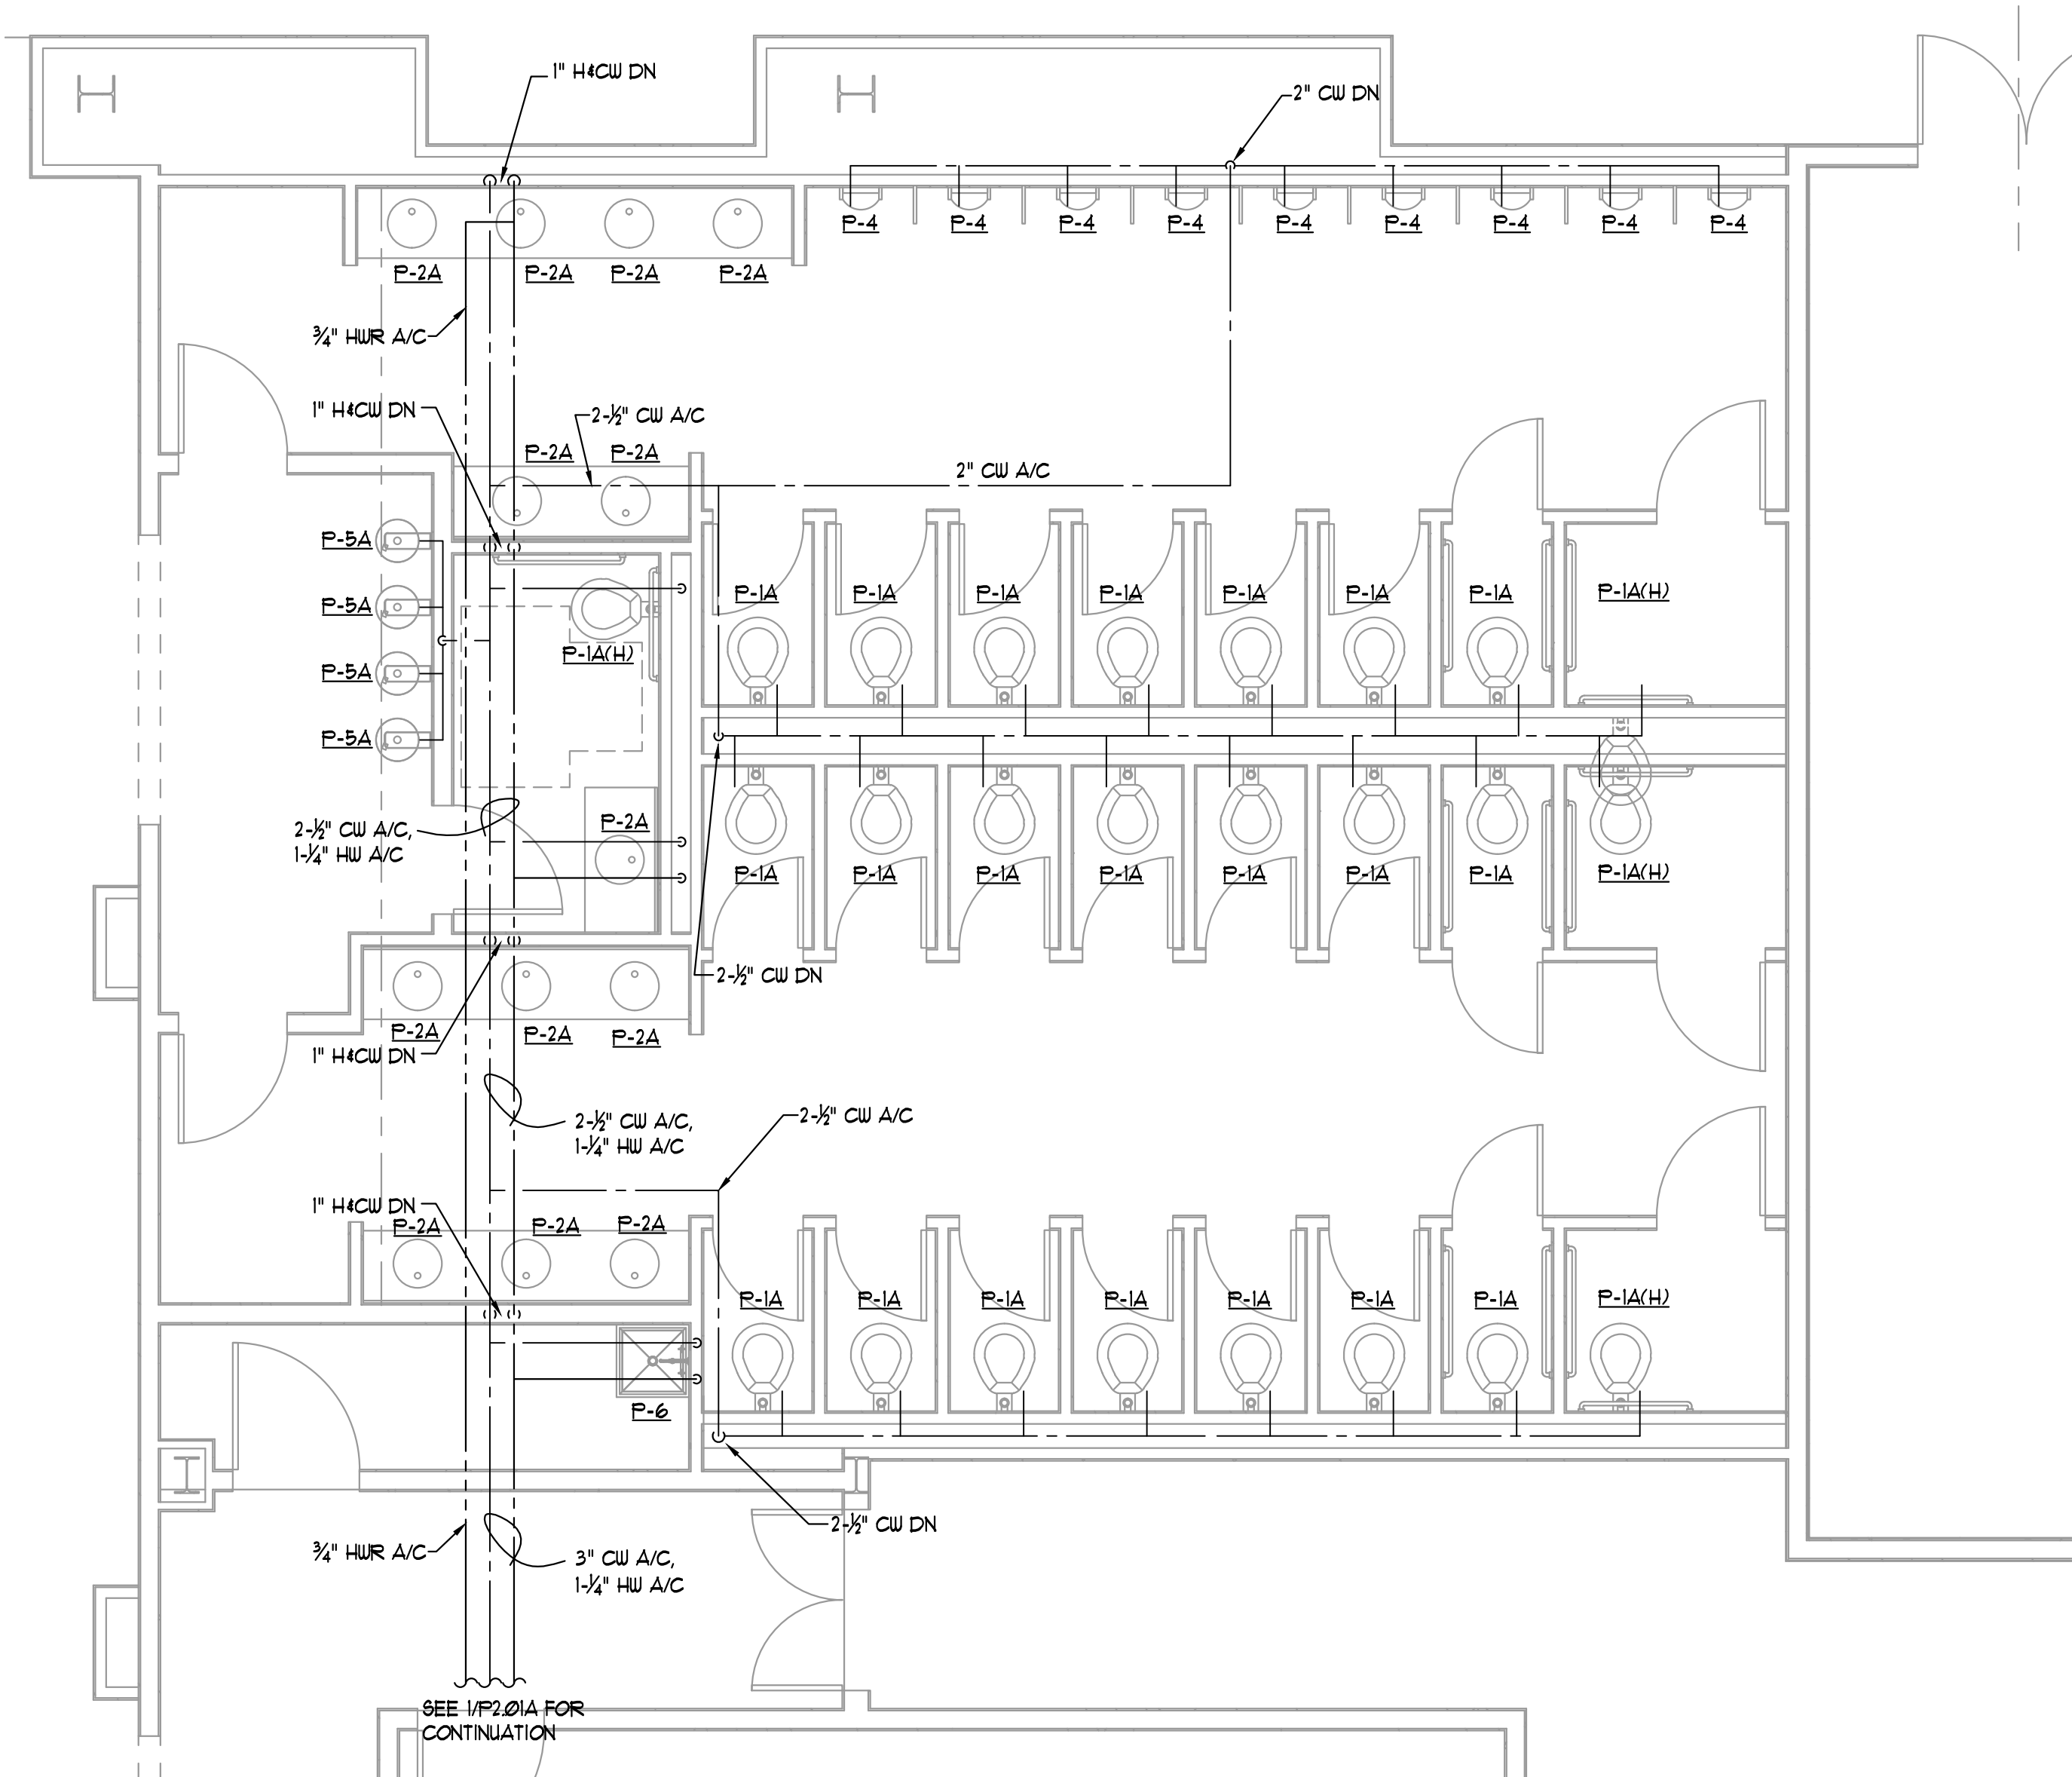


1 LEVEL 1 ZONE A RESTROOMS — DOMESTIC WATER
P4.07 1/4" = 1'-0"

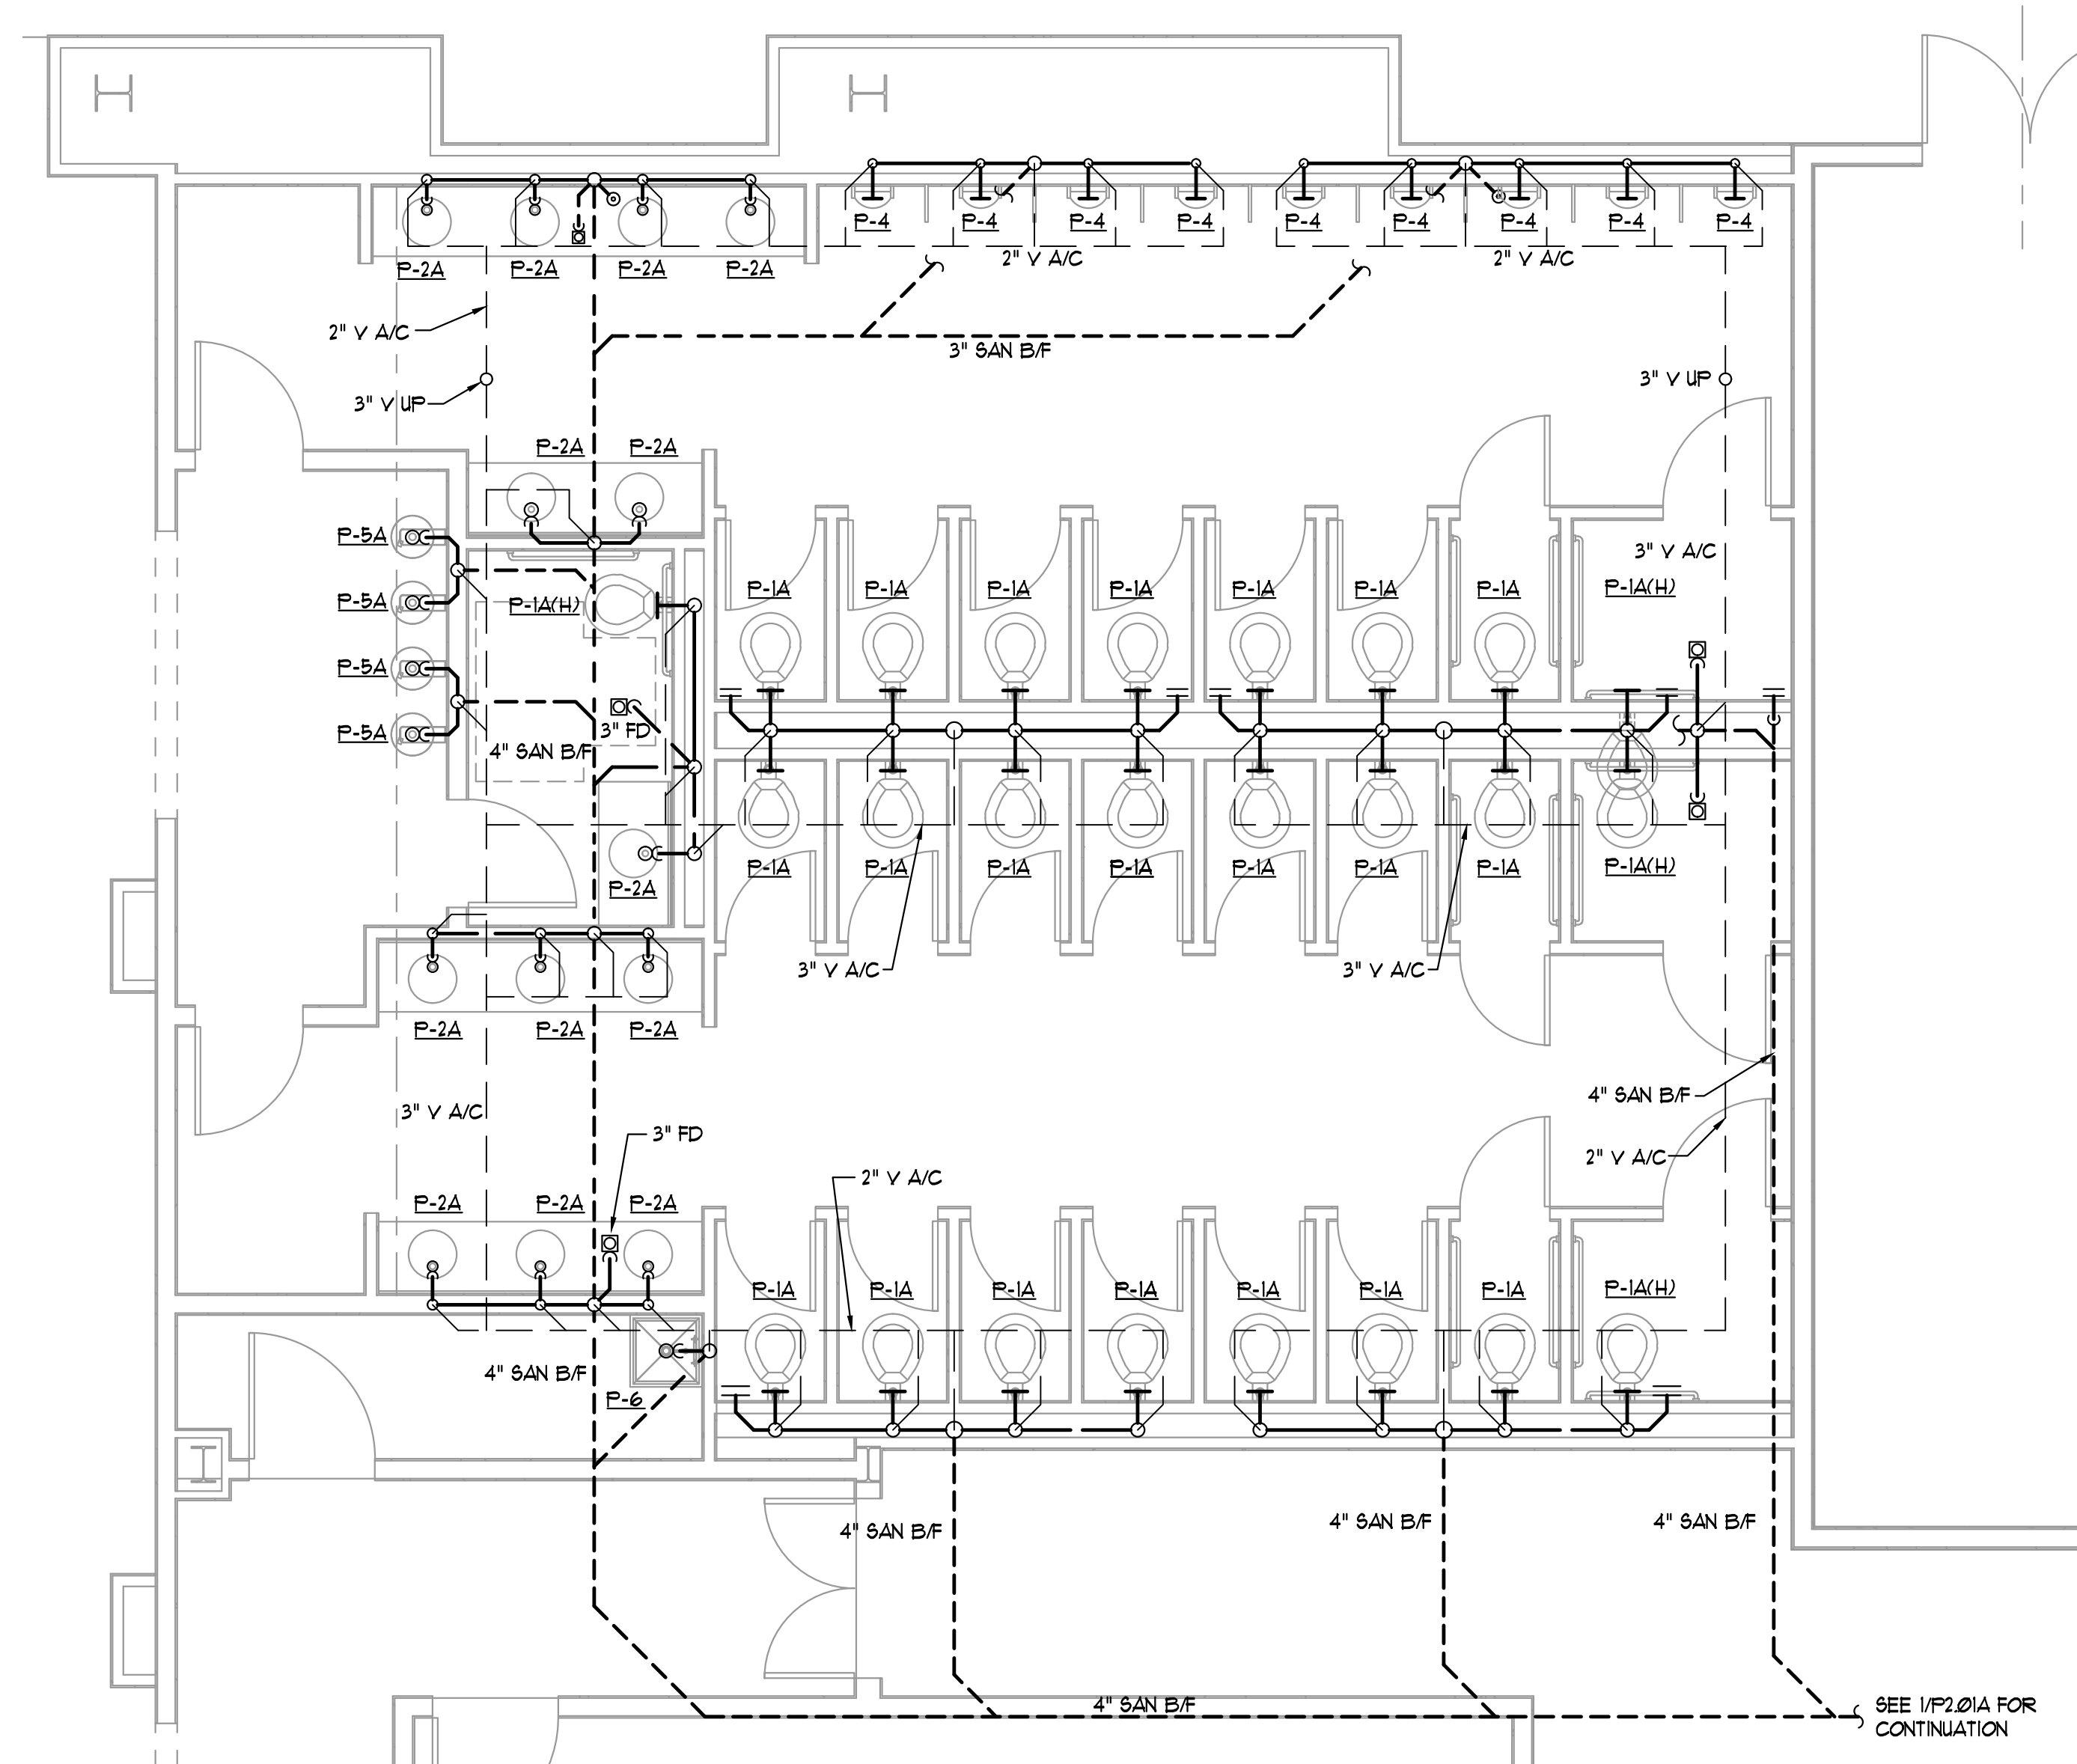

2 LEVEL 1 ZONE A RESTROOMS — SANITARY & VENT
P4.07 1/4" = 1'-0"

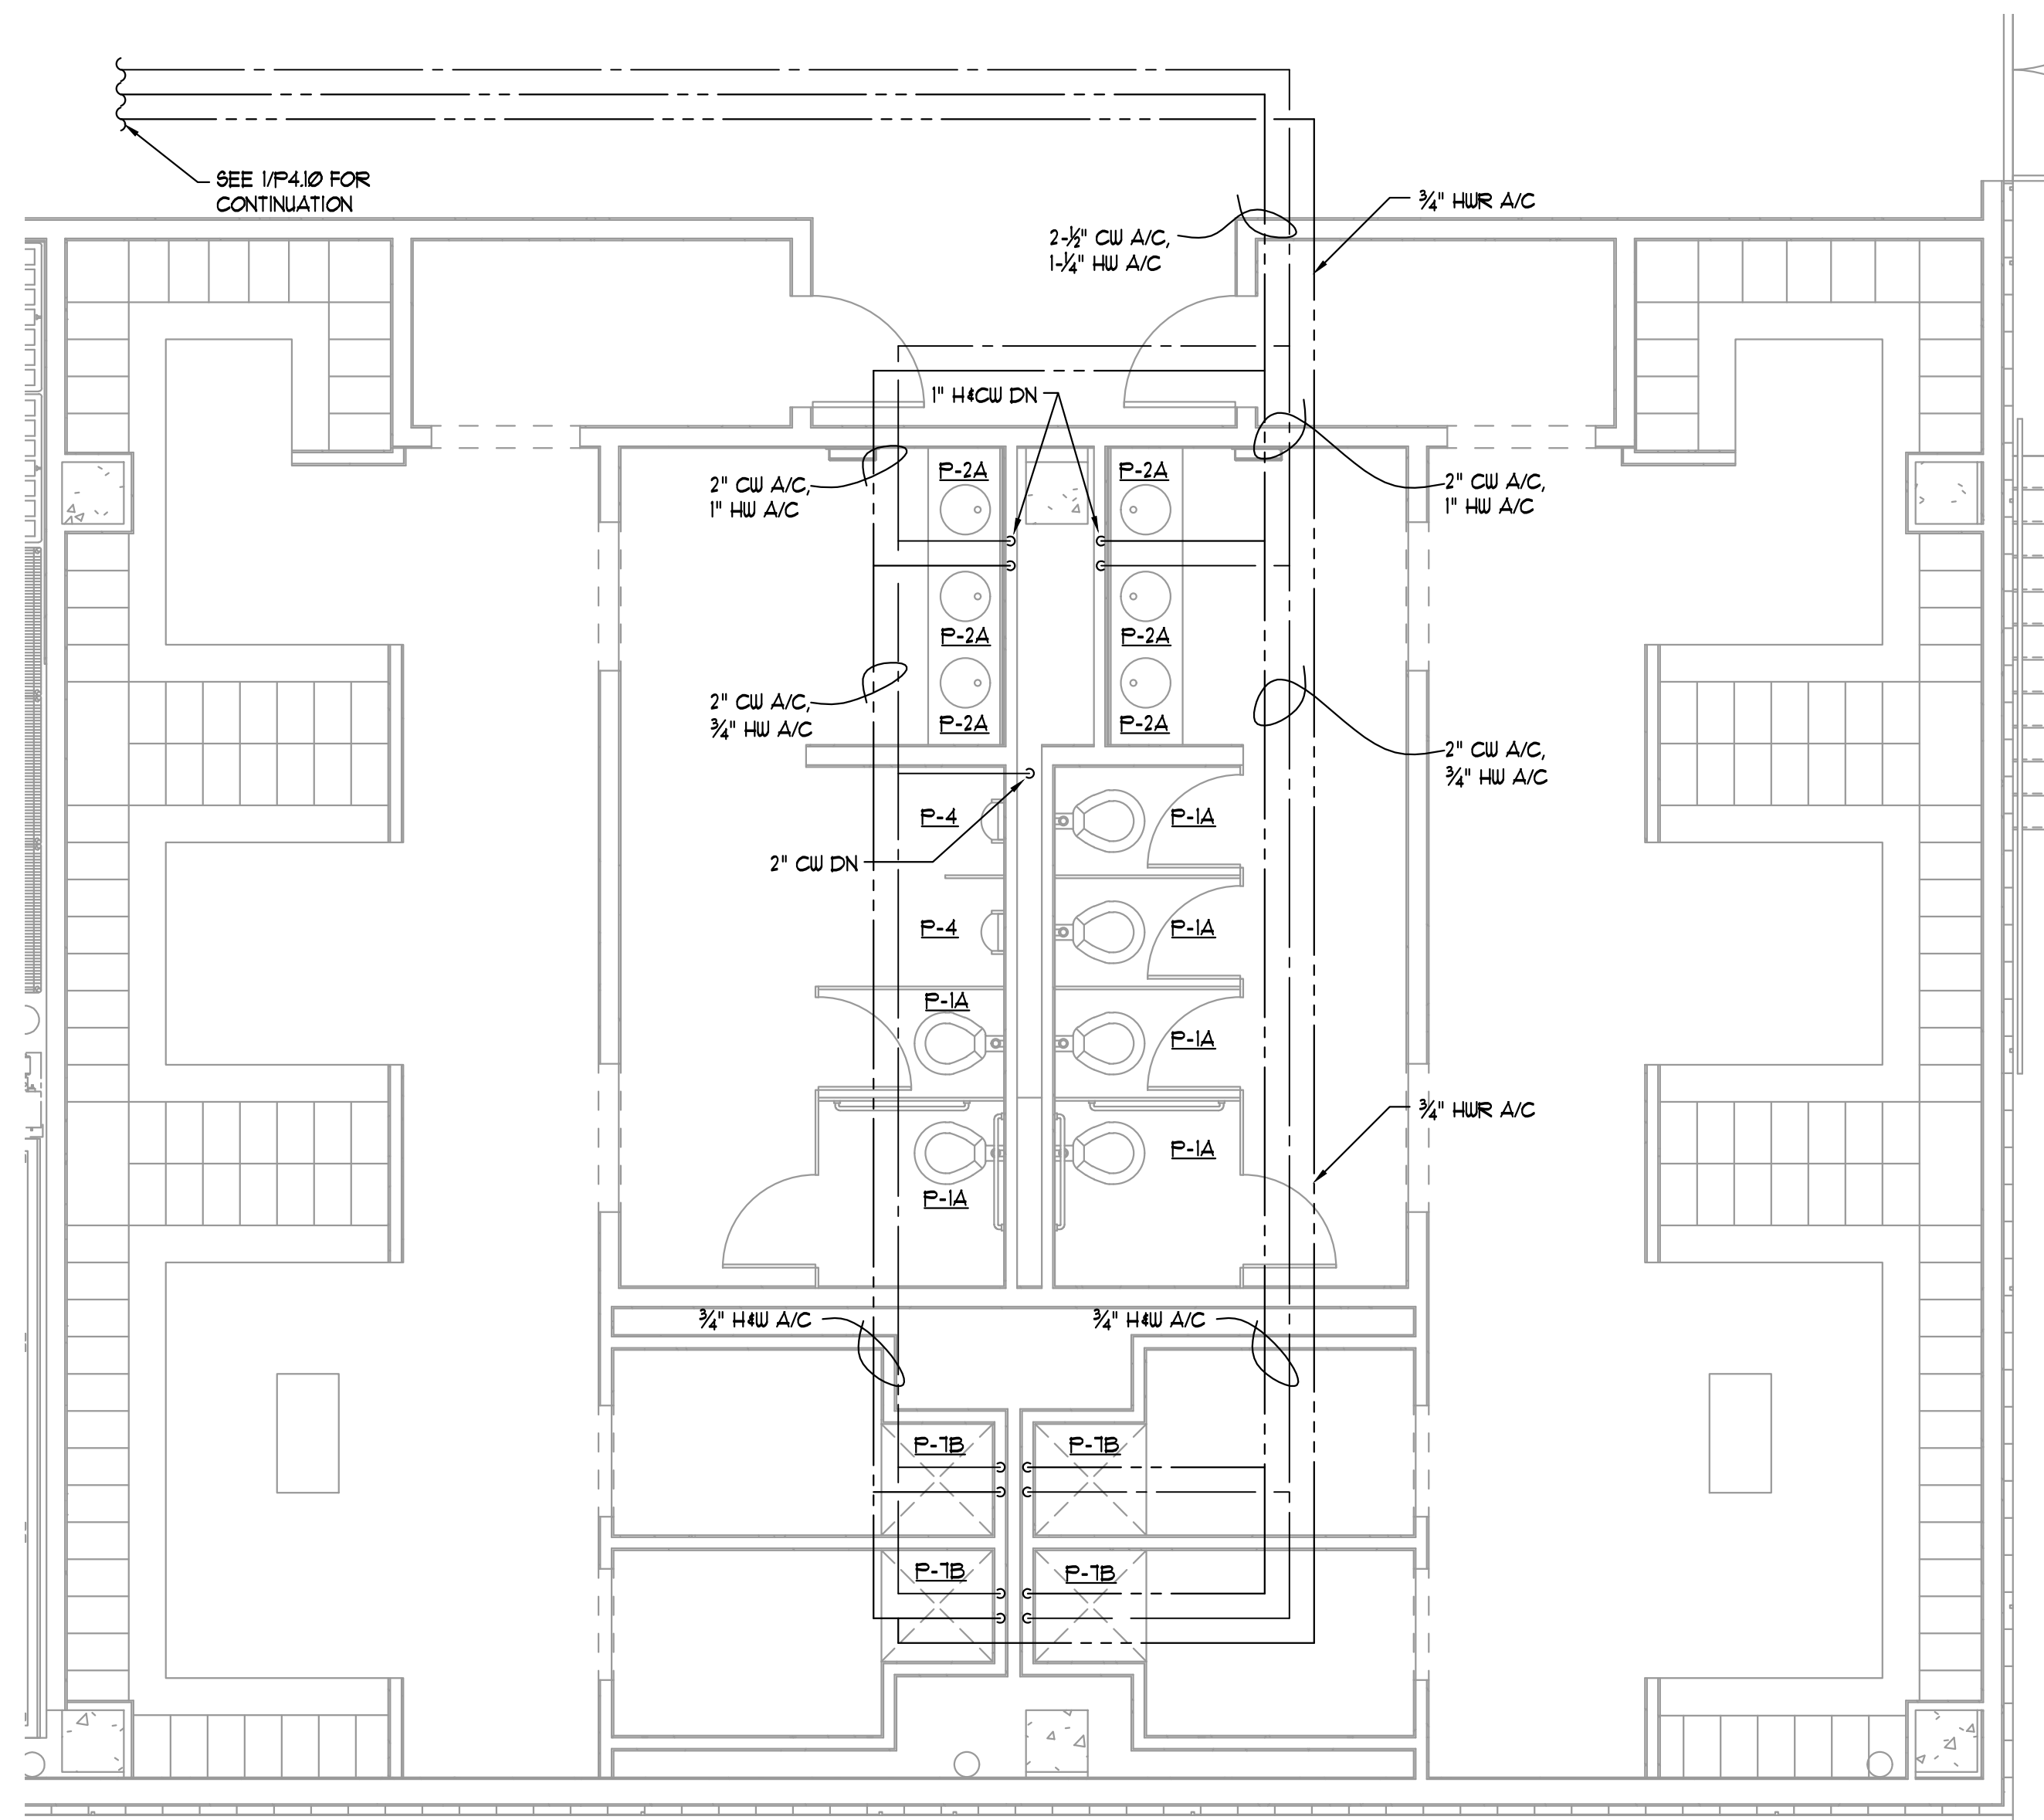

3 LEVEL 1 ZONE A LOCKERS — DOMESTIC WATER
P4.07 1/4" = 1'-0"

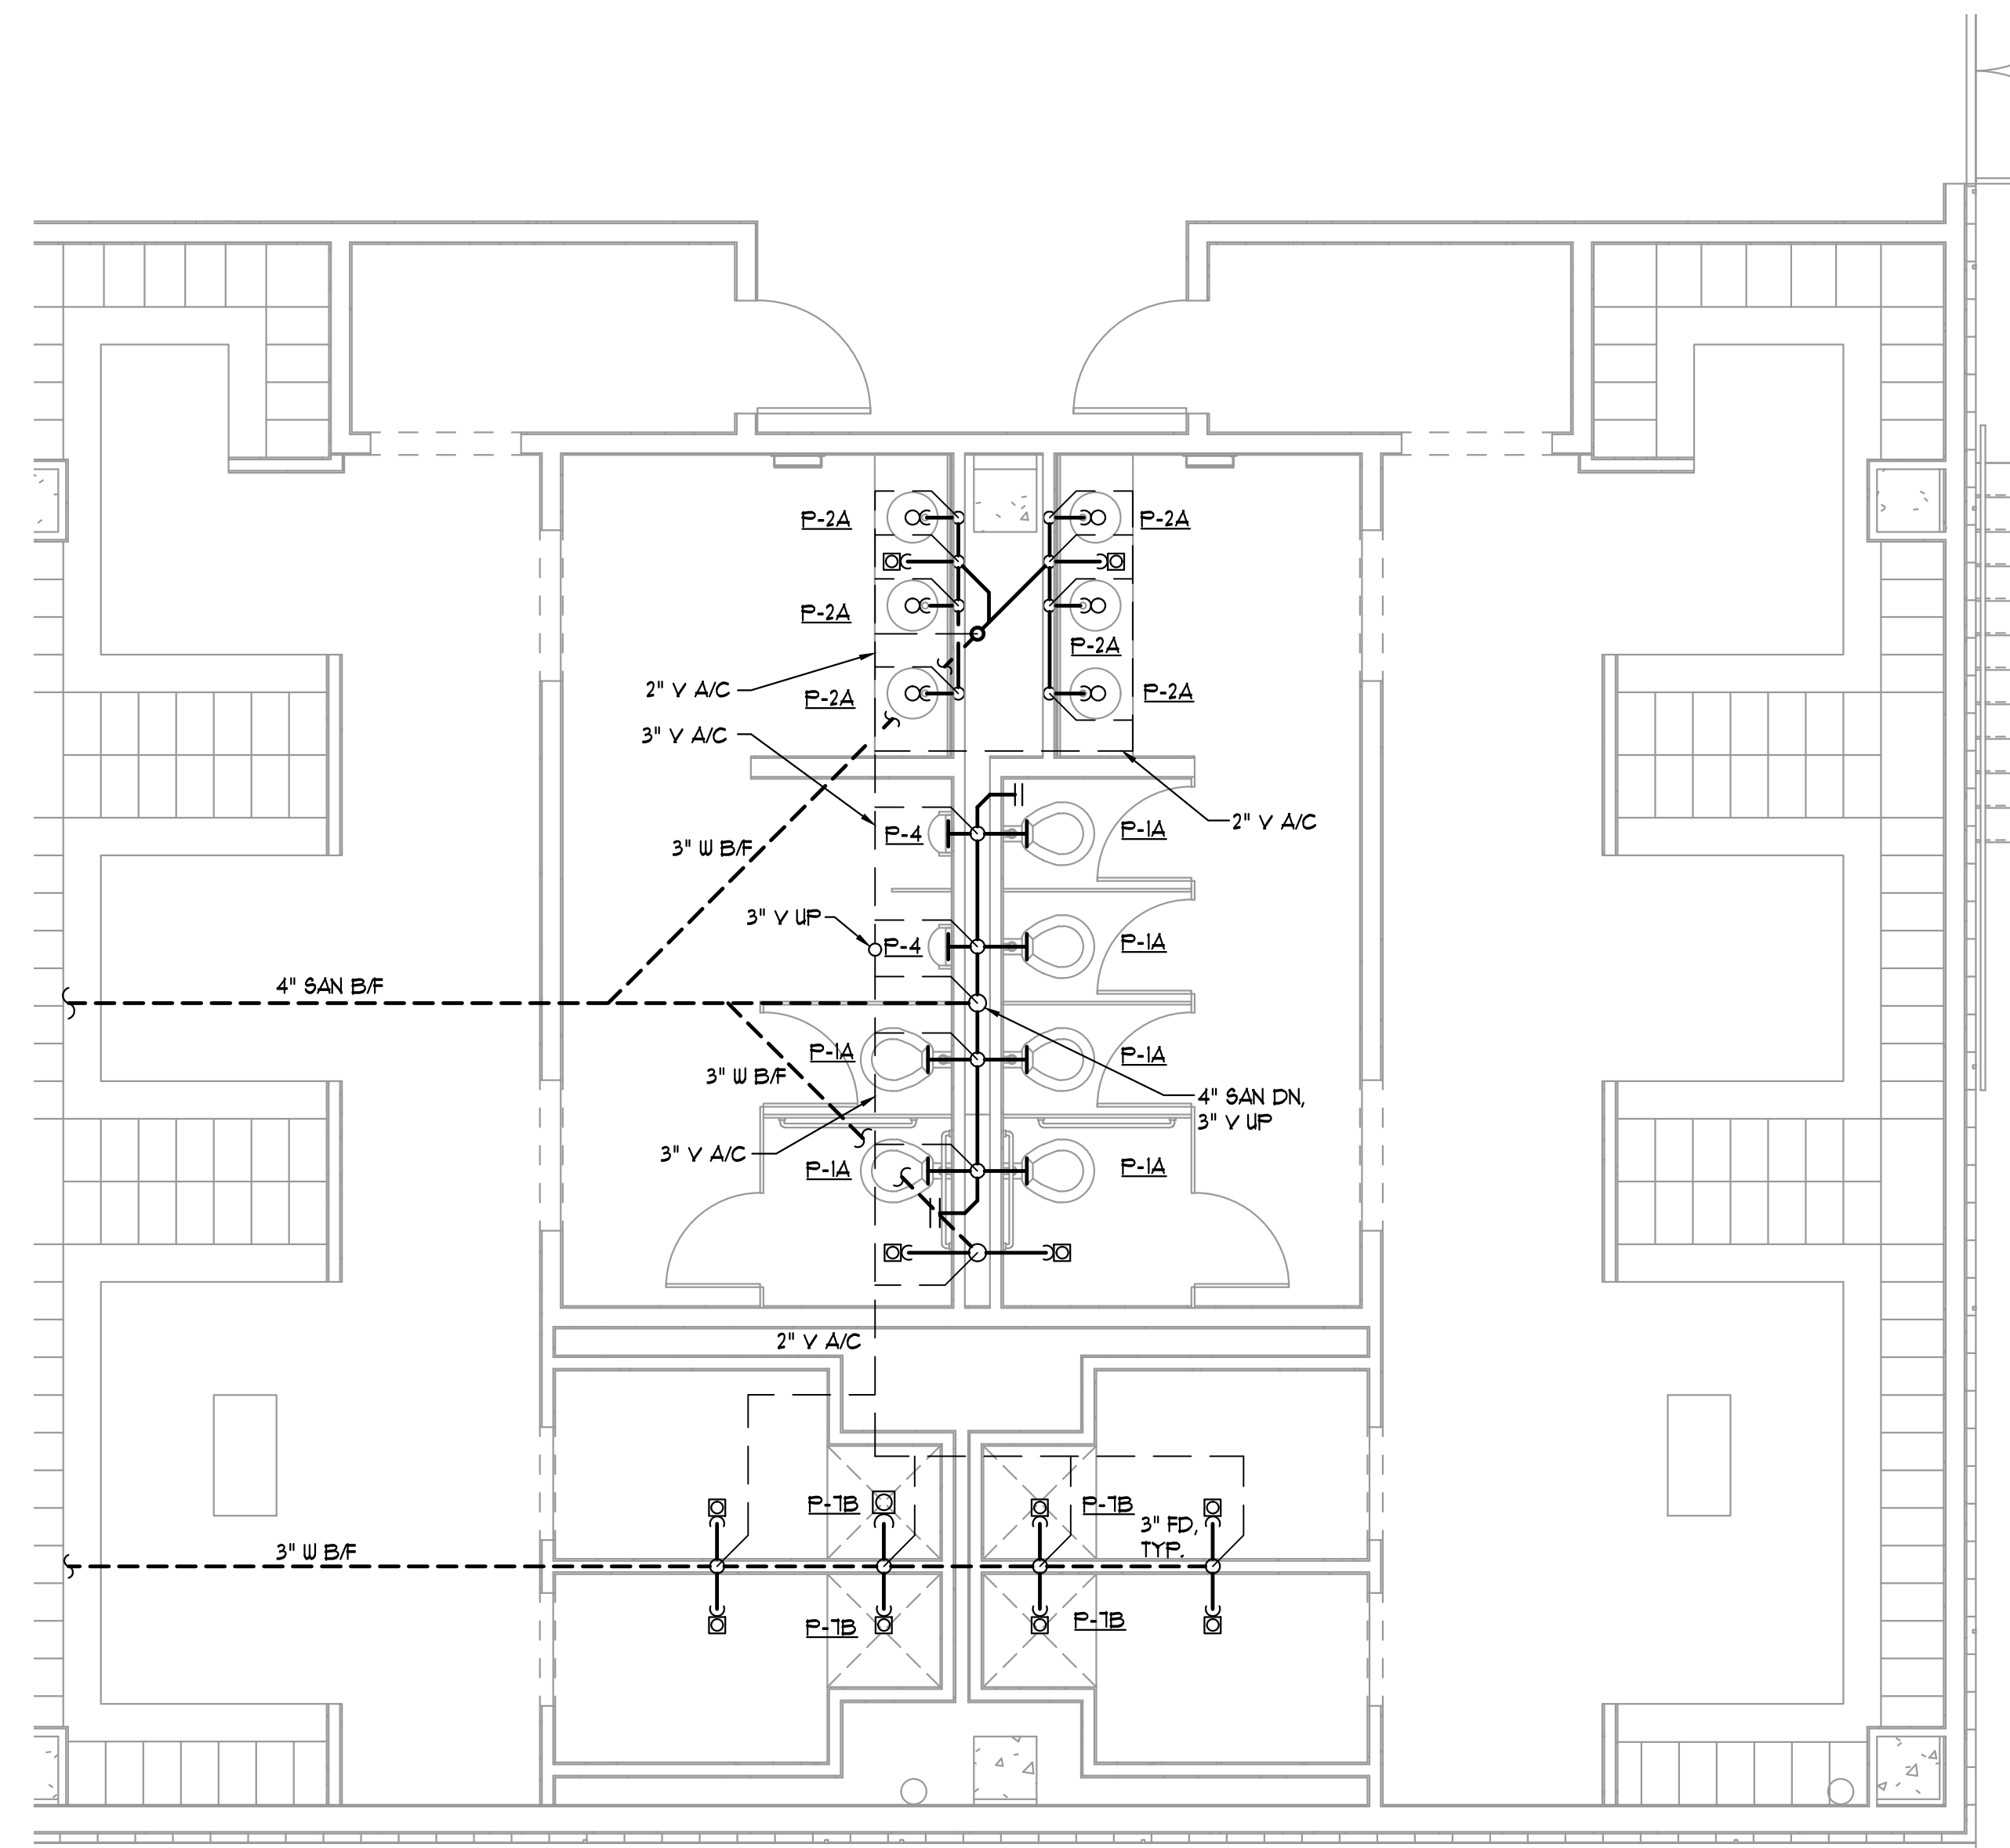

4 LEVEL 1 ZONE A LOCKERS — DOMESTIC WATER
P4.07 1/4" = 1'-0"

ALPHARETTA CONFERENCE CENTER & THE HOTEL AT AVALON


9000 AVALON BOULEVARD /
ALPHARETTA, GEORGIA 30009

STORMONT HOSPITALITY GROUP, LLC /
NORTH AMERICAN PROPERTY GROUP


LEVEL 1 PART PLANS - PLUMBING

K. PRICE	140028
Principal in Charge	BW&A Project No.
G. JENKINS	101716
Project Engineer	Date
T. MERCER	
Checker	


P4.07

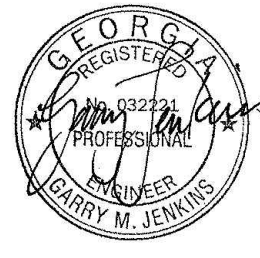

ISSUANCES		
No.	Drawing Issue Description	Date
1	BUILDING PERMIT	2016.10.17

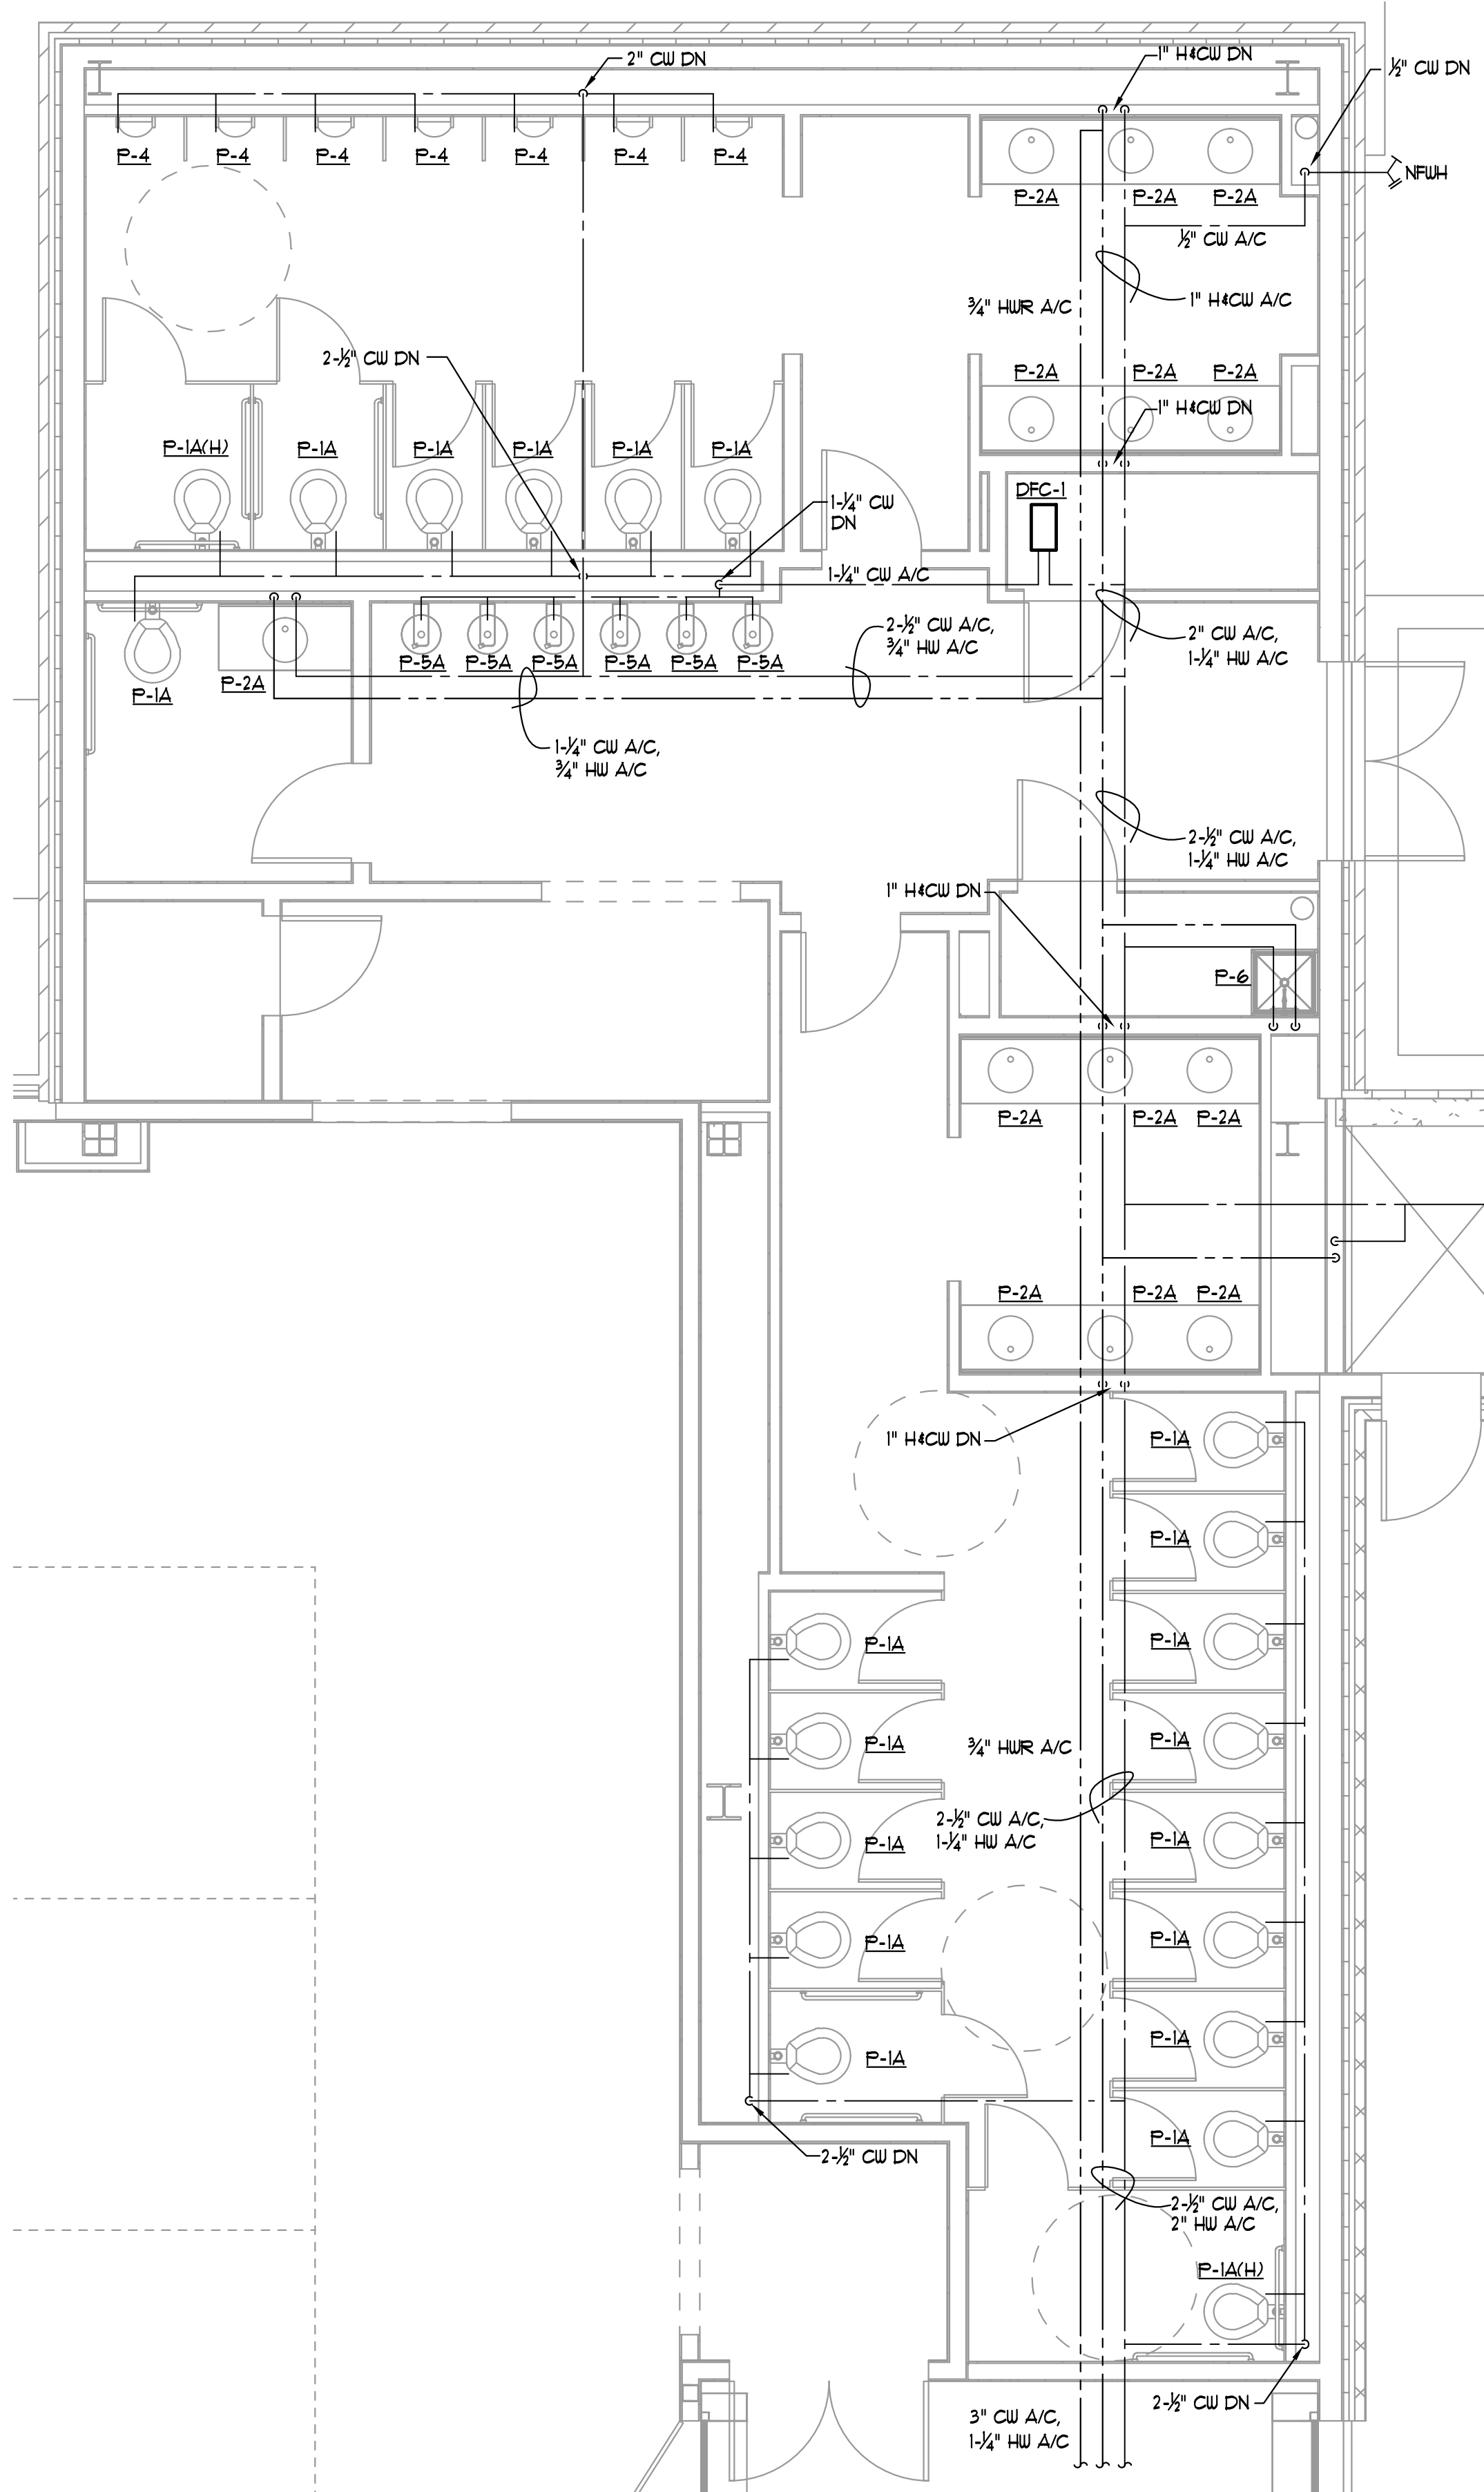

1
P4.08 LEVEL 1 ZONE B RESTROOMS — DOMESTIC WATER
1/4" = 1'-0"

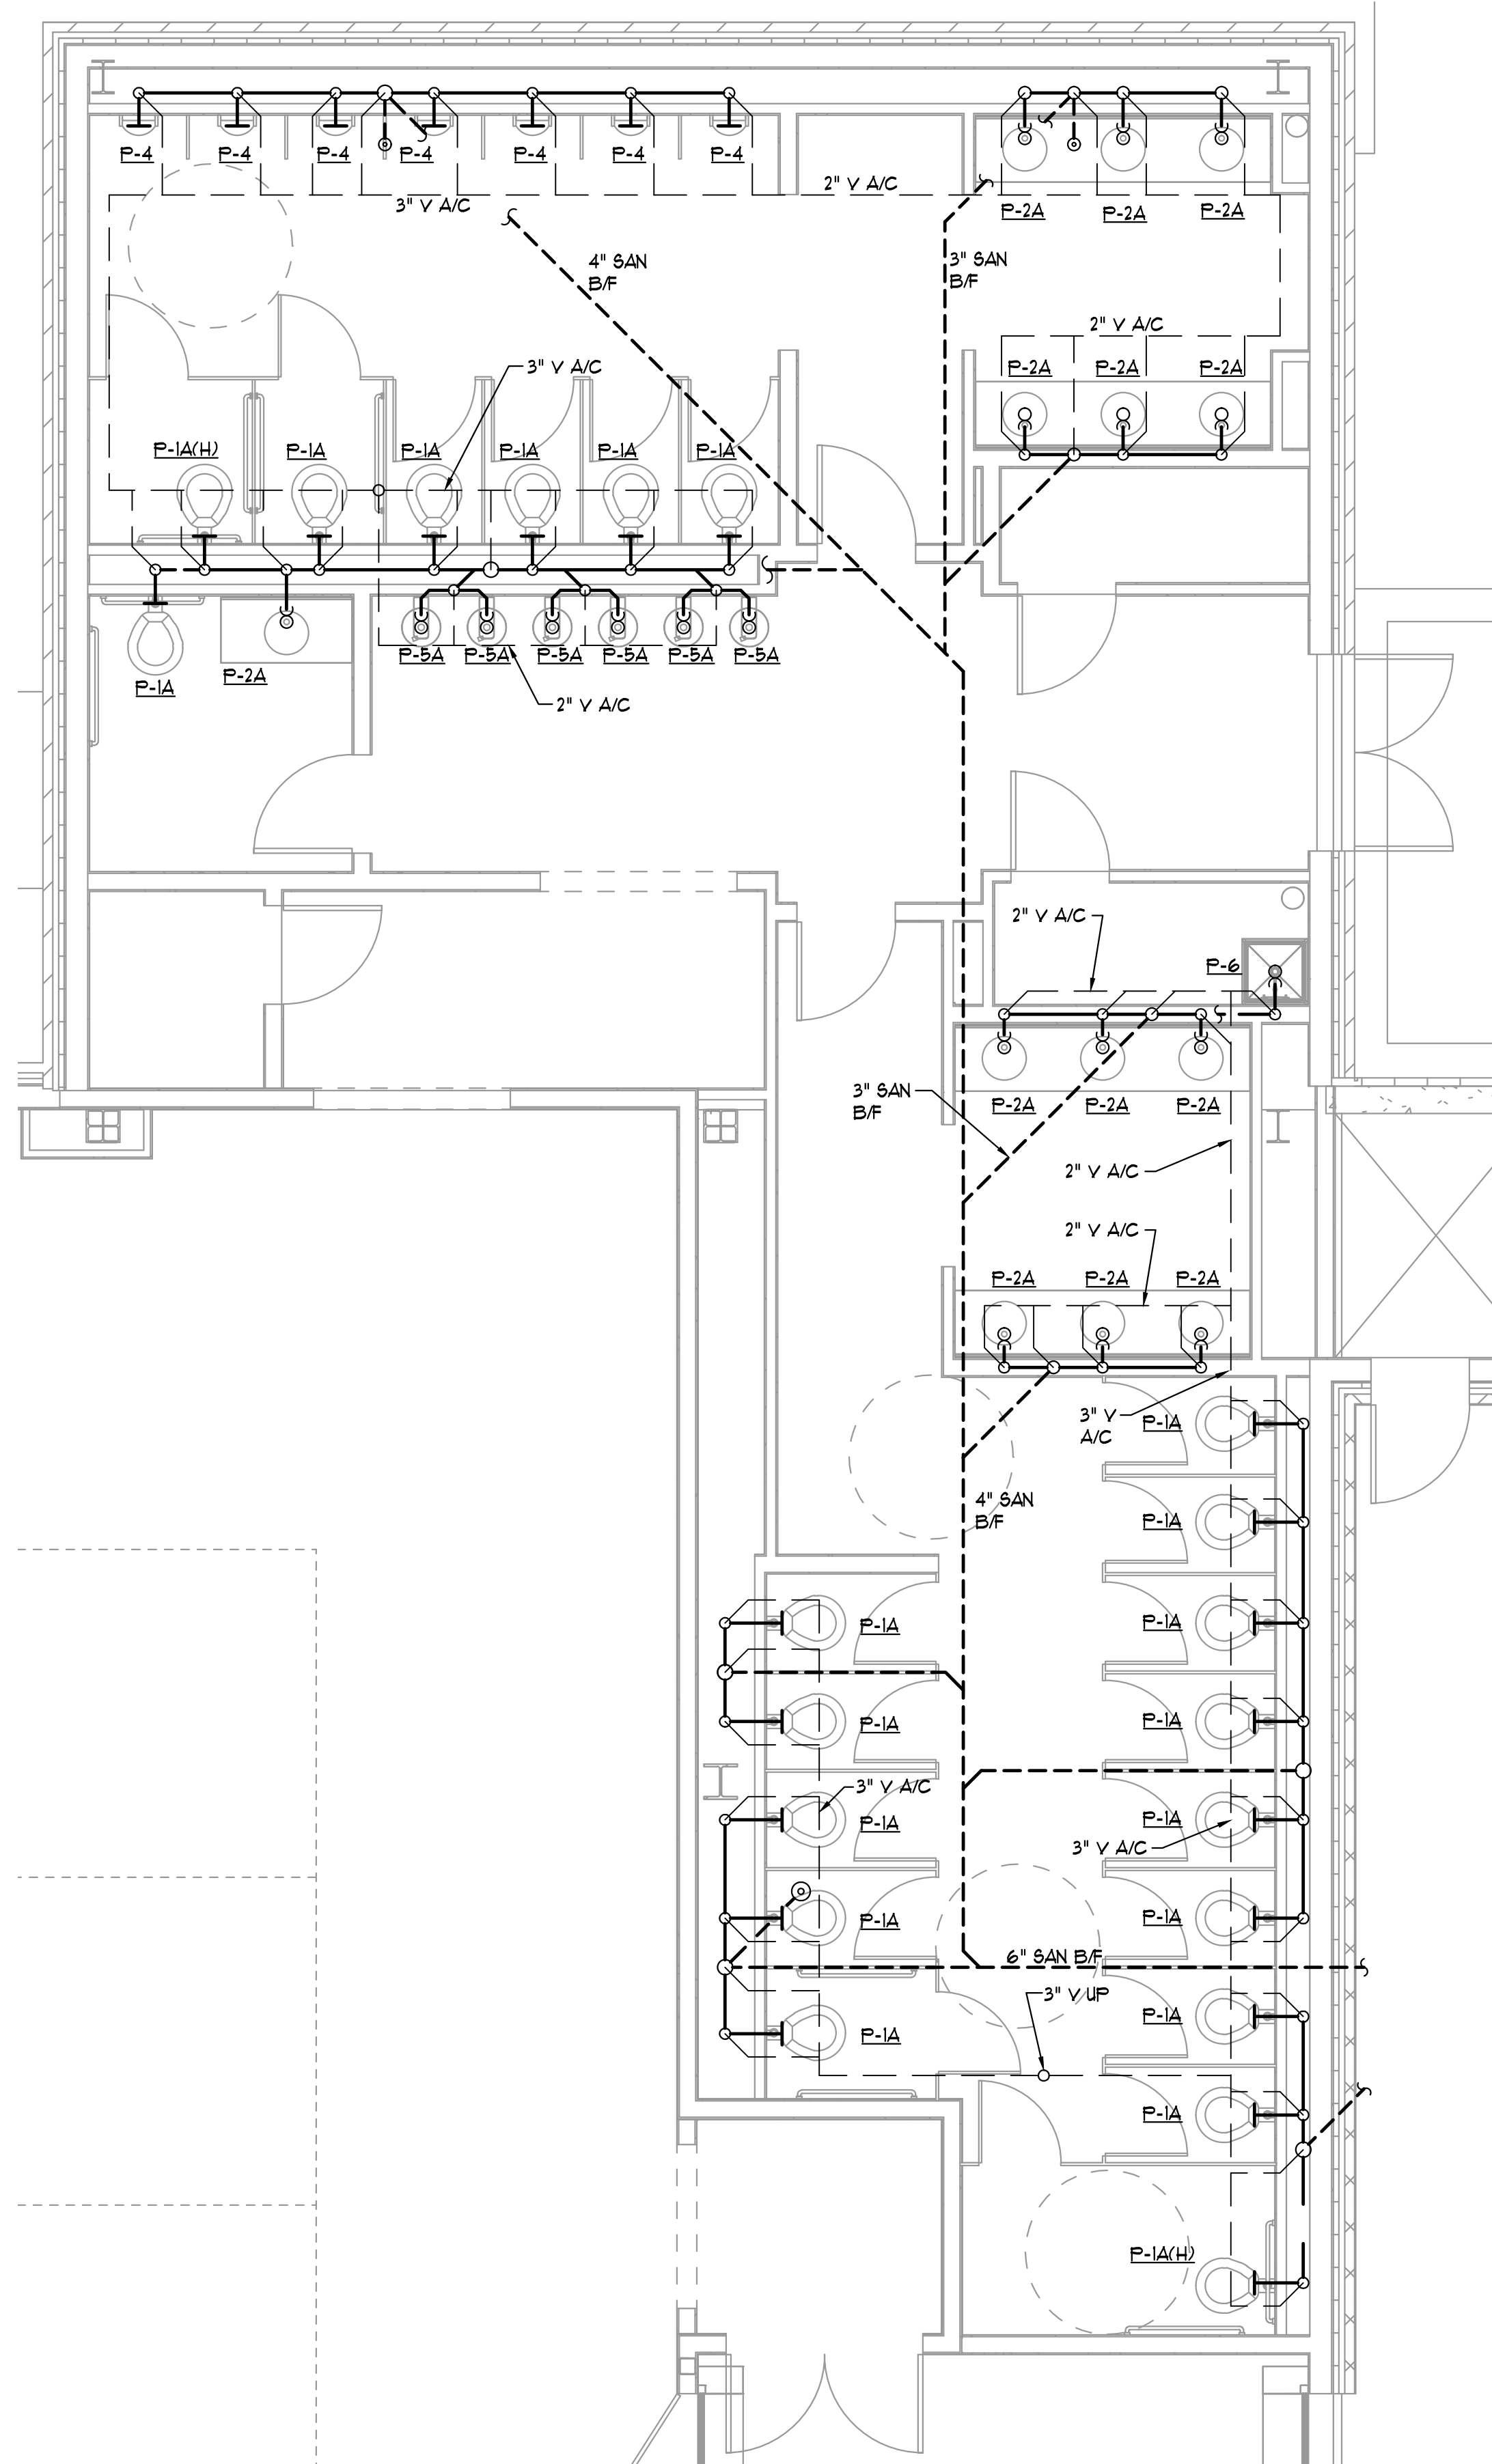

2
P4.08 LEVEL 1 ZONE B RESTROOMS — DOMESTIC WATER
1/4" = 1'-0"

ALPHARETTA CONFERENCE CENTER & THE HOTEL AT AVALON


9000 AVALON BOULEVARD /
ALPHARETTA, GEORGIA 30009

STORMONT HOSPITALITY GROUP, LLC /
NORTH AMERICAN PROPERTY GROUP


LEVEL 1 PART PLANS - PLUMBING

K. PRICE	140028
Principal in Charge	SH&A Project No.
G. JENKINS	101716
Project Engineer	Date
T. MERCER	
Owner's Rep.	


P4.08

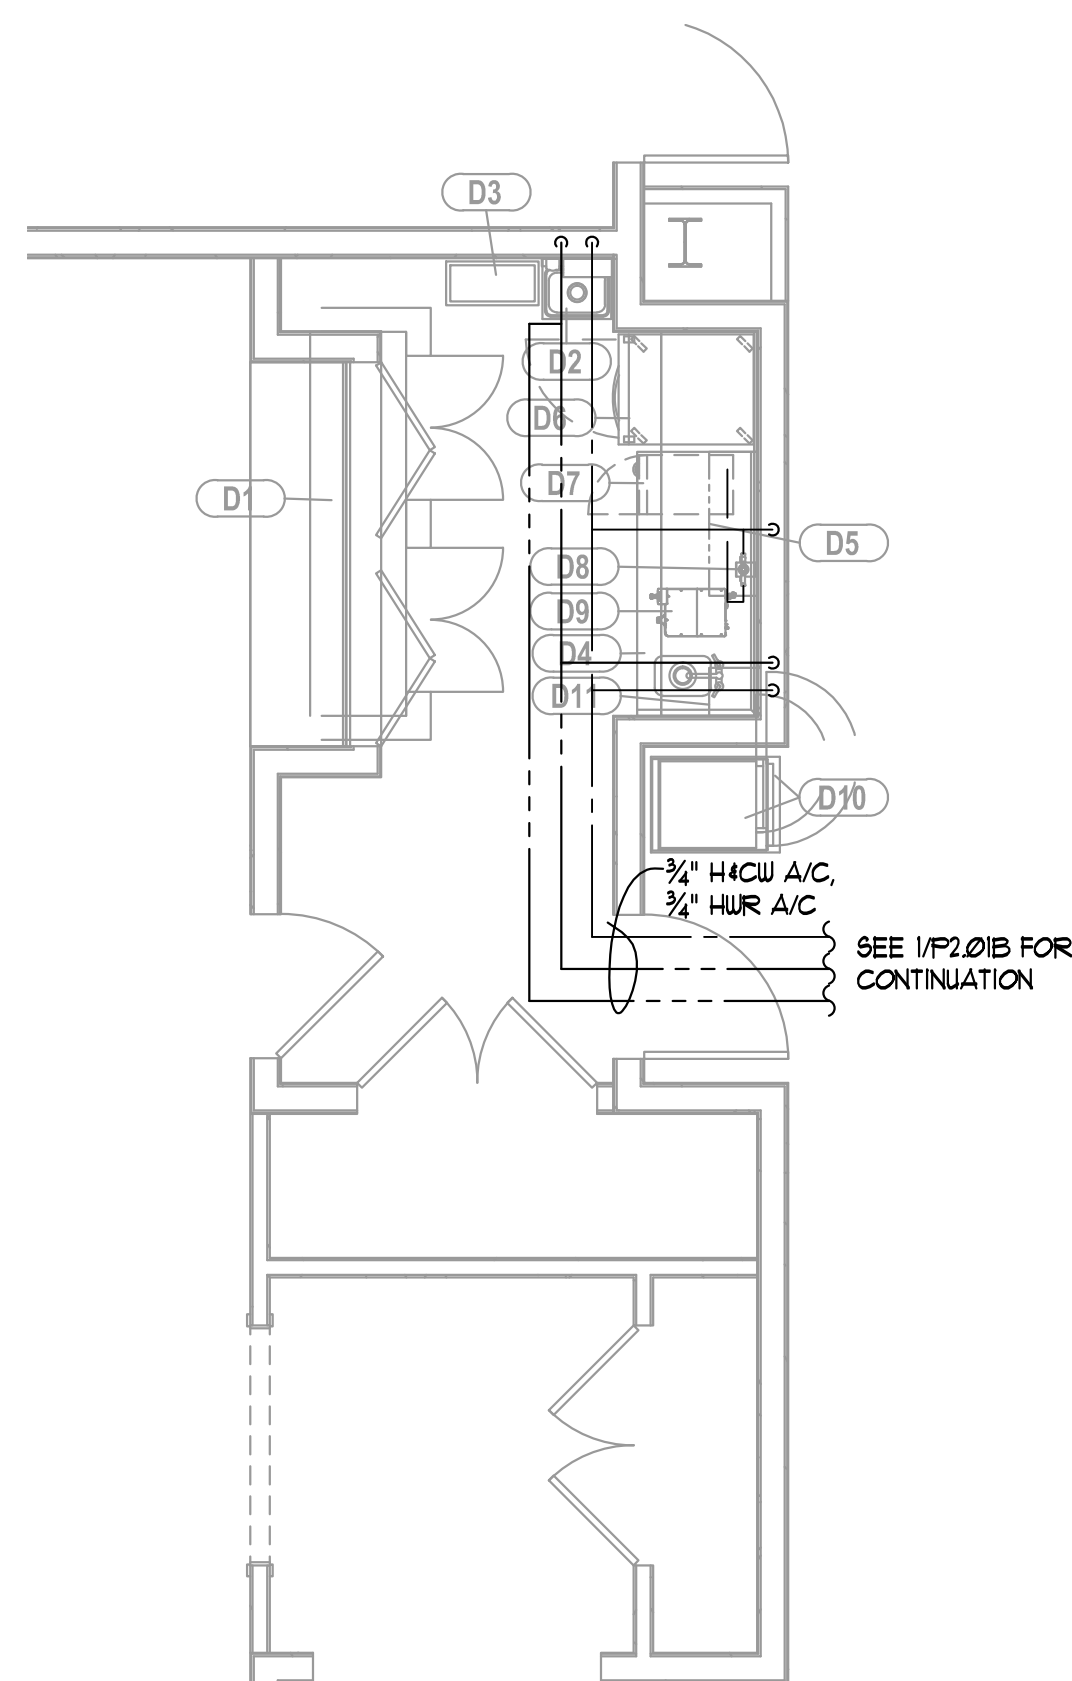


1 LEVEL 1 ZONE B SERVICE PANTRY — DOMESTIC WATER
P4.09 1/4" = 1'-0"

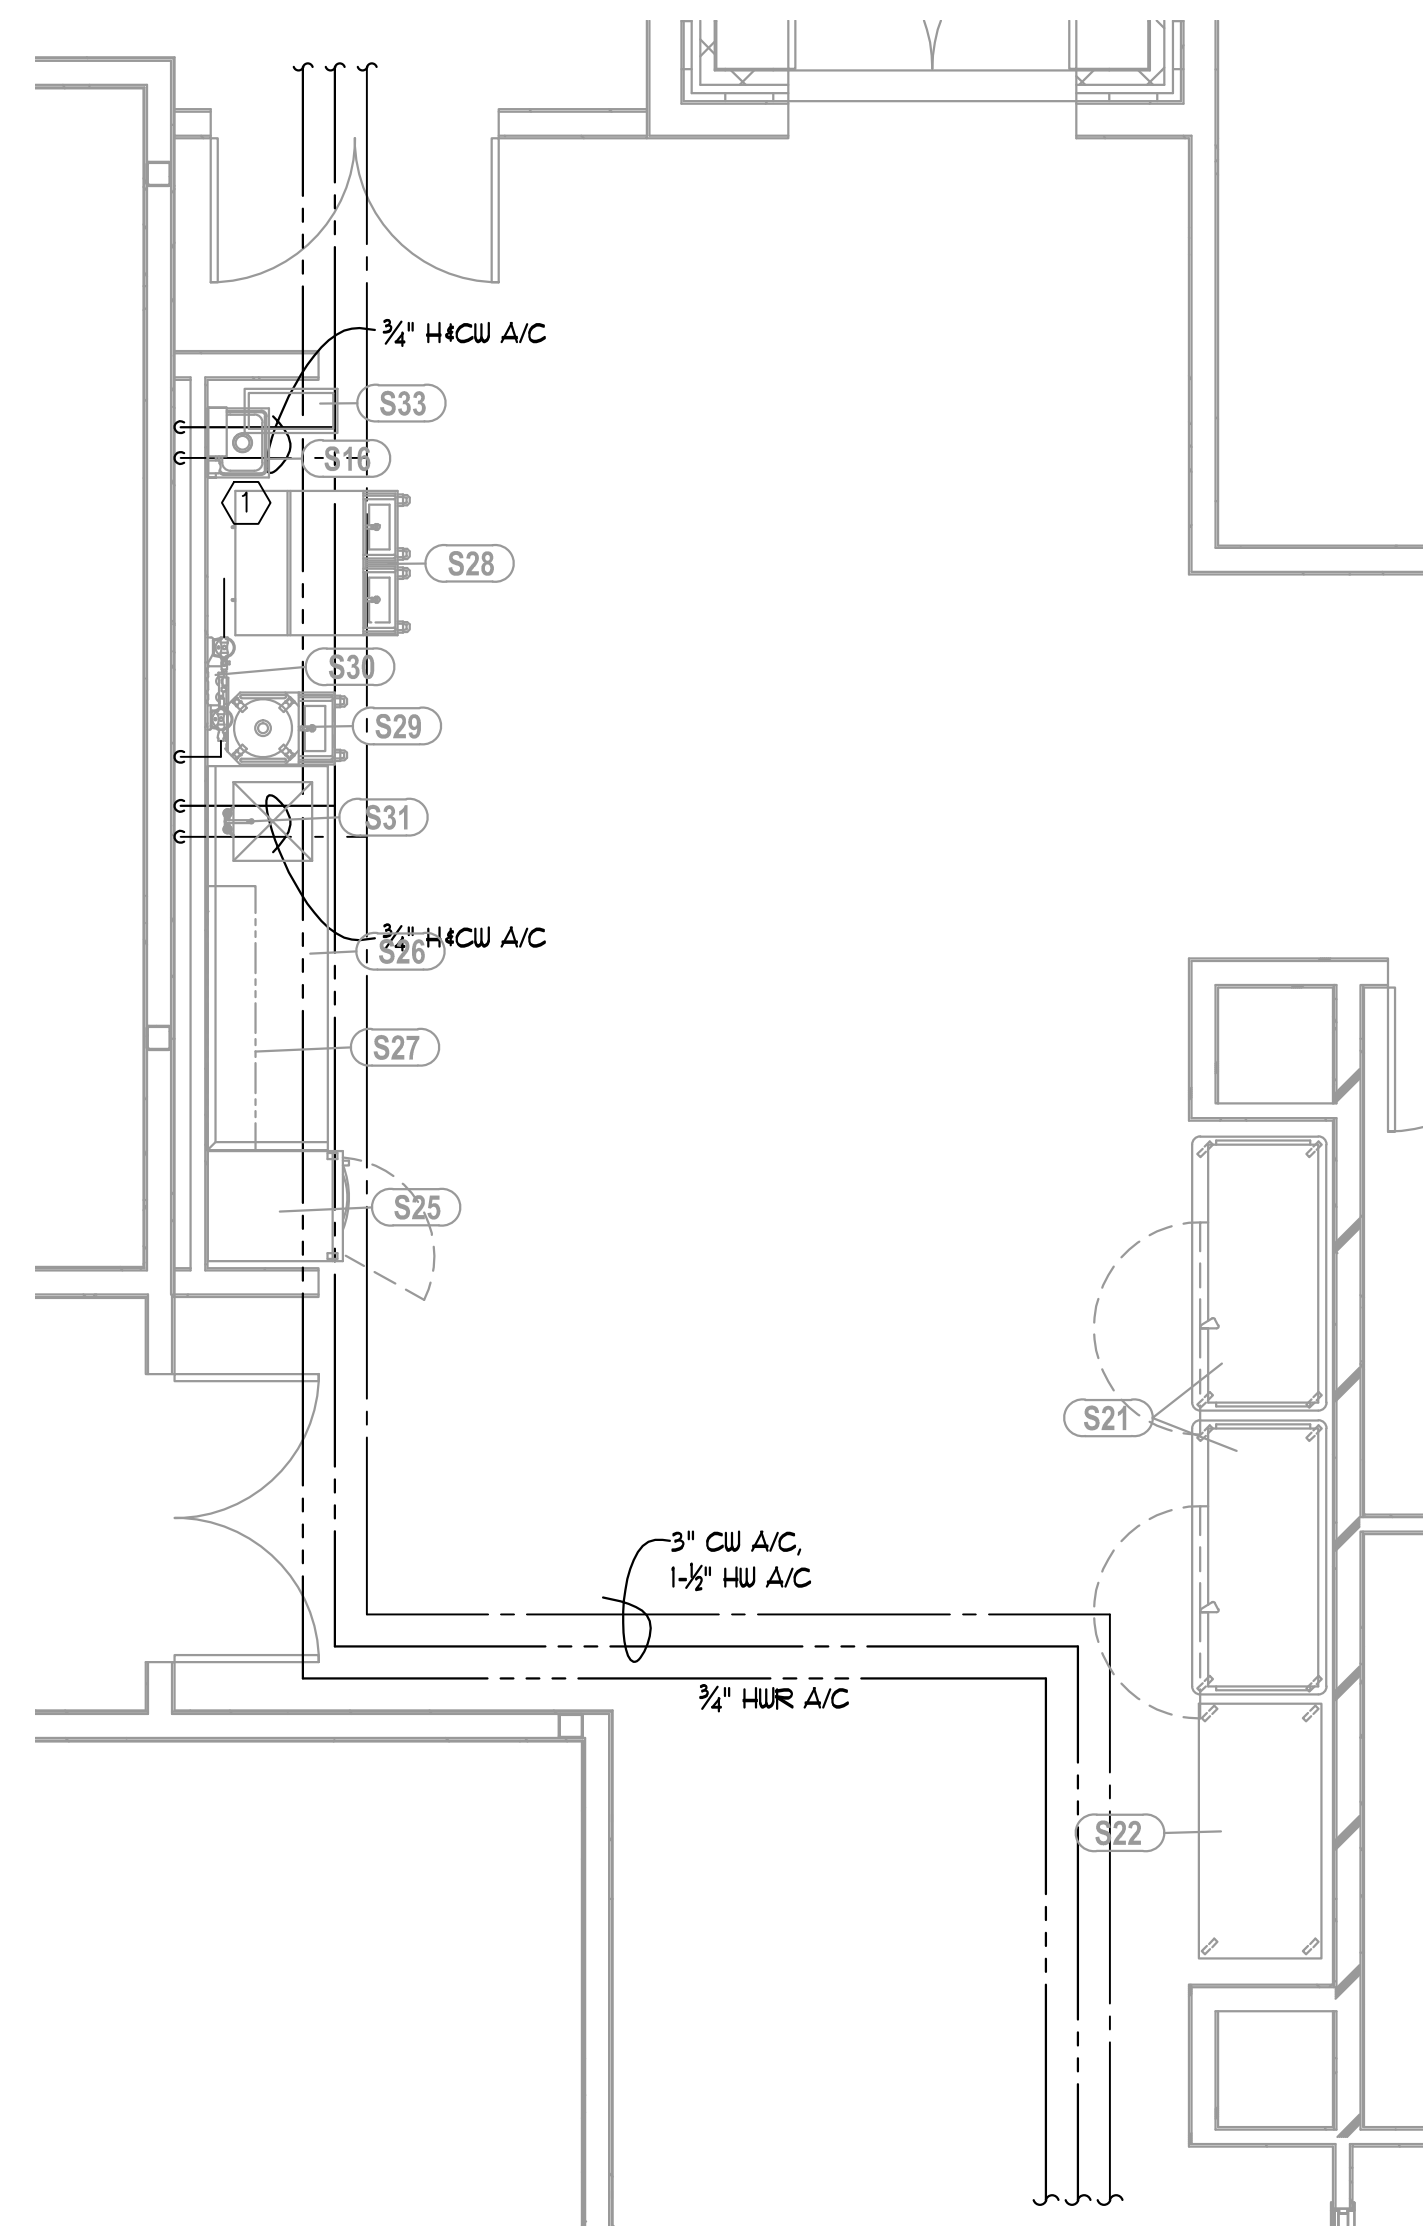


2 LEVEL 1 ZONE B BOH CORRIDOR — DOMESTIC WATER
P4.09 1/4" = 1'-0"

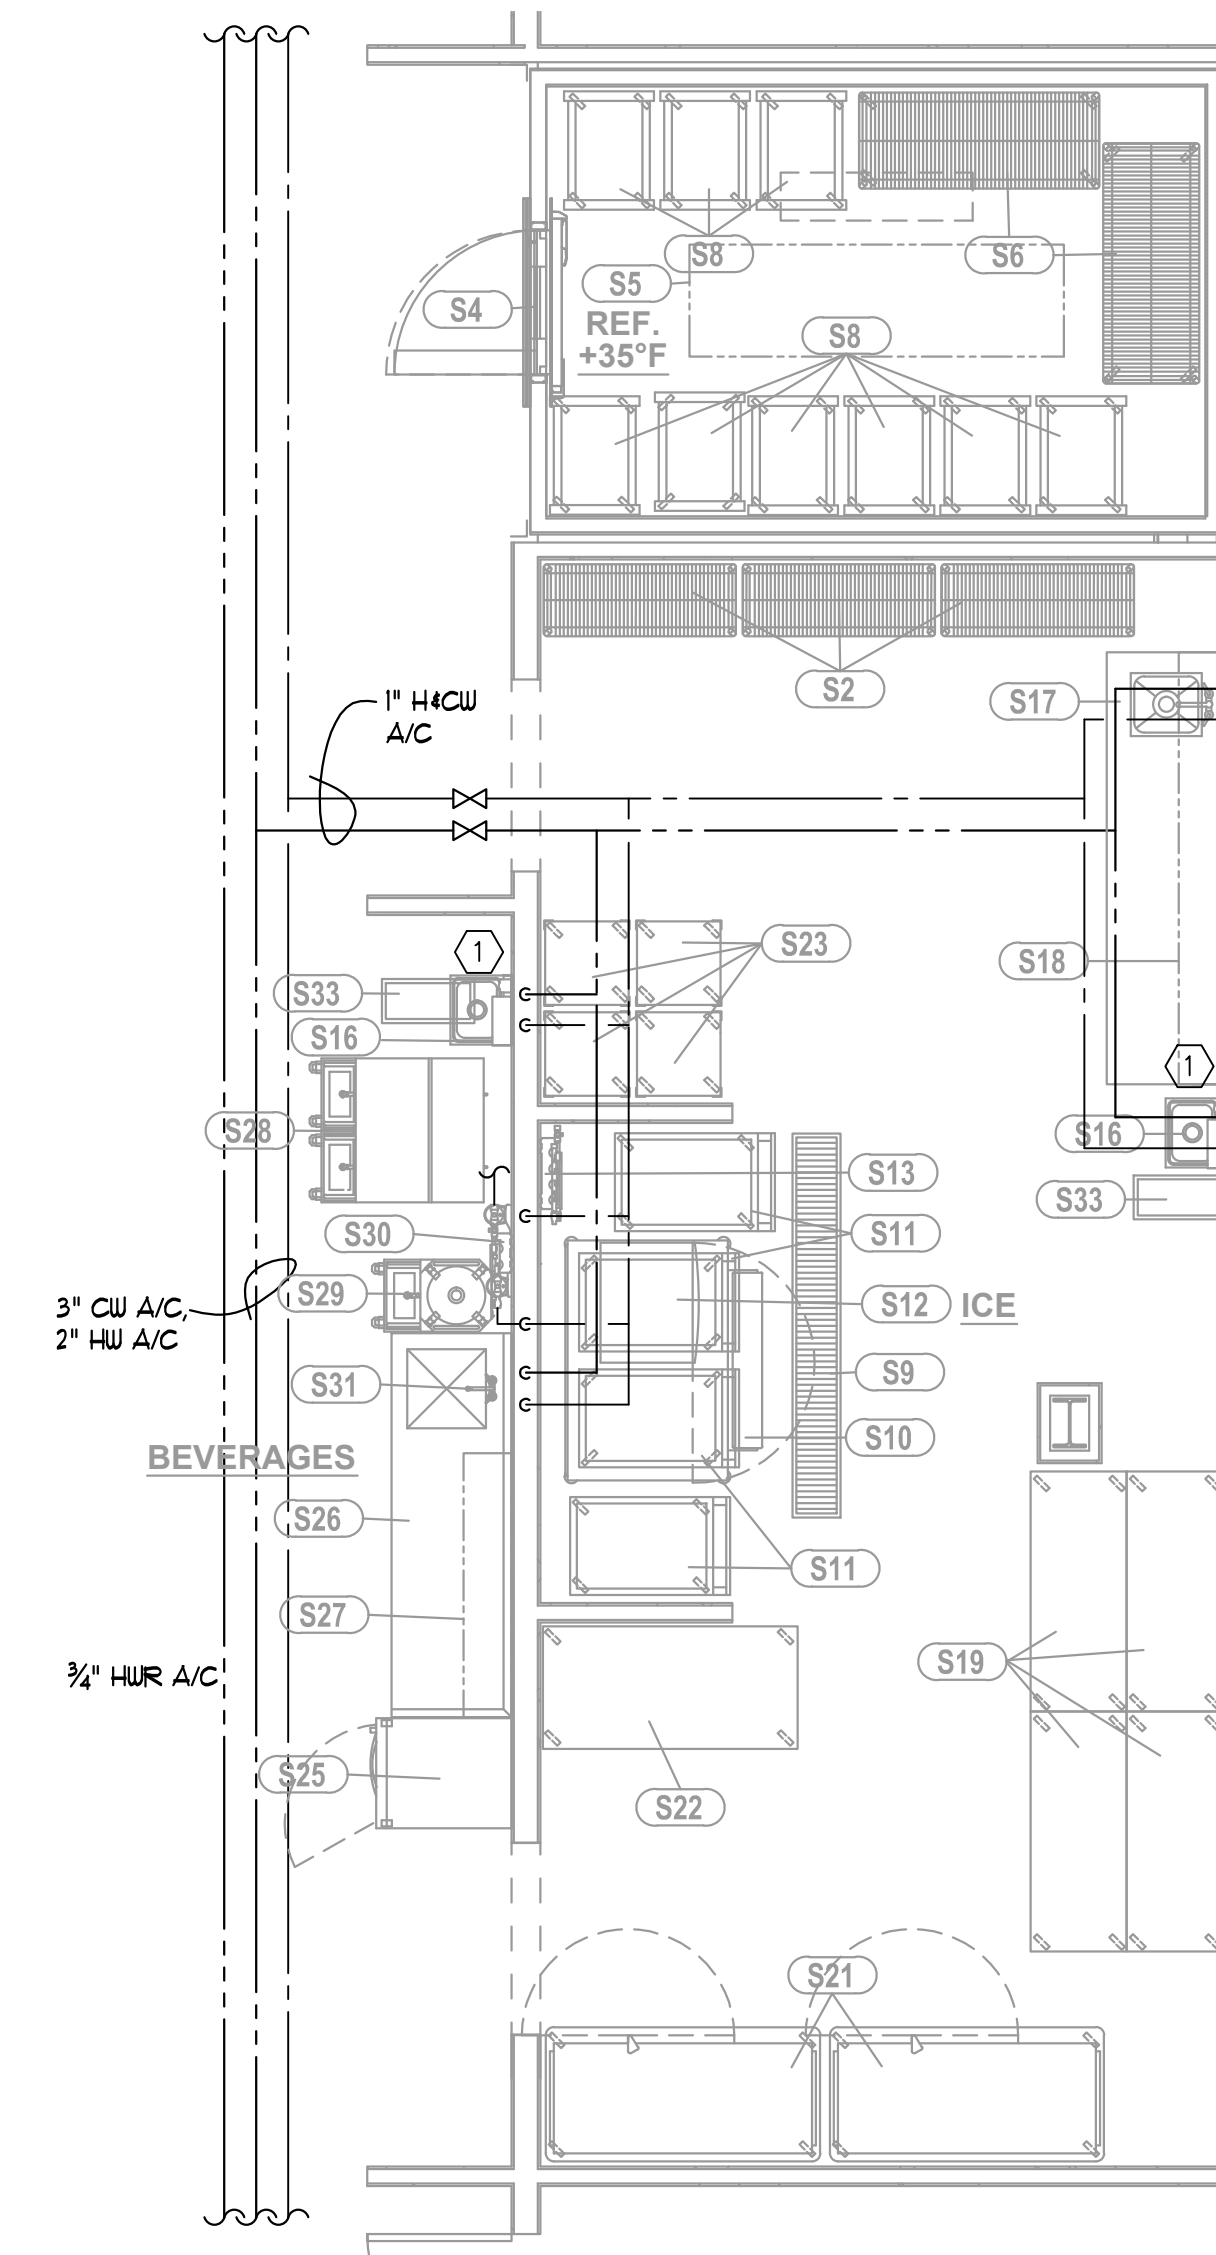


3 LEVEL 1 ZONE B WARMING KITCHEN — DOMESTIC WATER
P4.09 1/4" = 1'-0"

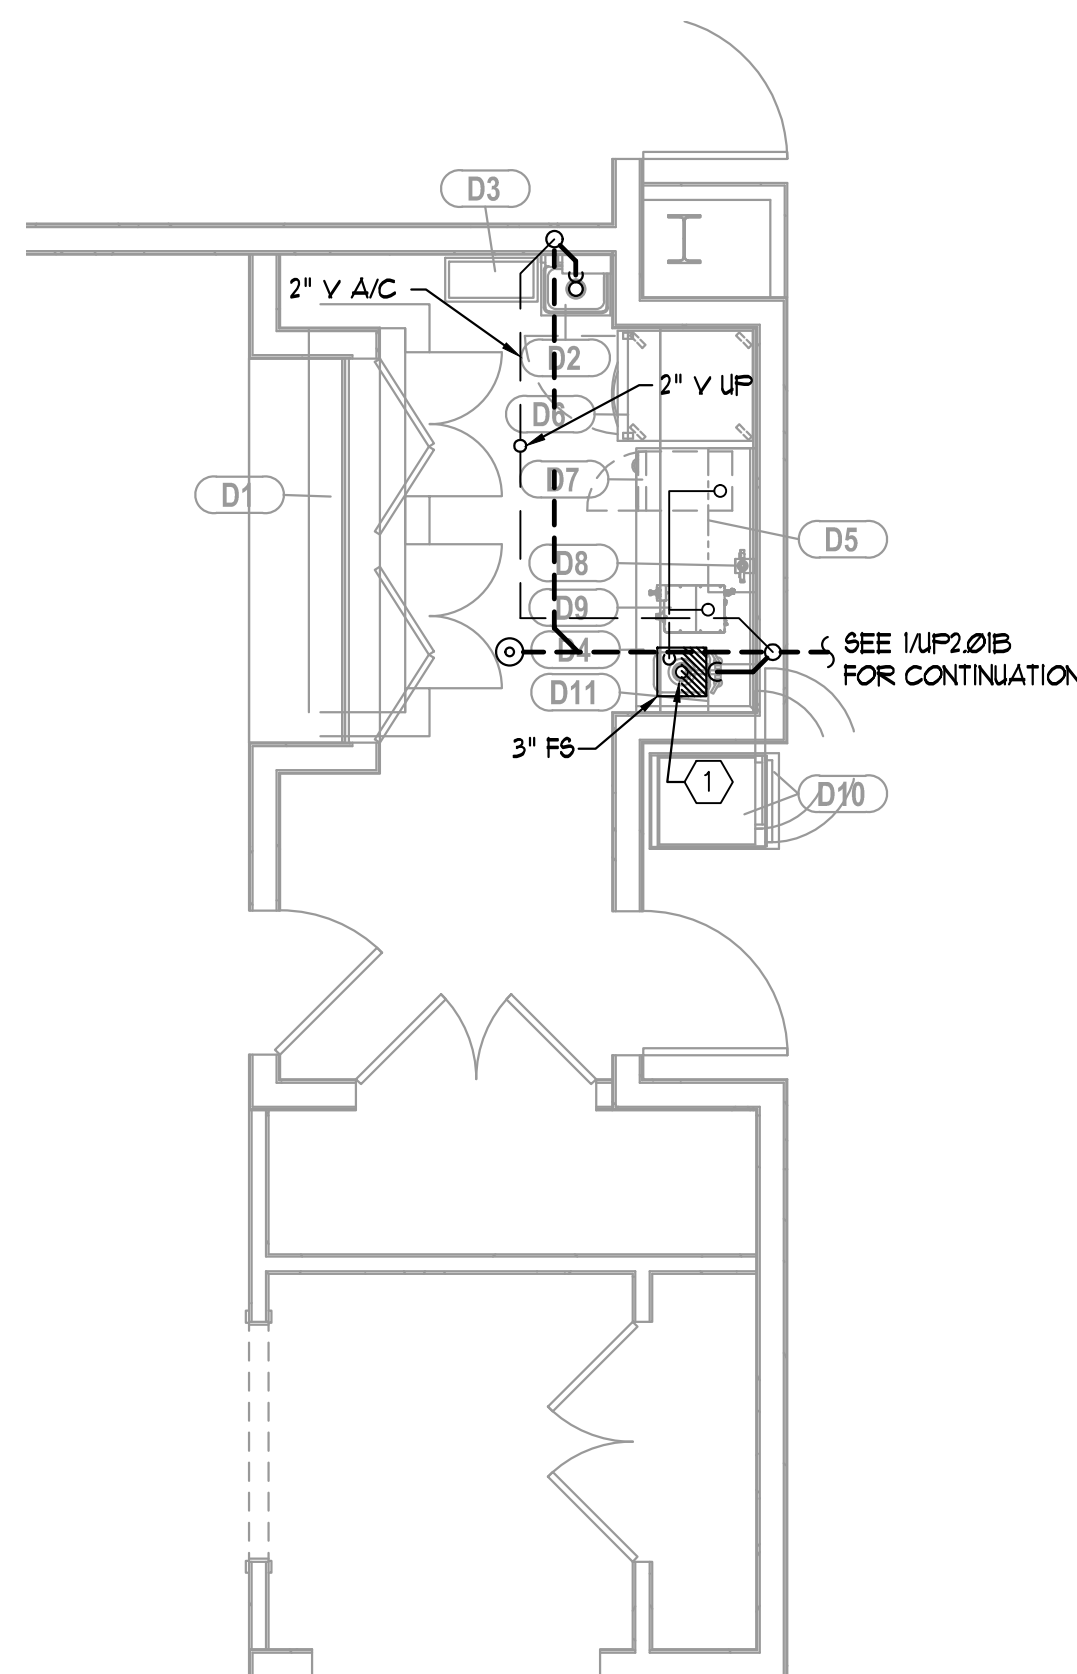

4 LEVEL 1 ZONE B SERVICE PANTRY — SANITARY & VENT
P4.09 1/4" = 1'-0"

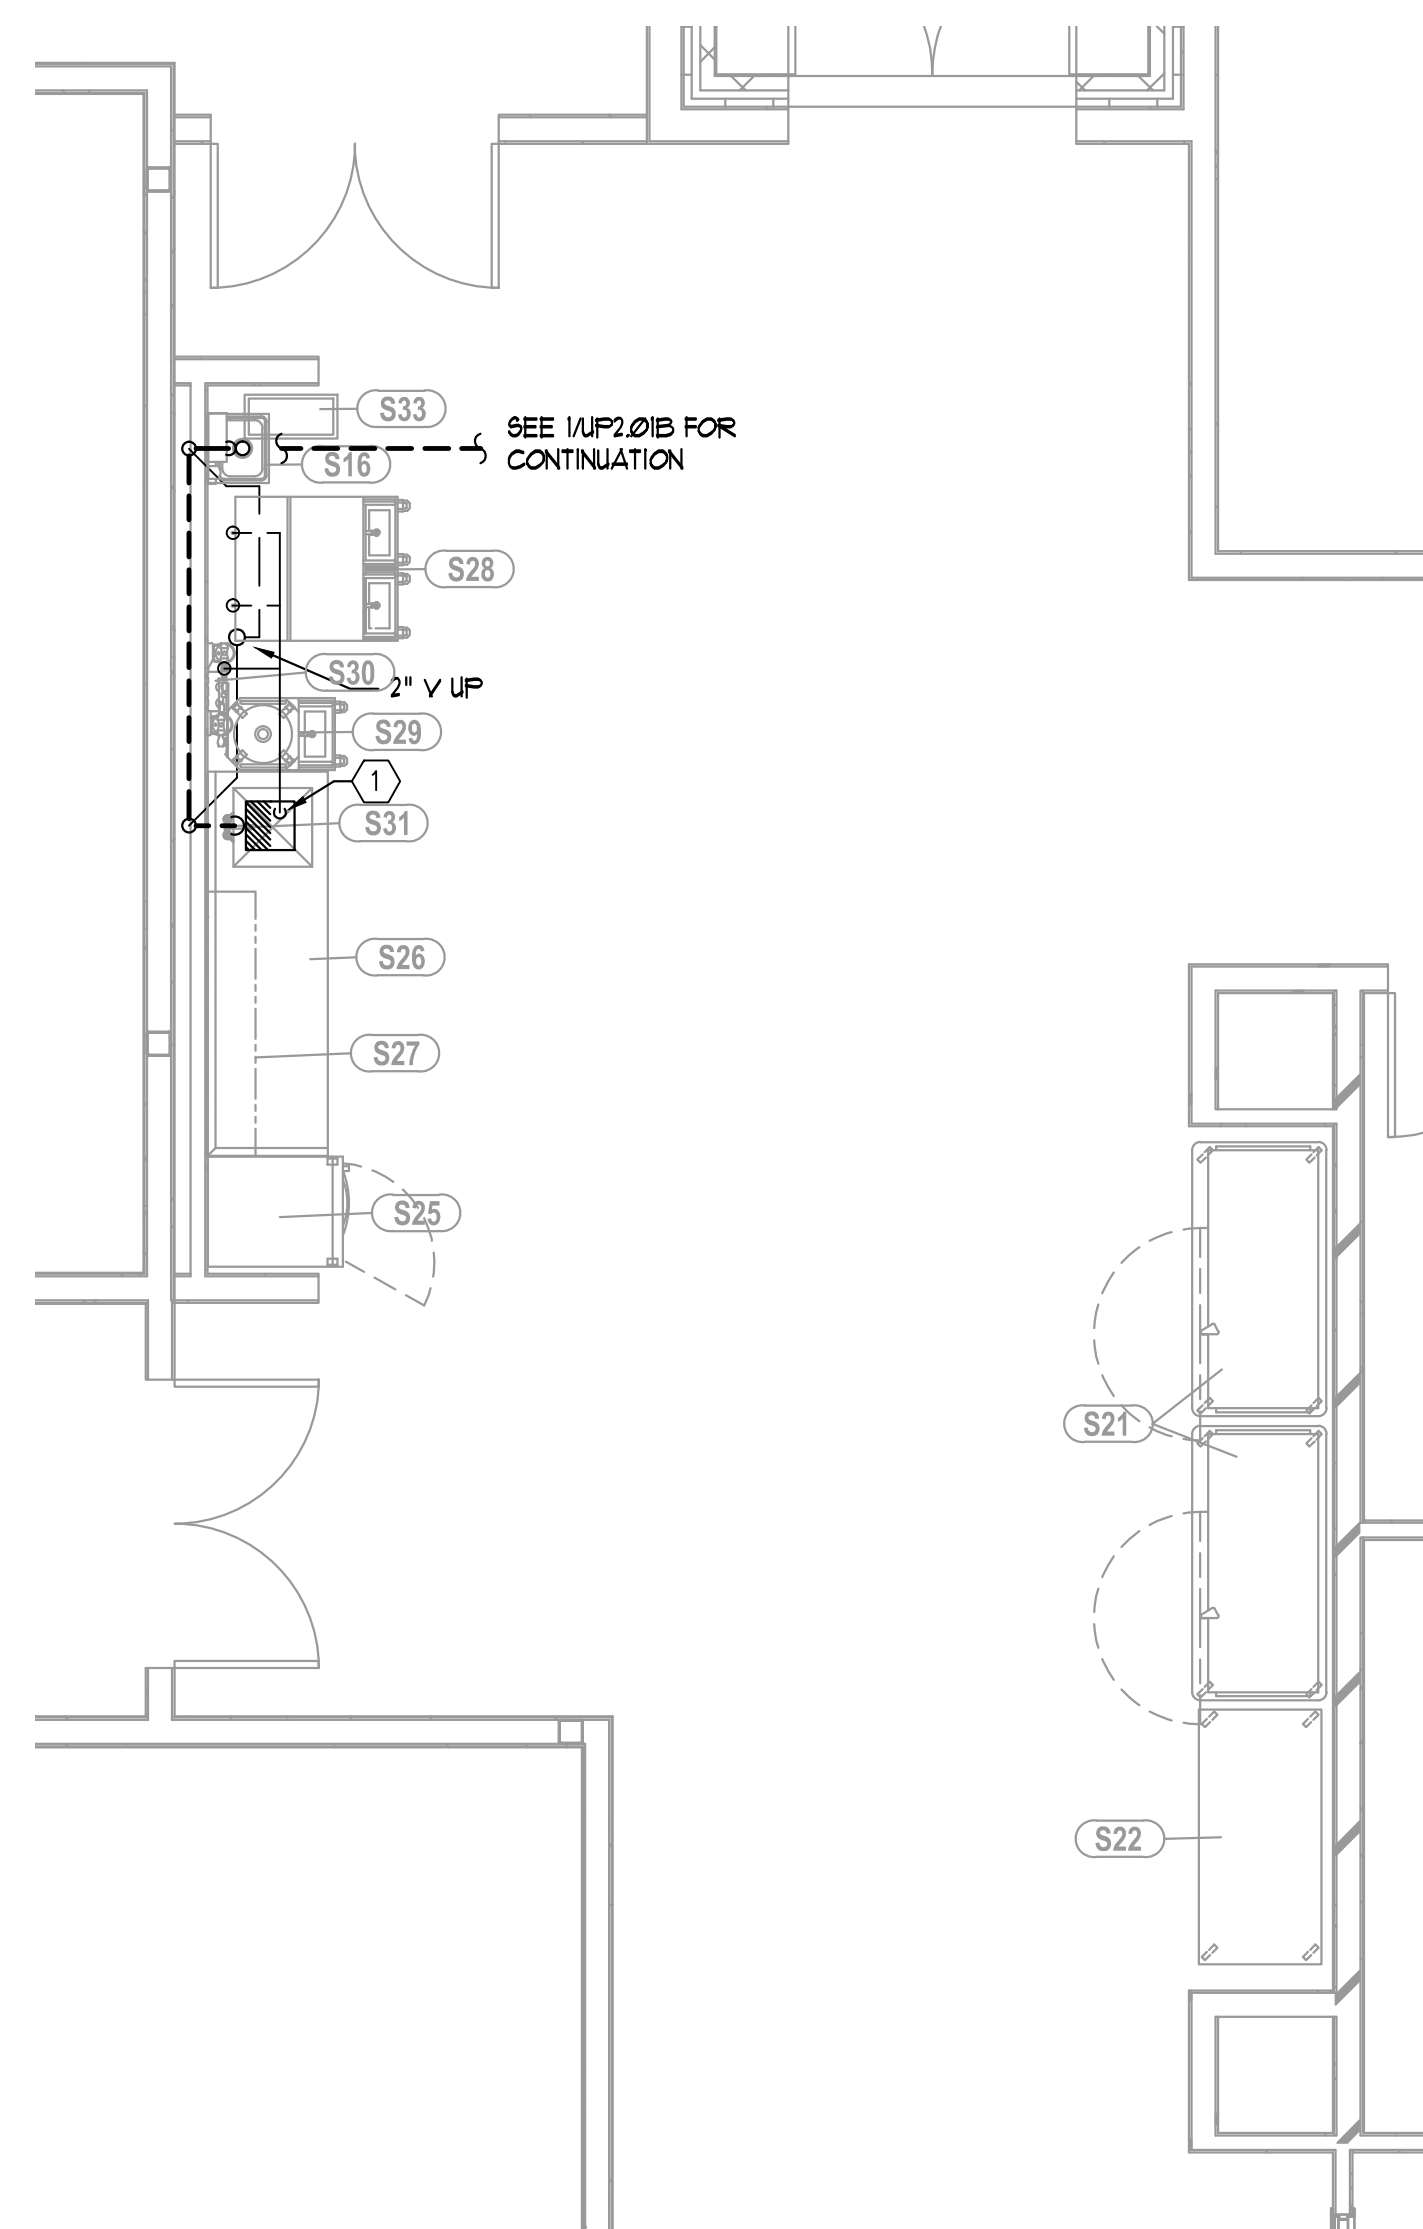


5 LEVEL 1 ZONE B BOH CORRIDOR — SANITARY & VENT
P4.09 1/4" = 1'-0"

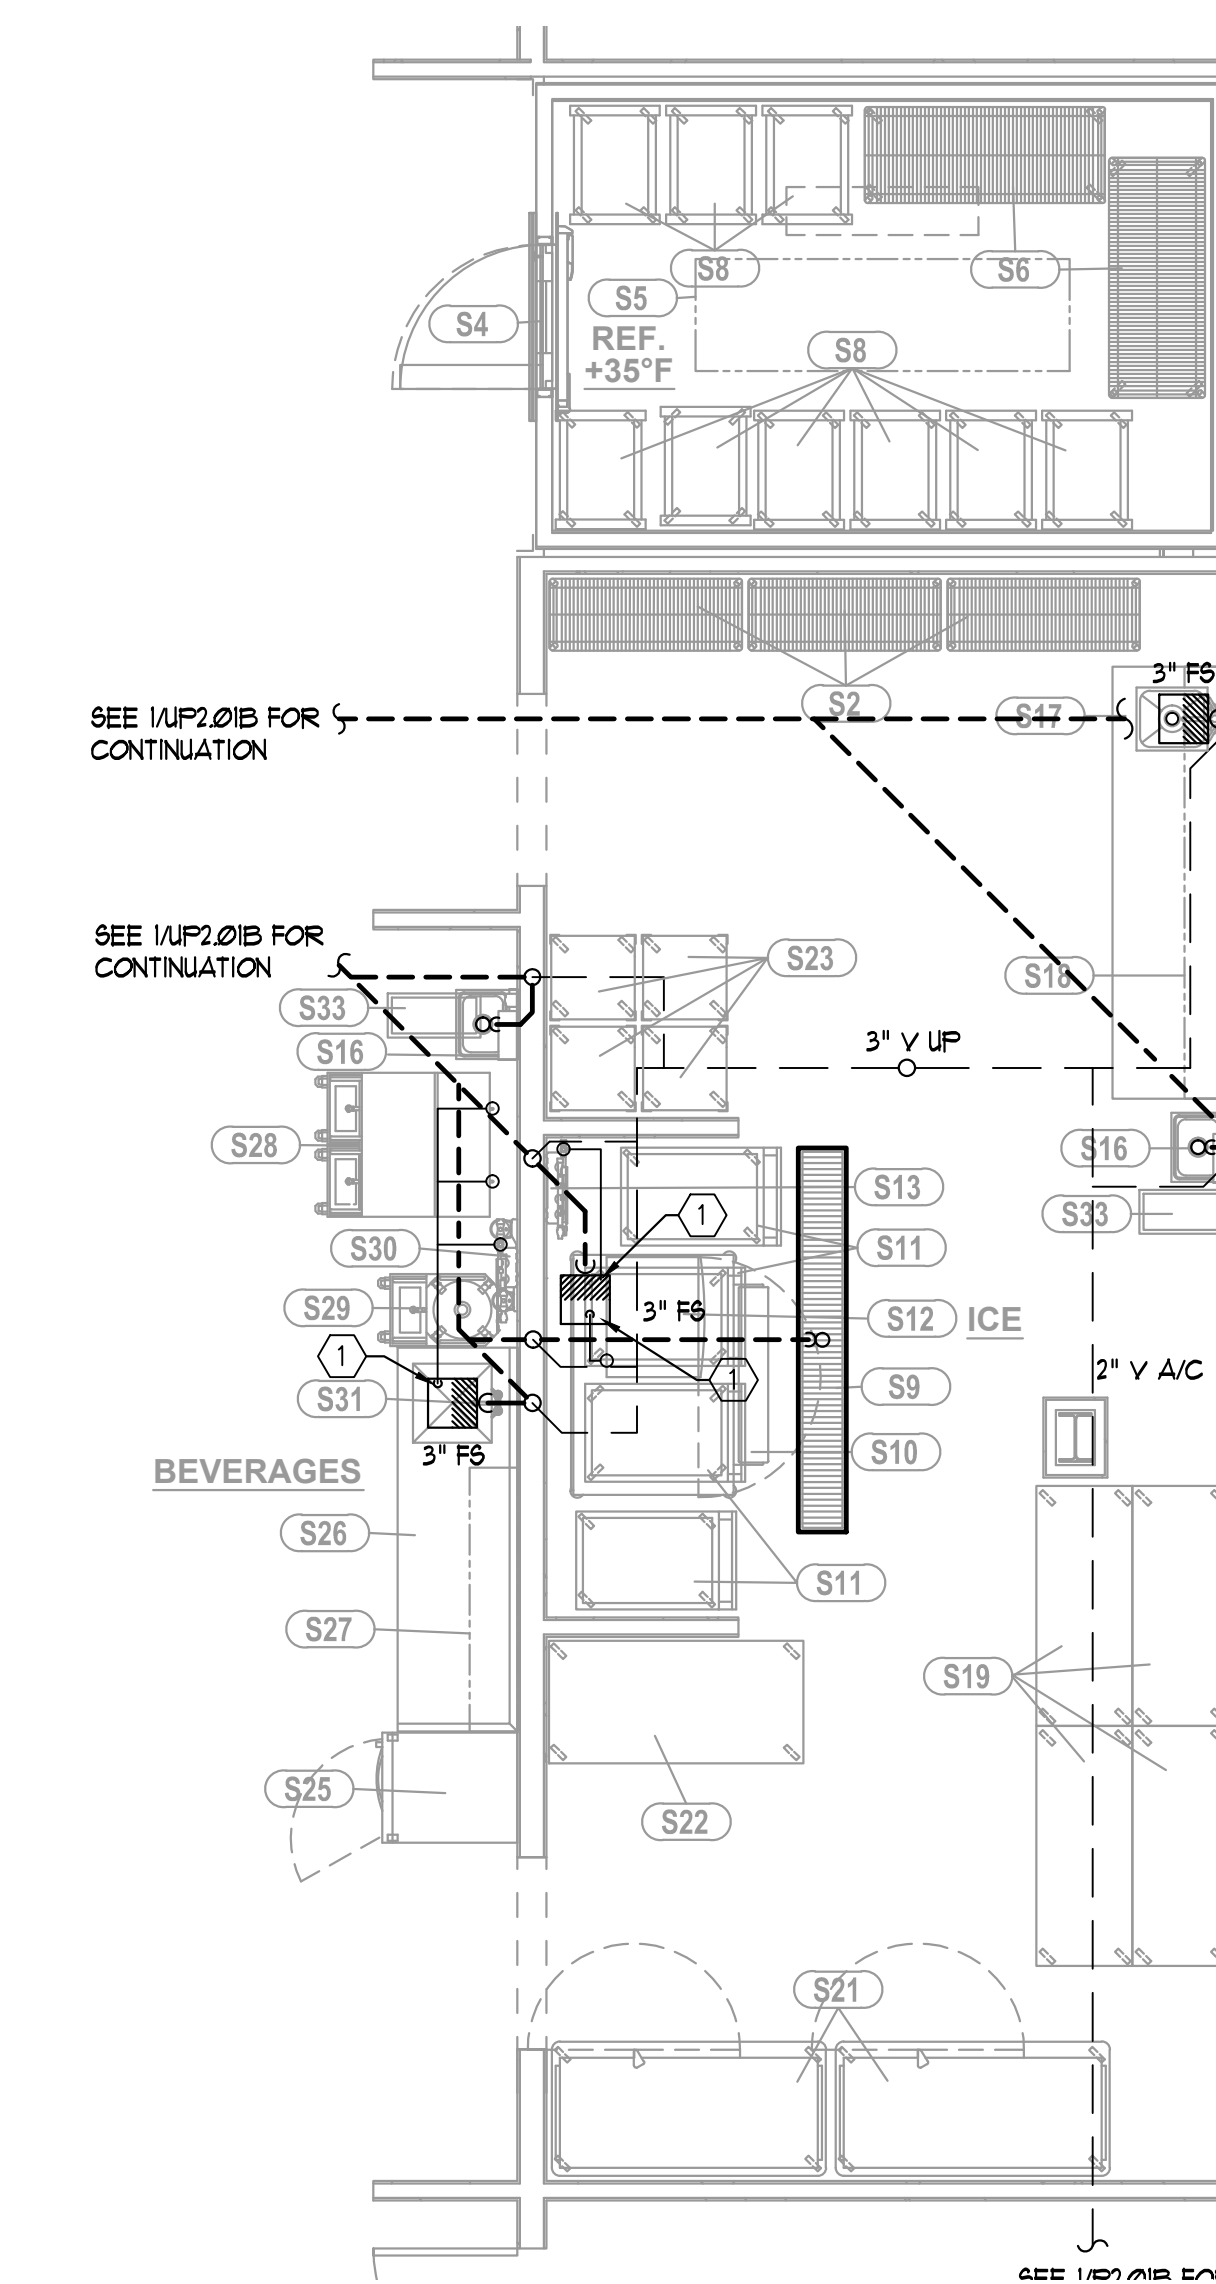

6 LEVEL 1 ZONE B WARMING KITCHEN — SANITARY & VENT
P4.09 1/4" = 1'-0"


- GENERAL NOTES
(APPLY THIS SHEET ONLY)
- REFER TO FIXTURE CONNECTION SCHEDULE AND APPROPRIATE DETAILS/RISEIS FOR PIPING SIZES.
 - REFER TO THE ARCHITECTURAL AND KITCHEN CONSULTANT PLANS FOR LOCATIONS OF ALL FIXTURES AND EQUIPMENT. PROVIDE ALL FINAL CONNECTIONS PER KITCHEN CONSULTANT SCHEDULES.
 - PROVIDE BACKFLOW PREVENTERS AT ALL EQUIPMENT CONNECTIONS.
 - LOCATE ALL VALVES IN ACCESSIBLE LOCATIONS.
- KEY NOTES
- ROUTE INDIRECT WASTE PIPE TO FLOOR SINK. SIZE PER KITCHEN CONSULTANT EQUIPMENT SCHEDULE.

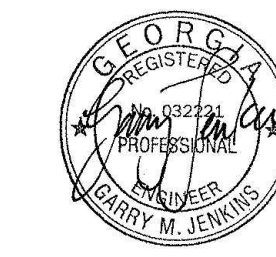


ISSUANCES		
No.	Drawing Issue Description	Date
1	BUILDING PERMIT	2016.10.17




ISSUANCES		
No.	Drawing Issue Description	Date
1	BUILDING PERMIT	2016.10.17

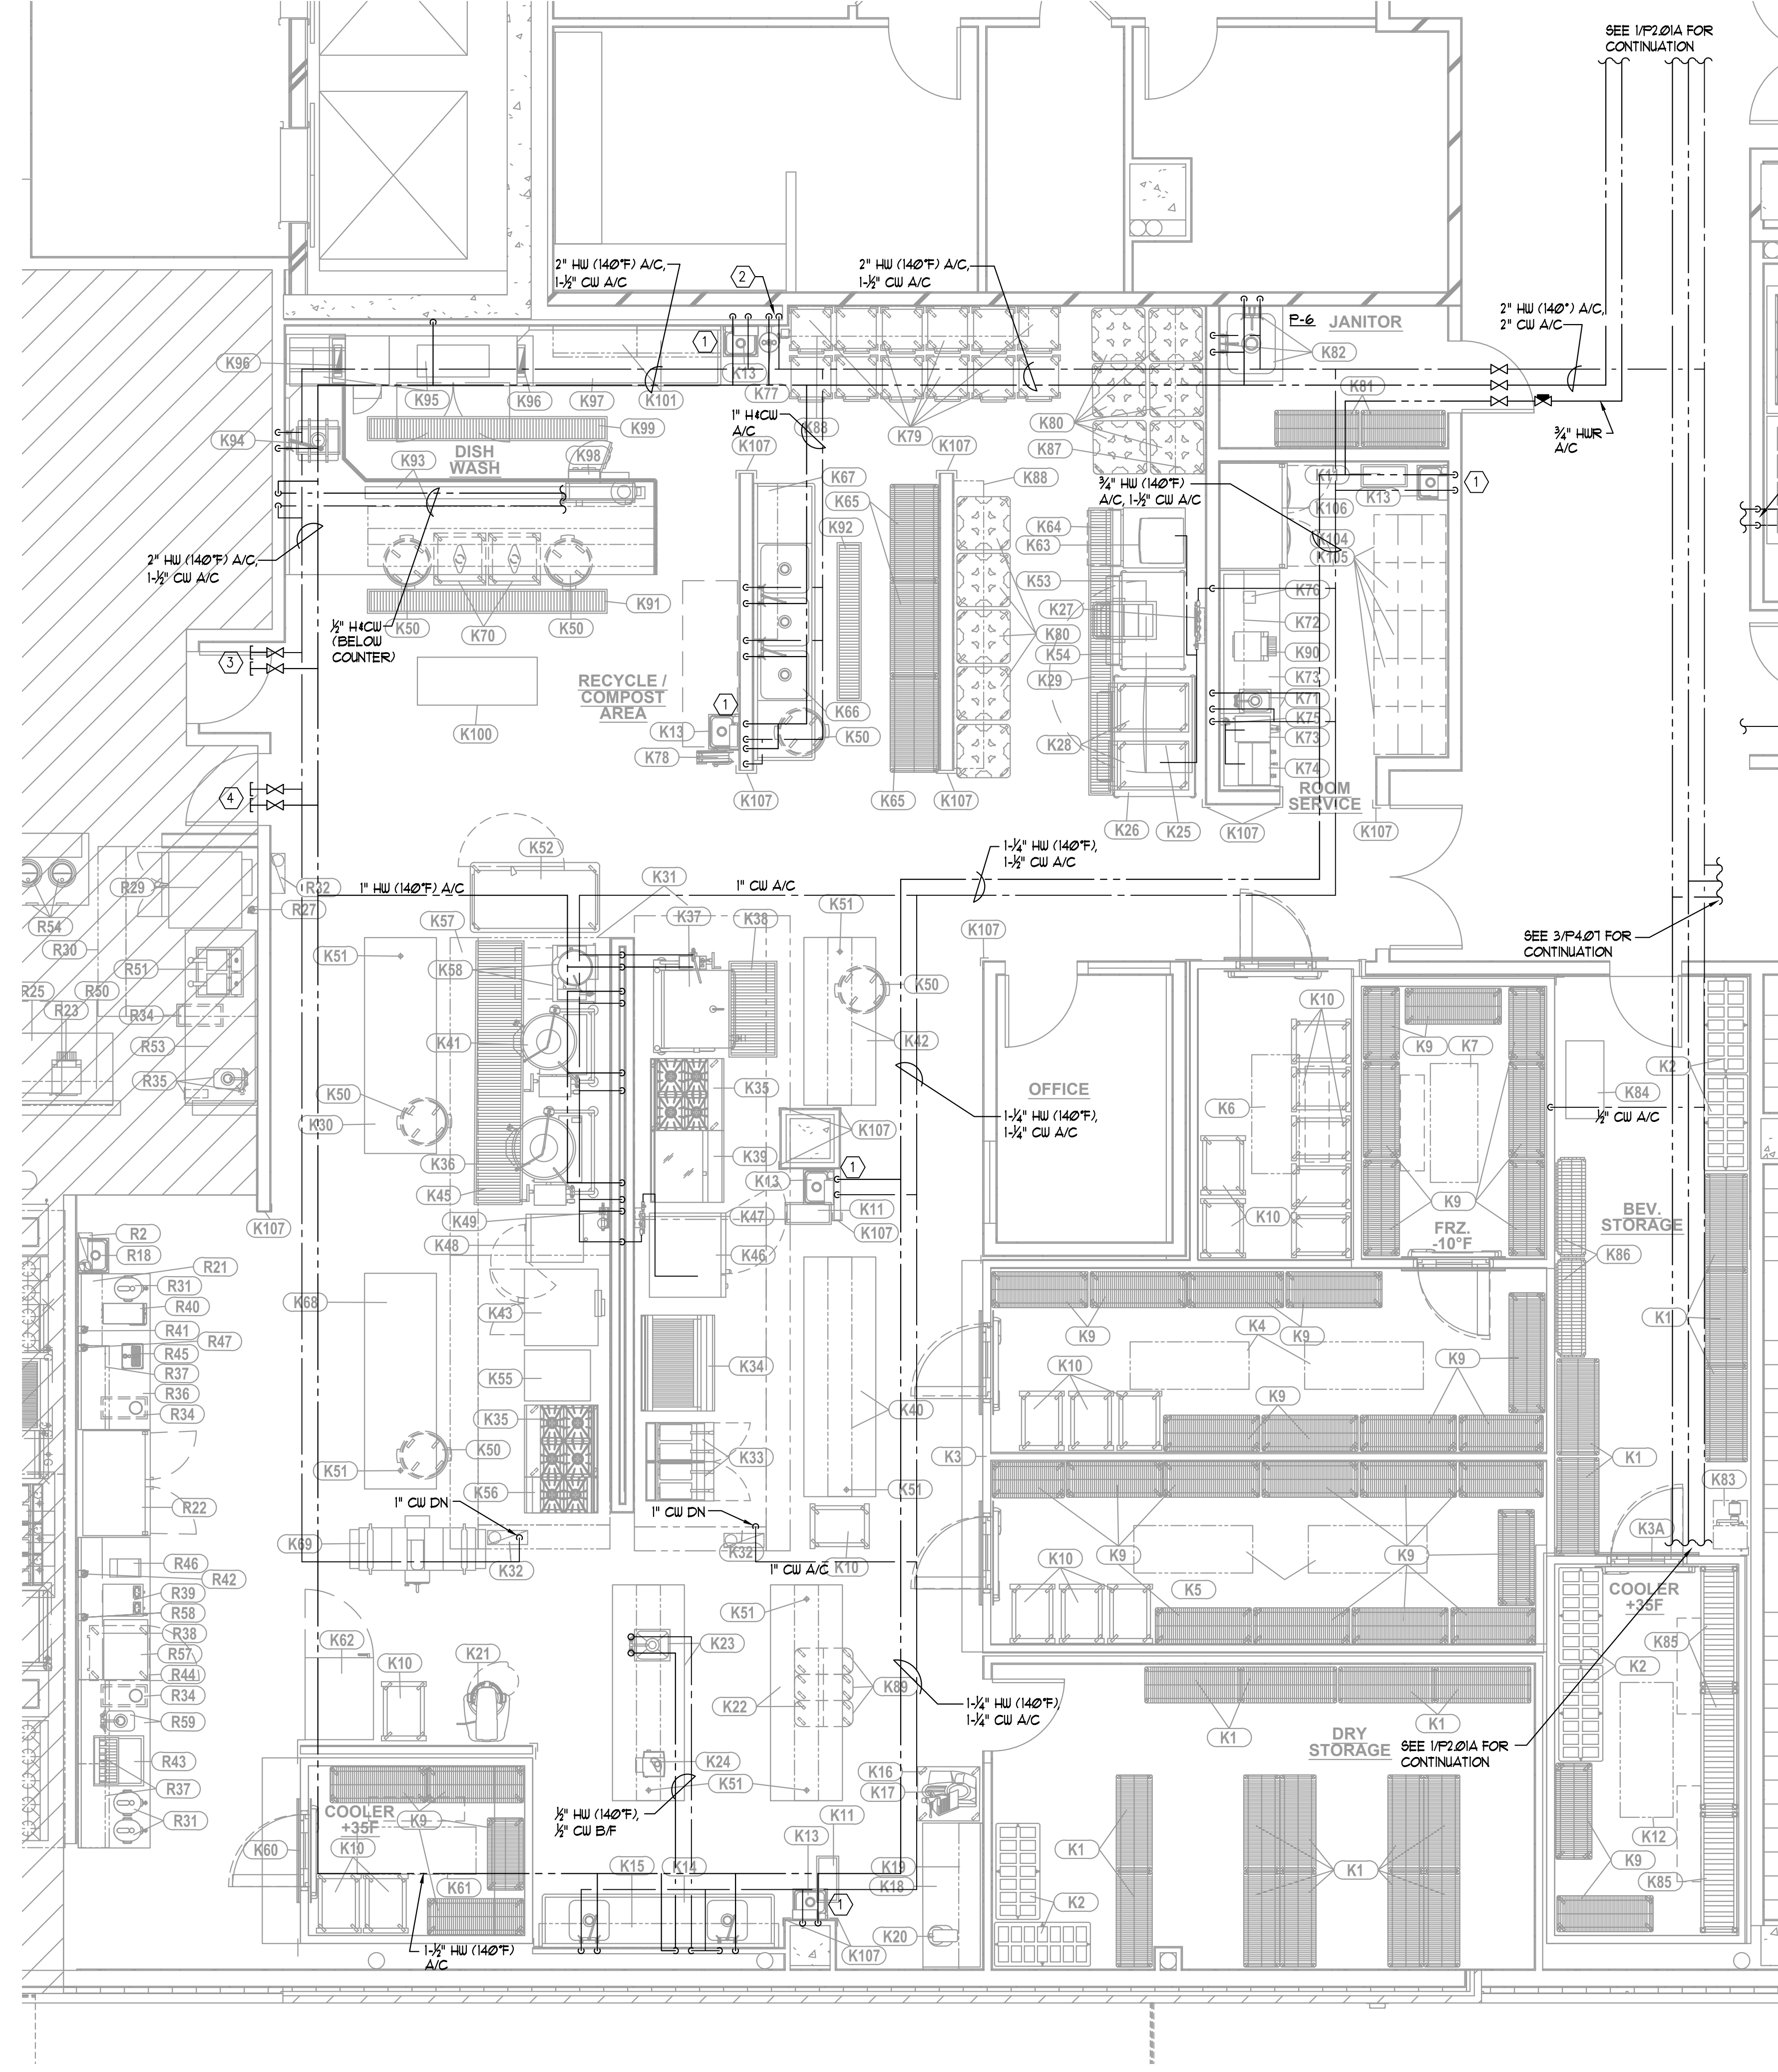

1 KITCHEN PART PLAN — DOMESTIC WATER
1/4" = 1'-0"

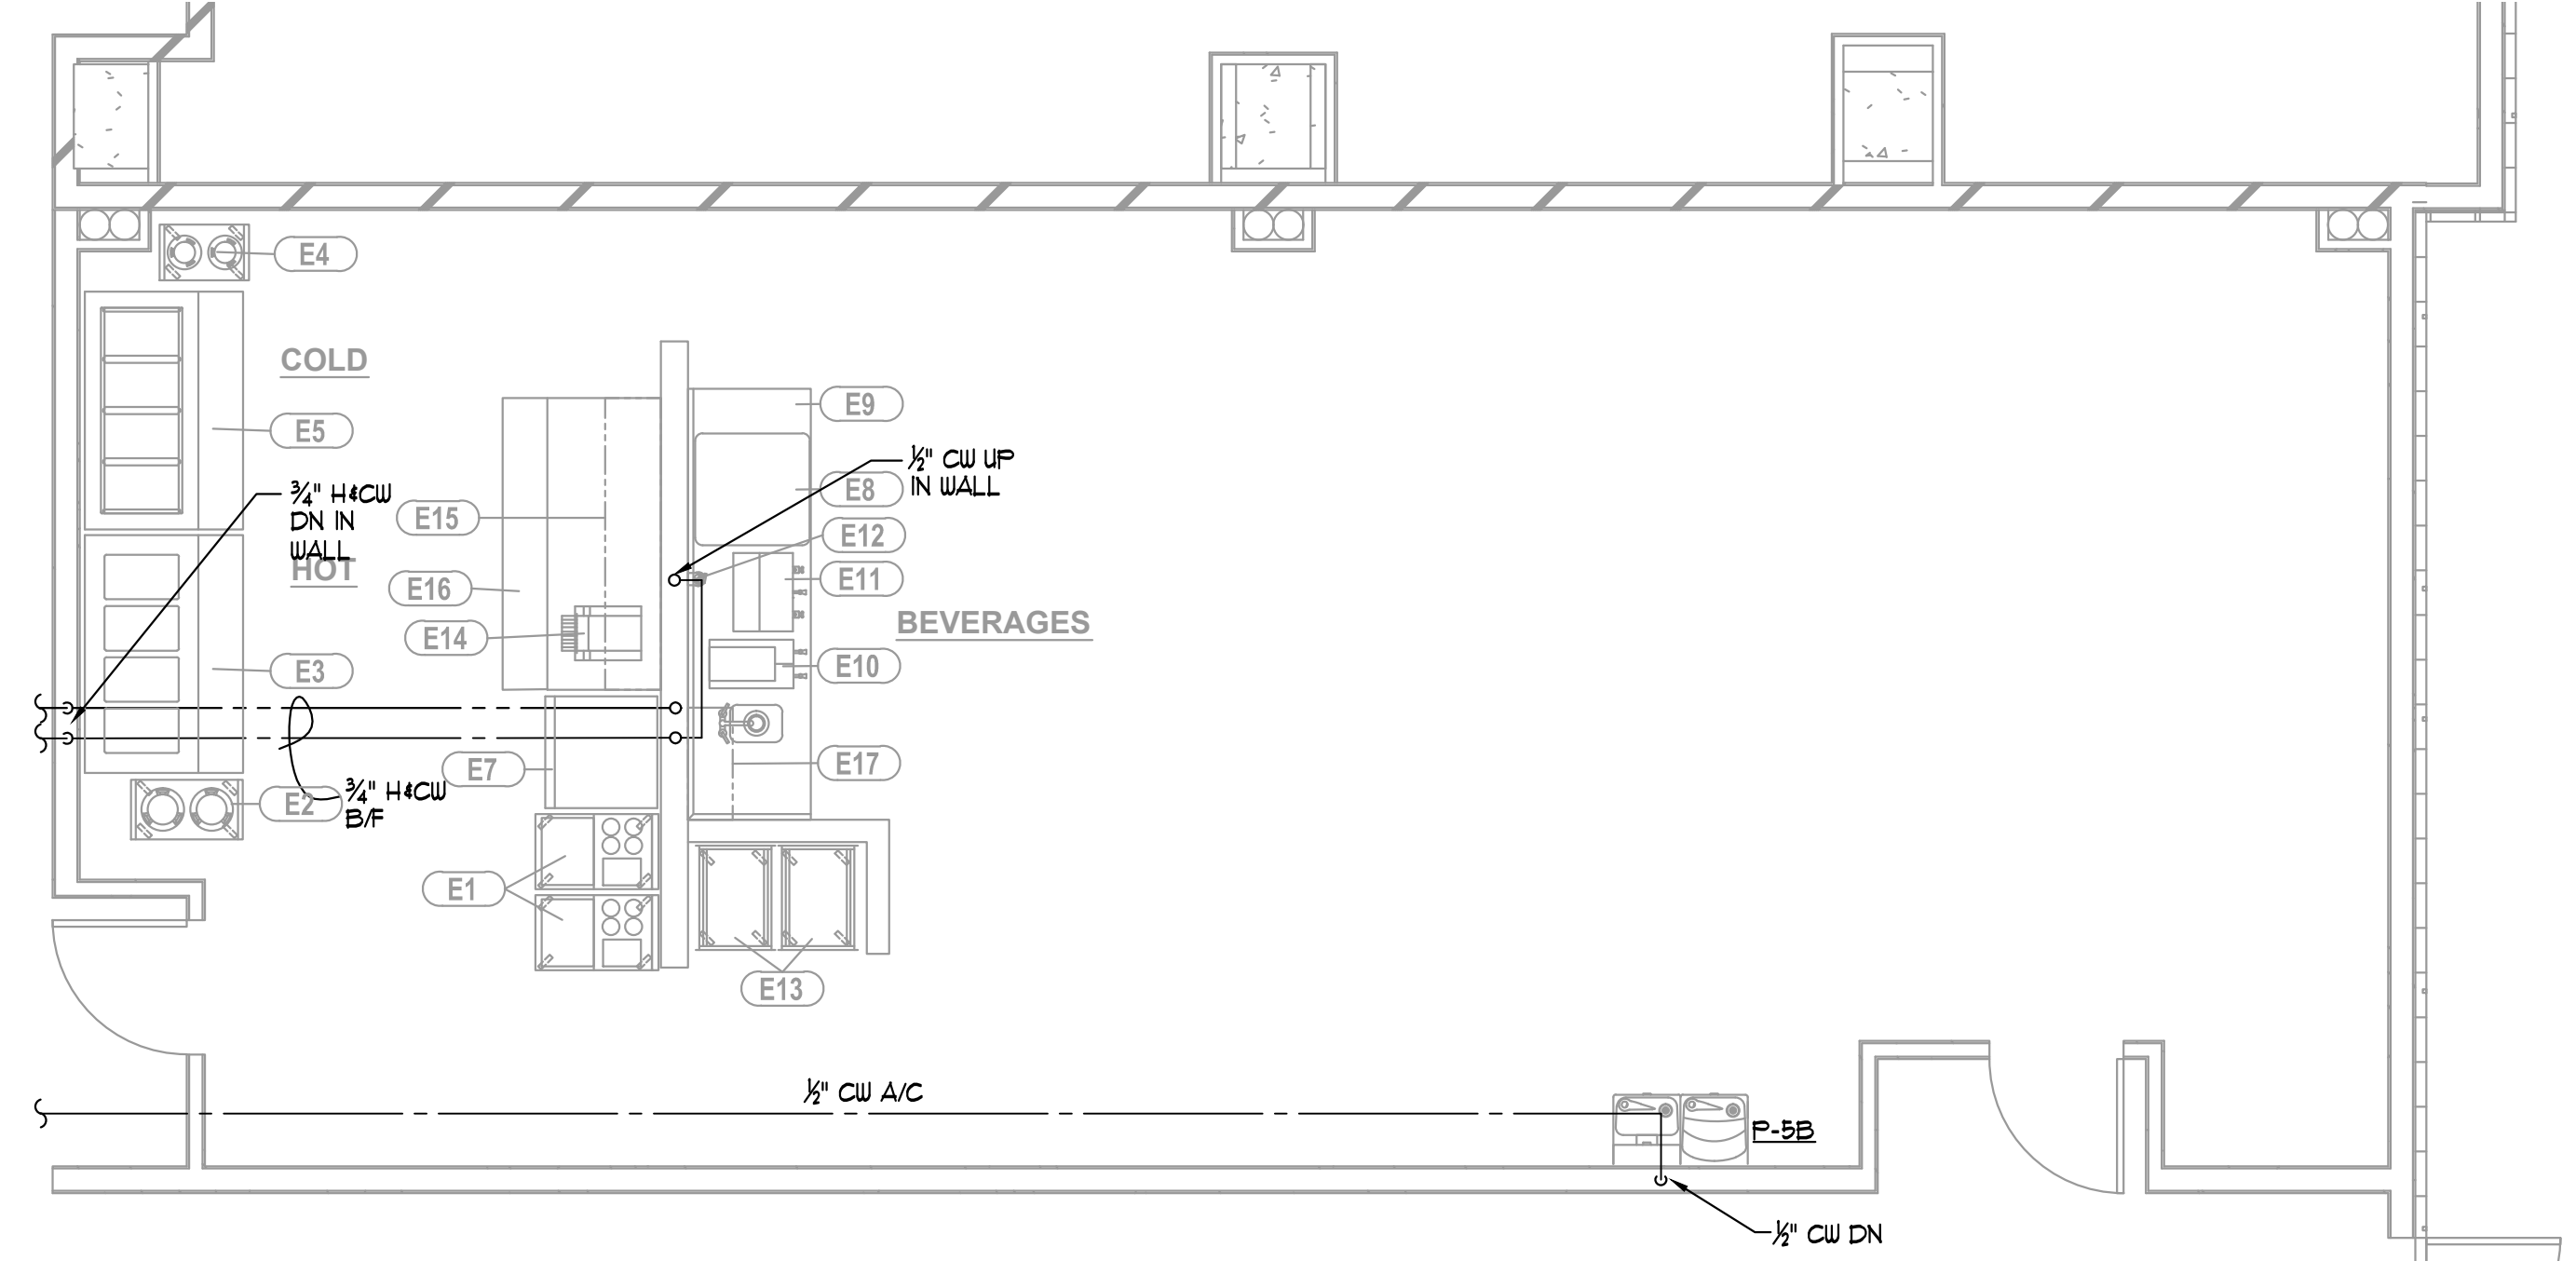

2 EMPLOYEE BREAK RM PART PLAN — DOMESTIC WATER
1/4" = 1'-0"

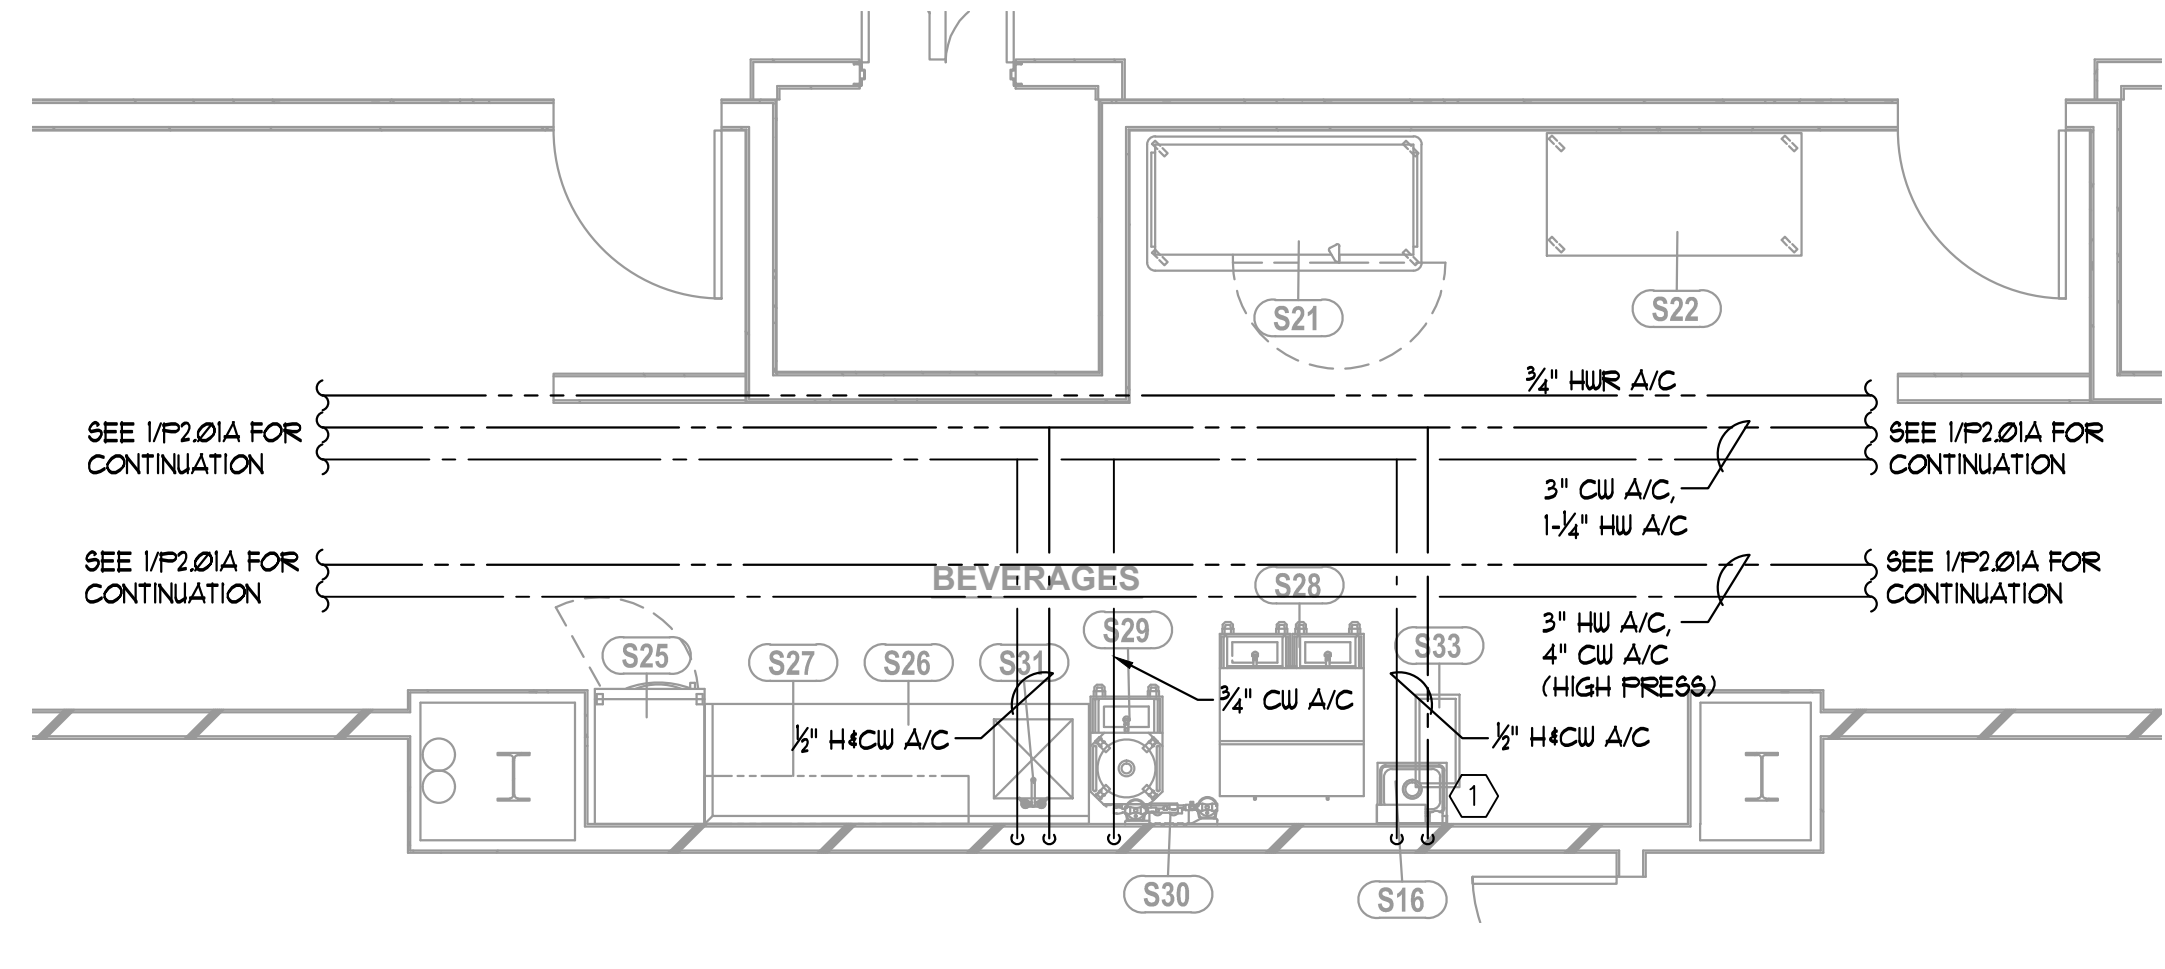

3 LEVEL 1 BANQUET BEVERAGE — DOMESTIC WATER
1/4" = 1'-0"

- GENERAL NOTES**
(APPLY THIS SHEET ONLY)
- REFER TO FIXTURE CONNECTION SCHEDULE AND APPROPRIATE DETAILS FOR PIPING SIZES.
 - REFER TO THE ARCHITECTURAL AND KITCHEN CONSULTANT PLANS FOR LOCATIONS OF ALL FIXTURES AND EQUIPMENT. PROVIDE ALL FINAL CONNECTIONS PER KITCHEN CONSULTANT SCHEDULES.
 - PROVIDE BACKFLOW PREVENTERS AT ALL EQUIPMENT CONNECTIONS.
 - LOCATE ALL VALVES IN ACCESSIBLE LOCATIONS.
- KEY NOTES**
- PROVIDE THERMOSTATIC MIXING VALVE AT HAND SINK. SET AT 110°F.
 - PROVIDE THERMOSTATIC MIXING VALVE AT EMERGENCY EYEWASH. SET AT 85°F.
 - PROVIDE 1-1/2" HW (140°F) AND 1-1/2" CW FUTURE TAPS FOR BAR.
 - PROVIDE 1-1/2" HW (140°F) AND 1-1/2" CW FUTURE TAPS FOR RESTAURANT.

ALPHARETTA CONFERENCE
CENTER & THE HOTEL AT
AVALON


9000 AVALON BOULEVARD /
ALPHARETTA, GEORGIA 30009

STORMONT HOSPITALITY GROUP, LLC /
NORTH AMERICAN PROPERTY GROUP

LEVEL 1 - ZONE A
KITCHEN PART
PLANS - PLUMBING


K. PRICE	140028
Principal in Charge	Block & Project No.
G. JENKINS	101716
Project Engineer	Date
T. MERCER	
Checker	

P4.10

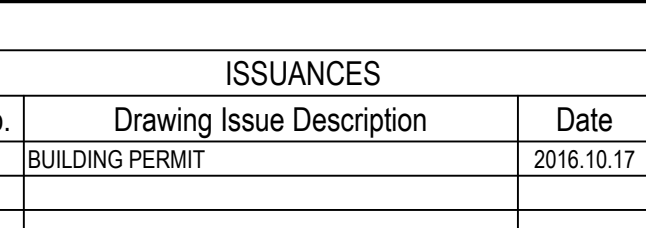

- | KEY NOTES | |
|-----------|---|
| 1 | ROUTE INDIRECT WASTE PIPE TO FLOOR SINK. SIZE PER KITCHEN CONSULTANT EQUIPMENT SCHEDULE. |
| 2 | ROUTE CONDENSATE FROM EVAPORATOR (SIZE PER MANUFACTURER'S RECOMMENDATIONS) TO DRAIN AS SHOWN. |



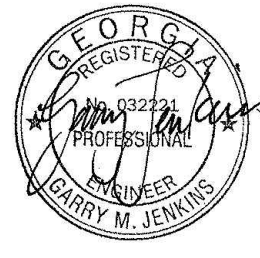

ISSUANCES		
No.	Drawing Issue Description	Date
1	BUILDING PERMIT	2016.10.17

ALPHARETTA CONFERENCE
CENTER & THE HOTEL AT
AVALON

9000 AVALON BOULEVARD /
ALPHARETTA, GEORGIA 30009

STORMONT HOSPITALITY GROUP, LLC /
NORTH AMERICAN PROPERTY GROUP

GUESTROOM
RISER DIAGRAMS


K. PRICE	140028
Principal in Charge	BW&A Project No.
G. JENKINS	101716
Project Engineer	Date
T. MERCER	
Checker	

P5.01

ISSUED FOR CONSTRUCTION

SOV
1


SEE 1/P2.12 FOR
CONTINUATION

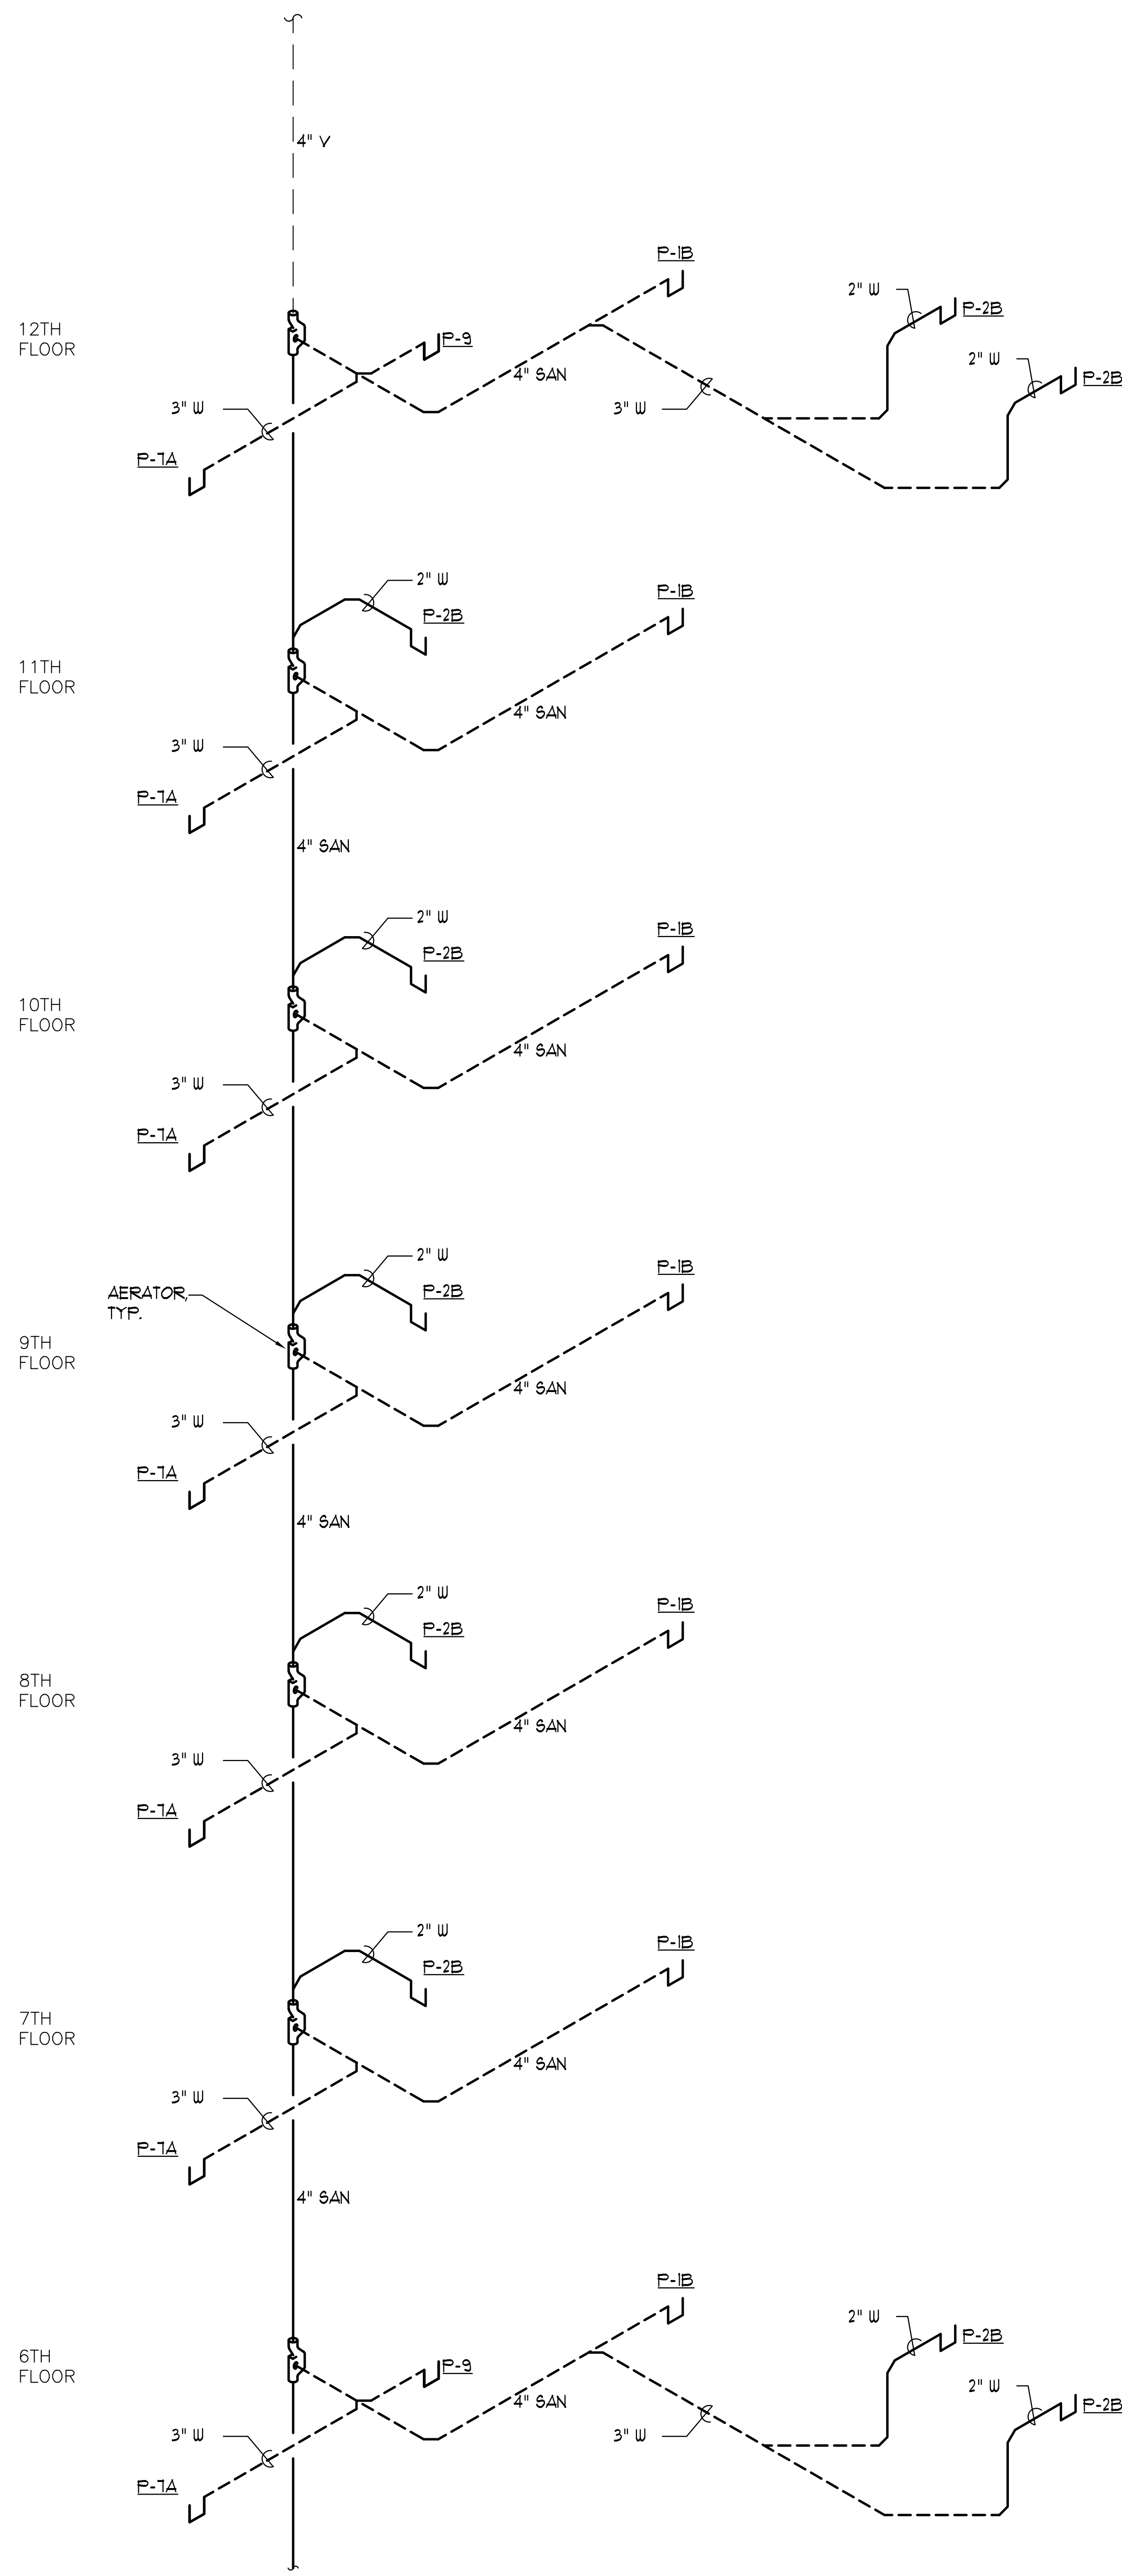

SEE 1/P5.02 FOR
CONTINUATION

SOV
2


SEE 1/P2.12 FOR
CONTINUATION

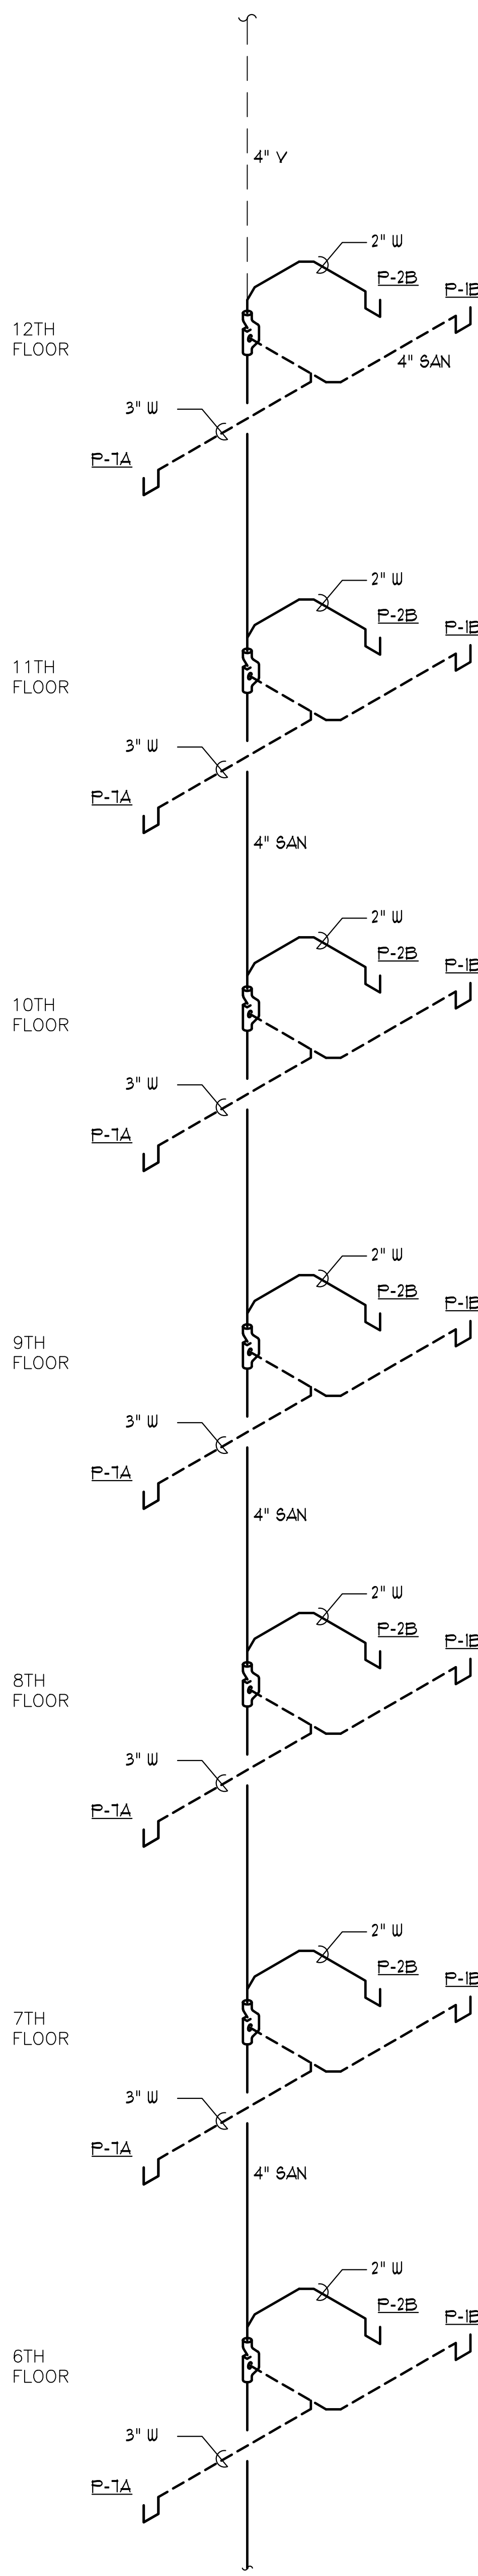

SEE 1/P5.02 FOR
CONTINUATION

SOV
3


SEE 1/P2.12 FOR
CONTINUATION

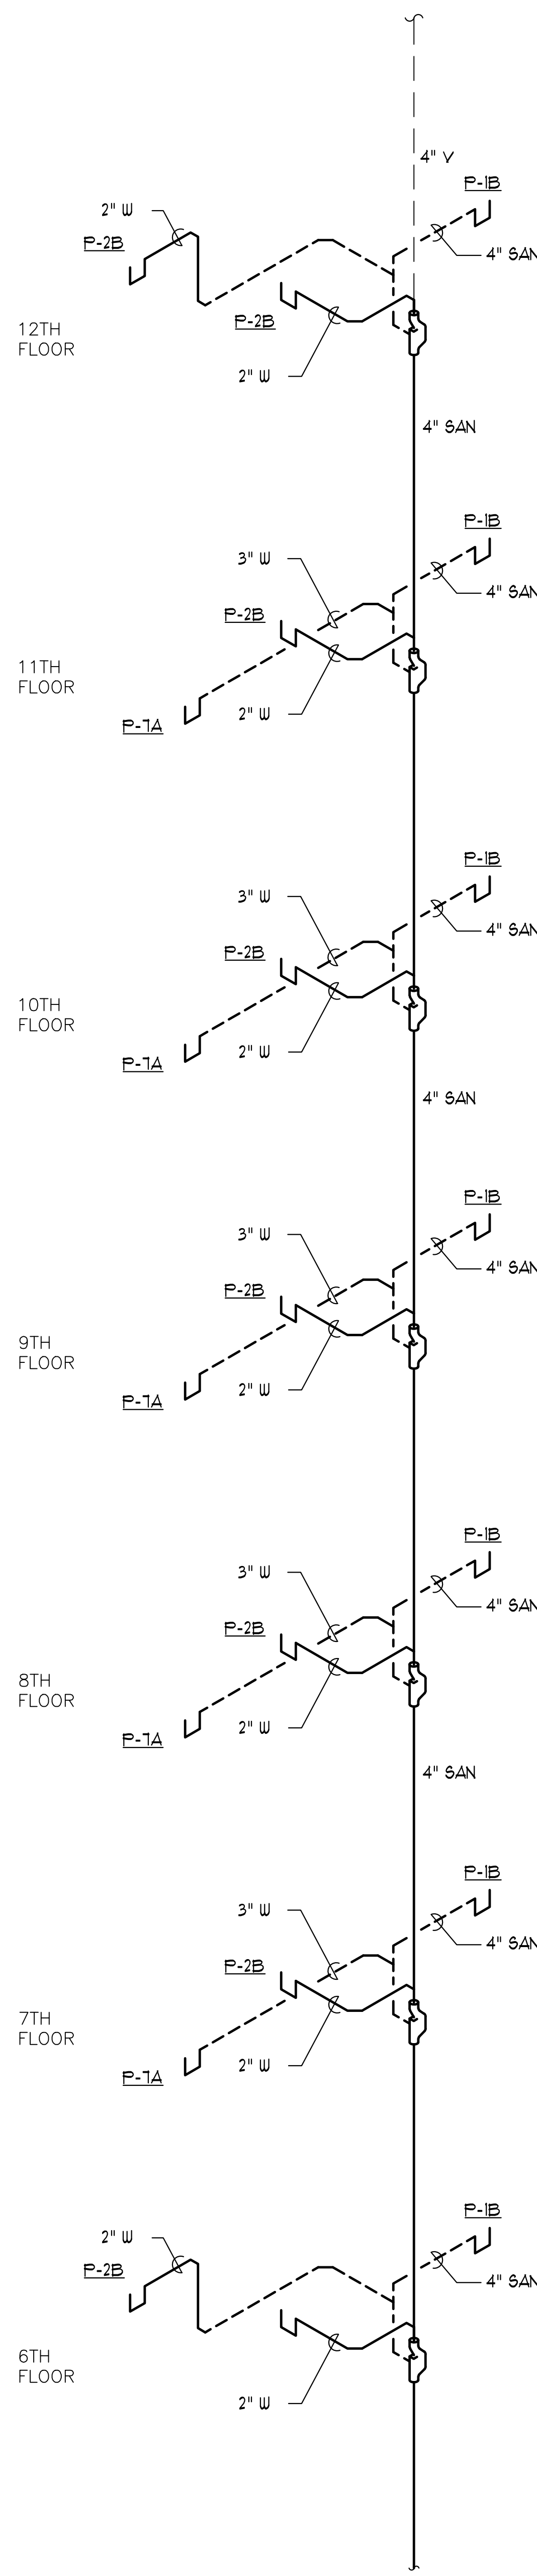

SEE 1/P5.02 FOR
CONTINUATION

SOV
4


SEE 1/P2.12 FOR
CONTINUATION

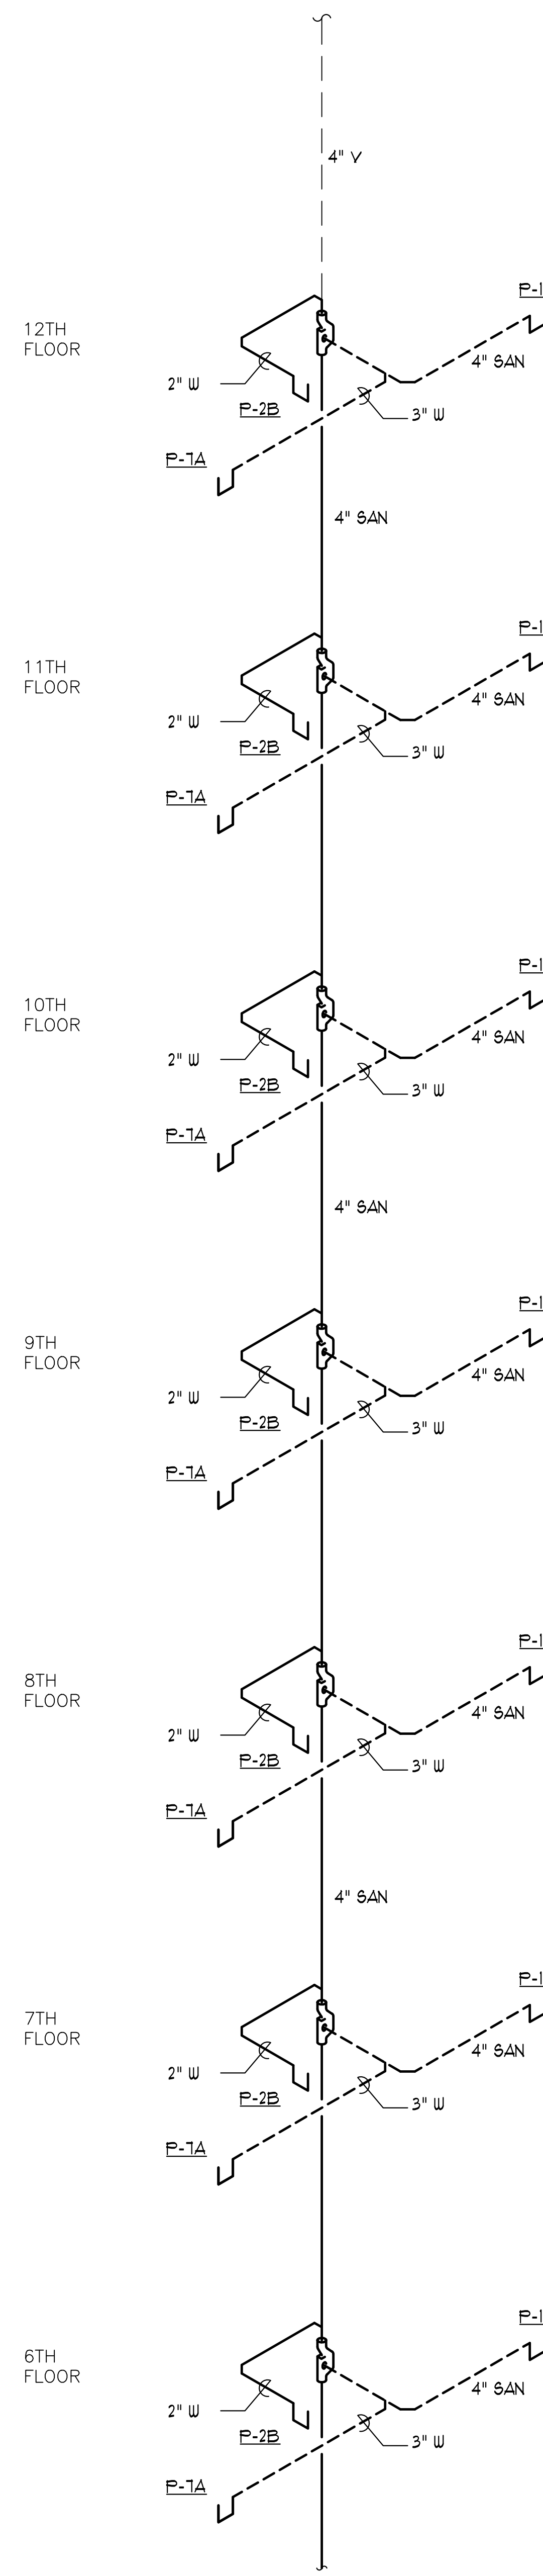





SEE 1/P5.02 FOR
CONTINUATION

1 GUESTROOM SOVENT RISER DIAGRAM (FLOORS 6-12)

P5.01 NO SCALE

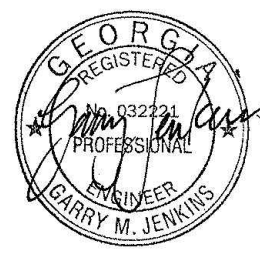

ISSUANCES		
No.	Drawing Issue Description	Date
1	BUILDING PERMIT	2016.10.17

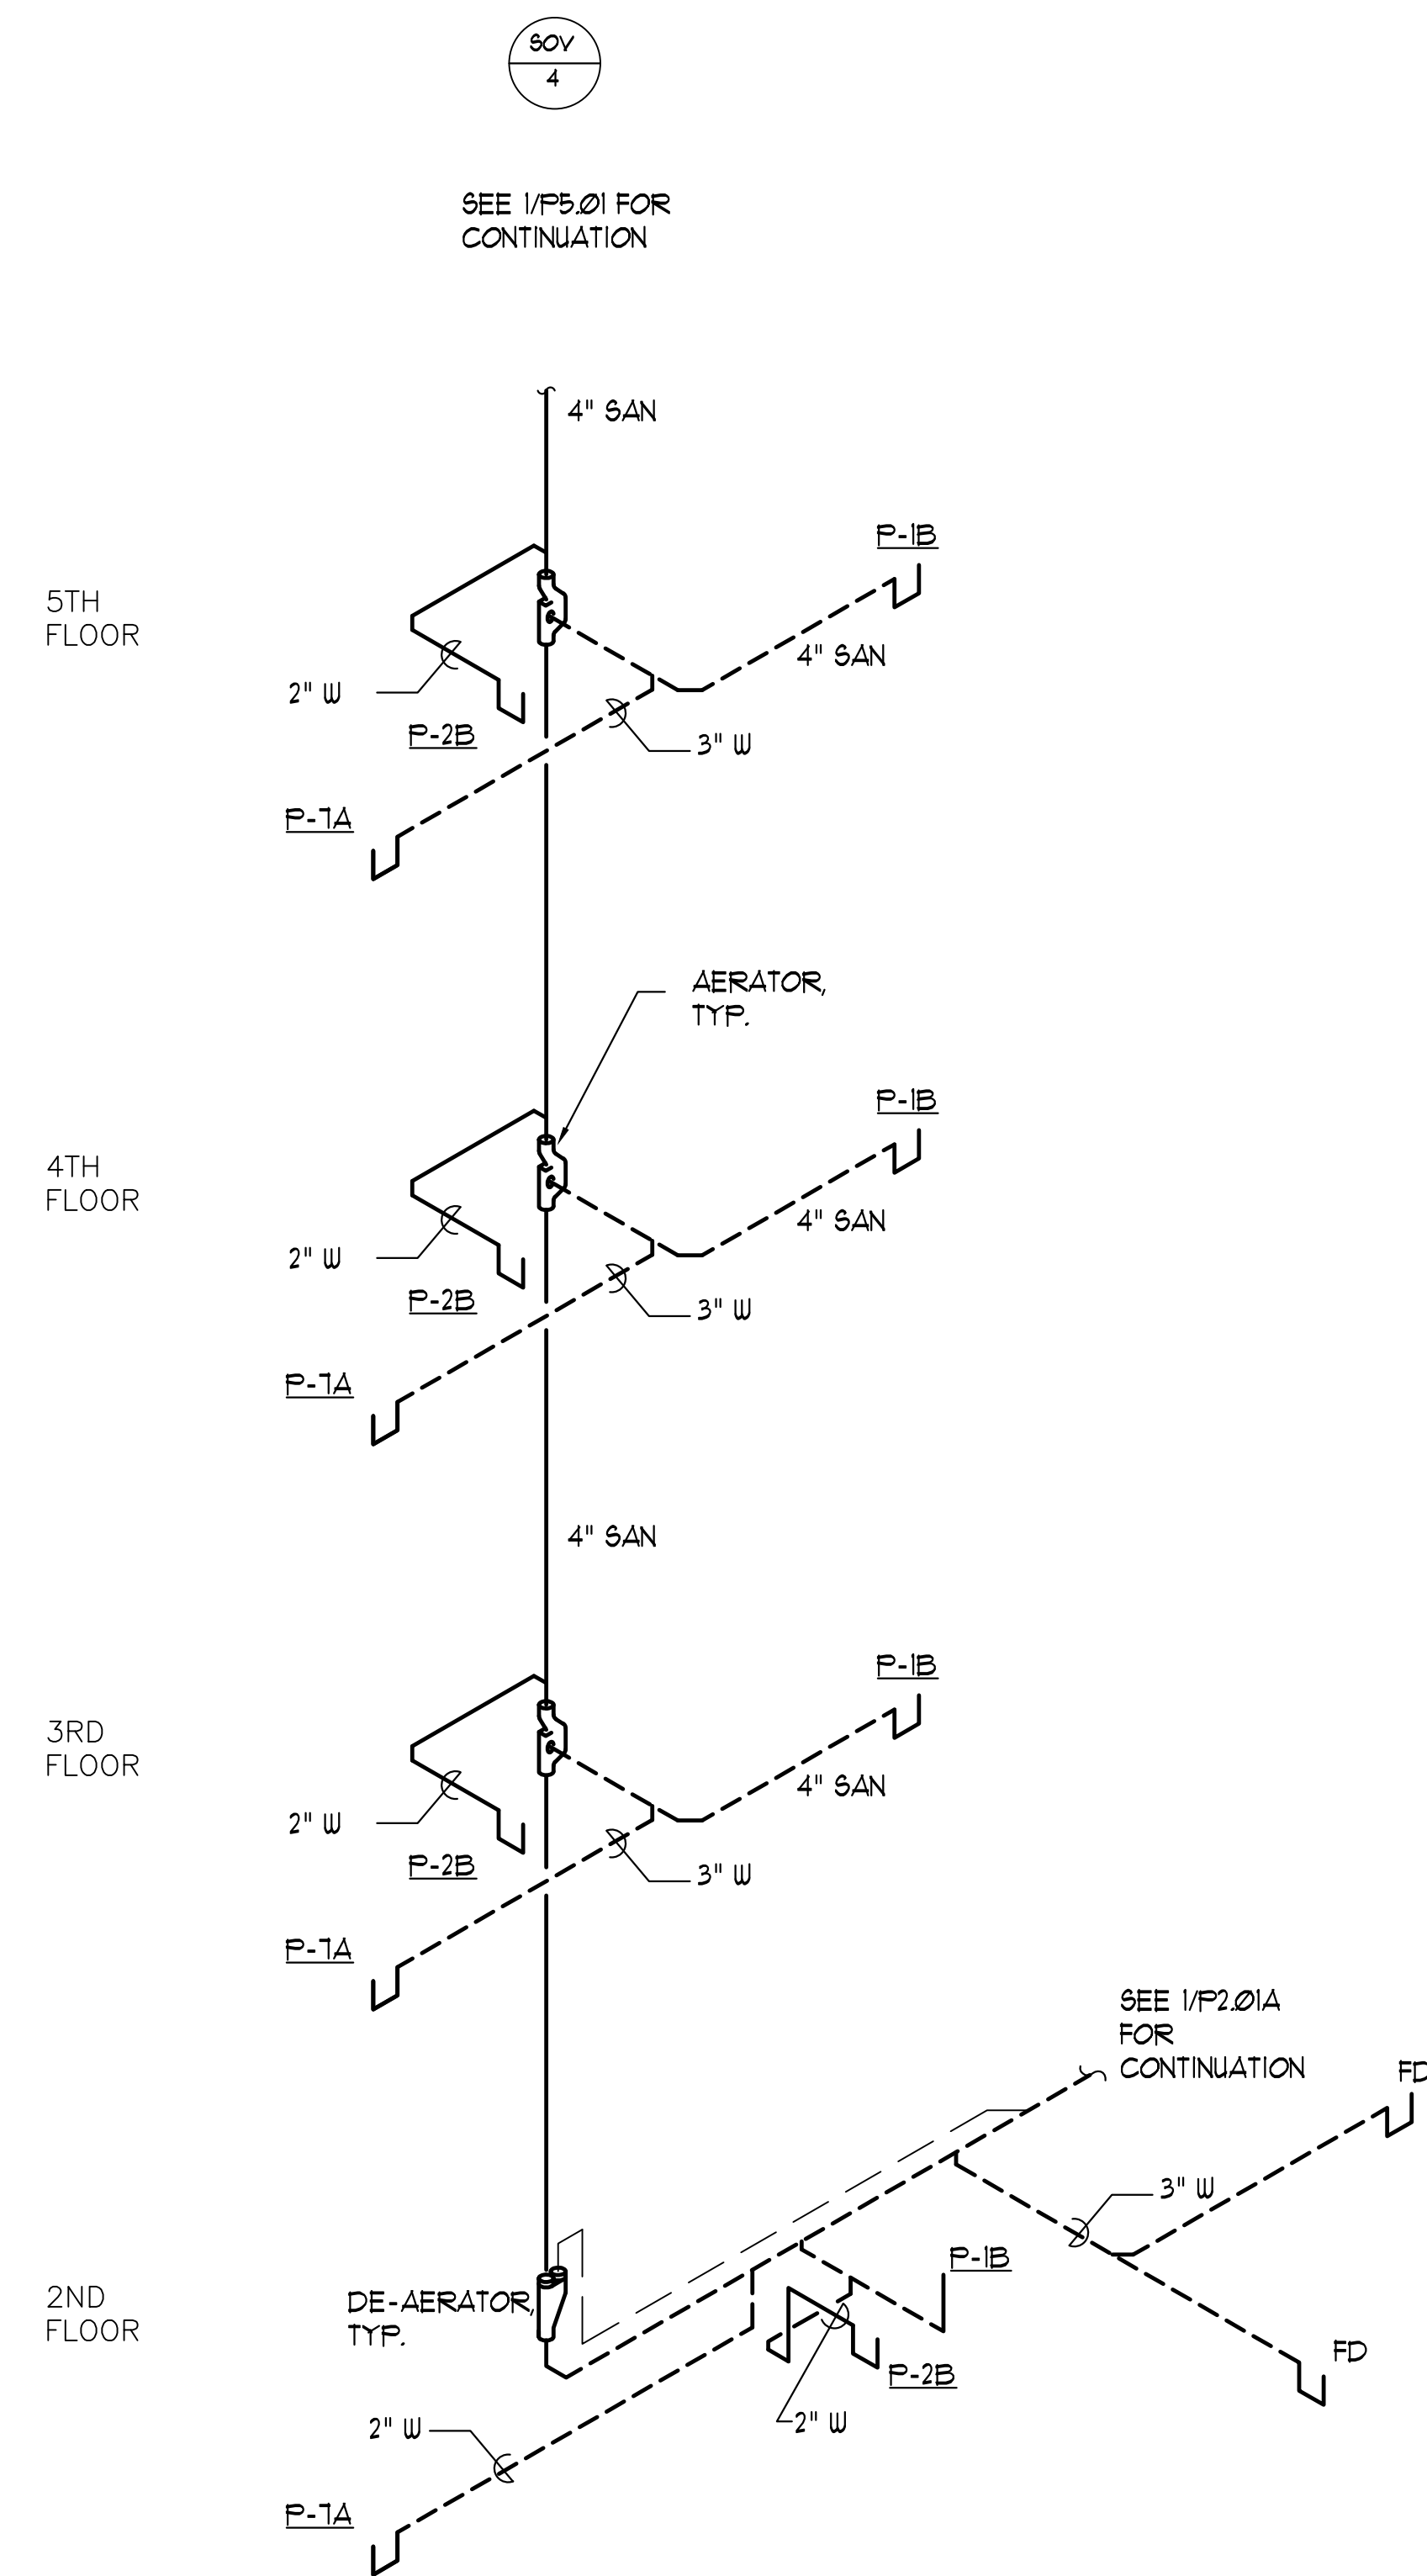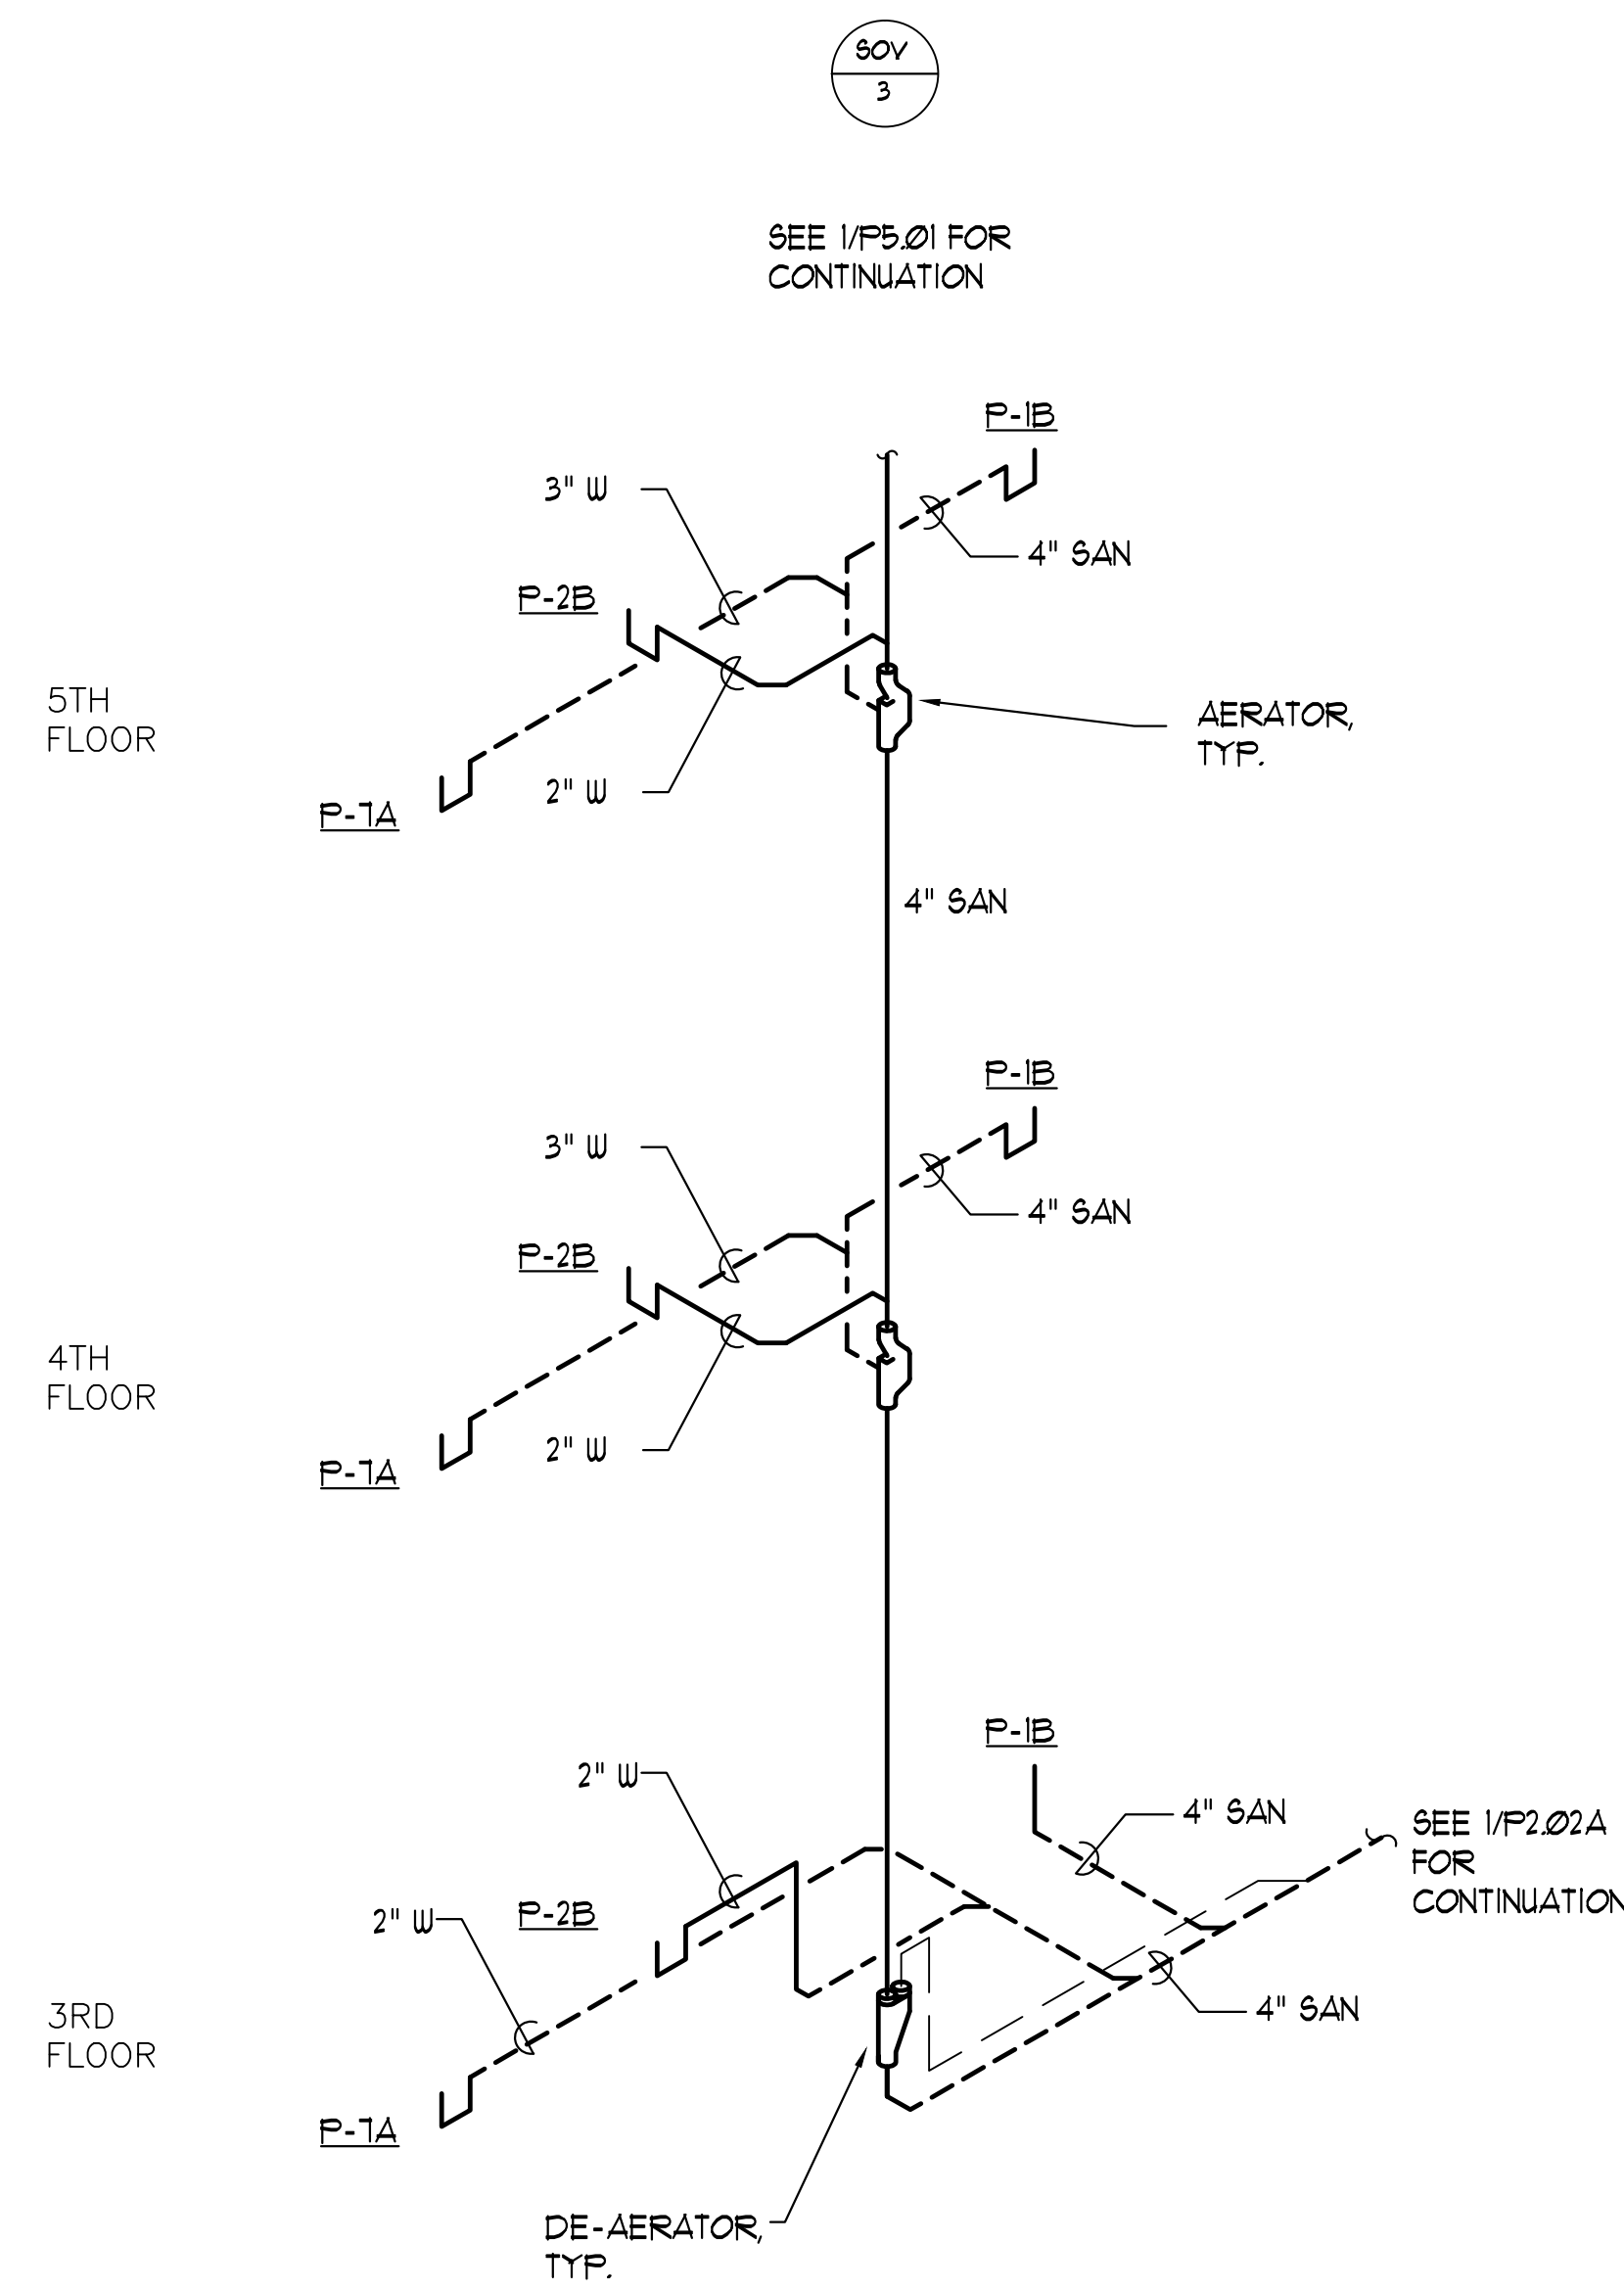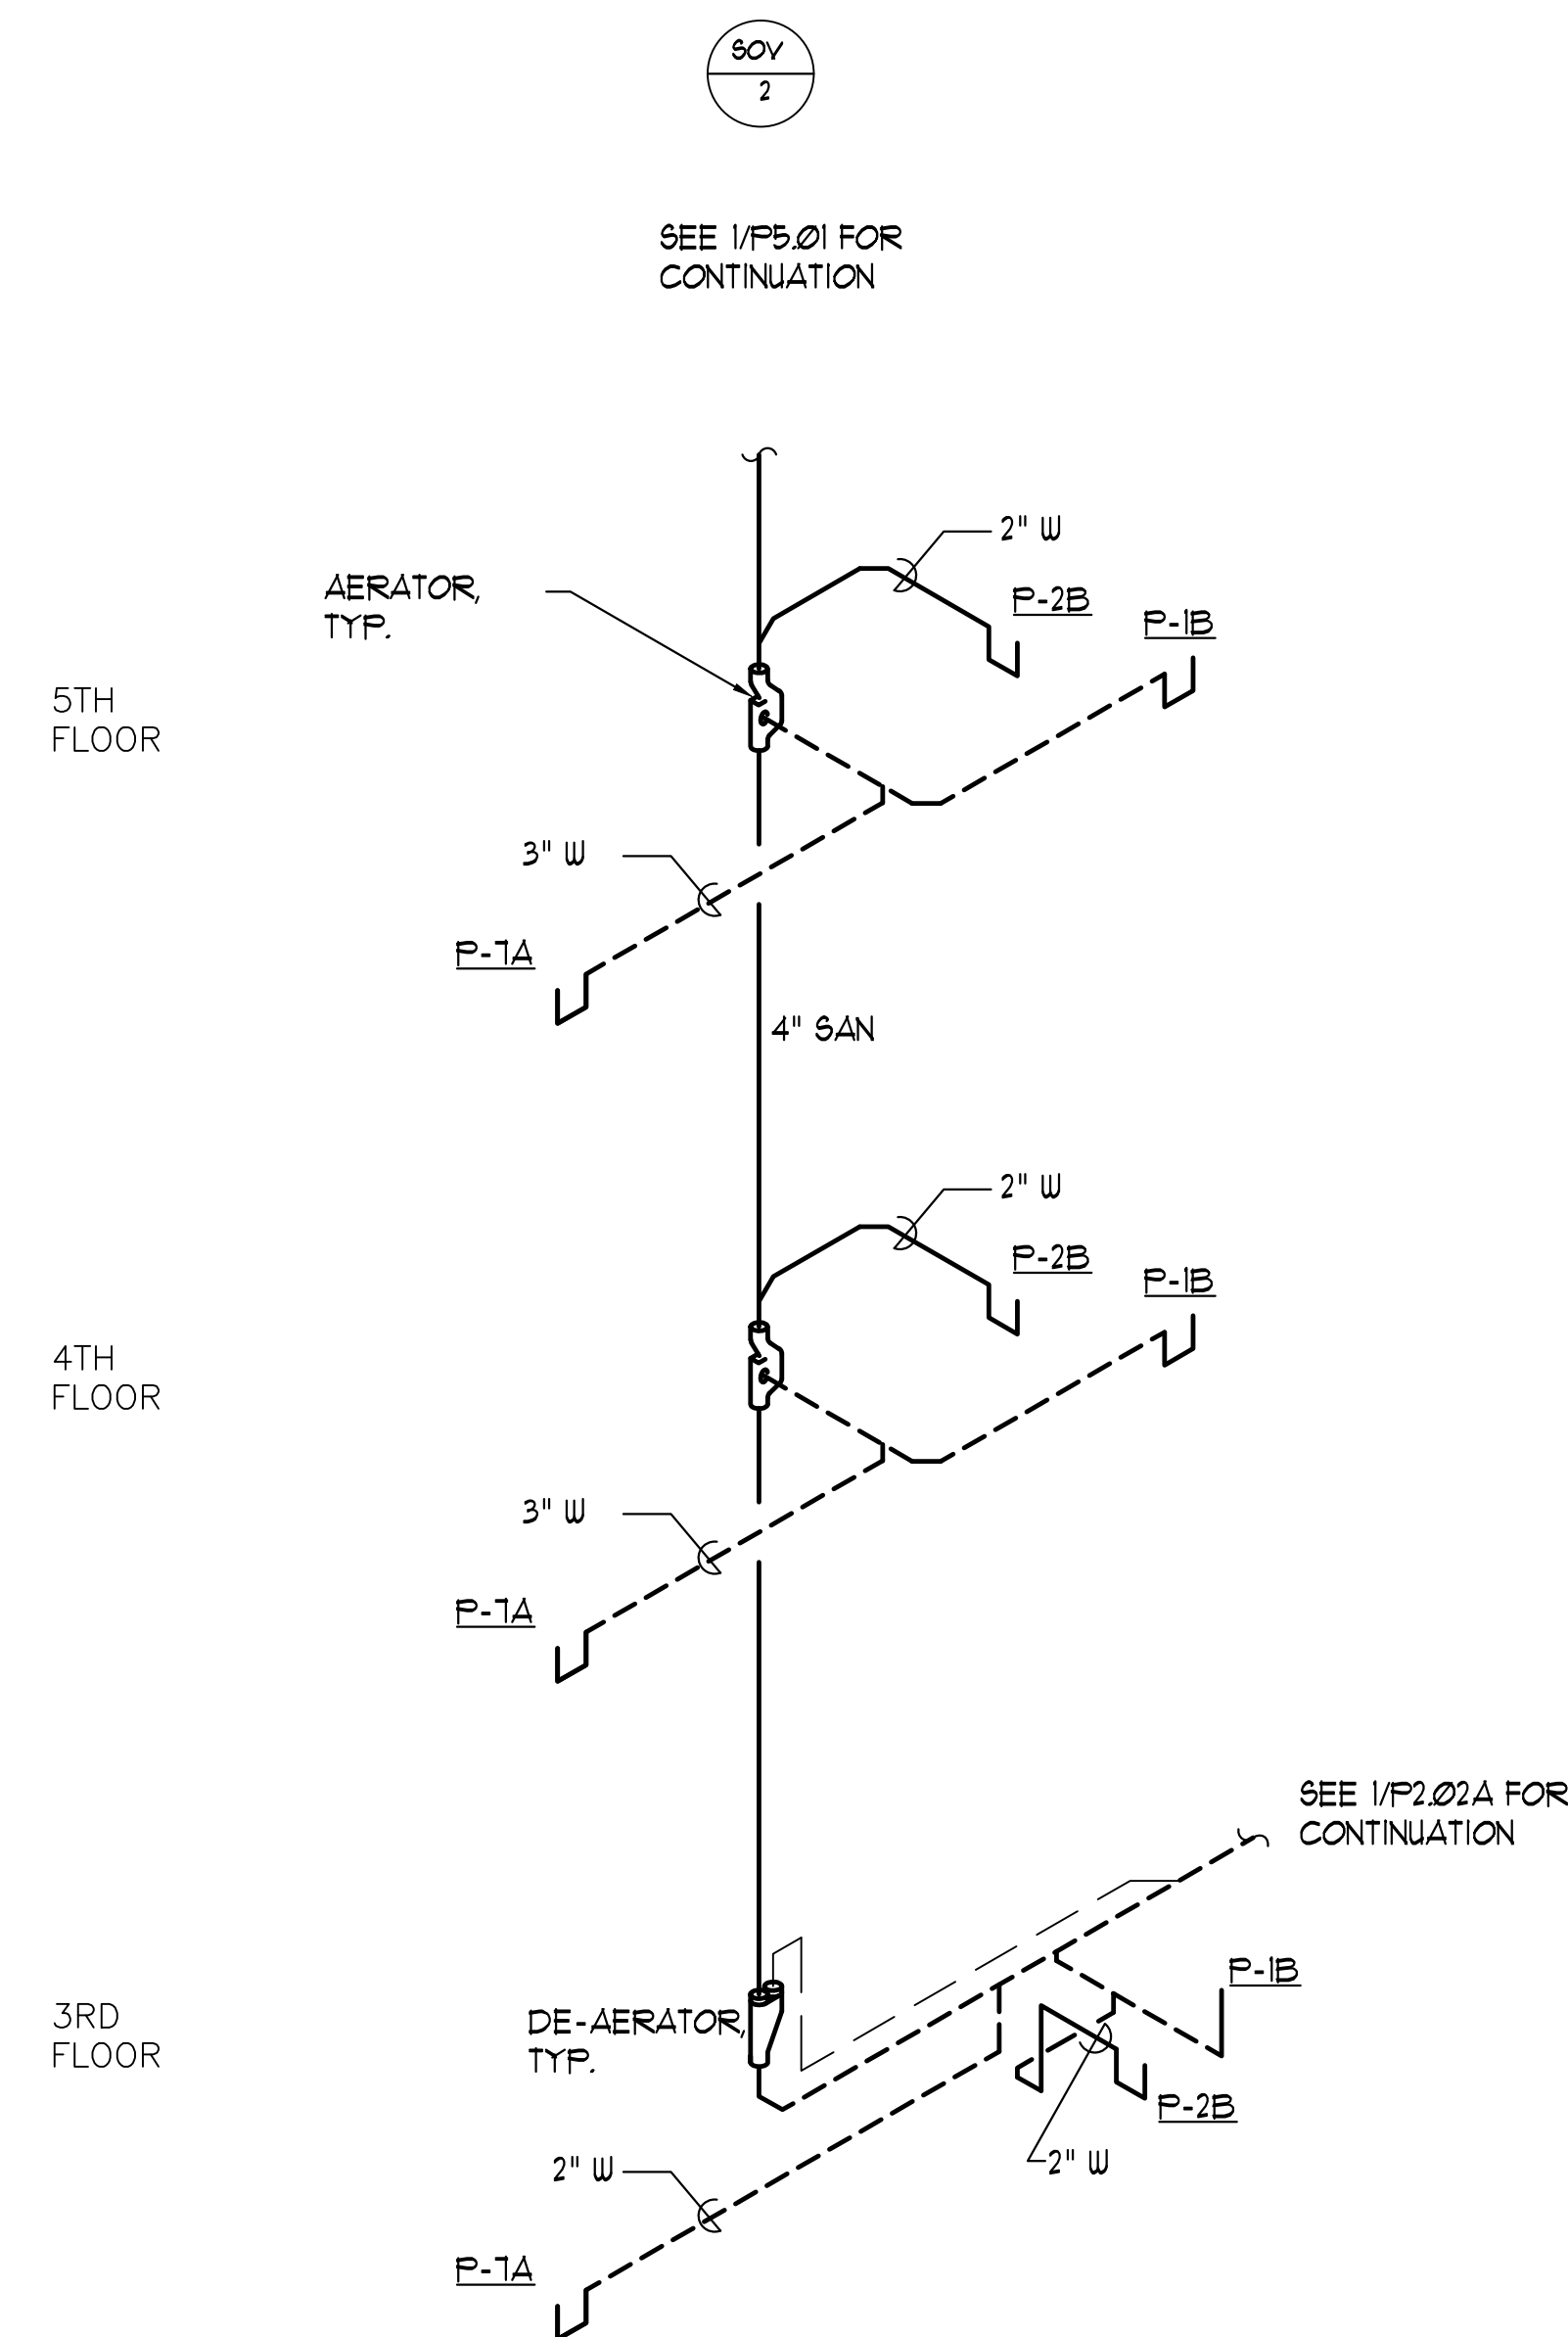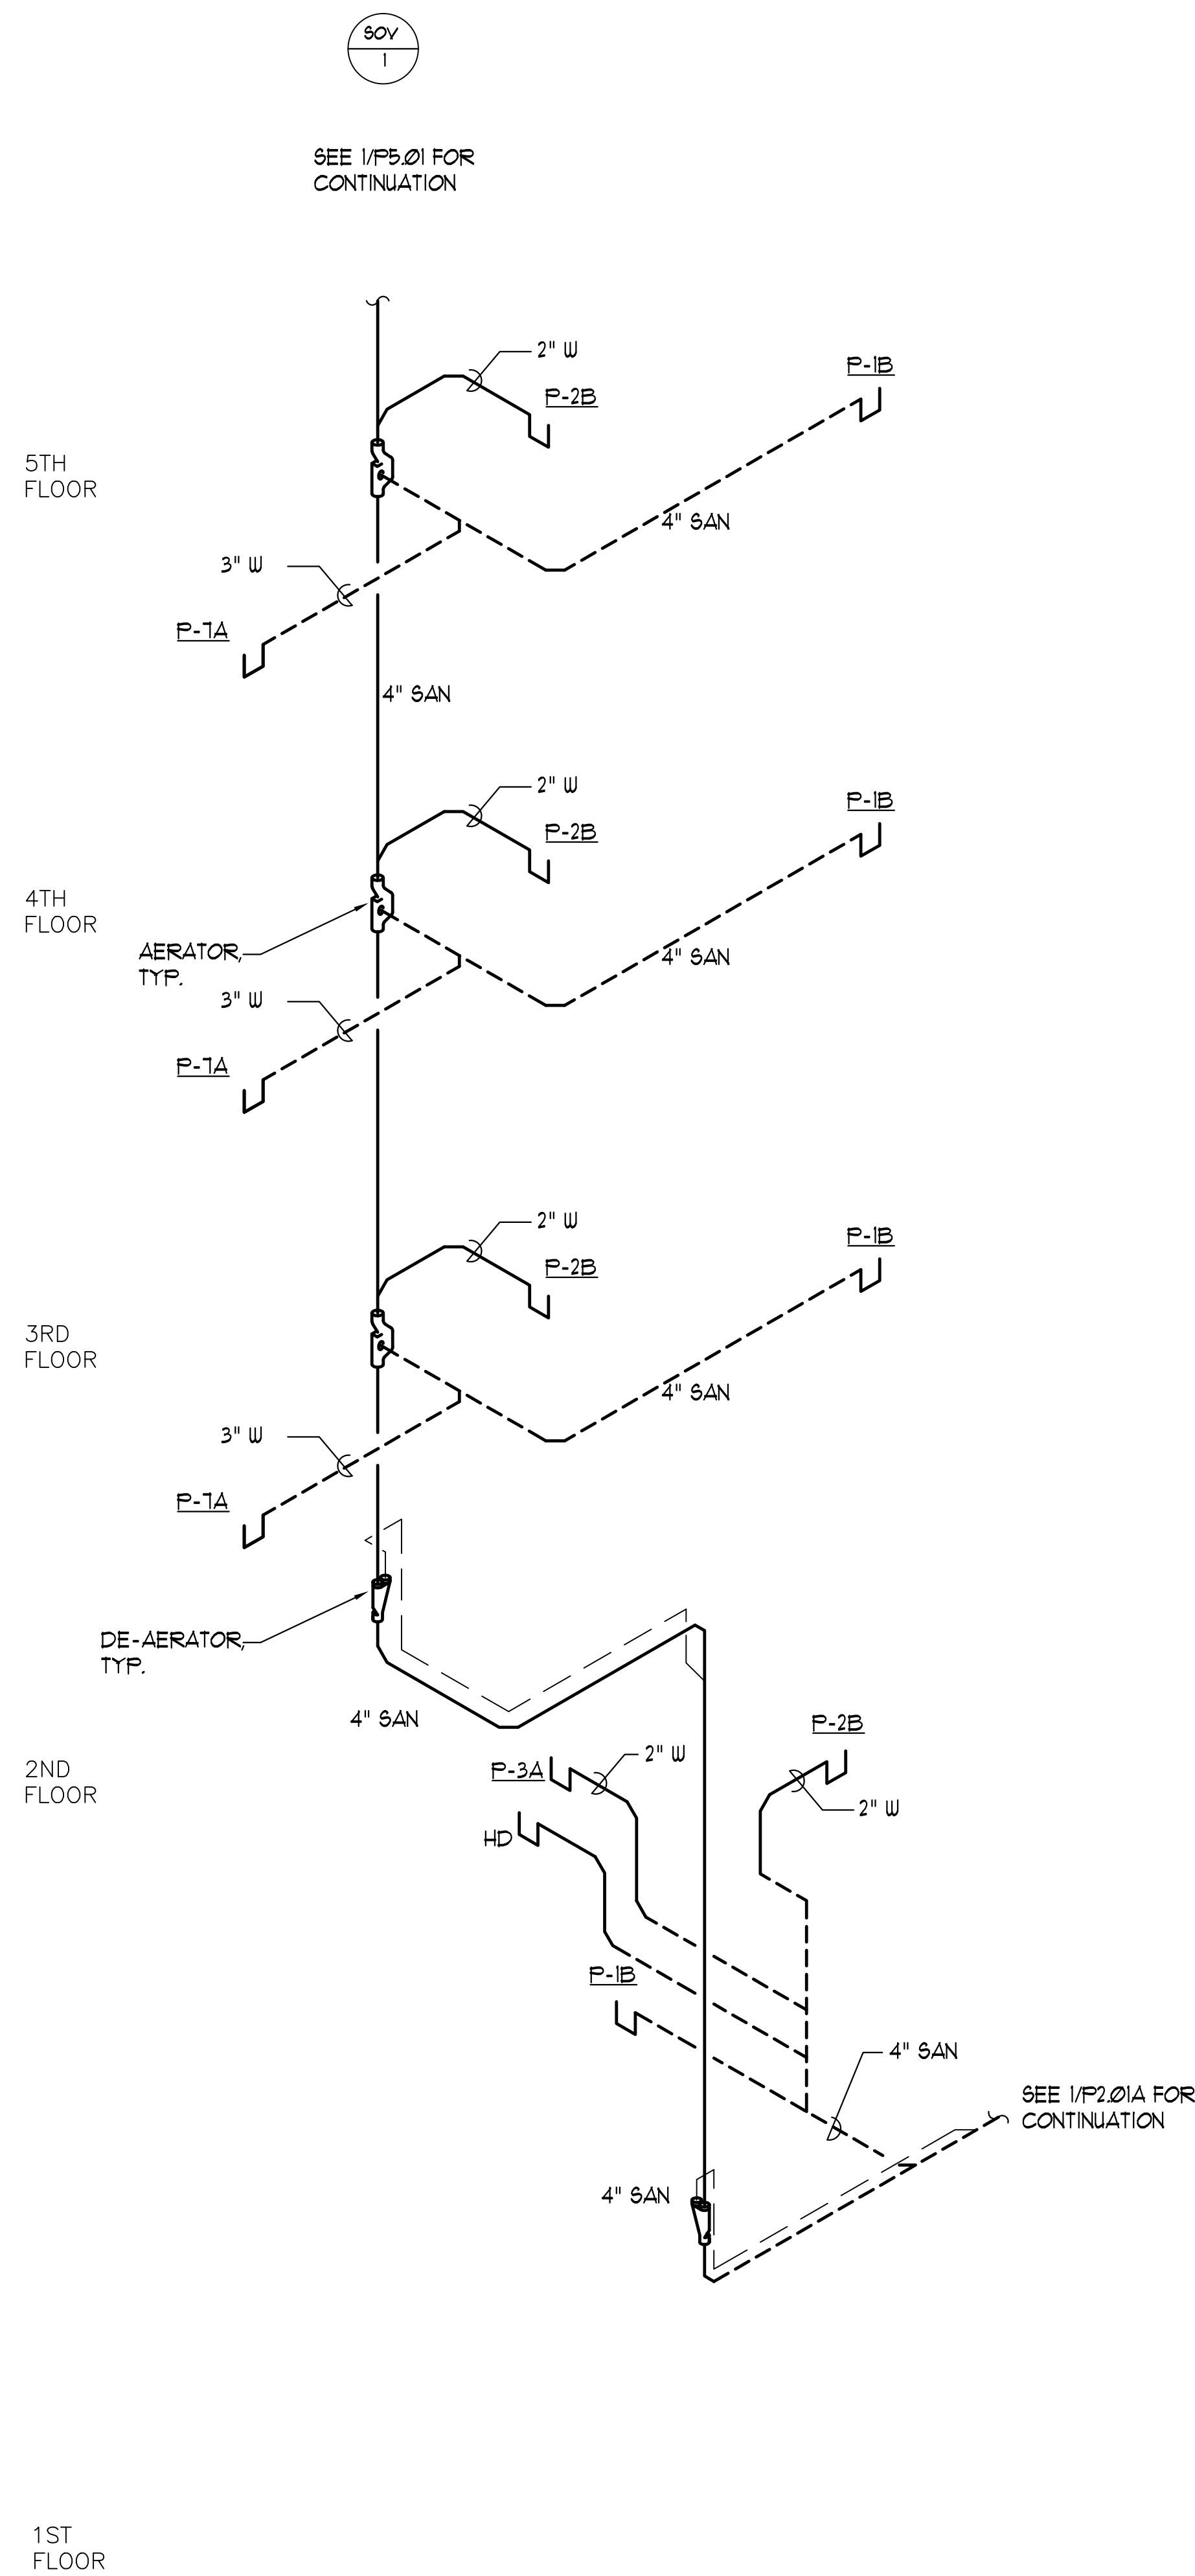

1
P5.02

GUESTROOM SOVENT RISER DIAGRAM (FLOORS 6-12)

NO SCALE

ALPHARETTA CONFERENCE
CENTER & THE HOTEL AT
AVALON


9000 AVALON BOULEVARD /
ALPHARETTA, GEORGIA 30009

STORMONT HOSPITALITY GROUP, LLC /
NORTH AMERICAN PROPERTY GROUP


GUESTROOM
RISER DIAGRAMS

K. PRICE	140028
Principal-in-Charge	BW&A Project No.
G. JENKINS	101716
Project Engineer	Date
T. MERCER	
Drawn By	

P5.02

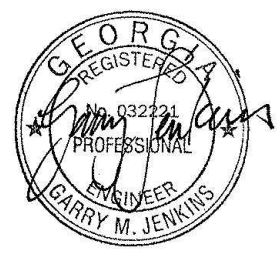

ISSUANCES		
No.	Drawing Issue Description	Date
1	BUILDING PERMIT	2016.10.17

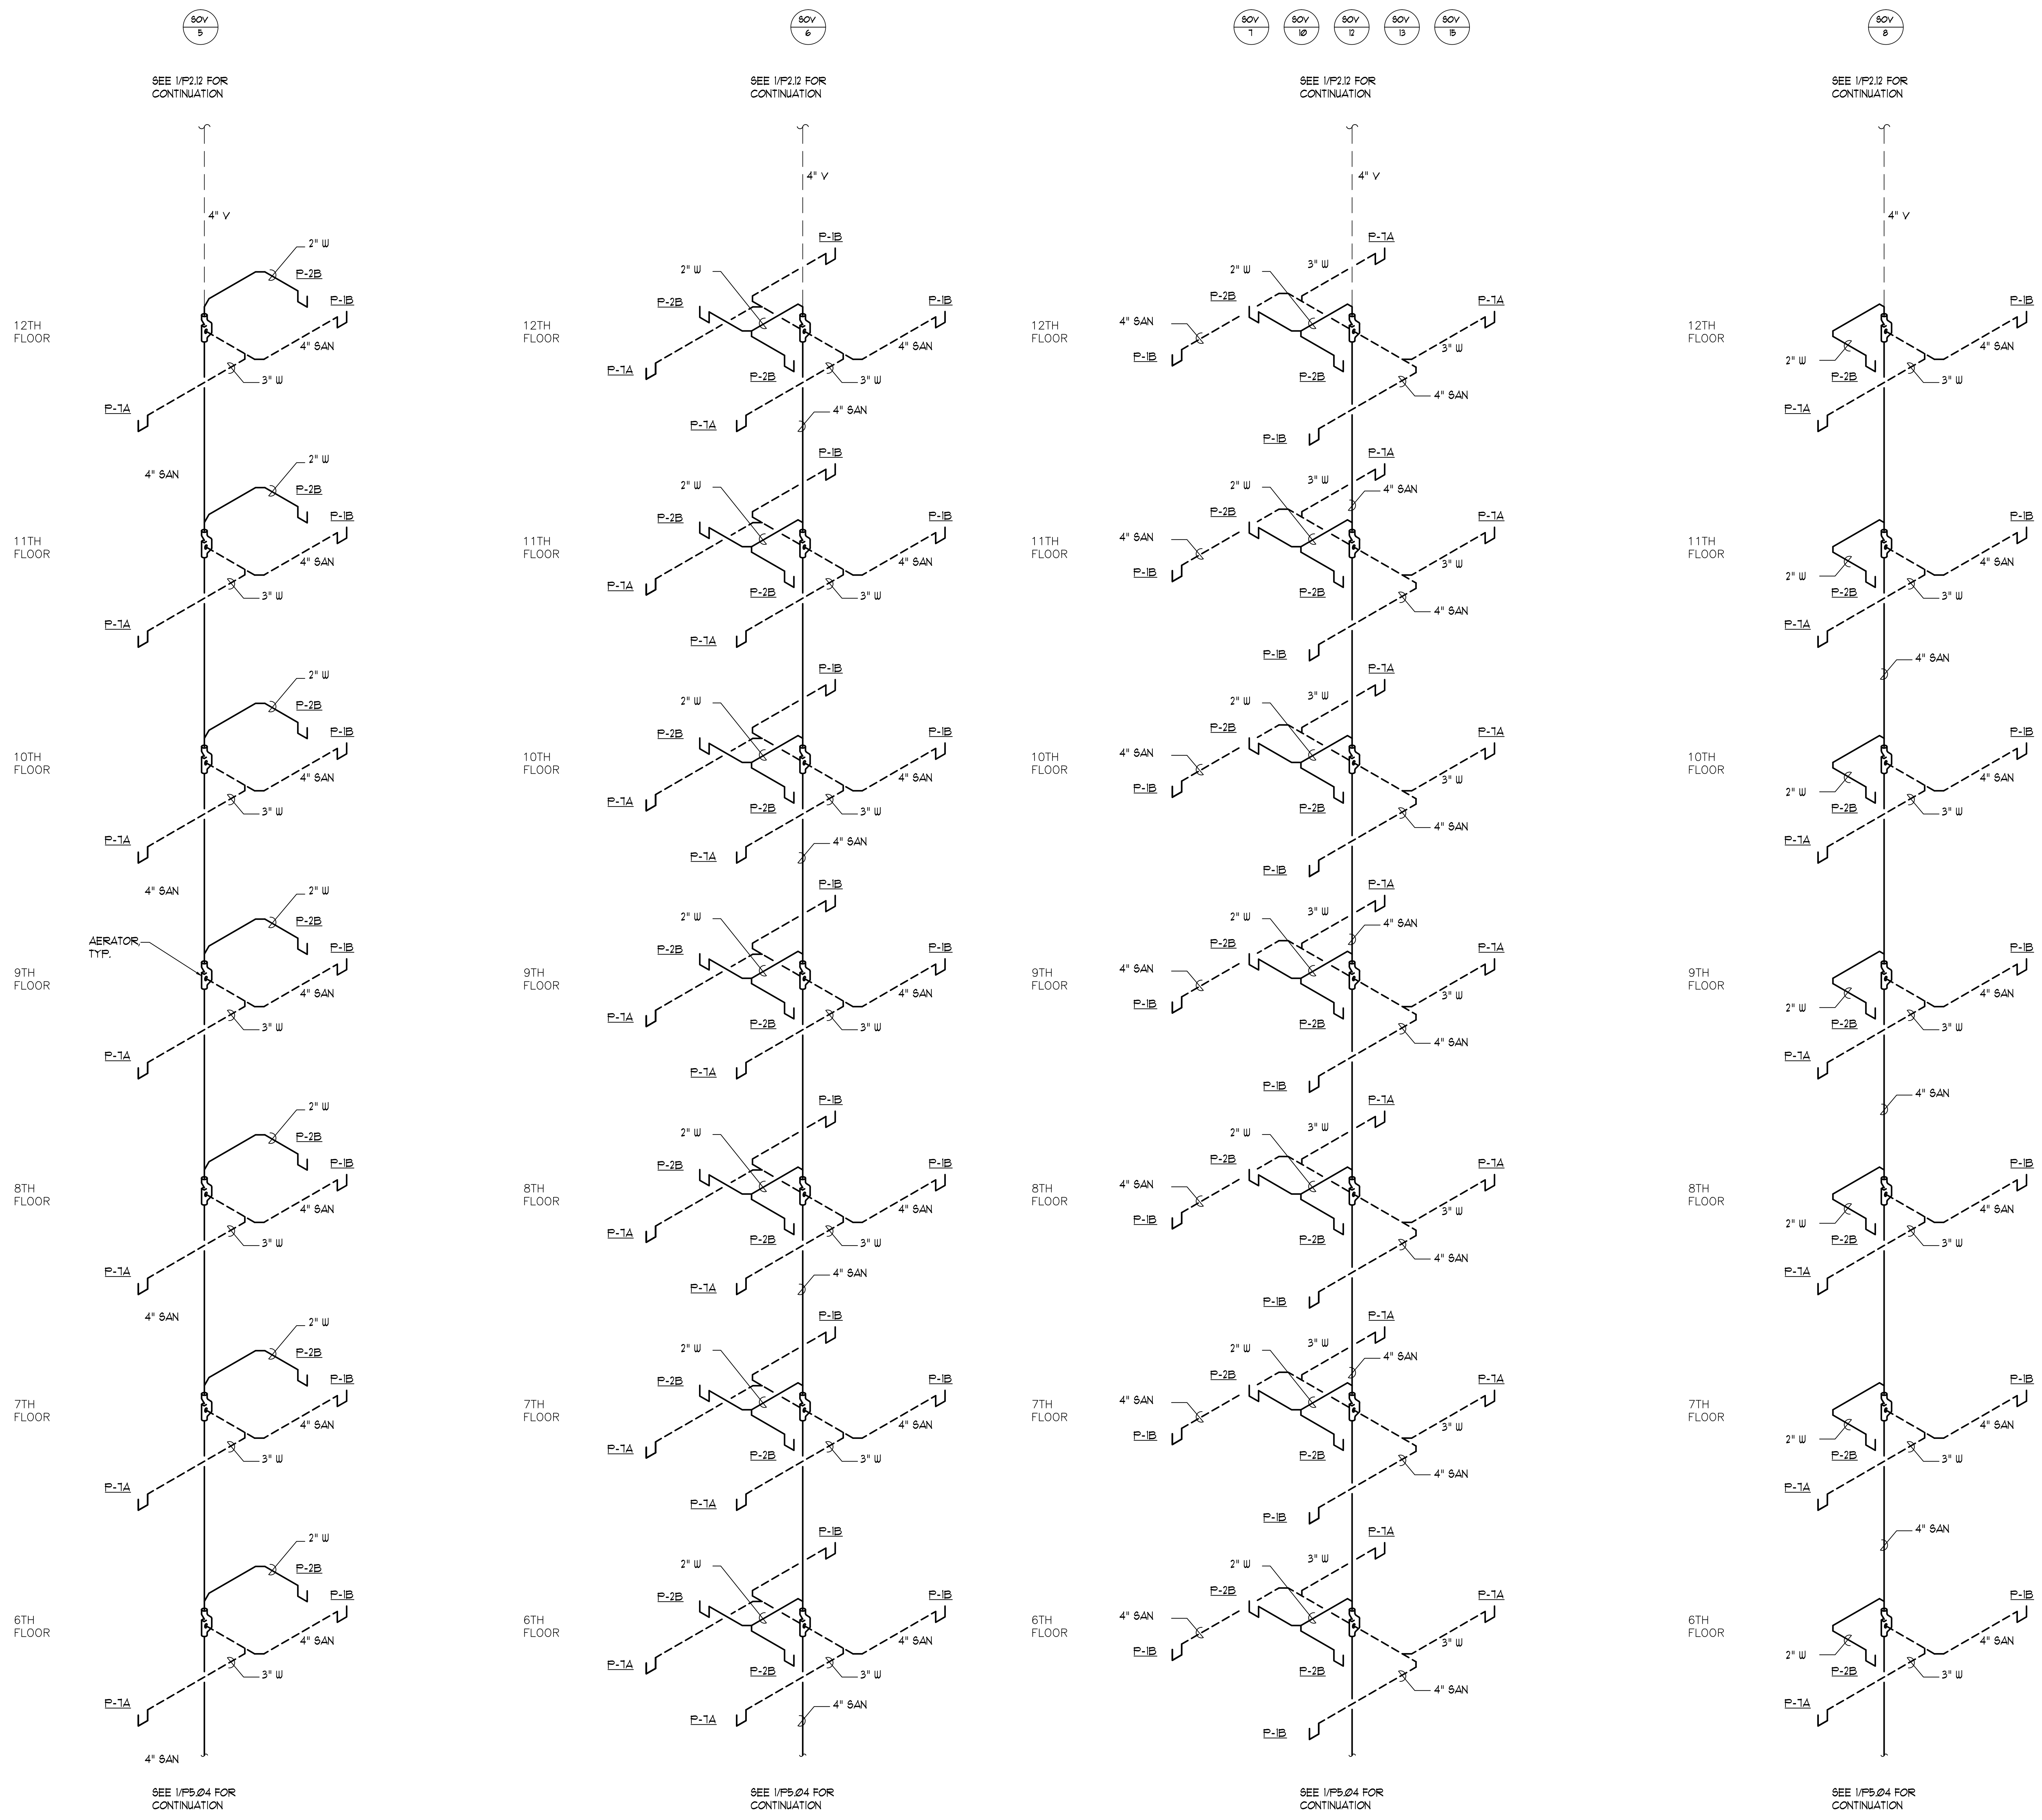

1 GUESTROOM SOVENT RISER DIAGRAM (FLOORS 6-12)
P5.03 NO SCALE

ALPHARETTA CONFERENCE
CENTER & THE HOTEL AT
AVALON


9000 AVALON BOULEVARD /
ALPHARETTA, GEORGIA 30009

STORMONT HOSPITALITY GROUP, LLC /
NORTH AMERICAN PROPERTY GROUP


GUESTROOM
RISER DIAGRAMS

K. PRICE	140028
Principal-in-Charge	BW&A Project No.
G. JENKINS	101716
Project Engineer	Date
T. MERCER	
Checker	

P5.03

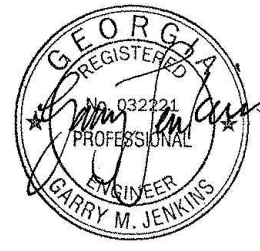

ISSUANCES		
No.	Drawing Issue Description	Date
1	BUILDING PERMIT	2016.10.17

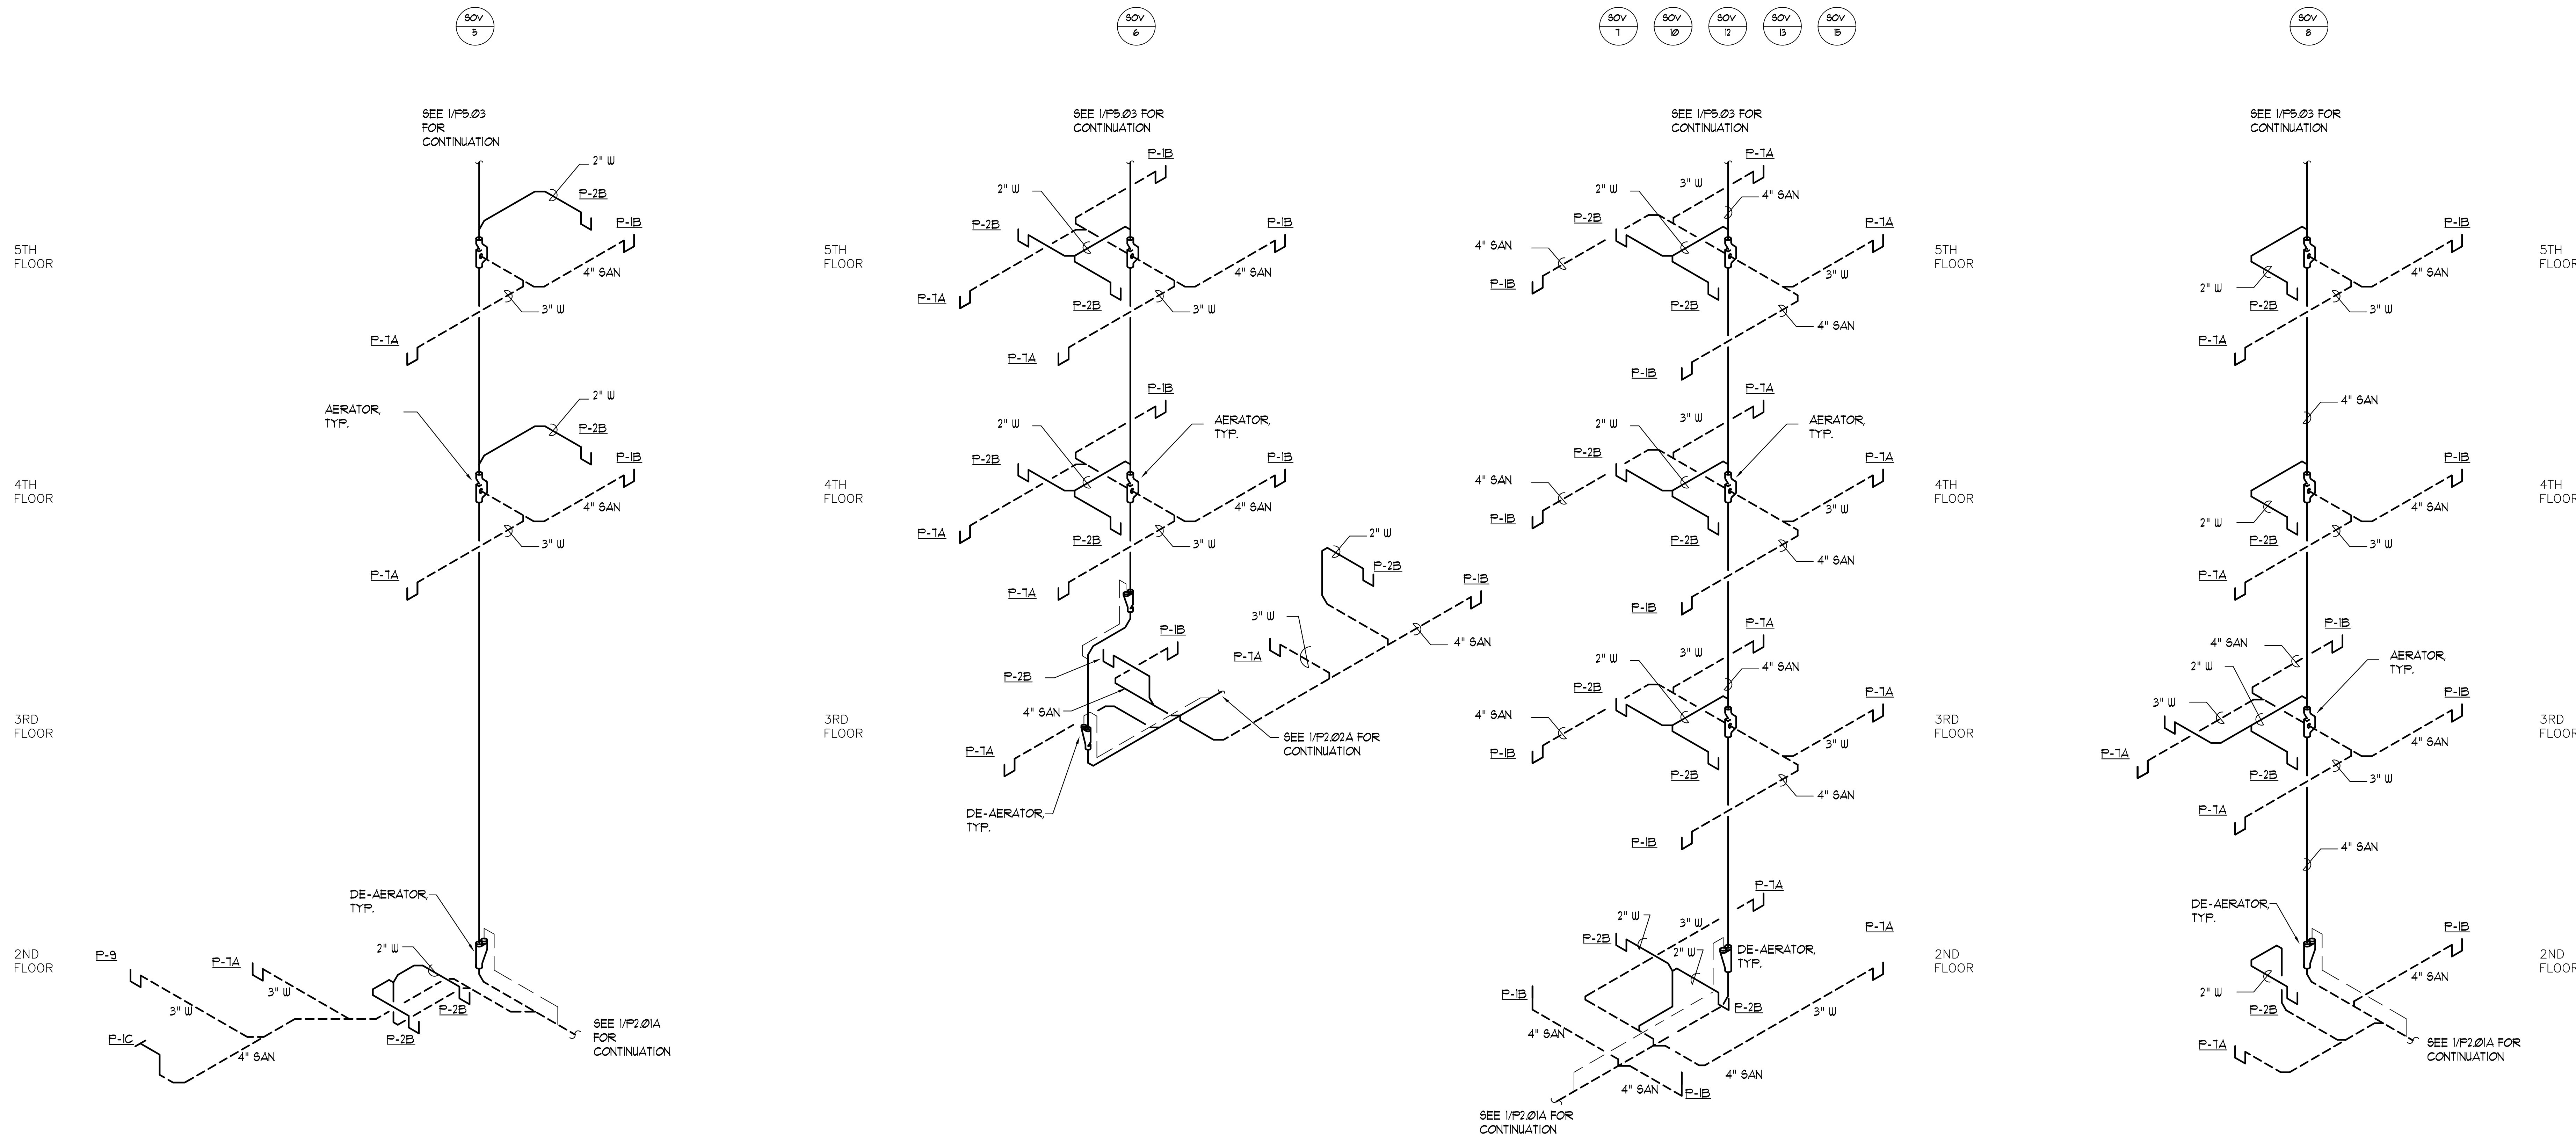

1 GUESTROOM SOVENT RISER DIAGRAM (FLOORS 6-12)
P5.04 NO SCALE

ALPHARETTA CONFERENCE
CENTER & THE HOTEL AT
AVALON


9000 AVALON BOULEVARD /
ALPHARETTA, GEORGIA 30009

STORMONT HOSPITALITY GROUP, LLC /
NORTH AMERICAN PROPERTY GROUP

GUESTROOM
RISER DIAGRAMS

K. PRICE	140028
Principal in Charge	BW&A Project No.
G. JENKINS	101716
Project Engineer	Date
T. MERCER	
Checker	

P5.04

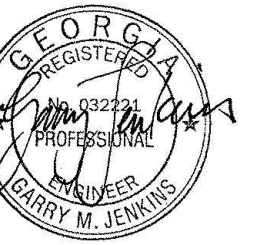

ISSUANCES		
No.	Drawing Issue Description	Date
1	BUILDING PERMIT	2016.10.17

ALPHARETTA CONFERENCE
CENTER & THE HOTEL AT
AVALON

9000 AVALON BOULEVARD /
ALPHARETTA, GEORGIA 30009





STORMONT HOSPITALITY GROUP, LLC /
NORTH AMERICAN PROPERTY GROUP

GUESTROOM
RISER DIAGRAMS


K. PRICE	140028
Principal in Charge	BW&A Project No.
G. JENKINS	101716
Project Engineer	Date
T. MERCER	
Checker	

P5.05





ISSUED FOR CONSTRUCTION

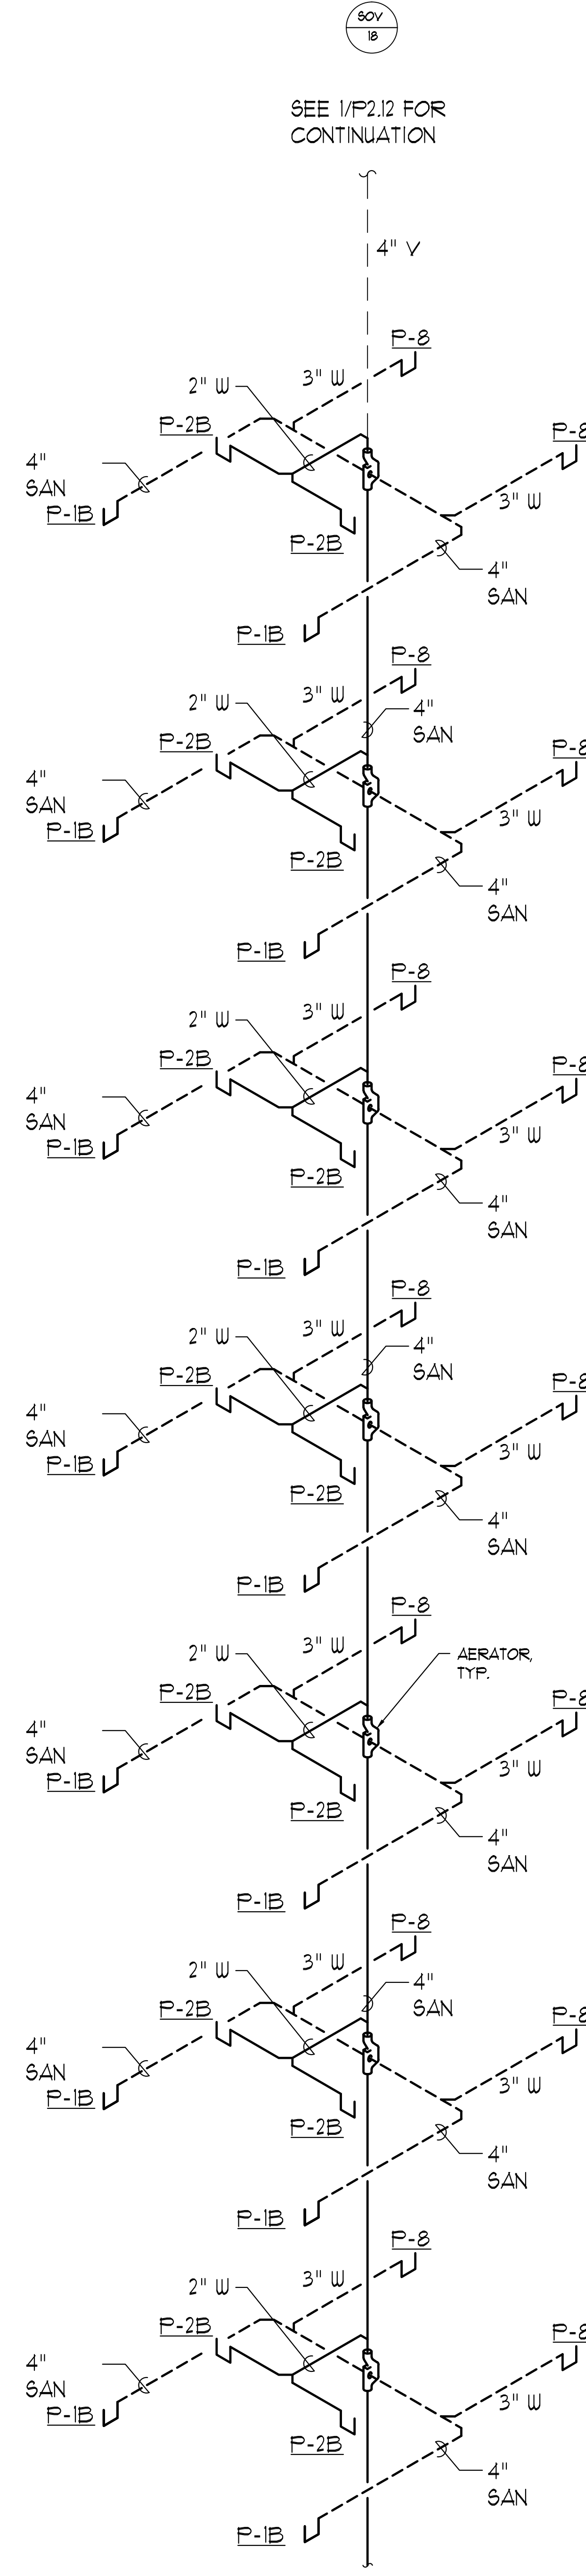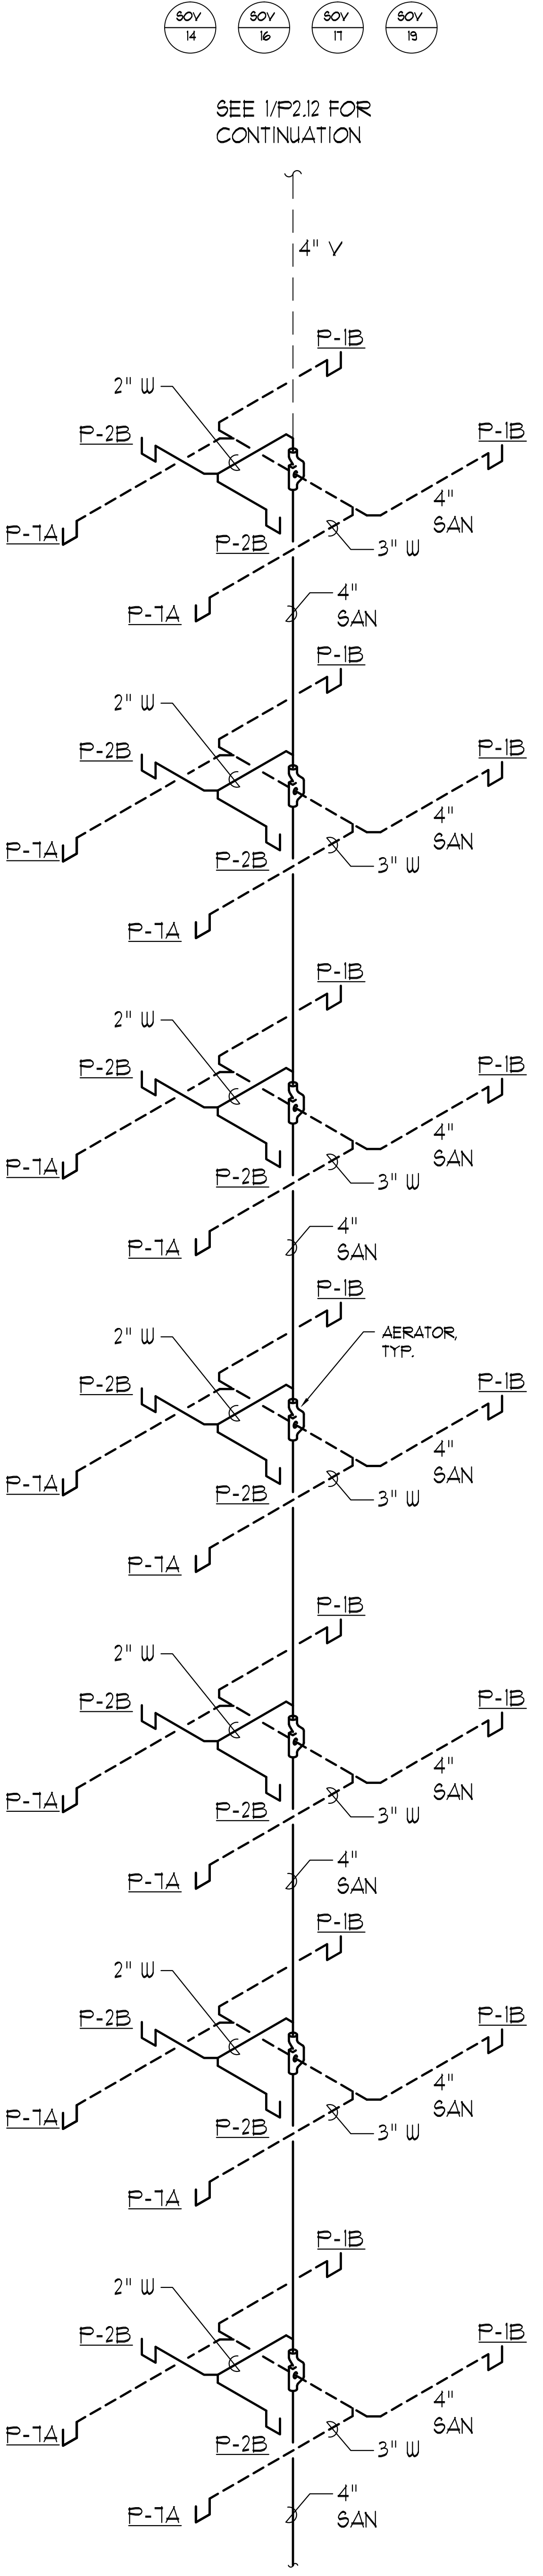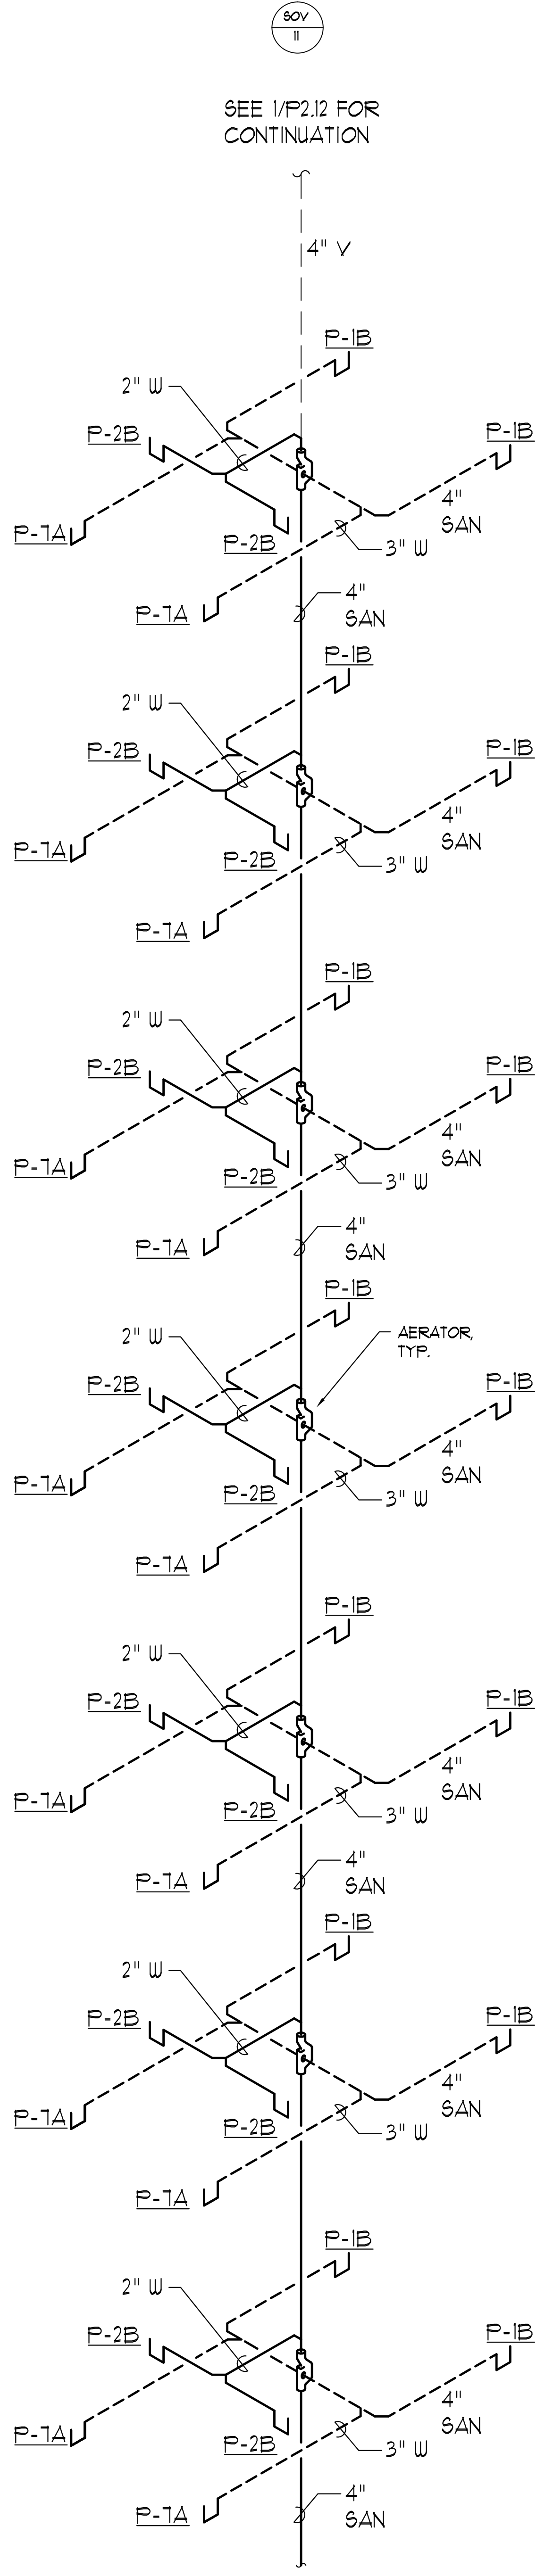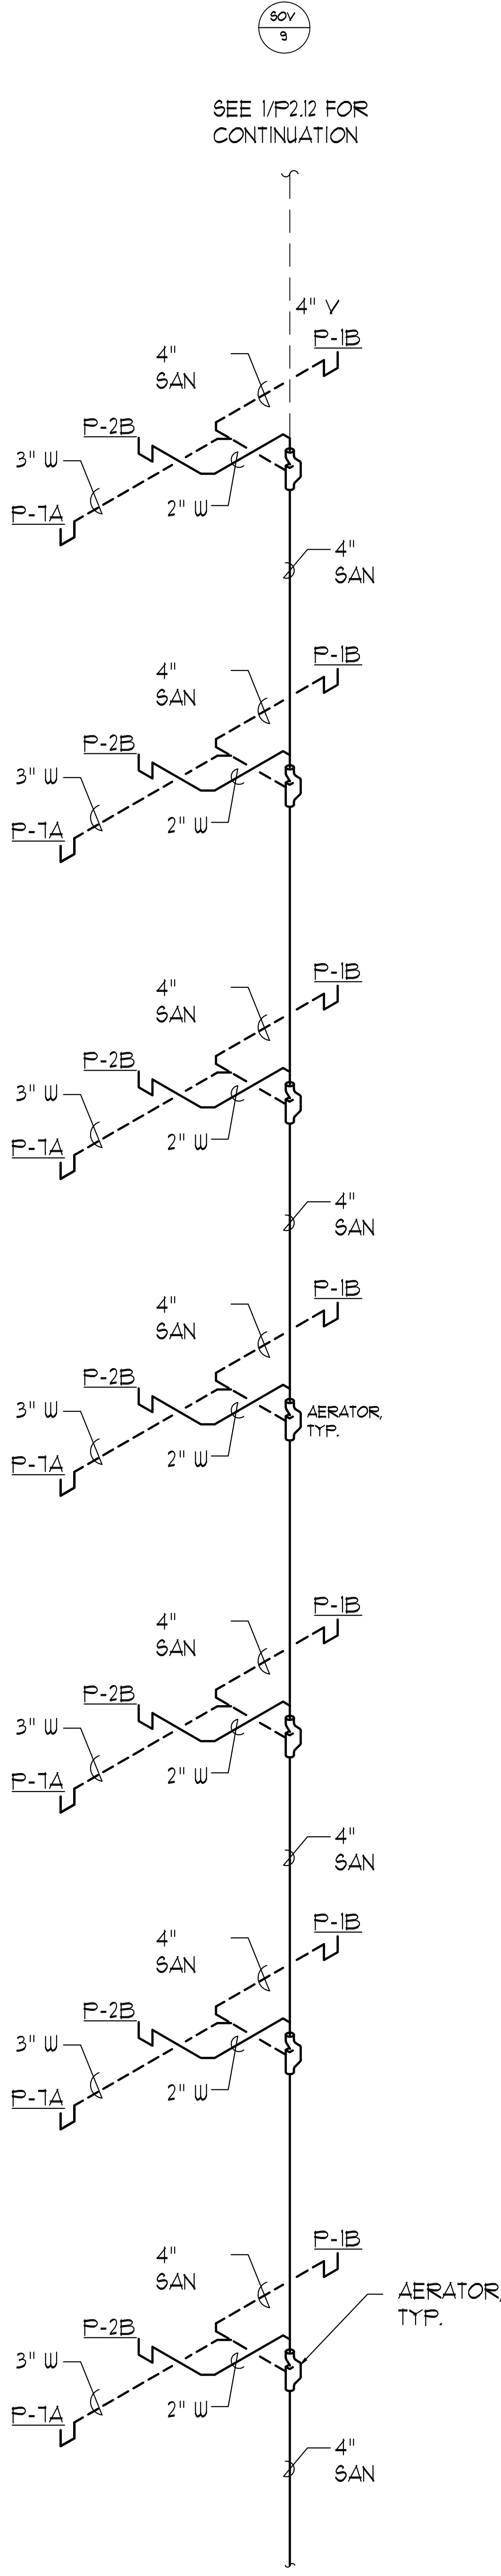

1 GUESTROOM SOVENT RISER DIAGRAM (FLOORS 6-12)
P5.05 NO SCALE

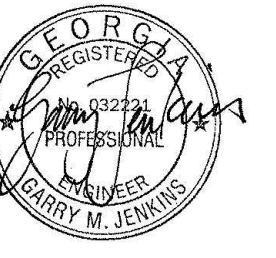


ISSUANCES		
No.	Drawing Issue Description	Date
1	BUILDING PERMIT	2016.10.17

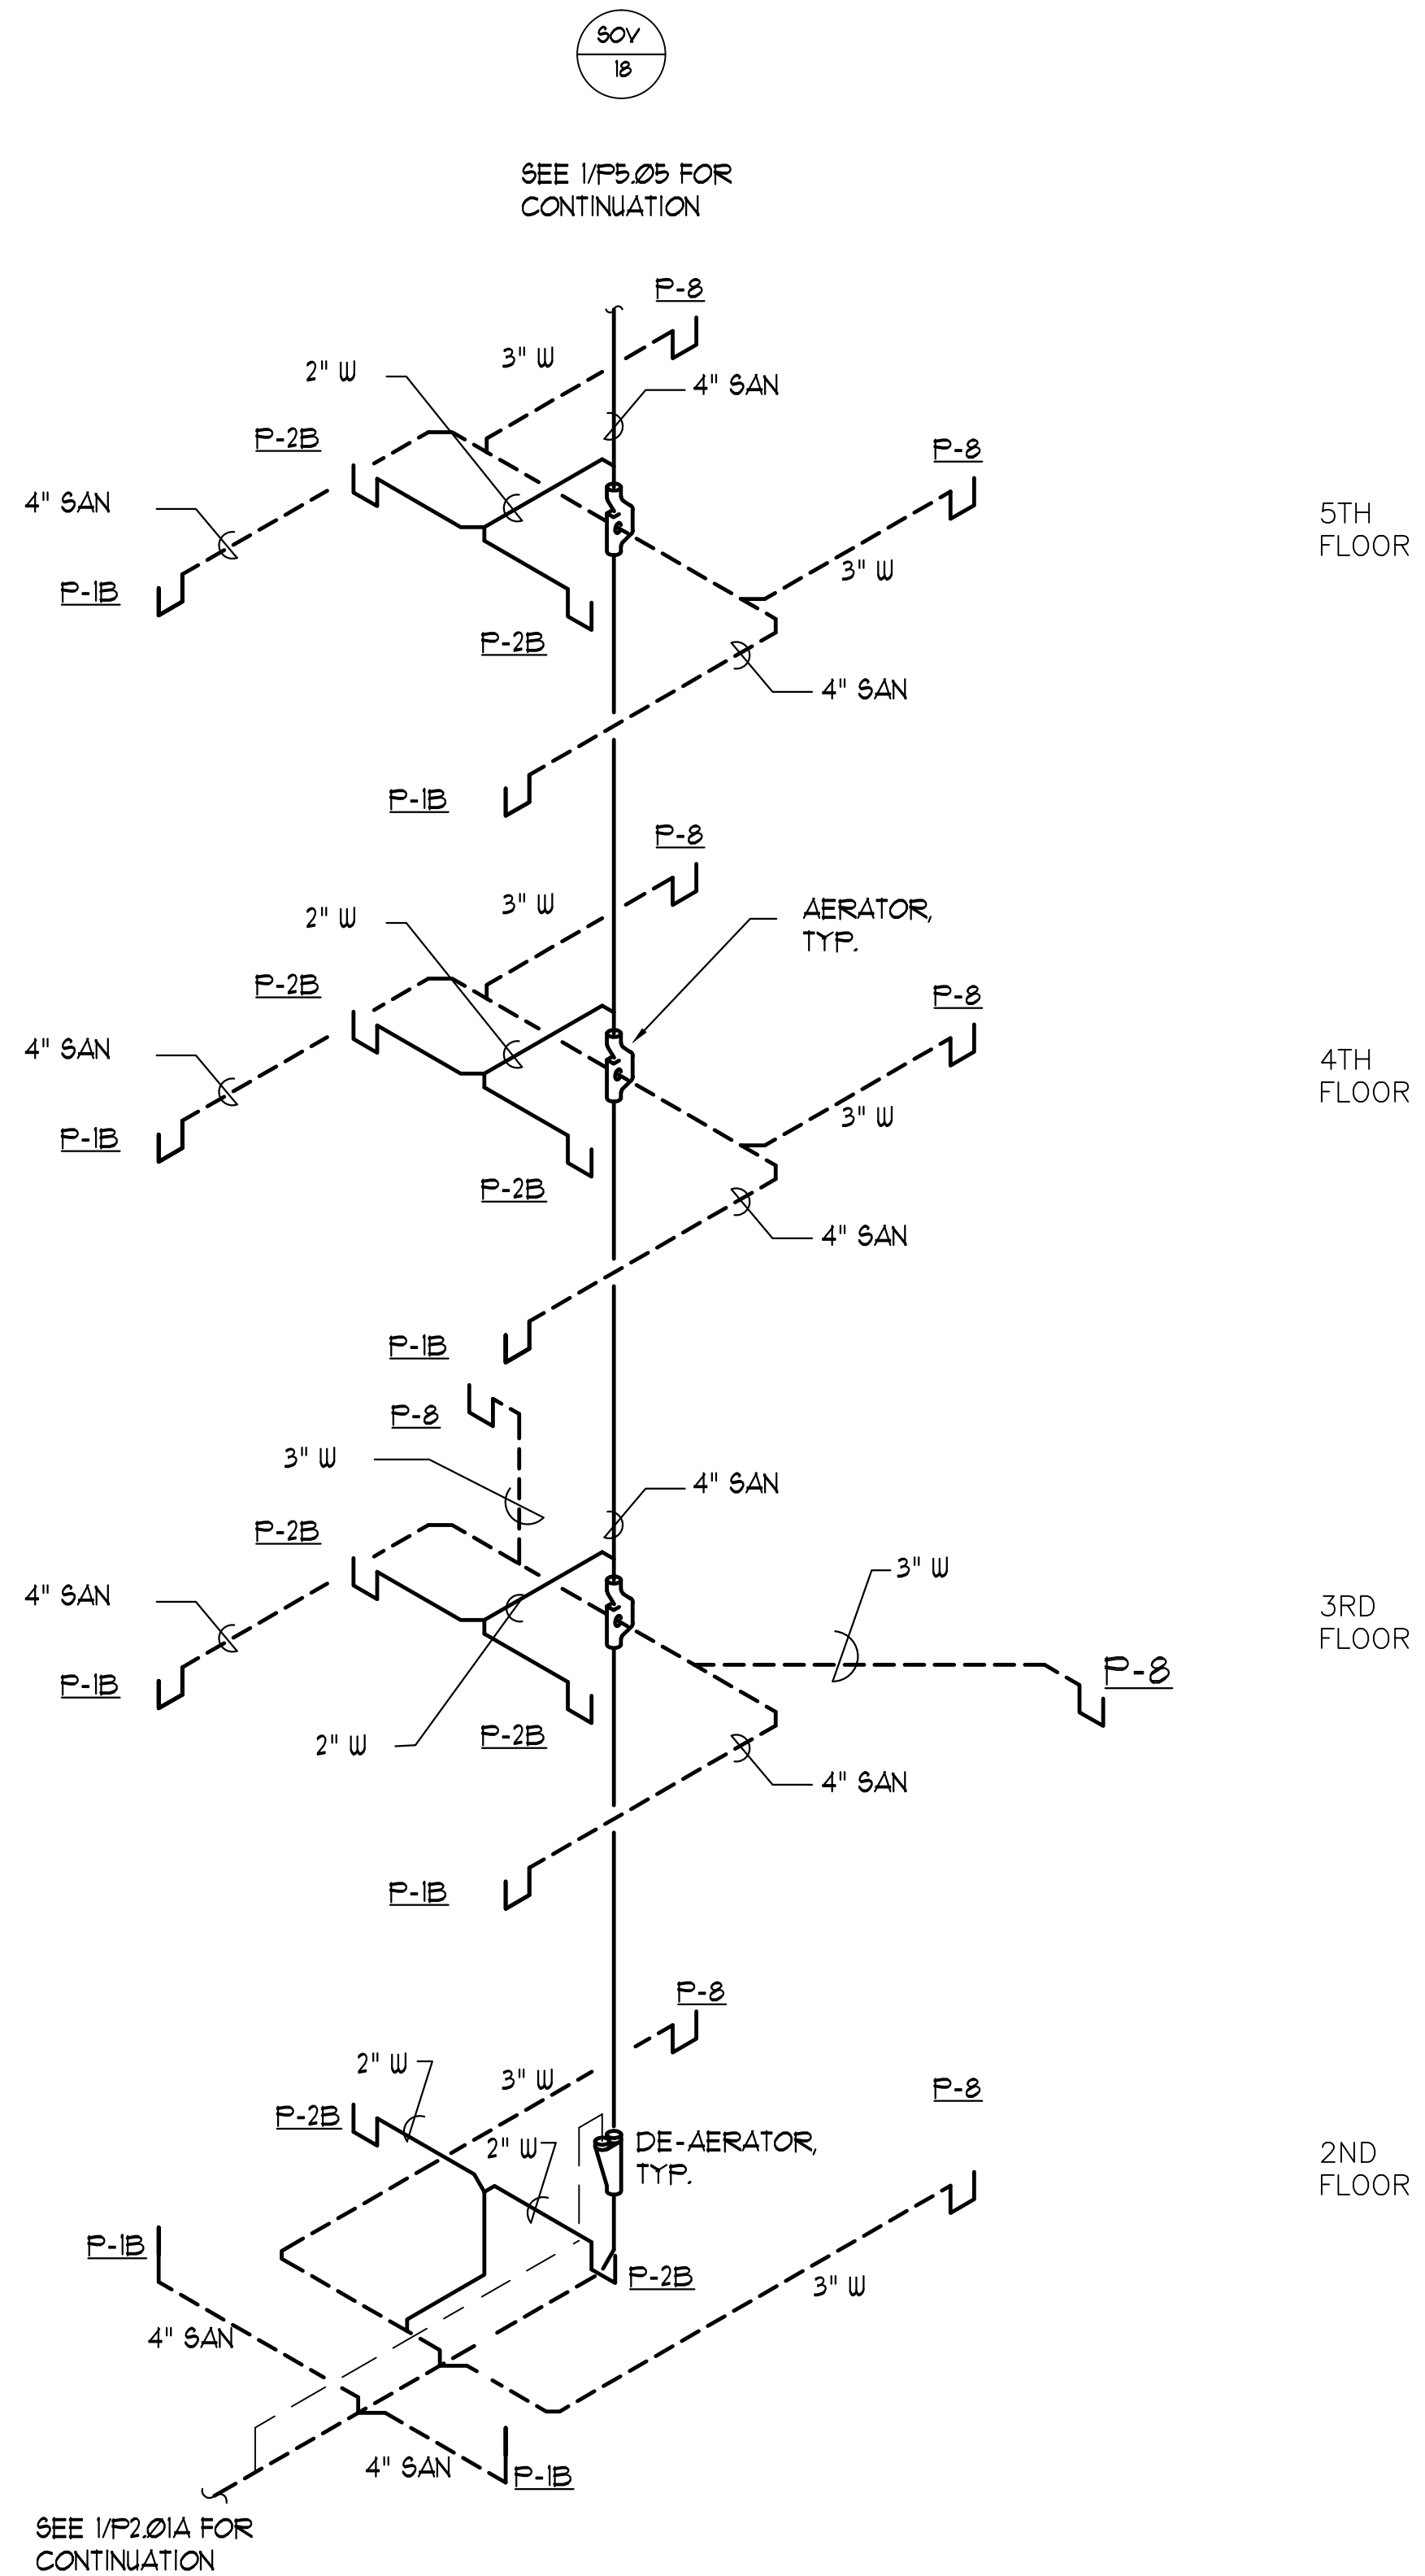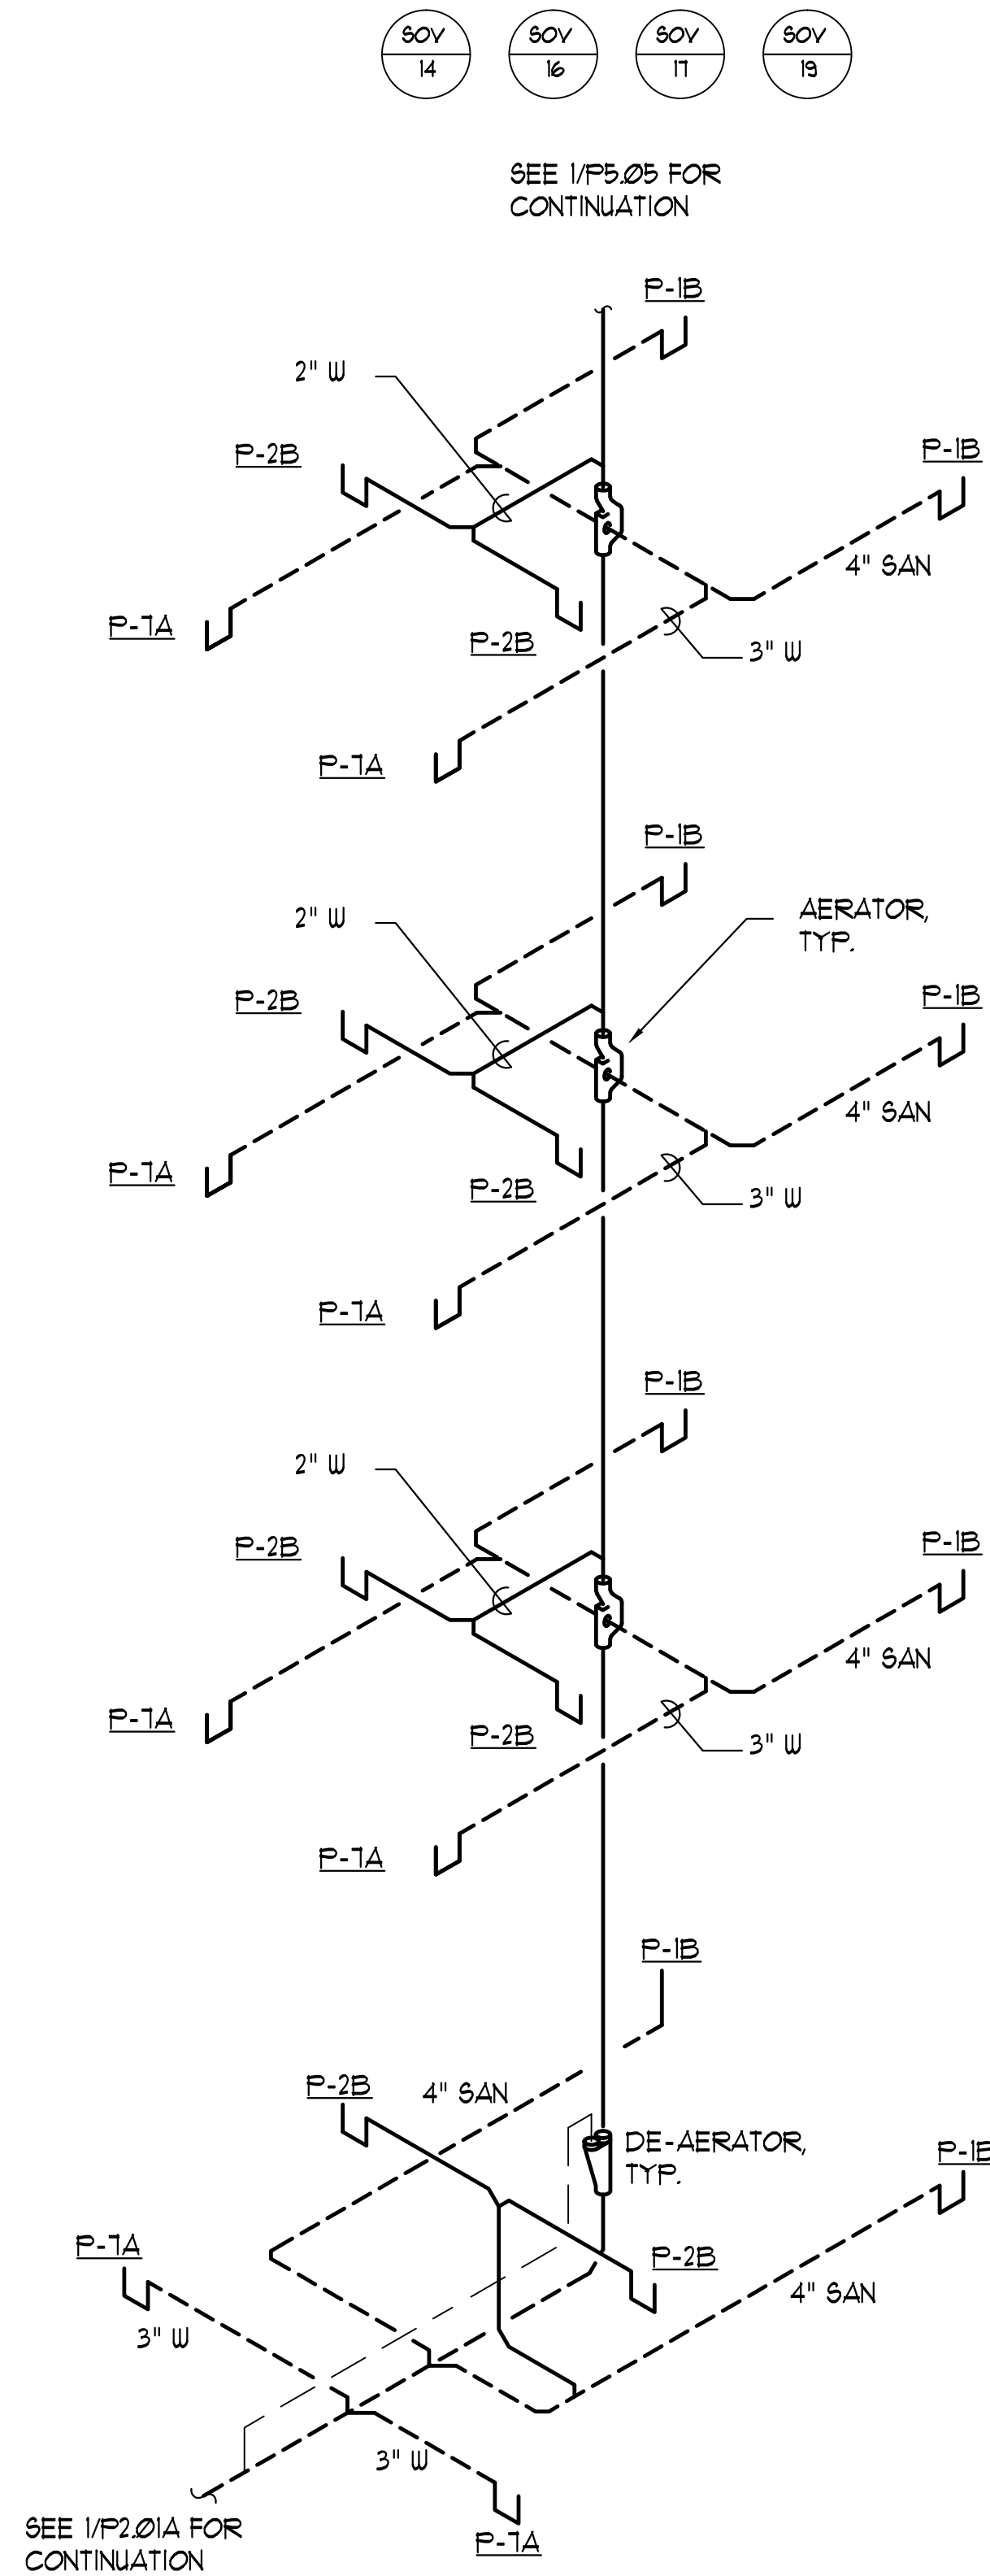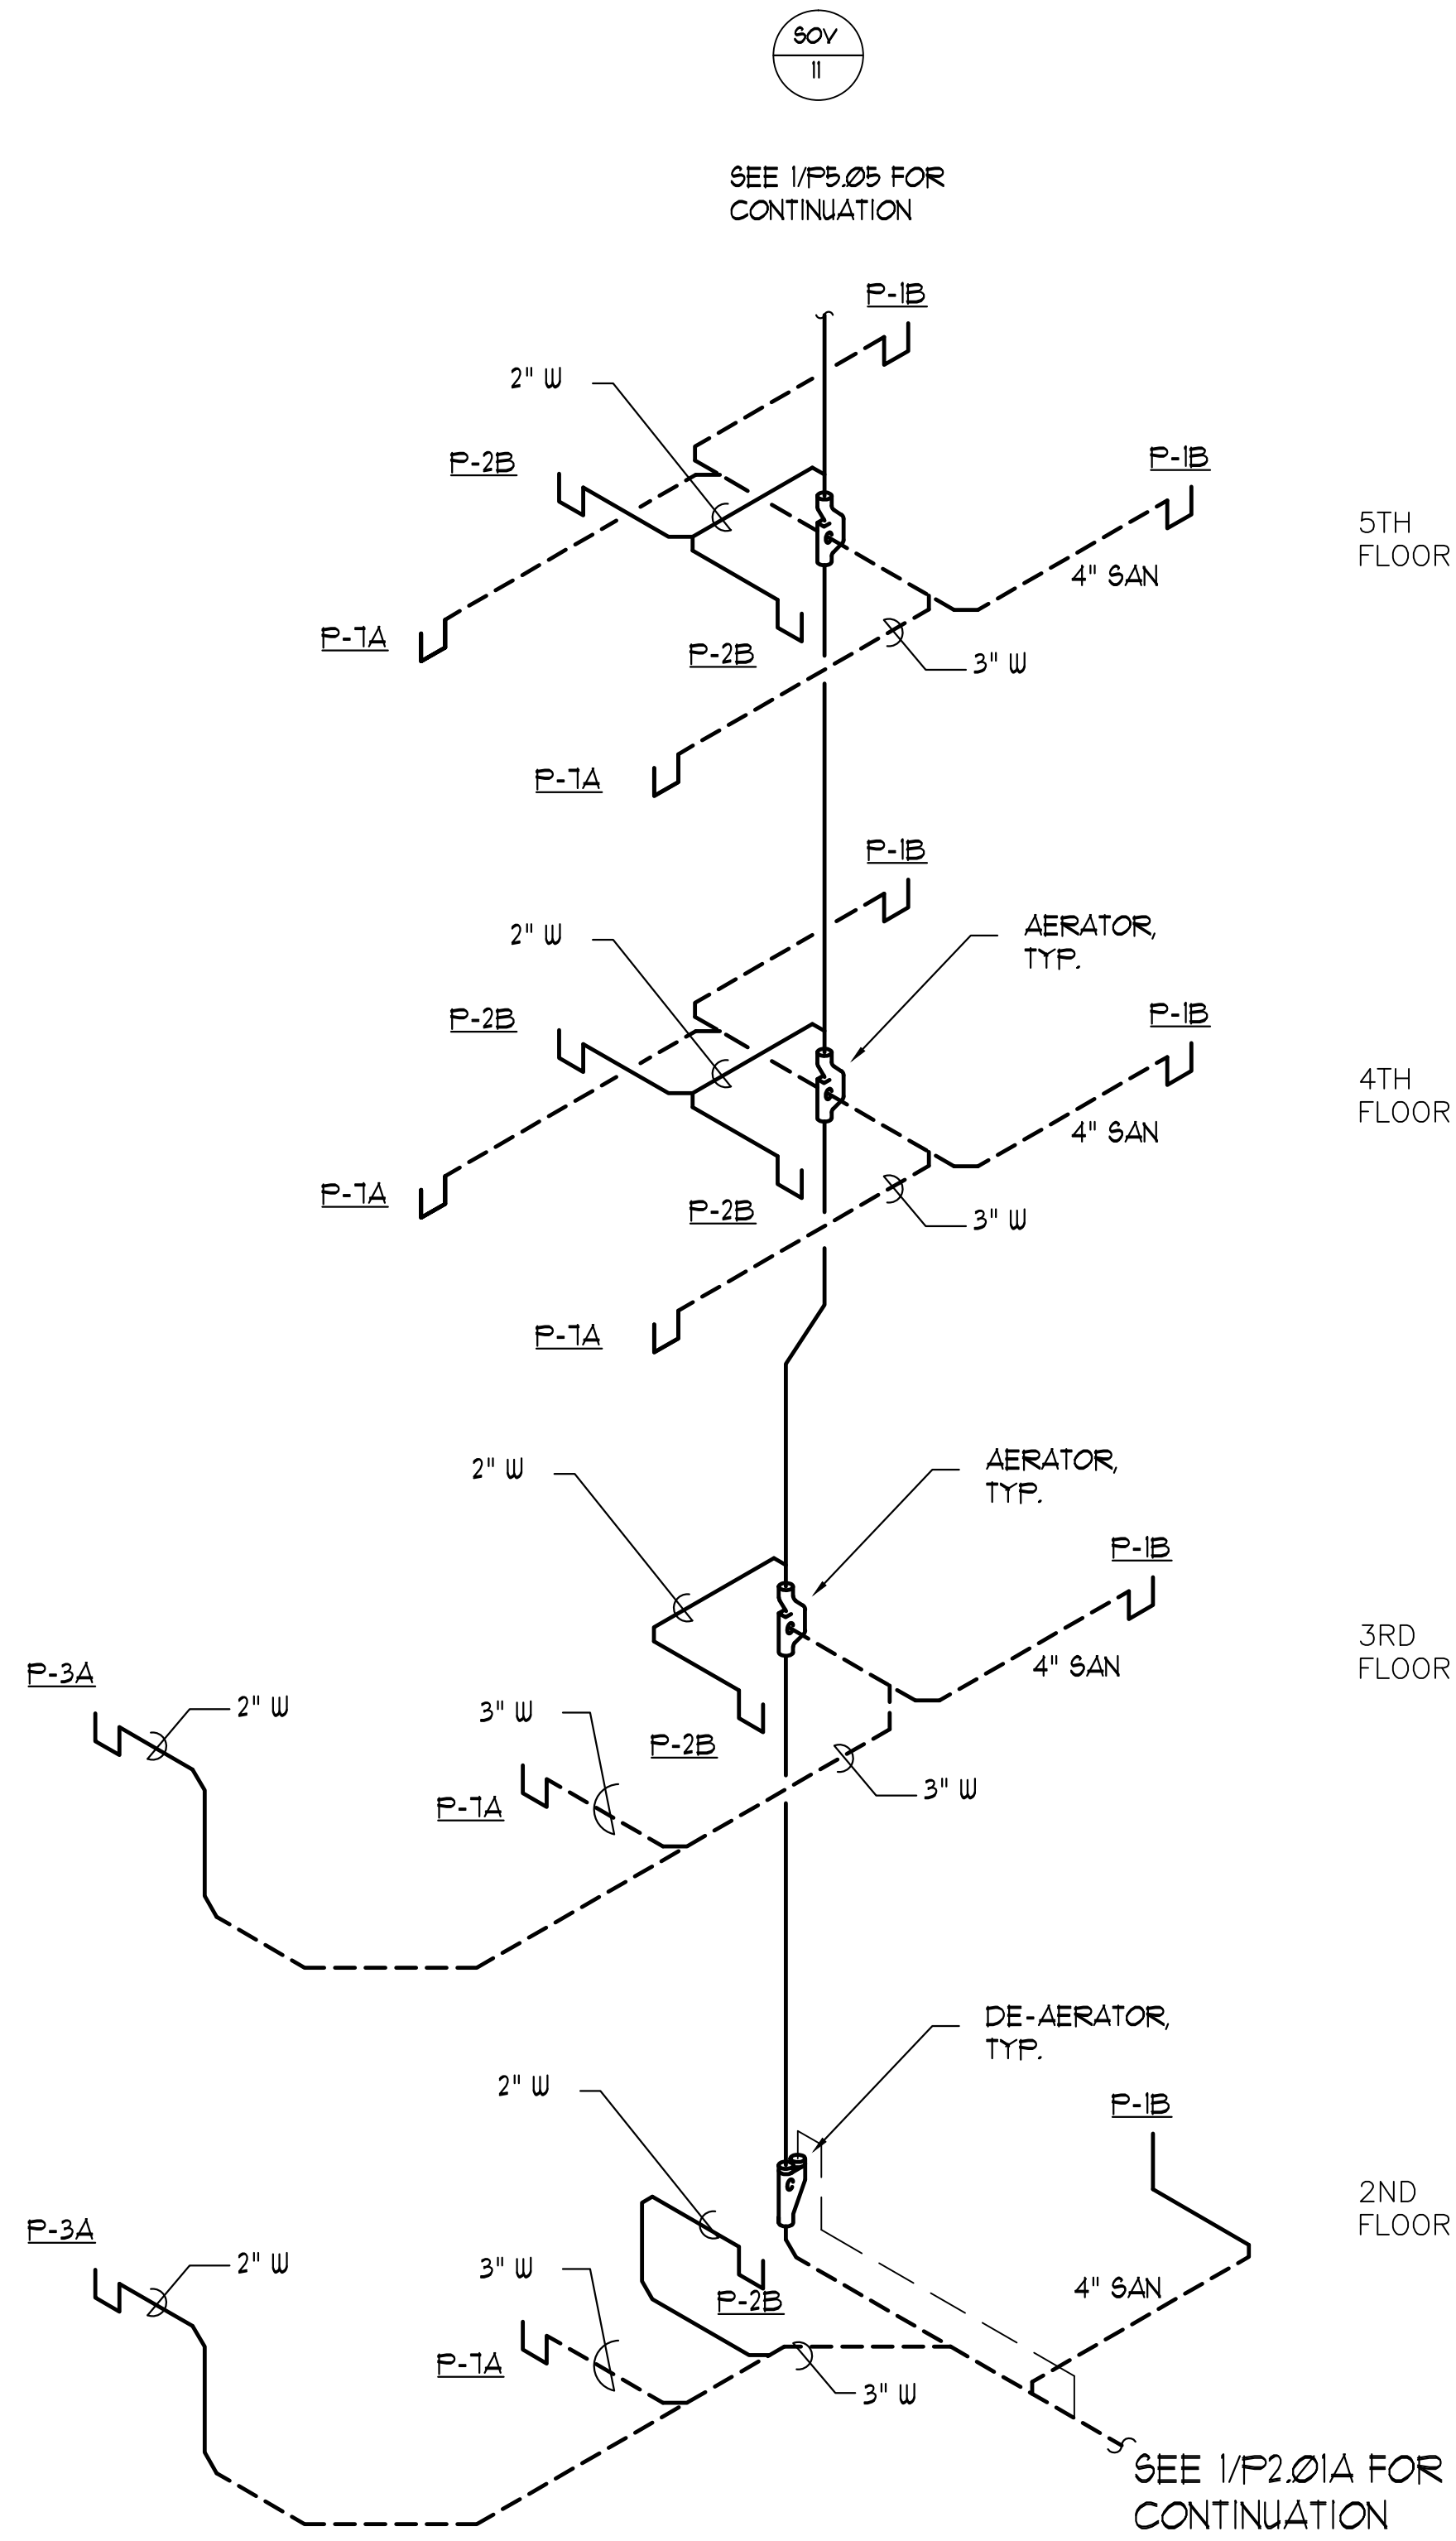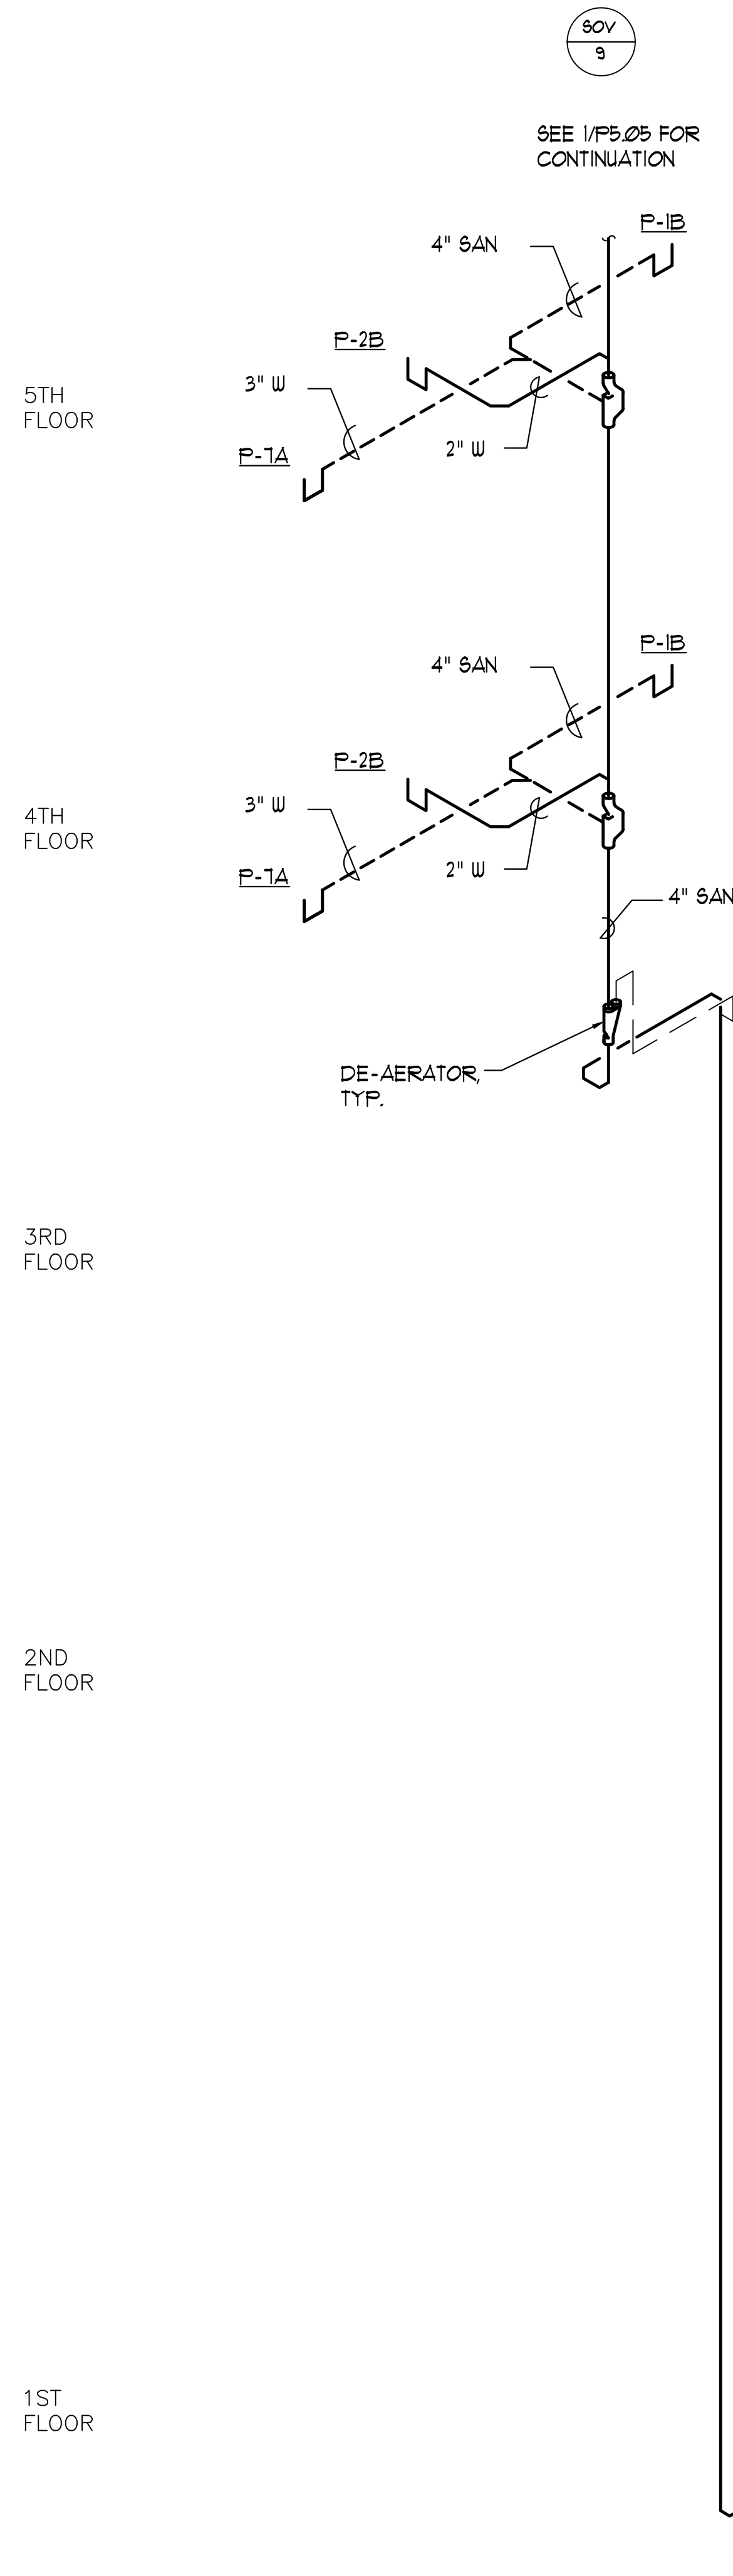



ISSUANCES		
No.	Drawing Issue Description	Date
	BUILDING PERMIT	2016.10.17

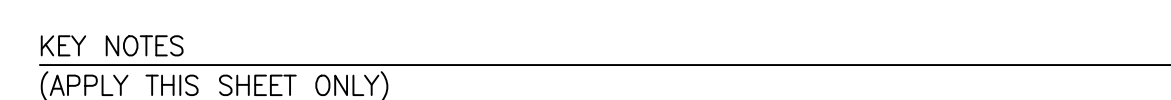

- ① SEE 1/P5.11 TYPICAL GUESTROOM DOMESTIC WATER RISER DIAGRAM FOR CONTINUATION.
- ② SEE 2/P5.11 TYPICAL GUESTROOM DOMESTIC WATER RISER DIAGRAM FOR CONTINUATION.
- ③ SEE 3/P5.11 TYPICAL GUESTROOM DOMESTIC WATER RISER DIAGRAM FOR CONTINUATION.

1 GUESTROOM DOMESTIC WATER RISER DIAGRAM (FLOORS 8-12)
P5.07 NO SCALE

ALPHARETTA CONFERENCE
CENTER & THE HOTEL AT
AVALON

9000 AVALON BOULEVARD /
ALPHARETTA, GEORGIA 30009

STORMONT HOSPITALITY GROUP, LLC
NORTH AMERICAN PROPERTY GROUP


GUESTROOM RISER DIAGRAMS

K. PRICE	140028
Principal-in-Charge	BUSA Project No.
G. JENKINS	10/17/16
Project Engineer	Date
T. MERCER	

P5.07



ISSUANCES		
No.	Drawing Issue Description	Date
1	BUILDING PERMIT	2016.10.17

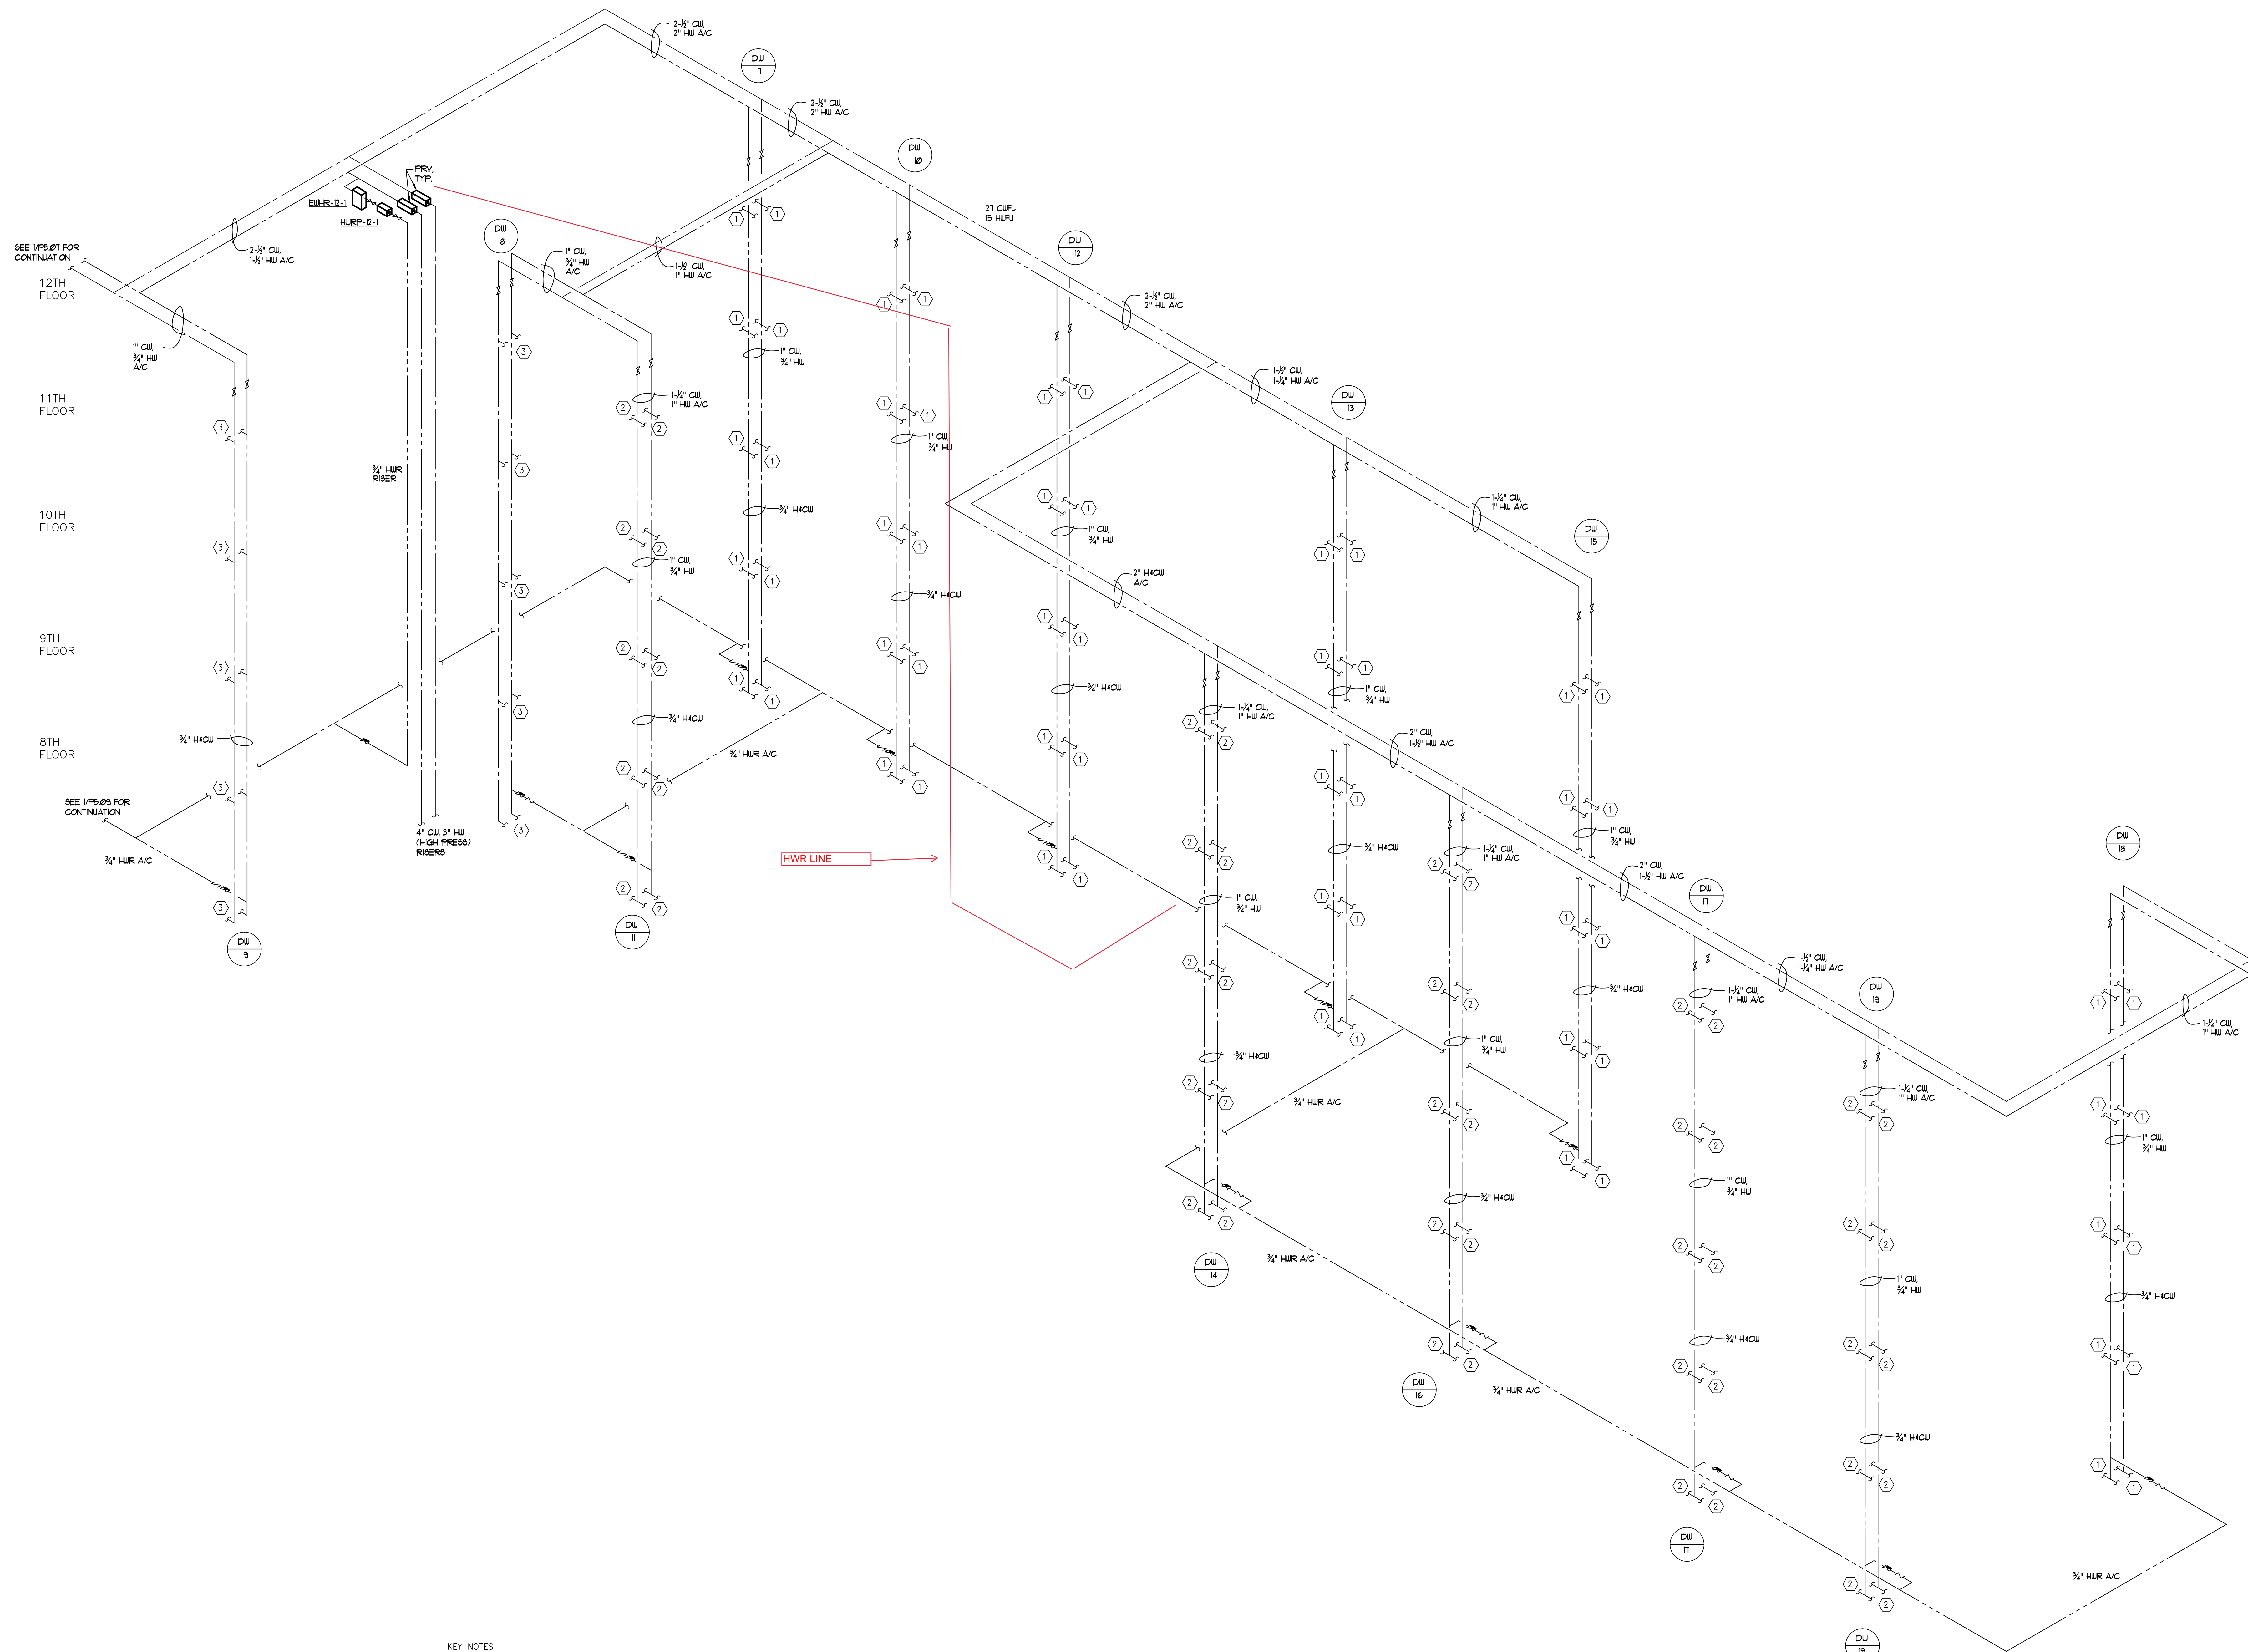

KEY NOTES
(APPLY THIS SHEET ONLY)

- SEE 1/P5.11 TYPICAL GUESTROOM DOMESTIC WATER RISER DIAGRAM FOR CONTINUATION.
- SEE 2/P5.11 TYPICAL GUESTROOM DOMESTIC WATER RISER DIAGRAM FOR CONTINUATION.
- SEE 3/P5.11 TYPICAL GUESTROOM DOMESTIC WATER RISER DIAGRAM FOR CONTINUATION.

1
P5.08
GUESTROOM DOMESTIC WATER RISER DIAGRAM (FLOORS 8-12)
NO SCALE

ALPHARETTA CONFERENCE
CENTER & THE HOTEL AT
AVALON


9000 AVALON BOULEVARD /
ALPHARETTA, GEORGIA 30009

STORMONT HOSPITALITY GROUP, LLC /
NORTH AMERICAN PROPERTY GROUP

GUESTROOM
RISER DIAGRAMS

K. PRICE	140028
Principal-in-Charge	BW&A Project No.
G. JENKINS	101716
Project Engineer	Date
T. MERCER	
Drawn By	

P5.08

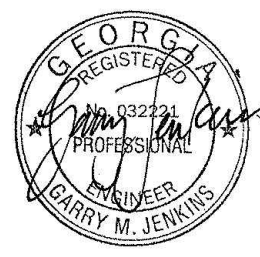

ISSUANCES		
No.	Drawing Issue Description	Date
1	BUILDING PERMIT	2016.10.17

7TH FLOOR


6TH FLOOR

5TH FLOOR

4TH FLOOR

3RD FLOOR

2ND FLOOR

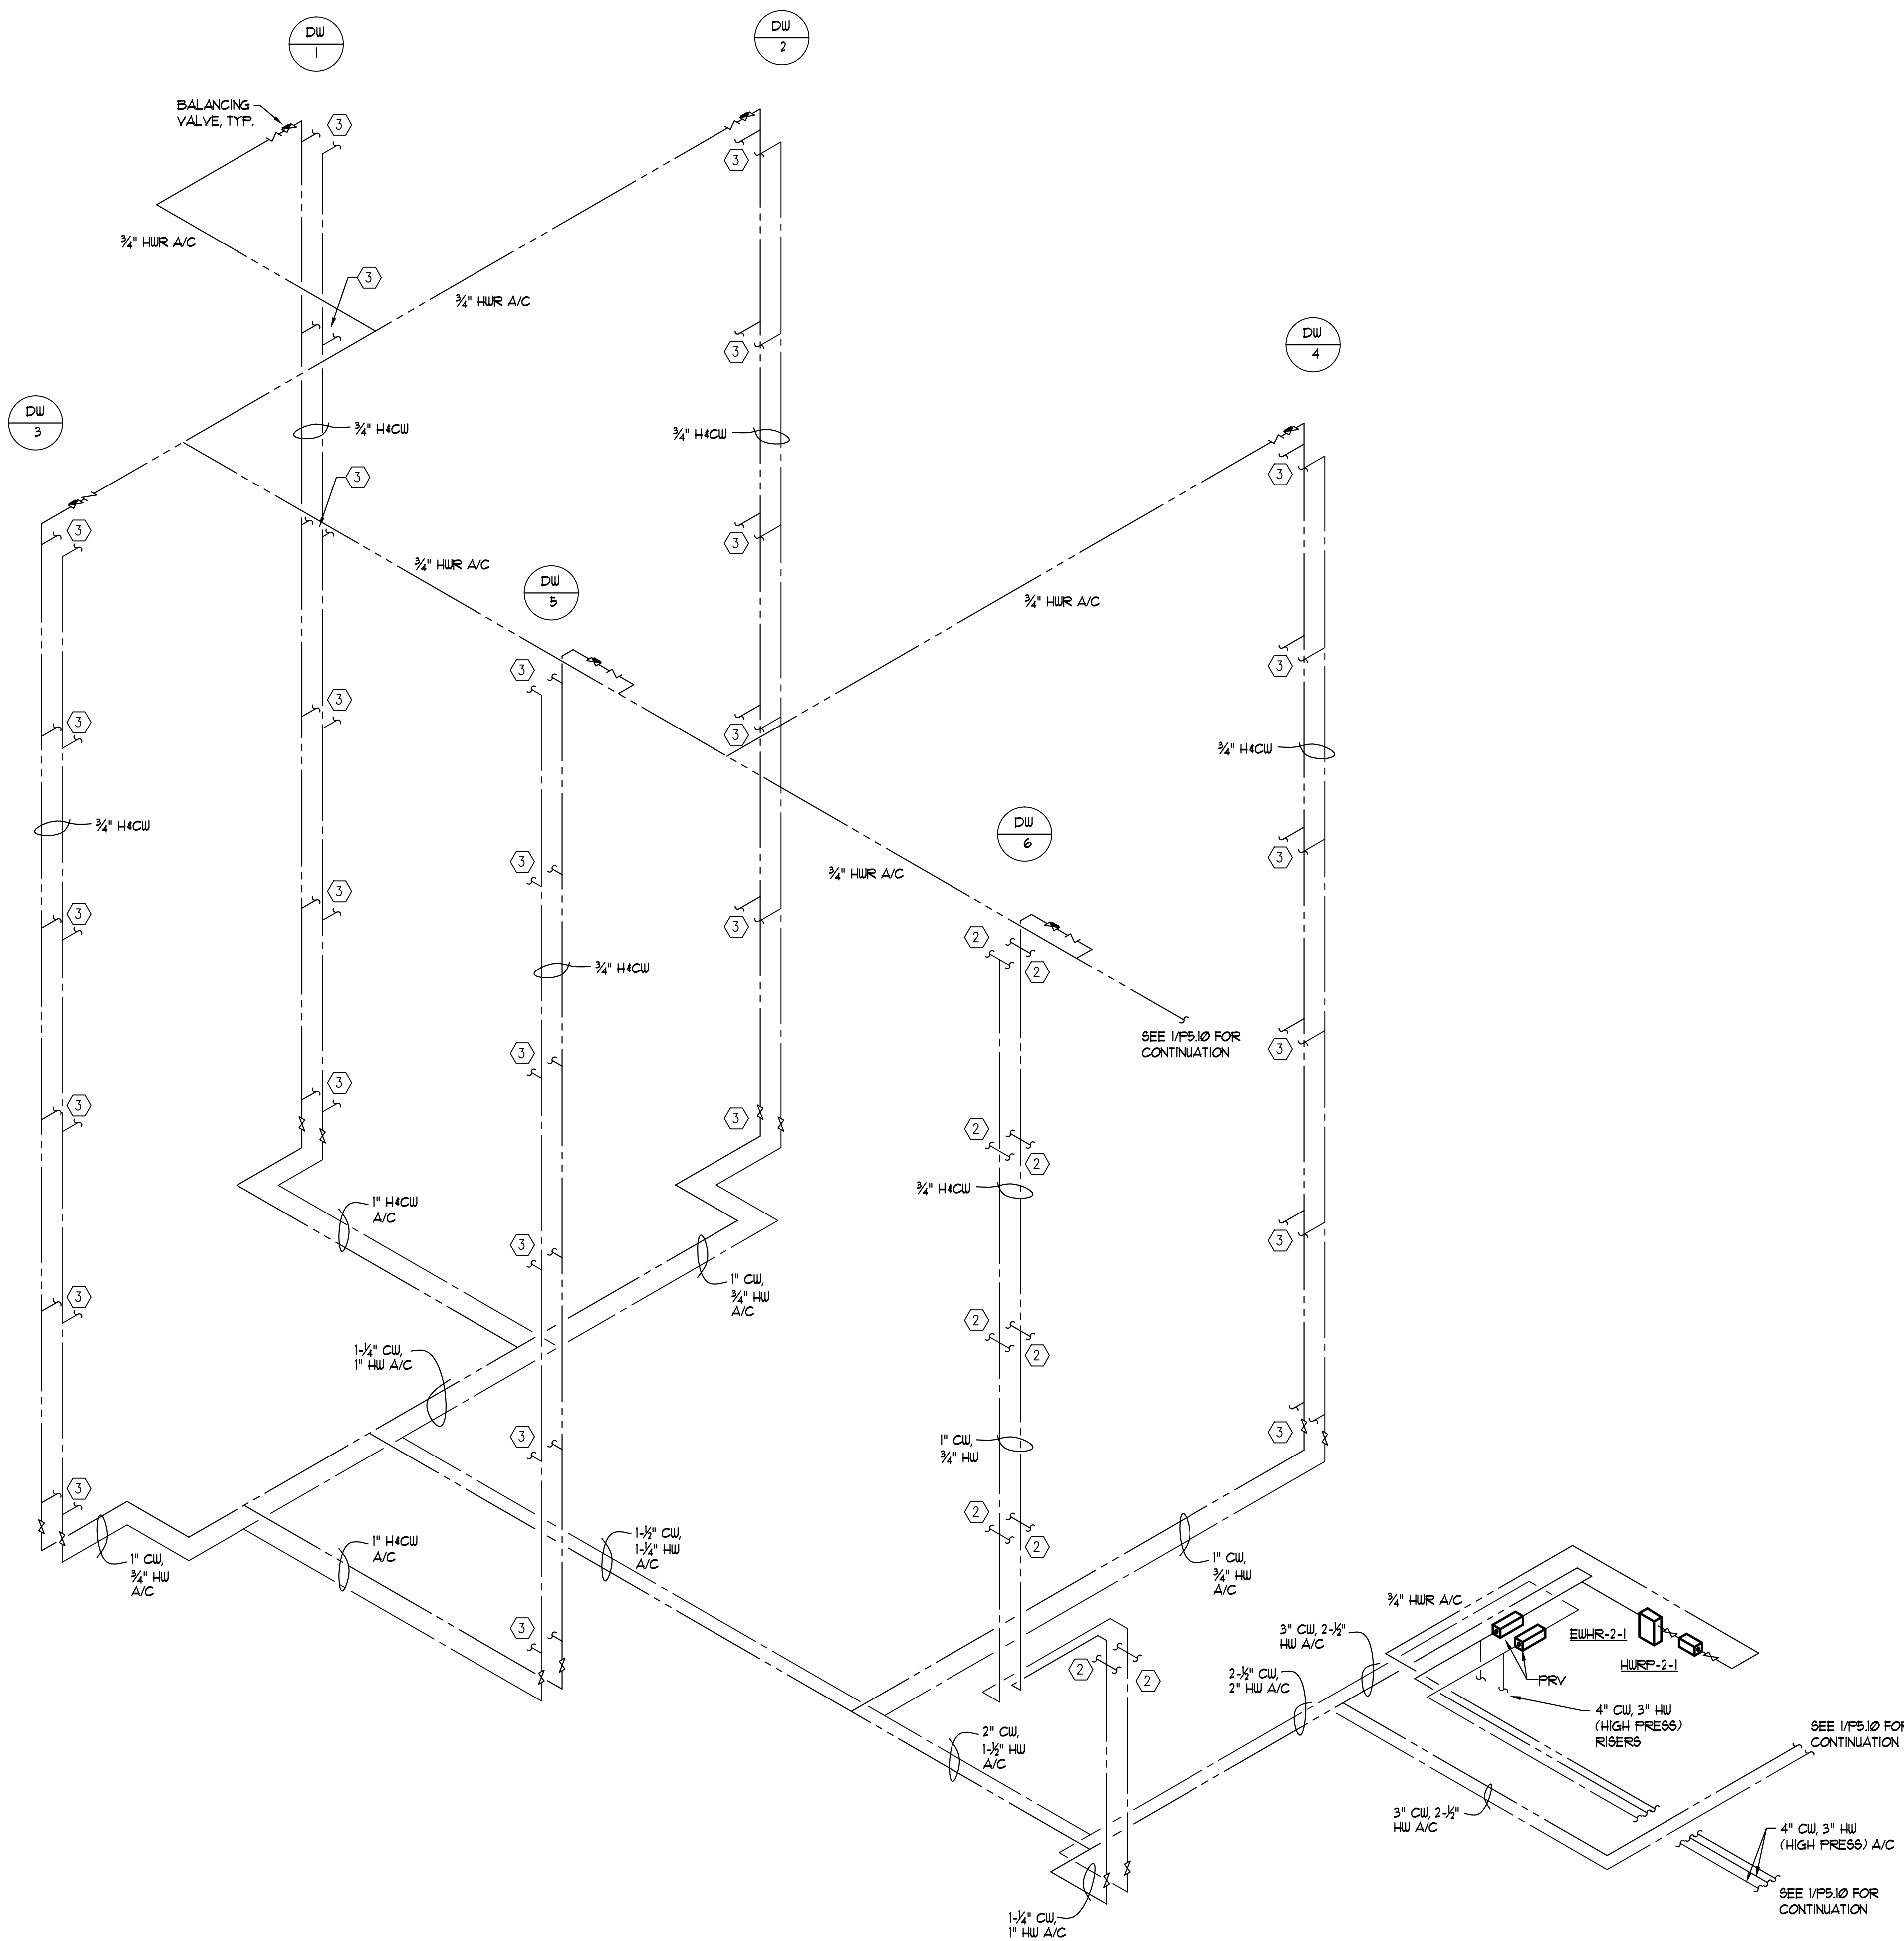

KEY NOTES
(APPLY THIS SHEET ONLY)

- ① SEE 1/P5.11 TYPICAL GUESTROOM DOMESTIC WATER RISER DIAGRAM FOR CONTINUATION.
- ② SEE 2/P5.11 TYPICAL GUESTROOM DOMESTIC WATER RISER DIAGRAM FOR CONTINUATION.
- ③ SEE 3/P5.11 TYPICAL GUESTROOM DOMESTIC WATER RISER DIAGRAM FOR CONTINUATION.

1
P5.09 GUESTROOM DOMESTIC WATER RISER DIAGRAM (FLOORS 2-7)
NO SCALE

ALPHARETTA CONFERENCE
CENTER & THE HOTEL AT
AVALON


9000 AVALON BOULEVARD /
ALPHARETTA, GEORGIA 30009

STORMONT HOSPITALITY GROUP, LLC /
NORTH AMERICAN PROPERTY GROUP

GUESTROOM
RISER DIAGRAMS

K. PRICE	140028
Principal-in-Charge	SH&A Project No.
G. JENKINS	101716
Project Engineer	Date
T. MERCER	
Checker	

P5.09

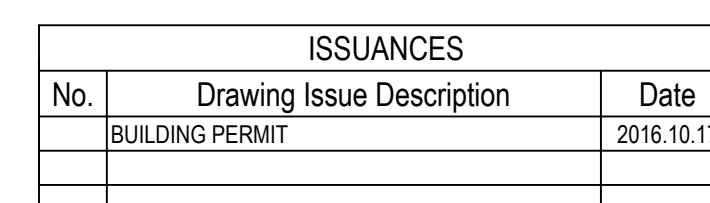


ISSUANCES		
No.	Drawing Issue Description	Date
	BUILDING PERMIT	2016.10.1

9000 AVALON BOULEVARD /
ALPHARETTA, GEORGIA 30009


GUESTROOM RISER DIAGRAMS

P5.10


Discharge No.

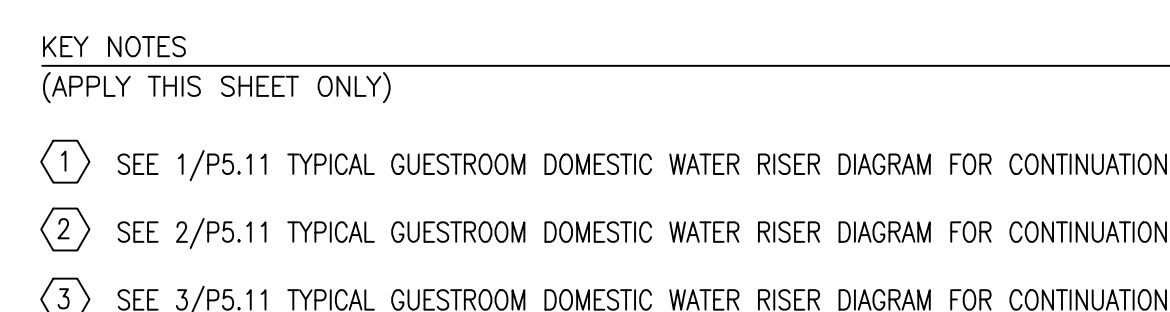


1 GUESTROOM DOMESTIC WATER RISER DIAGRAM (FLOORS 2-7)
P5.10 NO SCALE

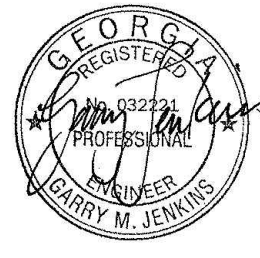


ISSUANCES		
No.	Drawing Issue Description	Date
	BUILDING PERMIT	2016.10.17

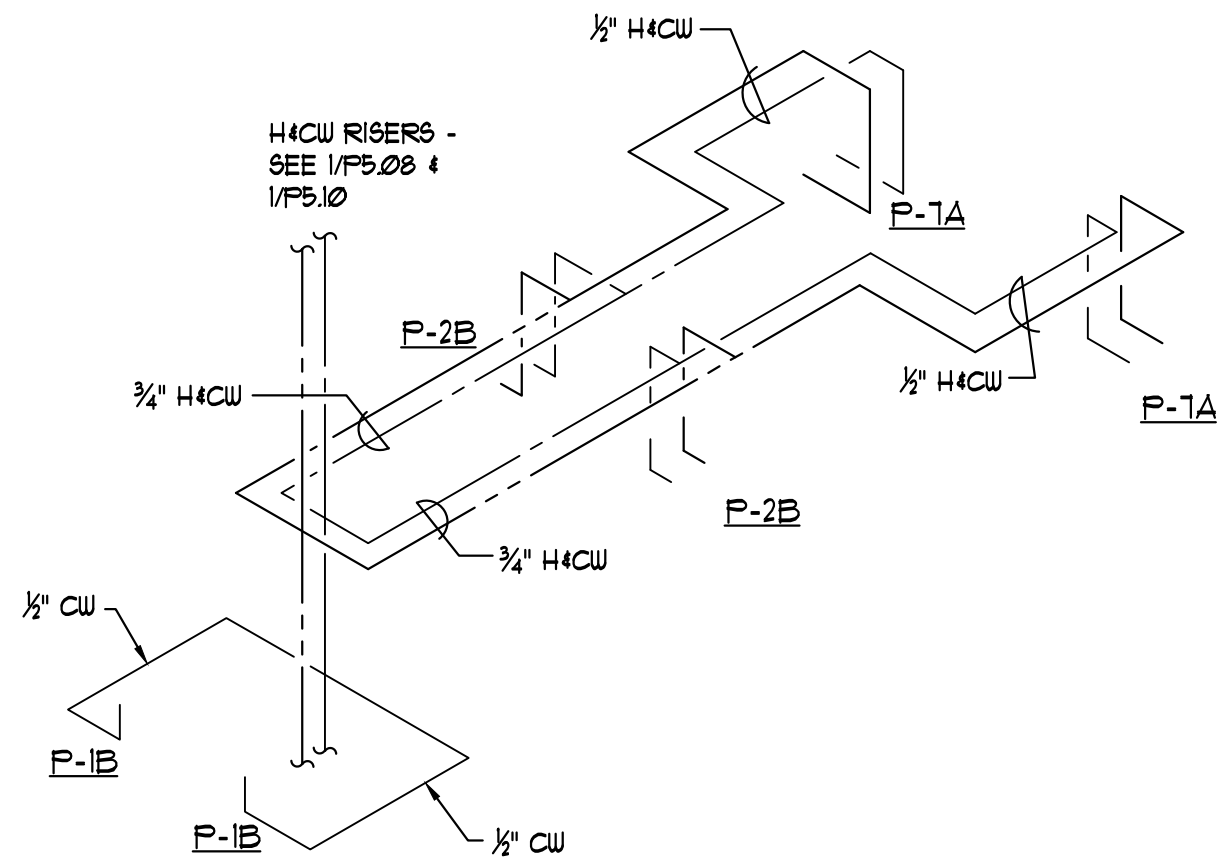

1 TYP. GUESTROOM DOMESTIC WATER RISER
P5.11 NO SCALE

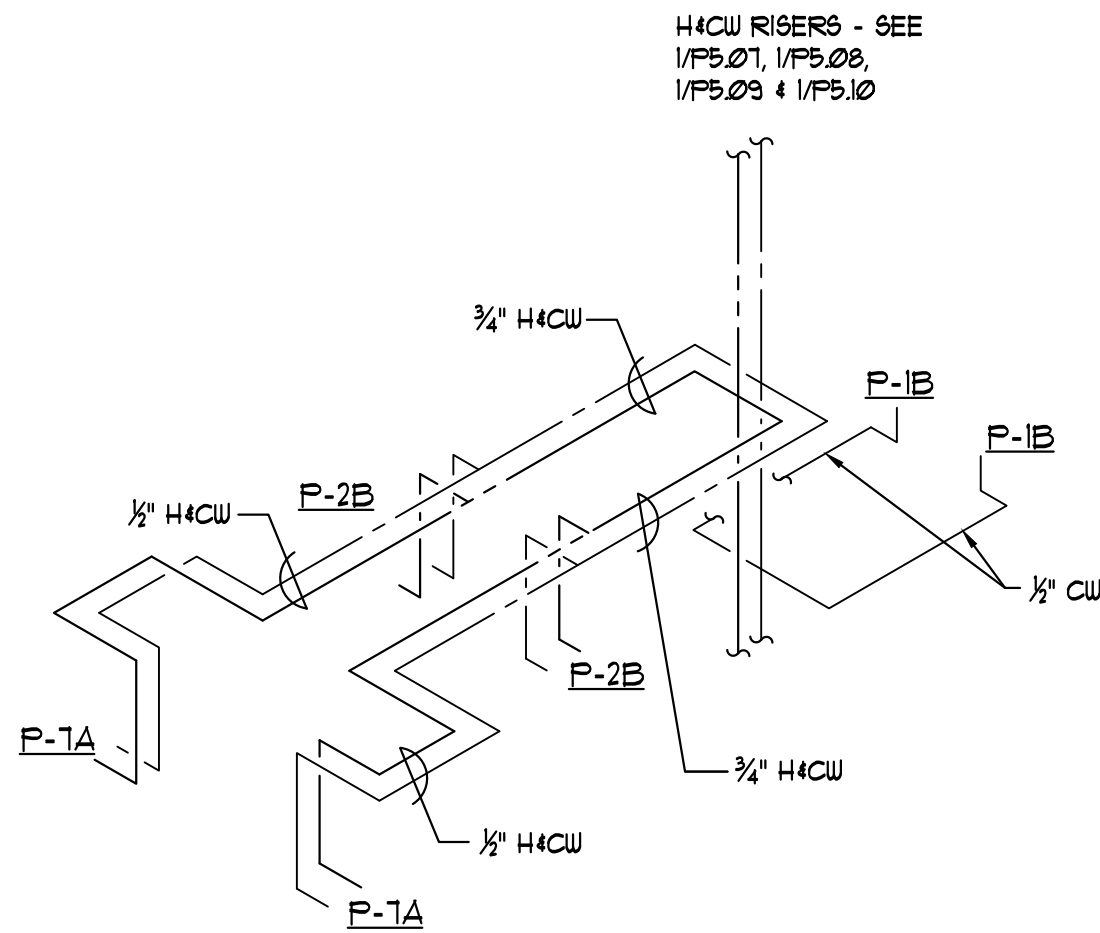

2 TYP. GUESTROOM DOMESTIC WATER RISER
P5.11 NO SCALE

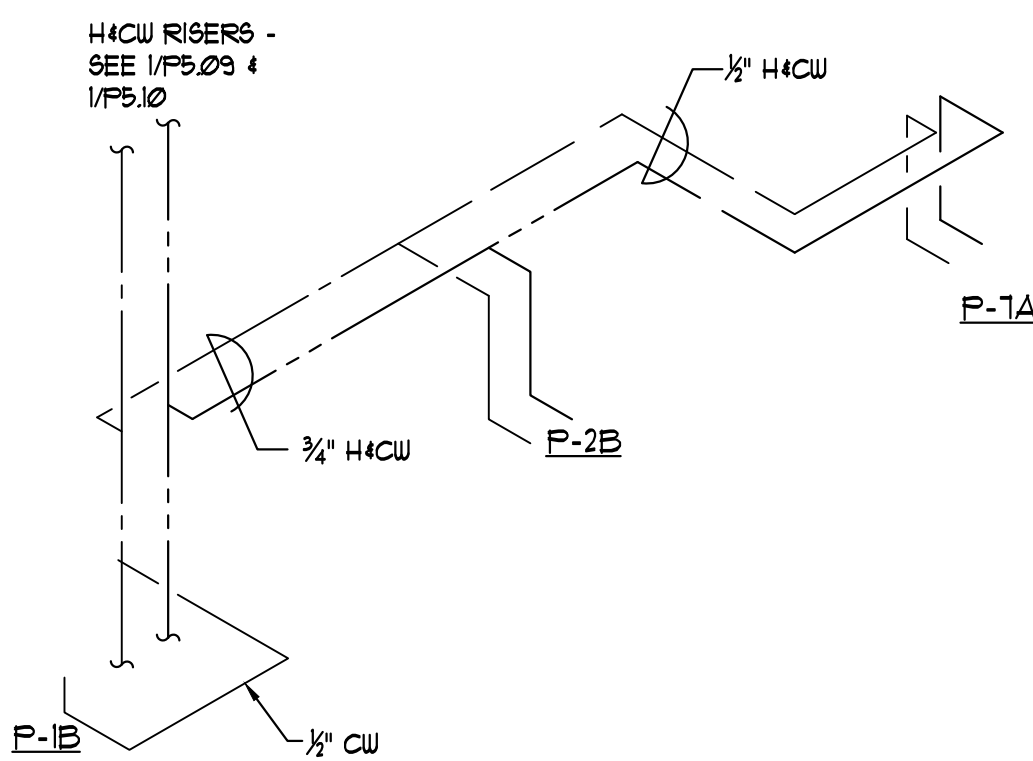

3 TYP. GUESTROOM DOMESTIC WATER RISER
P5.11 NO SCALE

ALPHARETTA CONFERENCE
CENTER & THE HOTEL AT
AVALON

9000 AVALON BOULEVARD /
ALPHARETTA, GEORGIA 30009

STORMONT HOSPITALITY GROUP, LLC /
NORTH AMERICAN PROPERTY GROUP

GUESTROOM
RISER DIAGRAMS

K. PRICE	140028
Principal in Charge	BW&A Project No.
G. JENKINS	101716
Project Engineer	Date
T. MERCER	
Drawn By	

P5.11

ABBREVIATIONS

A/C	ABOVE CEILING	ID	INSIDE DIMENSION
AD	ACCESS DOOR	IN	INCHES
ADJ	ADJUSTABLE		
AFT	ABOVE FINISHED FLOOR	KW	KITCHEN WASTE
AUTO	AUTOMATIC		
AC	AIR CONDITIONING		
AHU	AIR HANDLING UNIT		
ARP	ACID RESISTANCE PIPING		
BAL	BALANCING	LB	POUNDS
B/F	BELOW FLOOR	LWR	LOOP WATER RETURN
B/G	BELOW GRADE	LWS	LOOP WATER SUPPLY
BHP	BRAKE HORSEPOWER		
BCO	BASE CLEANOUT		
		MIN	MINIMUM
		MAX	MAXIMUM
		MFR	MANUFACTURER
CW	COLD WATER (DOMESTIC)		
CO	CLEANOUT		
		NC	NORMALLY CLOSED
DN	DOWN	NG	NATURAL GAS
DR	DRAIN	NFGH	NON-FREEZE GROUND HYDRANT
do	DITTO	NFWH	NON-FREEZE WALL HYDRANT
DWG	DRAWING	NO	NORMALLY OPEN
		NOM	NOMINAL
		OD	OVERFLOW DRAIN
EA	EACH	PSI	POUNDS PER SQUARE INCH
ECC	ECCENTRIC		
EFF	EFFICIENCY		
EOD	EMERGENCY OVERFLOW DRAIN		
EWI	ENTERING WATER TEMPERATURE		
FAV	FRESH AIR VENT	RAD	RADIUS
FCO	FLOOR CLEANOUT	RED	REDUCER
FD	FLOOR DRAIN	RS	REFRIGERANT SUCTION
FLR	FLOOR	RTU	ROOFTOP UNIT
FOB	FLAT ON BOTTOM	SAN	SANITARY
FOT	FLAT ON TOP	SQ	SQUARE
FTM	FEET PER MINUTE	ST	STORM
FPS	FEET PER SECOND	TEMP	TEMPERATURE
FT	FEET	TYP	TYPICAL
		UON	UNLESS OTHERWISE NOTED
G	GATE	V	VENT
GA	GAUGE	VA	VALVE
GPM	GALLONS PER MINUTE	VTR	VENT THRU ROOF
GL	GLOBE		
GCO	GRADE CLEANOUT	WC	WATER COLUMN
		WHA	WATER HAMMER ARRESTOR
HD	HUB DRAIN	WT	WEIGHT
HP	HORSEPOWER	W	WASTE
HTC	HEATING		
HW	HOT WATER (DOMESTIC)		
HWR	HOT WATER RETURN		
HWRR	HOT WATER REVERSE RETURN		
HWS	HOT WATER SUPPLY		

PLUMBING LEGEND

---	COLD WATER
----	HOT WATER
-----	HOT WATER RECIRCULATION
-----	VENT
=====	SANITARY WASTE
=====	GAS
XXXXXX	WORK TO BE REMOVED
⌘	FLOOR DRAIN
⌘	HOSE BIBB
⊙	FLOOR CLEAN-OUT
=	WALL CLEAN-OUT
⌘	GATE VALVE
⌘	BALL VALVE

PUMP SCHEDULE

I.D. TAG	FLUID	TYPE OF PUMP	FLOW (GPM)	HEAD (FT.)	MOTOR H.P.	VOLTS/ PHASE	BASIS OF DESIGN	REMARKS
DWP-1	WATER	BOOSTER PUMP	200	125	7.5 (3)	460/3	SYNCRFLO TRIPLEX W/ VFD	③ ④ ⑥ ⑦
DHWP-1	WATER	BOOSTER PUMP	125	125	5 (3)	460/3	SYNCRFLO TRIPLEX W/ VFD	③ ④ ⑥ ⑦
HWRP - TYP	WATER	RECIRCULATION PUMP	5	12	1/6	120/1	B&G PR	① ②
SP-A	WATER	ELEVATOR PIT	50	35	1/2	120/1	ZOELLER FLOW-MATE	⑤

- ① BRONZE CONSTRUCTION
② PROVIDE AQUASTAT AND AUTOMATIC THERM
③ PROVIDE INTEGRAL CONTROLLER. INTERLOCK ALL ALARMS WITH BUILDING EMS. PROVIDE PRESSURE SENSOR ON "CITY" SIDE OF SERVICE AND SEND MEASUREMENTS TO EMS.
④ UNIT SHALL BE SKID MOUNTED. PROVIDE WITH ALL NECESSARY STARTERS, VFDS AND CONTROLS FOR A COMPLETE DOMESTIC WATER BOOSTER PUMP PACKAGE.
⑤ PROVIDE OIL SMART OIL SENSOR/CONTROLLER TO LOCK OUT PUMP UPON DETECTION OF OIL. PROVIDE ALARM TO BUILDING EMS.
⑥ PROVIDE HYDROCUMULATOR TANK SIZED TO MATCH SYSTEM. LOCATE AT TOP OF RISER.
⑦ TRIPLEX PUMP - EACH PUMP SIZED FOR 50% FLOW.

GAS WATER HEATER SCHEDULE

I.D. TAG	TANK CAPACITY (GALLONS)	INPUT (MBH)	RECOVERY @ 100° F (GPH)	MIN. EFF.	FUEL	VOLTS/ PHASE	BASIS OF DESIGN	REMARKS
HWB-1	-	2,070	2,133	85%	NAT. GAS	120/1	LOCHINVAR CFN2072PM	① ②
HWB-2	-	2,070	2,133	85%	NAT. GAS	120/1	LOCHINVAR CFN2072PM	① ②

- ① PROVIDE SYSTEM WITH A 1,000 GALLON, GLASS LINED, VERTICAL STORAGE TANK (ST-1) FOR STORAGE OF 140° F WATER. PROVIDE INSULATED JACKET OVER ENTIRE TANK.
② UNIT SHALL COME WITH THE BOILER CIRC PUMP.
③ PROVIDE WITH MODULATING FIRING CONTROLS AND UNIT DISCONNECT.
④ PROVIDE WITH SIDEWALL DIRECT VENT KIT FOR FLUE AND COMBUSTION AIR.

ELECTRIC WATER HEATER SCHEDULE

I.D. TAG	TYPE OF WATER HEATER	TANK CAPACITY (GALLONS)	RECOVERY @ 60° F (GPH)	POWER INPUT	ELEC. CHAR. (VOLTS/PHASE)	BASIS OF DESIGN	REMARKS
EWHR-2-1	INSTANT	-	-	9 KW	277V/1	EEMAX	
EWHR-12-1	INSTANT	-	-	9 KW	277V/1	EEMAX	

GENERAL NOTES (APPLY TO ALL SHEETS):

1. ALL HORIZONTAL SANITARY, WASTE, STORM, AND VENT PIPING SHALL BE SLOPED AT 1/8" PER FOOT IN THE DIRECTION OF FLOW, UNO.
2. REFER TO KITCHEN CONSULTANT PLANS FOR ALL FIXTURE CONNECTION SIZES IN KITCHEN/BAR/BUFFET AREAS. PROVIDE ALL FINAL PLUMBING CONNECTIONS FOR ALL FIXTURES AND EQUIPMENT. PROVIDE INLINE BACKFLOW PREVENTERS AT ALL EQUIPMENT CONNECTIONS.
3. PROVIDE TWO-STAGE ROOF OR AREA DRAINS AS REQUIRED - REFER TO ARCHITECTURAL PLANS FOR ROOF CONSTRUCTION.
4. PROVIDE CLEANOUTS ON ALL STORM/WASTE/SANITARY PIPING INCLUDING AT THE BASE OF ALL RISERS AND AT ALL INSTANCES REQUIRED BY THE PLUMBING CODE. CLEANOUTS SHALL BE LOCATED SO THEY ARE ACCESSIBLE.
5. PROVIDE HEAT TRACE AND INSULATION OVER ALL WATER CARRYING PIPING IN UNCONDITIONED AREAS, INCLUDING ANY SANITARY/GREASE WASTE TRAPS.
6. PROVIDE ACCESS PANELS IN DVP CEILINGS AS REQUIRED TO ACCESS EQUIPMENT, CLEANOUTS, VALVES, ETC. PANELS SHALL BE AS SPECIFIED BY THE ARCHITECT. EXACT SIZES AND LOCATIONS SHALL BE COORDINATED DURING SHOP DRAWINGS. FINAL AUTHORITY OVER SIZE AND LOCATION SHALL REST WITH THE ARCHITECT AND AHJ.
7. PROVIDE THERMOSTATIC MIXING VALVES AT ALL HAND SINKS. SET TO 110°F.

PLUMBING FIXTURE SCHEDULE ②

TAG	FIXTURE	CW	HW	SAN / WASTE	VENT
P-1A, P-1A(H)	PUBLIC WATER CLOSET	1/2"	----	4"	2"
BASIS OF DESIGN: American Standard "Hwall Flowise" #3351.128, vitreous china, wall hung, siphon jet action, 1.3 GPF, elongated closet bowl with 1 1/2" top spud complete with carriers selected to match the chase size indicated. Flush valves shall be Sloan "Royal." Fixtures P-1AH shall be similar, except that they shall be mounted in accordance with the handicap code.					
P-1B	GUESTROOM WATER CLOSET	1/2"	----	4"	2"
BASIS OF DESIGN: 16-1/2" high handicapped style, bottom outlet; American Standard "Cadet 3", 1.28 GPF, #33784B.128ST complete with tank, bowl, flush valve unit, anti-syphon float valve, chromed lever and supply stop.					
P-1C	PRES. SUITE WATER CLOSET	1/2"	----	4"	2"
BASIS OF DESIGN: 16-1/2" high handicapped style, Floor-Mounted, back outlet; American Standard "Orkville", 1.28 GPF, #2878.100 complete with tank, bowl, flush valve unit, pressure-assisted siphon jet flush action, chromed lever and supply stop.					
P-2A	PUBLIC LAVATORY	3/4"	3/4"	3"	2"
BASIS OF DESIGN: American Standard "Ovalyn" #0497-221, 21" x 17" vitreous china, undercounter, oval lavatory complete with front overflow and 1 1/4" drain. Fittings shall include American Standard Battery operated "Selectronic" faucet #6055.163 with lever handles, chrome-plated finish, vandal resistant aerator, chrome-plated tailpieces, strainers, P-trap, supply stops, anchoring clips and all other trim. Wall supply stops, drains and tailpieces shall be offset wheelchair type.					
P-2B	GUESTROOM LAVATORY	3/4"	3/4"	3"	2"
BASIS OF DESIGN: See Interior Design Plans.					
P-3A	GUESTROOM BAR SINK	3/4"	3/4"	3"	2"
BASIS OF DESIGN: See Interior Design Plans.					
P-4A	PUBLIC URINAL	3/4"	----	3"	2"
BASIS OF DESIGN: American Standard "Washbrook Flowise", vitreous china, 0.5 GPF, wall hung, washout flush with integral flushing rim and 3/4" top spud. Flush valve shall be exposed, battery powered, sensor operated Sloan "U2 Optima Plus" #8186-0.5or approved equal.					
P-5A	PUBLIC DRINKING FOUNTAIN	1/2"	----	2"	1-1/2"
BASIS OF DESIGN: Combination standard height and barrier-free, stainless steel drinking fountain and shall provide ample leg room and easy access from sitting position. Fountain shall include self-closing, semi-circular push bar with full 180-degree directional activation, contour-formed oval shape receptor to eliminate splashing and standing water and shall have rounded corners and edges. Fountain shall be complete with stainless steel back panel. Projector shall be chrome-plated two-stream, mound-building type with integral hood guard, stream height regulator and anti-repeat feature. Drinking fountains shall be Hixley Taylor Model OVL II-EPB with each drinking fountain served by a Model S45-D remote chiller certified by ARI to meet Standard 1010. Capacity shall be 8.0 GPH of 50 degrees F. chilled water at 90 degrees F. ambient. Provide service stops on inlet and outlet of chiller. Chiller shall operate on 120 volts, 1 phase power supply.					
P-5B	PUBLIC DRINKING FOUNTAIN	1/2"	----	2"	1-1/2"
BASIS OF DESIGN: Barrier free split level surface mounted electric water cooler with a bottle filling station; each complete with P-trap and supply service stops. Electric water cooler shall deliver 8.0 GPH of 50 degrees F. water at 90 degrees F. ambient and 90 degrees F. inlet water. Cooler shall have horizontal stainless steel top. Bubblet shall have flexible guard and operate between 20 and 120 psi. Separate valve and diaphragm-type automatic stream regulator shall be mounted with cabinet. Refrigeration system shall employ high efficiency, positive start compressor, non-pressurized counter-flow cooling coil with totally encapsulated insulation and shall be controlled by an integral, adjustable thermostat. Coolers shall have front pushbar water controls with raised lettering for the visually impaired. Bottle filling unit shall have an electronic sensor for no-touch activation with an automatic shutoff. Bottle filler shall meet ADA guidelines for parallel approach. Coolers shall comply with ANSI 117.1 for both visual and motion disabilities and ADA. Cabinet shall have removable front panels and be finished in a neutral-gray baked enamel. Coolers shall be certified by ARI to meet Standard 1010. Coolers shall be Elkay EZSTLWSLK.					
P-6A	JANITOR SINK	1/2"	1/2"	2"	2"
BASIS OF DESIGN: American Standard "Flowwell" #7745.811 enamelled cast iron, corner floor service sink, 28" x 28" size, complete with removable vinyl coated rim guard, service sink faucet, American Standard Model 8344.112 with vacuum breaker, integral stops, wall brace, 5' rubber hose and wall hook, and strainer with flat metal grid for 3" I.P.S. connection.					
P-7A	GUESTROOM SHOWER	1/2"	1/2"	2"	2"
BASIS OF DESIGN: See Interior Design Plans.					
P-7B	LOCKER ROOM SHOWER	1/2"	1/2"	2"	2"
BASIS OF DESIGN: Shower faucets and headsets shall be Kohler Model K-72422-CP showerhead with Kohler Model K-98362 Slidebar Kit. 1.5 GPM flow rate. Provide with diverter.					
P-8	GUESTROOM BATHTUB	1/2"	1/2"	2"	2"
BASIS OF DESIGN: See Interior Design Plans.					
FD	FLOOR DRAIN	1/2" *	----	3"	2"
FS	FLOOR SINK	1/2" *	----	3"	2"
HD	HUB DRAIN	1/2" *	----	3"	2"


- ① PROVIDE ALL FLOOR DRAINS, FLOOR SINKS, AND HUB DRAINS WITH AUTOMATIC TRAP PRIMER.
② SANITARY PIPE SIZING IS BASED ON 1/8" SLOPE PER FOOT.

BW & A

Barrett, Woodyard & Associates, Inc.

3495 Holcomb Bridge Road
Norcross, GA 30092
Phone (770) 810-8800
Fax (770) 810-8808

© 2016 BW&A

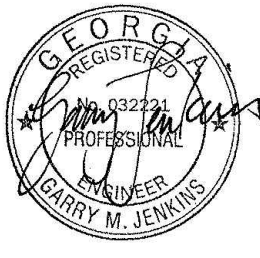

ISSUANCES

No.	Drawing Issue Description	Date
	BUILDING PERMIT	2016.10.17

ALPHARETTA CONFERENCE CENTER & THE HOTEL AT AVALON

9000 AVALON BOULEVARD /
ALPHARETTA, GEORGIA 30009

STORMONT HOSPITALITY GROUP, LLC /
NORTH AMERICAN PROPERTY GROUP


ABBREVIATIONS, LEGEND, SCHEDULES, & DETAILS - PLUMBING

K. PRICE	140028
Principal-in-Charge	BW&A Project No.
G. JENKINS	101716
Project Engineer	Date
T. MERCER	
Checker	


P7.01

Revised By:

ISSUED FOR CONSTRUCTION

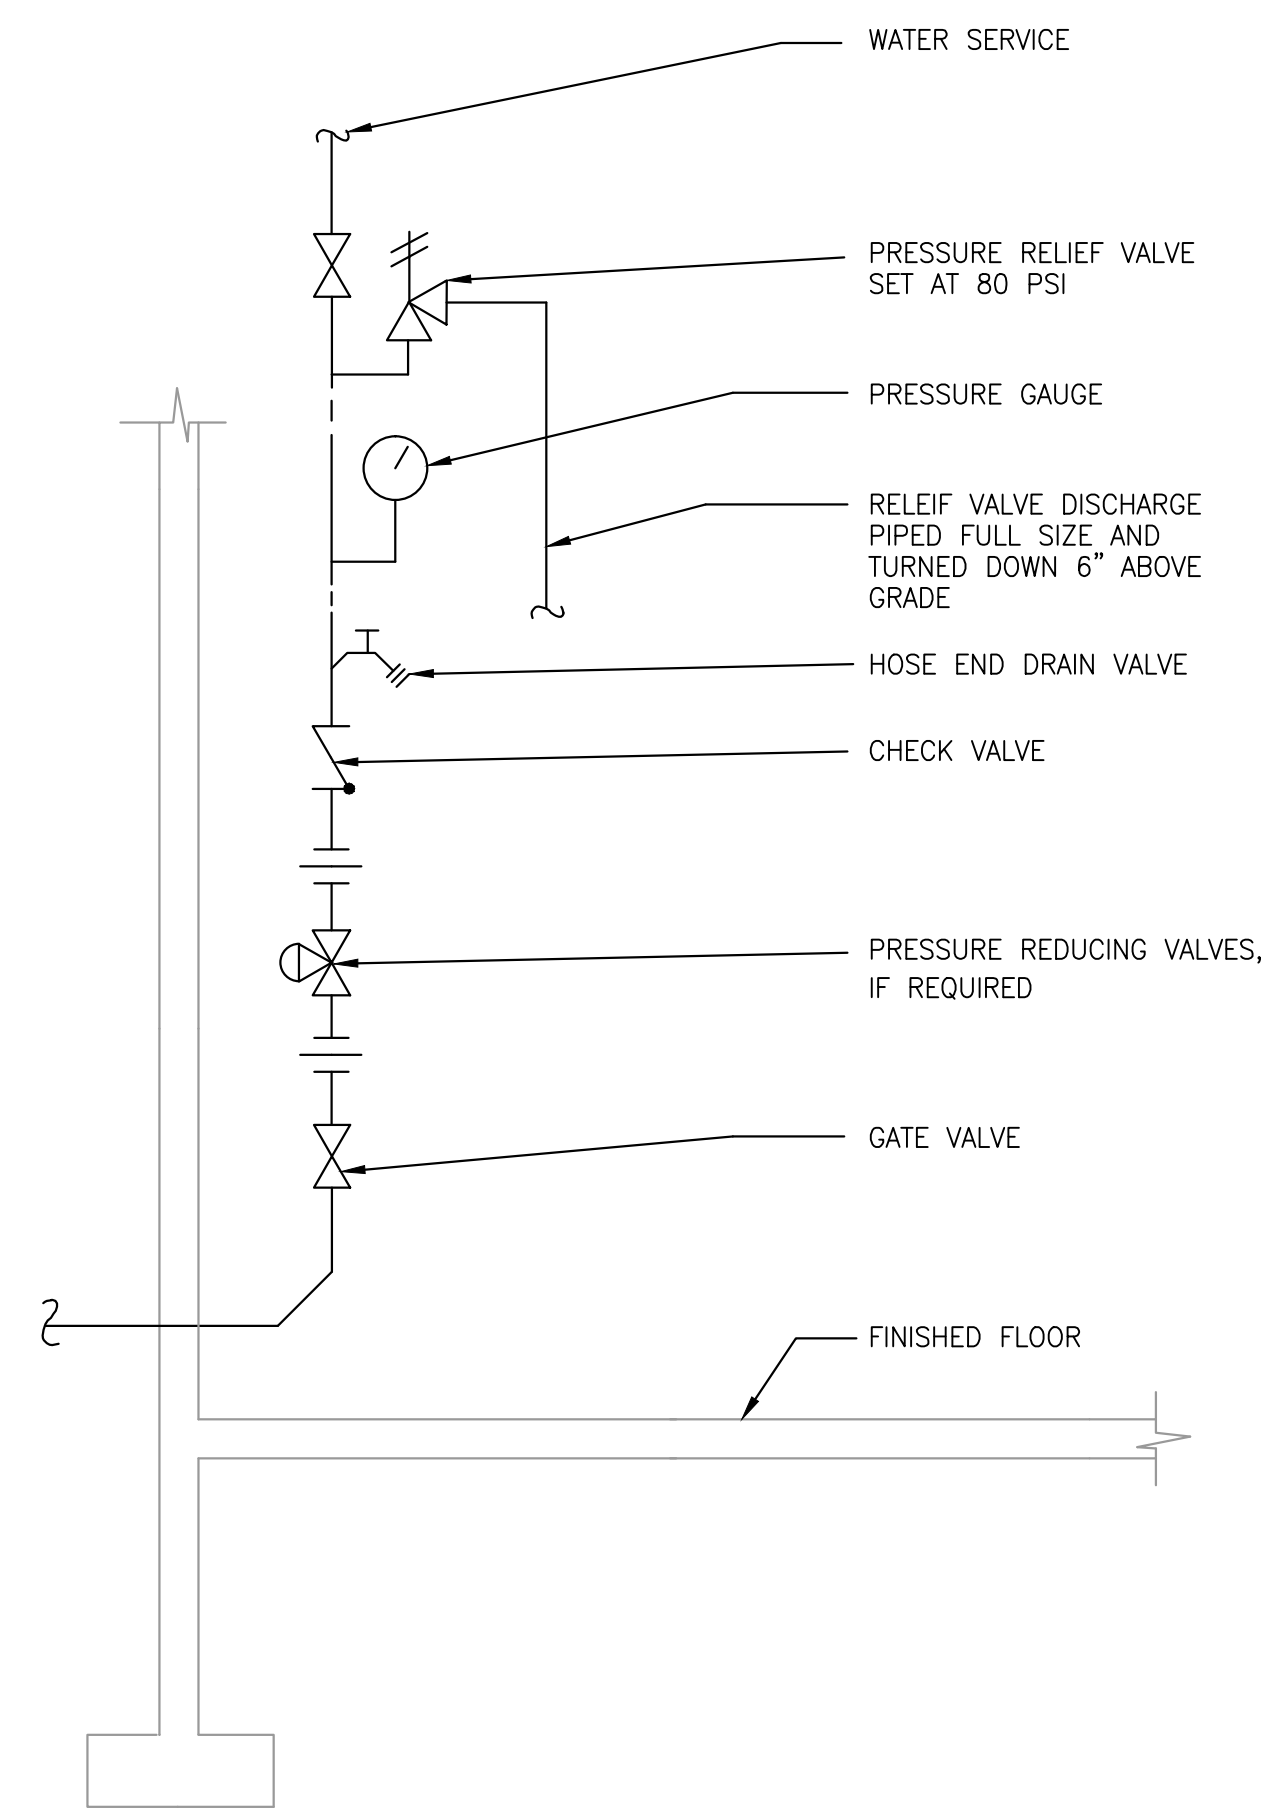


1 WATER SERVICE RISER
P7.02 NO SCALE

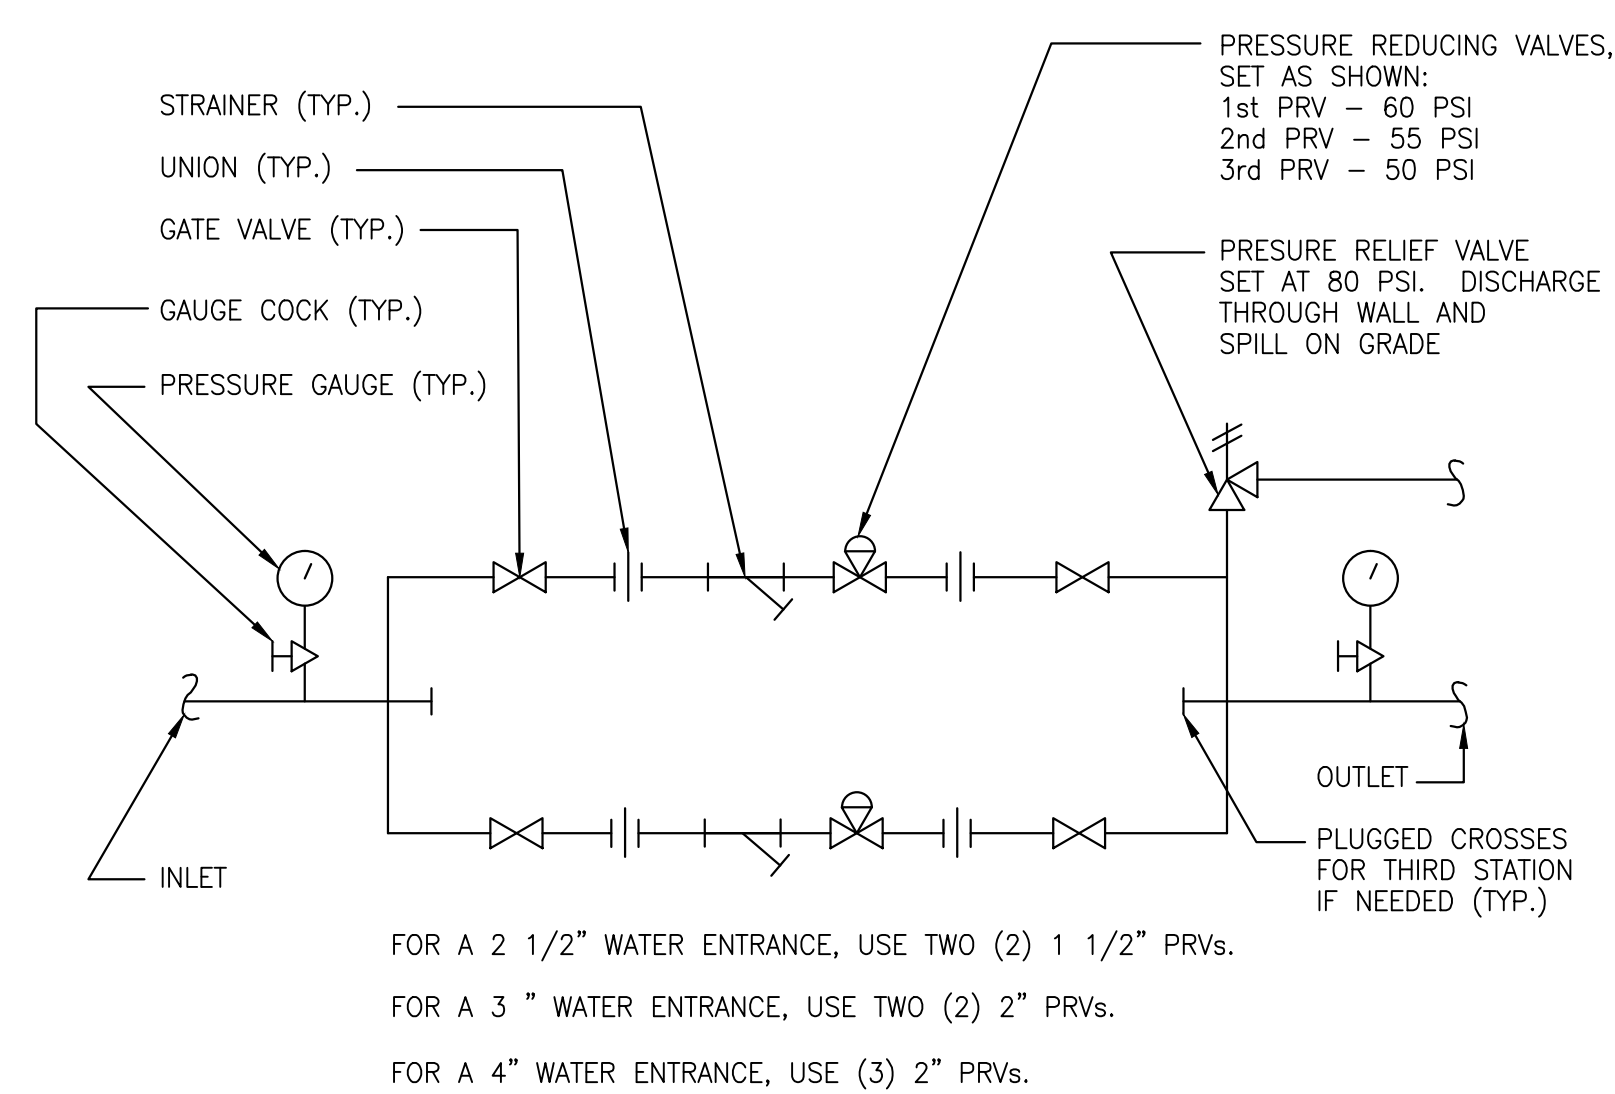


2 PRESSURE REDUCING STATION
P7.02 NO SCALE


NOTE: REQUIRED ON 2 1/2" THROUGH 4" WATER ENTRANCES

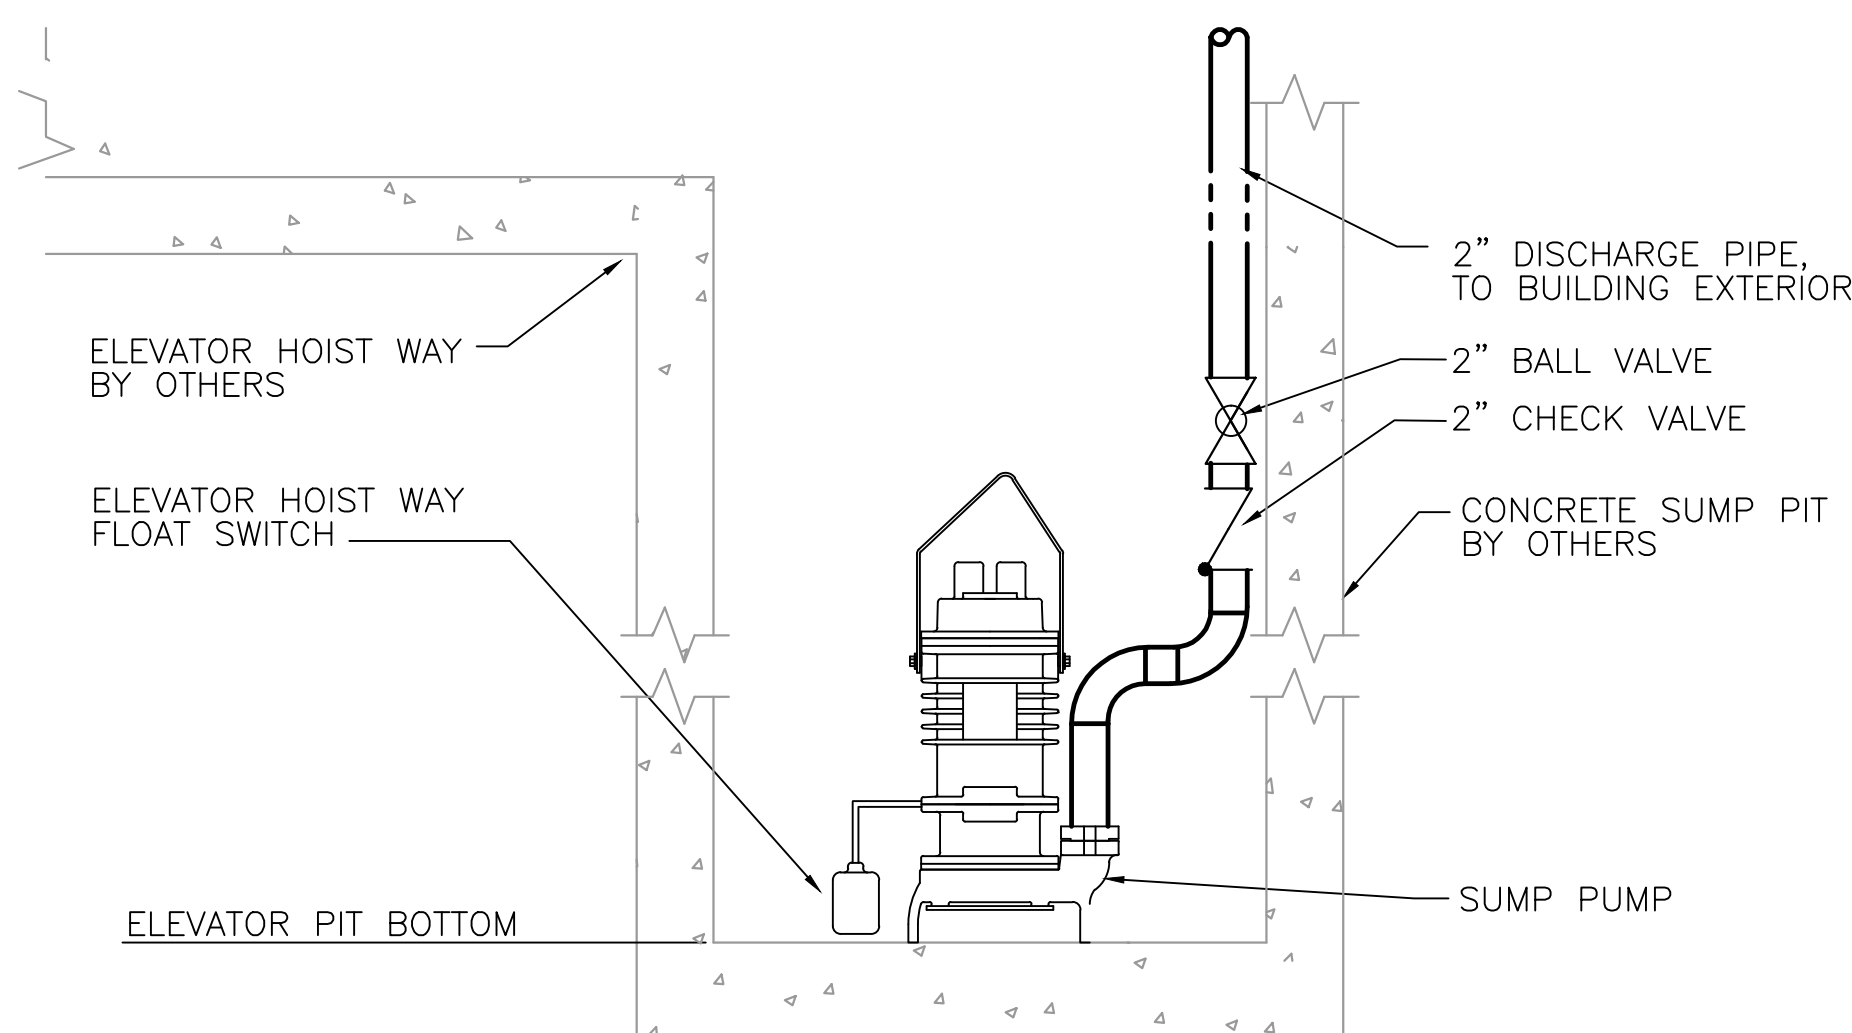


3 ELEVATOR SUMP PUMP DETAIL
P7.02 NO SCALE

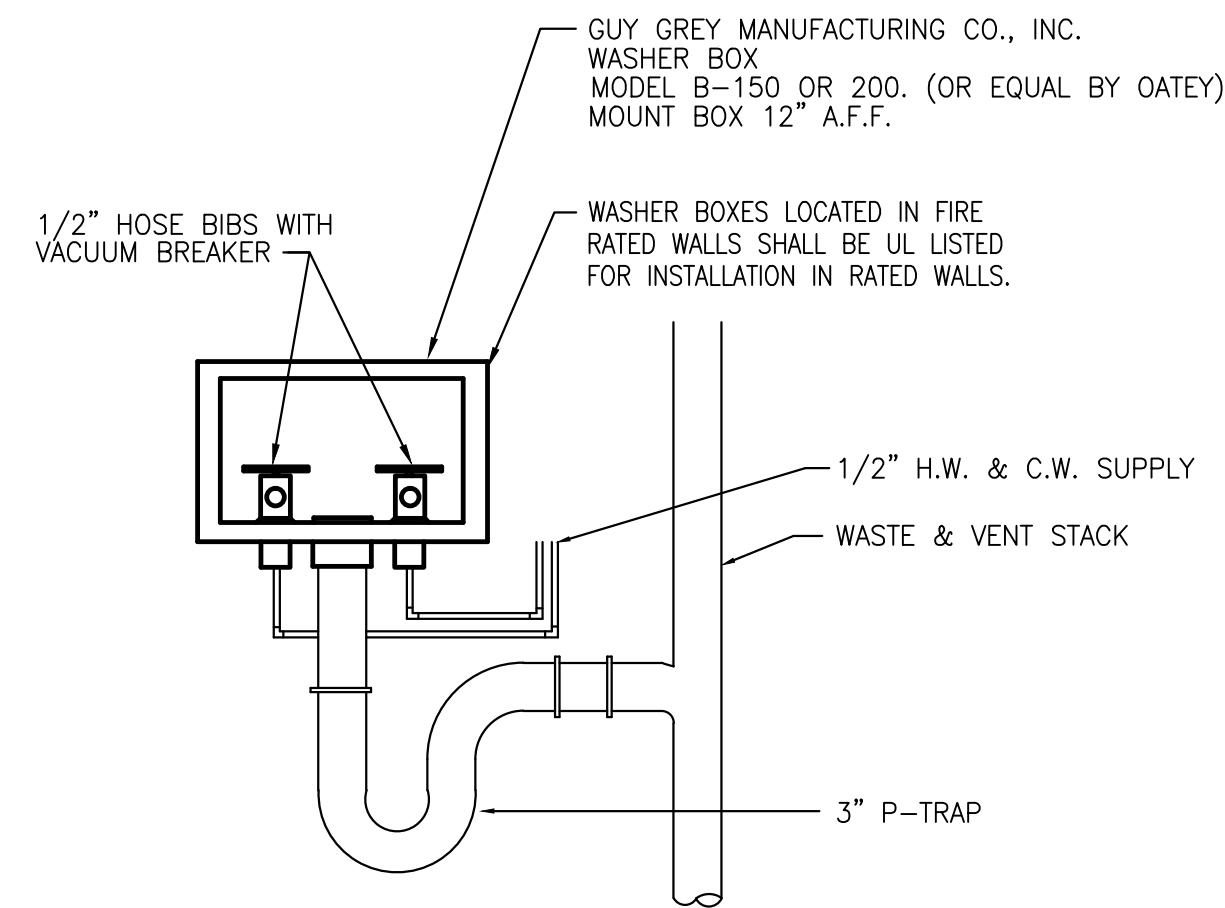


4 LAUNDRY BOX DETAIL
P7.02 NO SCALE

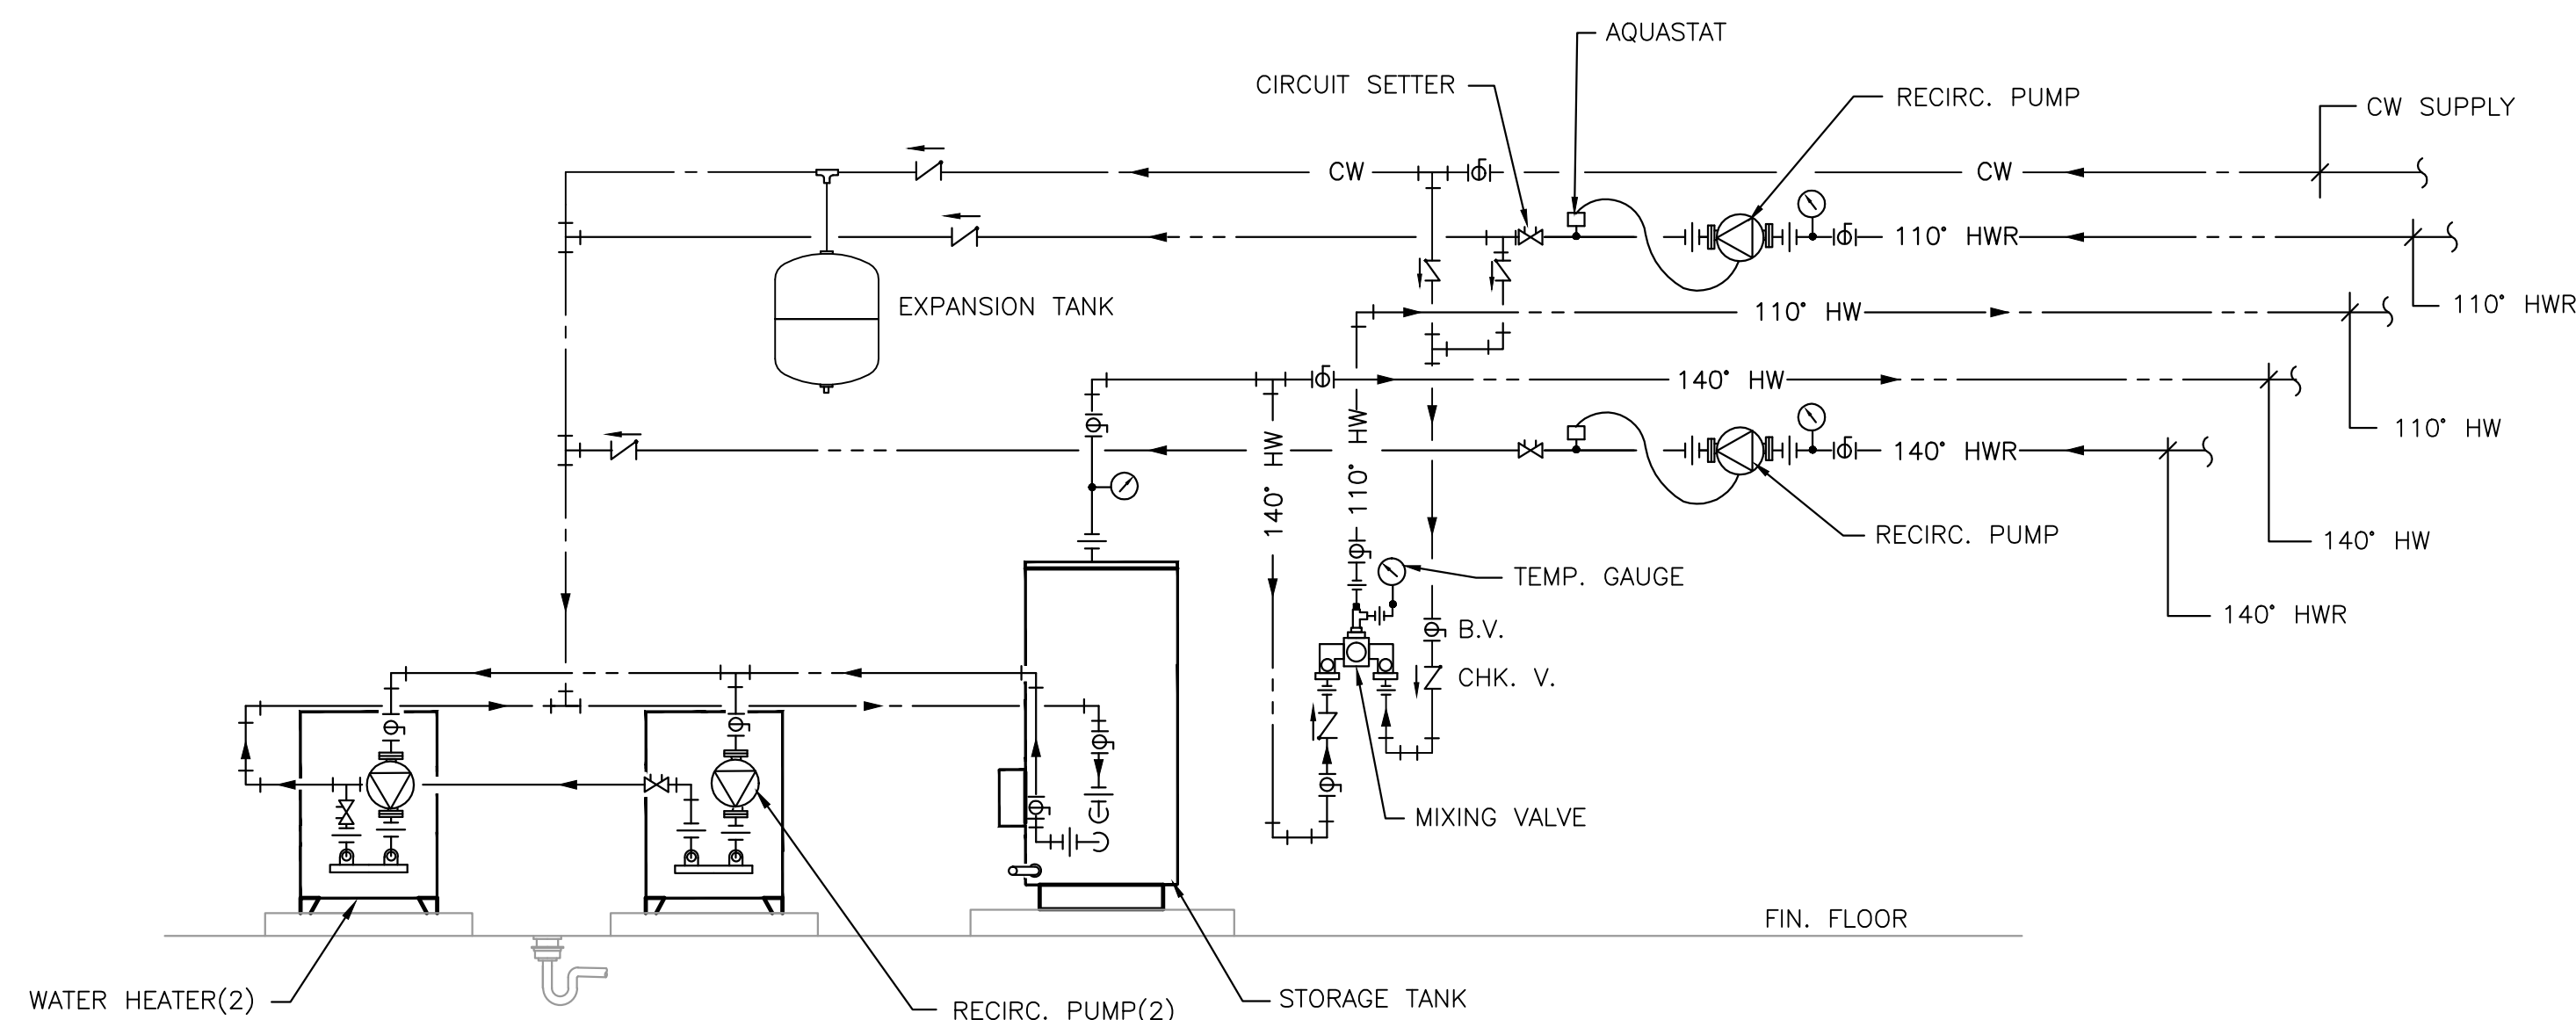


5 DOMESTIC WATER BOILER CONNECTION DETAIL
P7.02 NO SCALE

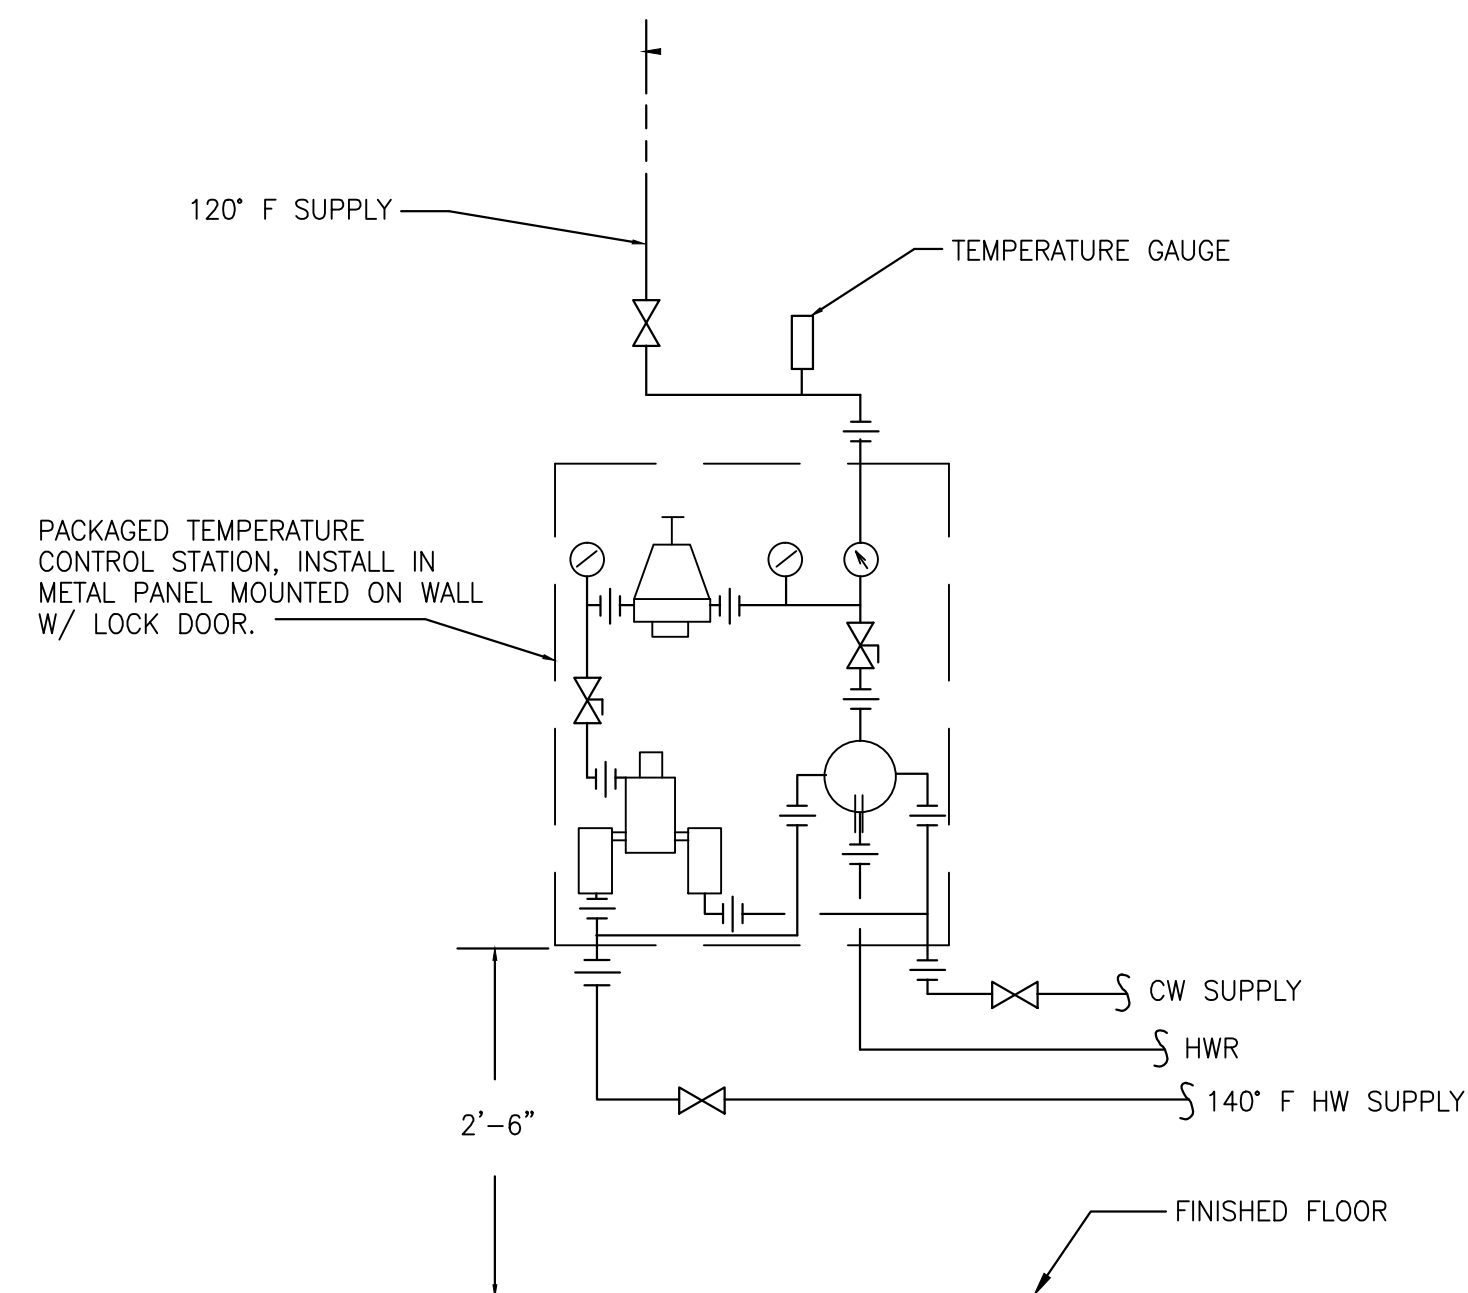


6 MIXING VALVE DETAIL
P7.02 NO SCALE

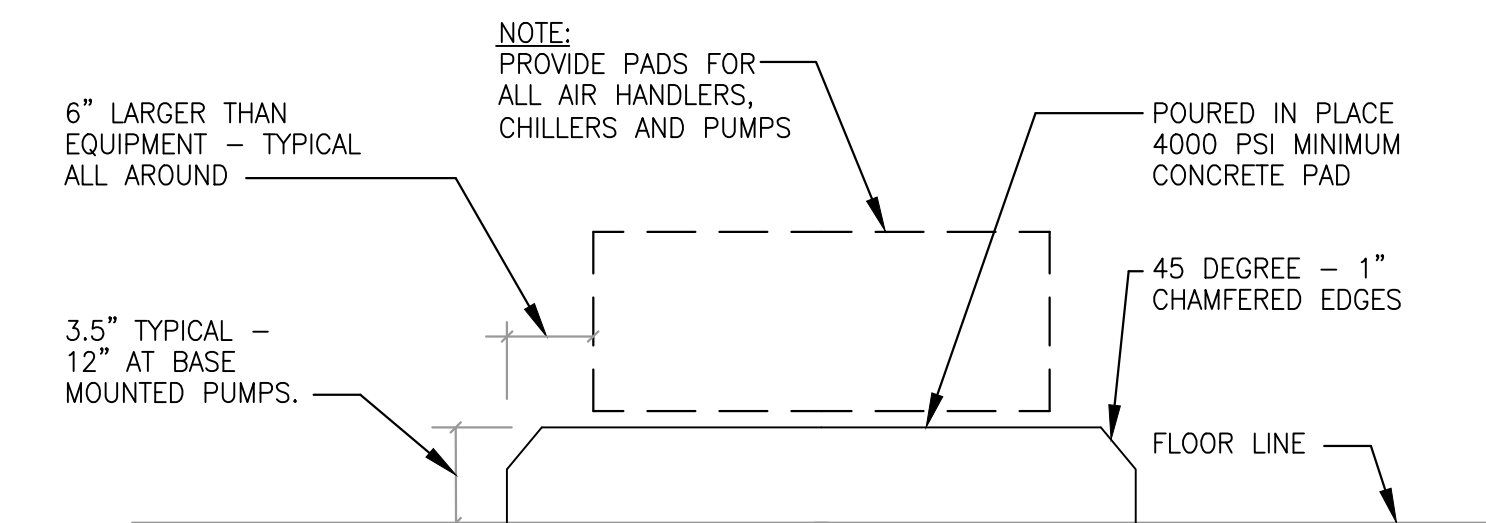


7 MECHANICAL EQUIPMENT PAD DETAIL
P7.02 NO SCALE

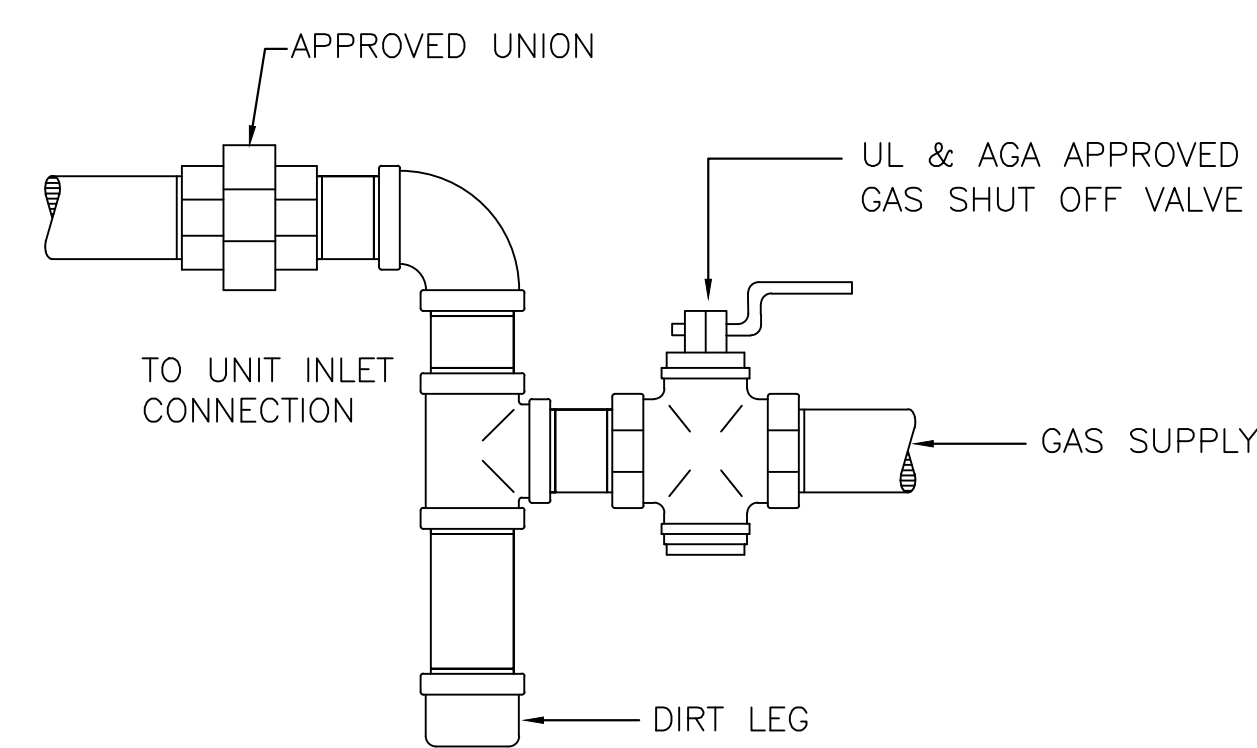

8 GAS CONNECTION
P7.02 NO SCALE

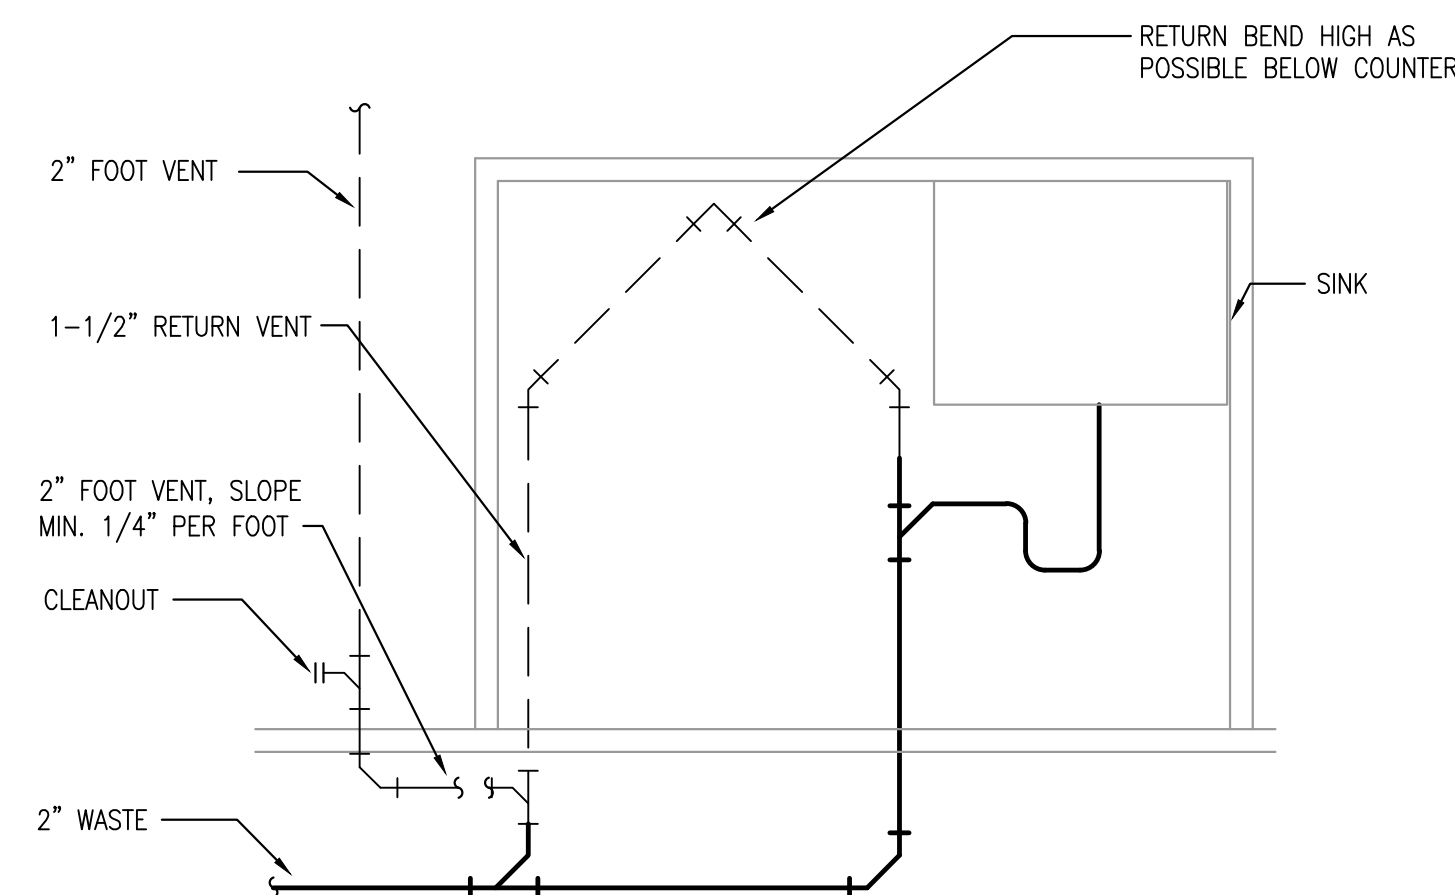

9 ISLAND LOOP VENT DETAIL
P7.02 NO SCALE

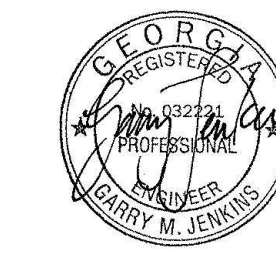

ISSUANCES		
No.	Drawing Issue Description	Date
1	BUILDING PERMIT	2016.10.17

ALPHARETTA CONFERENCE
CENTER & THE HOTEL AT
AVALON

9000 AVALON BOULEVARD /
ALPHARETTA, GEORGIA 30009

STORMONT HOSPITALITY GROUP, LLC /
NORTH AMERICAN PROPERTY GROUP

DETAILS
PLUMBING

K. PRICE	140028
Principal-in-Charge	SH&A Project No.
G. JENKINS	101716
Project Engineer	Date
T. MERCER	
Checker	

P7.02

System No. C-AJ-8041
 F RATING = 3-HR
 T RATING = 0 and 1 HR
 L Rating At Ambient - 10 CFM/sq ft
 L Rating At 400 F - Less Than 6 CFM/sq ft

[illegible]

3. Pipe Covering* - (Optional) - Max 1 in. thick hollow cylindrical heavy density (min 3.5pcf) glass fiber units jacketed on the outside with an oil

ISSUANCES		
No.	Drawing Issue Description	Date
	BUILDING PERMIT	2016.10.17

System No. W-L-8013
 F Ratings - 1 and 2 H (See Item 1)
 T Rating - 0 H
 L Rating At Ambient - 5 CM/Sq Ft
 L Rating At 400 F - 2 CM/Sq Ft

1. Pipe
 2. Flange
 3. Gasket
 4. Bolt
 5. Nut
 6. Washer

SECTION A-A

assembly The 1 or 2 fire-rated gypsum board(s) will assembly shall be constructed of the materials and manner specified in the Individual ISO-9001 or ISO9001 Series Wall and Partition Division in the Fire Protection Division.

Wall Framing may consist of either wood stud or steel channel studs. Wood studs to comply of nominal 2 x 4 lumber spaced 16 in. OC. Steel studs to be min.-1-1/2" deep and max. spaced 24 in. OC.

Gypsum Board 5/8" thick, 14 ft wide with square tapered edges. The gypsum board type, thickness, manufacturer, finish, sagging type and sheet orientation shall be as specified in the Individual Wall and Partition Division. Max area of opening is 302 sq. ft. with max dimension of 72 in. w/c.

hourly Fire Rating of the tested system is equal to the hourly fire rating of the wall assembly in which it is installed.

Max 18 in. wide by max 6 in. d, deep on back-board and/or sub-bottom cable tray with channel-shaped side rails

Aggregates cross-sectioned are cables in cable tray to be max 20 percent of the cross-sectioned area of tray. Any combination of the following types and sizes of conductor conductors could be used:

- 100 No. 12 AWG with polyethylene (PVC) insulation and PVC jacket.
- 100 No. 10 AWG with polyethylene (PVC) insulation and PVC jacket.
- 100 No. 24 AWG with polyethylene (PVC) insulation and PVC jacket.
- 100 No. 750 kcmil (or more) with PVC insulation and jacket.

Insulators One or more pipe or tube to be installed within the opening. The total number of insulators is dependent on the size of the opening and types and sizes of the penetrators. Any combination of the following types and sizes of insulators could be used:

- 100 No. 12 AWG with polyethylene (PVC) insulation and PVC jacket.
- 100 No. 10 AWG with polyethylene (PVC) insulation and PVC jacket.
- 100 No. 24 AWG with polyethylene (PVC) insulation and PVC jacket.
- 100 No. 750 kcmil (or more) with PVC insulation and jacket.


Polyethylene (PVC) Pipe Max 3 in. diam. Schedule 40 steel size PVC pipe (as standard) for use in closed conduits or as supply or vented (drain or vent) piping system.

Steel Pipe Max 6 in. diam. (or smaller) Schedule 40 (or heavier) steel pipe.

Flexible Pipe One or more (or more) flexible pipe (as standard) for use in closed conduits or as supply or vented (drain or vent) piping system.

[illegible]

P7.03

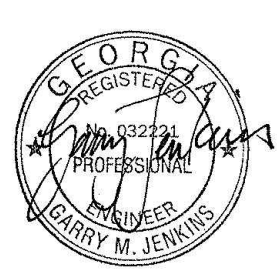

ISSUANCES		
No.	Drawing Issue Description	Date
1	BUILDING PERMIT	2016.03.17

SOVENT® AERATOR AND STACK RULES

(A) The stack size shall be in accordance with Table B based on the total fixture unit load determined by Table A or A-1.
(Drawing No. 1)

(B) The stack shall not telescope or decrease in size and must be continued full size through the roof.
(Drawing No. 2)

(C) An Aerator fitting is required at each level where the following horizontal branches enter the stack:
(1) Any soil branch
(2) A waste branch the same size as the stack size
(3) A waste branch one pipe size smaller than the stack size
(Drawing No. 3)

(D) The Aerator fitting shall be placed in a vertical plane. Tilting the Aerator to offset the Sovernt® stack is not permitted.
(Drawing No. 4)

(E) At any level where an Aerator is not required, an "in-line" offset consisting of two one-eighth bends and one quarter bend may be used. The vertical distance between Aerators or "in-line" offsets shall not exceed twenty feet (20'-0"). No more than two consecutive "in-line" offsets are permitted.
(Drawing No. 5)

(F) Waste branches two pipe sizes smaller than the stack size may connect directly to the stack through a sanitary fitting.
(Drawing No. 6)

(G) Horizontal stack offsets exceeding sixty-degrees (60°) from vertical require a De-aerator fitting and Pressure Relief Line (PRL). The Pressure Relief Line (PRL) shall connect to the vertical portion of the stack downstream of the offset. Soil and waste branches may connect to the horizontal portion of the offset. These connections shall be made BETWEEN the two vertical portions of the stack at a minimum distance of ten pipe diameters (based on stack size) downstream of the higher vertical section. Branch connections to a horizontal stack offset less than ten pipe diameters in length shall be made as far downstream on the horizontal as possible. Soil and waste branches shall not connect where the offset makes a horizontal change of direction. Waste branches may connect to the horizontal portion of the Pressure Relief Line (PRL), except on office building battery type installations. Waste branches shall be at least one pipe size smaller than the PRL. Waste branch connections shall not be made into any vertical portion of the PRL. Clothes washers shall not connect to the PRL. Horizontal stack offsets shall be sized per Table C based on the total fixture unit load of all fixtures connecting to the offset and upstream. The entire stack size shall be no smaller than the largest horizontal offset size.
(Drawing No. 7)

(H) Sovernt® stacks may be combined before entry into the main sewer drain. The stacks shall combine downstream of each Pressure Relief Line (PRL) termination point. The total fixture unit load of the combined stacks determines collection drain line sizing.
(Drawing No. 8)

(I) Stack vent headers above the highest fixture may offset prior to the vent thru roof penetration (VTR). The horizontal vent header and VTR shall be increased one pipe size when exceeding twenty feet (20'-0") in horizontal length.
(Drawing No. 9)

(J) Stack vent headers above the highest fixture may be combined prior to the vent thru roof penetration (VTR) with one vertical stack extending through the roof. The one combined vertical stack shall be one pipe size larger than the largest of the combined stacks. If the distance between any stack and the VTR exceeds twenty feet (20'-0"), the horizontal offset shall be increased one (1) pipe size larger than the downstream stack.
(Drawing No. 10)

The above information is based on data found in **Cast Iron Sovernt® Design Manual #802** as published by Conine Manufacturing Co., Inc. © Flint, Texas. For more detailed information contact them at 1-800-537-5895 or visit www.casionsovent.com.

DRAWING NO. 1
Sovernt® Sizing Requirements

DRAWING NO. 2
Required Aerator Connections

DRAWING NO. 3
"In-line" Offset Requirements

DRAWING NO. 4
Direct Stack Connections

DRAWING NO. 5
Horizontal Stack Offsets

DRAWING NO. 6
Stack Offsets 60 Degrees or Less

DRAWING NO. 7
Combining Sovernt® Stacks

DRAWING NO. 8
Vent Stack Offset Requirements

DRAWING NO. 9
Base of Stack Requirements

SOVENT® DE-AERATOR AND BUILDING DRAIN RULES

(A) A De-aerator fitting is required at the base of each stack. The De-aerator fitting shall be installed in the vertical portion of the stack. The distance between the De-aerator fitting and the Sovernt® building drain shall not exceed five feet (5'-0"). The Sovernt® building drain size shall be in accordance with Table C based on the total fixture unit load determined by Table A or A-1. The transition to a larger Sovernt® building drain size shall be made in the vertical stack below the De-aerator fitting, except as noted in paragraph "I".
(Drawing No. 8)

(B) The De-aerator fitting uses a Pressure Relief Line (PRL). The Pressure Relief Line (PRL) connects to the Sovernt® building drain at a MINIMUM distance of ten pipe diameters (based on stack size) downstream from the centerline of the stack. The PRL connects to the Sovernt® building drain above the centerline of the drain. The PRL may be rolled to the side providing the bottom of the PRL is above the centerline of the Sovernt® building drain.
(Drawing No. 9)

(C) The installed slope for the Sovernt® building drain and PRL is recommended to be one-quarter inch per foot (2%). Installed slopes of one-eighth inch per foot (1%) are permitted however pipe capacity is reduced by a factor of 0.8 as shown in Table C. Installed slopes less than one-eighth inch per foot (1%) are strictly prohibited.
(Drawing No. 10)

(D) Soil and waste branches may connect to the Sovernt® building drain BETWEEN the centerline of the stack and the termination point of the Pressure Relief Line (PRL). All connections shall be made a MINIMUM distance of ten pipe diameters (based on stack size) downstream from the centerline of the stack. Soil and waste branches shall not connect where the Sovernt® building drain makes a horizontal change of direction.
(Drawing No. 11)

(E) Waste branches may connect to the horizontal portion of the Pressure Relief Line (PRL), except on battery type installations. Waste branches shall be at least one pipe size smaller than the PRL. Waste branch connections shall not be made into any vertical portion of the PRL. Clothes washers shall not connect to the PRL.
(Drawing No. 12)

(F) Soil and waste branches may connect downstream of the PRL termination point providing conventional plumbing rules are applied. The vent header from these fixtures may connect to the vertical portion of a Sovernt® stack below an Aerator fitting through a sanitary tee installed with the flow radius down. The vent load of these fixtures shall be added to the fixture unit load on the Sovernt® stack.
(Drawing No. 13)

(G) Soil and waste branches may connect to the vertical stack below the De-aerator fitting. These connections shall be made through a wye-type fitting or through an Aerator fitting. Entry to the Sovernt® building drain from these stacks shall be made using a short sweep, long sweep, two one-eighth bends, or a combination wye & one-eighth bend fitting.
(Drawing No. 14)

(H) Fixtures considered too remote from the Sovernt® stack may be plumbed by conventional methods. This waste and vent area shall be sized in accordance with local prevailing ordinances.
(Drawings No. 12 & No. 15)

(I) Office building battery type installations and Sovernt® stacks serving clothes washers shall use a De-aerator fitting equal in size to the Sovernt® building drain serving that stack. A four-inch (4") De-aerator fitting will be required on three-inch (3") Sovernt® stacks.
(Drawing No. 16)

The above information is based on data found in **Cast Iron Sovernt® Design Manual #802** as published by Conine Manufacturing Co., Inc. © Flint, Texas. For more detailed information contact them at 1-800-537-5895 or visit www.casionsovent.com.

DRAWING NO. 9
Pressure Relief Line Details

DRAWING NO. 10
Base of Stack Connections

DRAWING NO. 11
Branch Connections To PRL

DRAWING NO. 12
Interim Level Remote Plumbing

DRAWING NO. 13
"Conventional" Vent Connections

DRAWING NO. 14
De-aerator Transition Details

SOVENT® BRANCH RULES

(A) The maximum developed length of a three-inch (3") soil branch shall not exceed twelve feet (12'-0"). The maximum developed length of a four-inch (4") soil branch shall not exceed twenty-seven feet (27'-0"). Developed lengths are measured along the centerline of all horizontal branch piping located in ceiling and wall areas. Vertical drops from trap arms or fixtures are not included in the developed length calculations.
(Drawing No. 16)

(B) The maximum developed length of a two-inch (2") waste branch shall not exceed fifteen feet (15'-0"). The maximum developed length of a three-inch (3") waste branch shall not exceed fifteen feet (15'-0"). Developed lengths are measured along the centerline of all horizontal branch piping located in ceiling and wall areas. Vertical drops from trap arms or fixtures are not included in the developed length calculations. Waste branches two pipe sizes smaller than the stack size may connect directly to the stack through a sanitary fitting.
(Drawing No. 17)

(C) Branch sizing shall be in accordance with Table D based on the total fixture unit load determined by Table A or A-1. The installed slope for horizontal branches is recommended to be one-quarter inch per foot (2%). Installed slopes of one-eighth inch per foot (1%) are permitted however pipe capacity is reduced by a factor of 0.8 as shown in Table D. Installed slopes less than one-eighth inch per foot (1%) are strictly prohibited.
(Drawing No. 18)

(D) Branches having three ninety-degree (90°) horizontal changes of direction shall be increased one pipe size at the third ninety degree (1 change of direction reduces the stack. This increase is not required if one of the directional changes can be made with two one-eighth bends or a short sweep radius bend.
(Drawing No. 19)

(E) The transition from a horizontal or vertical branch to another horizontal branch must be made with a wye-type fitting.
(Drawing No. 18)

(F) Horizontal branch piping at the base of a vertical drop exceeding forty inches (40") in height shall be increased one pipe size. This increase is not required when the lower portion of the drop is made at forty-five degrees (45°) and the upper vertical portion is less than forty inches (40").
(Drawing No. 19)

(G) Branch piping with vertical drops exceeding ten feet (10'-0") shall be increased one pipe size.
(Drawing No. 19)

(H) A three-inch (3") soil branch shall be increased one pipe size at the connection point of other fixtures. This increase is not required when comparing fixture unit loads from Table A-1.
(Drawing No. 20)

(I) Two fixtures using 1-1/4" tailpiece/trap sizes may combine into a single two-inch (2") vertical drop. Fixtures using 1-1/2" tailpiece/trap sizes and larger require separate vertical drops from each trap arm or may combine into a single vertical drop that is increased one pipe size. This increase is not required if the change in elevation is made at forty-five degrees (45°). The future trap arm shall be one pipe size larger than the future tailpiece and this increase may be made at the wall.
(Drawing No. 20)

(J) Clothes washer branches shall be three-inch (3") in size. Clothes washer branches with no vertical drops and developed lengths five feet (5'-0") or less may be two-inch (2") in size.
(Drawing No. 20)

(K) Pressure Equalizing Lines may be used as an alternate to the rules concerning increased branch sizes. Pressure Equalizing Lines shall be vertically above the branch and connect to the Sovernt® stack above the floor of the fixtures they serve. Pressure Equalizing Lines may be fed directly through the roof.
(Drawing No. 20)

The above information is based on data found in **Cast Iron Sovernt® Design Manual #802** as published by Conine Manufacturing Co., Inc. © Flint, Texas. For more detailed information contact them at 1-800-537-5895 or visit www.casionsovent.com.

DRAWING NO. 15
Remote Penthouse Connections

DRAWING NO. 16
Soil Branch Developed Lengths

DRAWING NO. 17
Waste Branch Developed Lengths

DRAWING NO. 18
Miscellaneous Branch Details

DRAWING NO. 19
Branch Sizing - Vertical Drops

DRAWING NO. 20
Miscellaneous Branch Details